
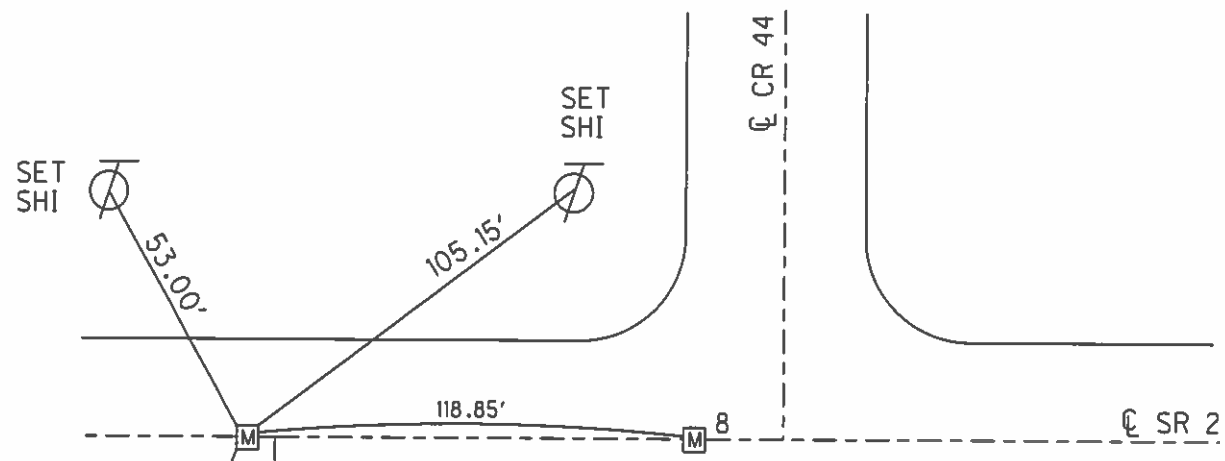


O.D.O.T. DISTRICT 2 SURVEY OFFICE (USE ONLY)

PERSONNEL _____ REFERENCE NO. 7 A SHEET 13 OF 38
 NOTES RHOADES DATE 6/24/15 ROUTE SR 2
 H.C. O'DONNELL WEATHER FAIR COUNTY OTTAWA
 R.C. RHOADES TEMP. 70° TOWNSHIP BENTON
 _____ SECTION 3
 _____ T 7 N R 14 E

TYPE MONUMENT MONBOX
 ON SURFACE - ~~BELOW~~ ON _____
 LEFT - ☉ PAV'T - RIGHT ON _____
15.0' TO LT EDGE PAVEMENT
 S.L.M. 168+84.24
 GRID: NORTHING: 706635.646 EASTING: 1771101.729

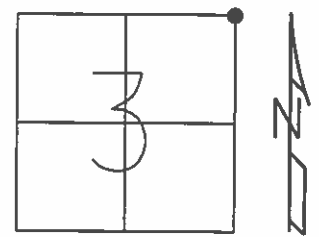

RECORD:
 STA. 169+93.26
 SET P.K./WASHER
 ATOP P.K./WASHER
 1/4/83, CRONIN

FD MON.BOX
 GPS, REFA8
 11/25/11, MC
 FD MONBOX
 4/23/13, SDC
 NEW MON.BOX SET
 W/ 1" IPIN
 GPS, NEWREFA8
 10/1/15, JFO