

S 1/4 Post SEC 34 - Fo. Remnants of 1/2 of a CHAINED 'x' to loc. Now USE

N = 706,674.7670 E = 1,768,567.0160

N 1/4 Post SEC 3 - ESTABLISH ON LINE S 1/4 Post SEC 34 TEN RAKE TO SW CORNER SEC 34 TEN RAKE USING SINGLE PROPORTIONATE MEASUREMENT FROM NE CORNER TO NW CORNER SECTION 3

N = 706,676.5613 E = 1,768,451.8100

NEED TO SET IRON PINS IN MONUMENT BOX @ S 1/4 Post BOUND SEC 34 TEN RAKE
④ N 1/4 Post BOUND SEC 3 TEN RAKE

* CONCRETE FOOT IS 0.49' ±
BELOW EXISTING SURFACE

2 PINS & BOXES NEEDED

County Ottawa S.R. # 2

Date 1/4/83

Township Benton


Weather sunny - windy

Section 34

Temp. 35°


T8N, R14E

Personnel Cronin

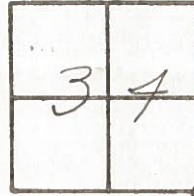

8

Ripple
Geyman
Barbour

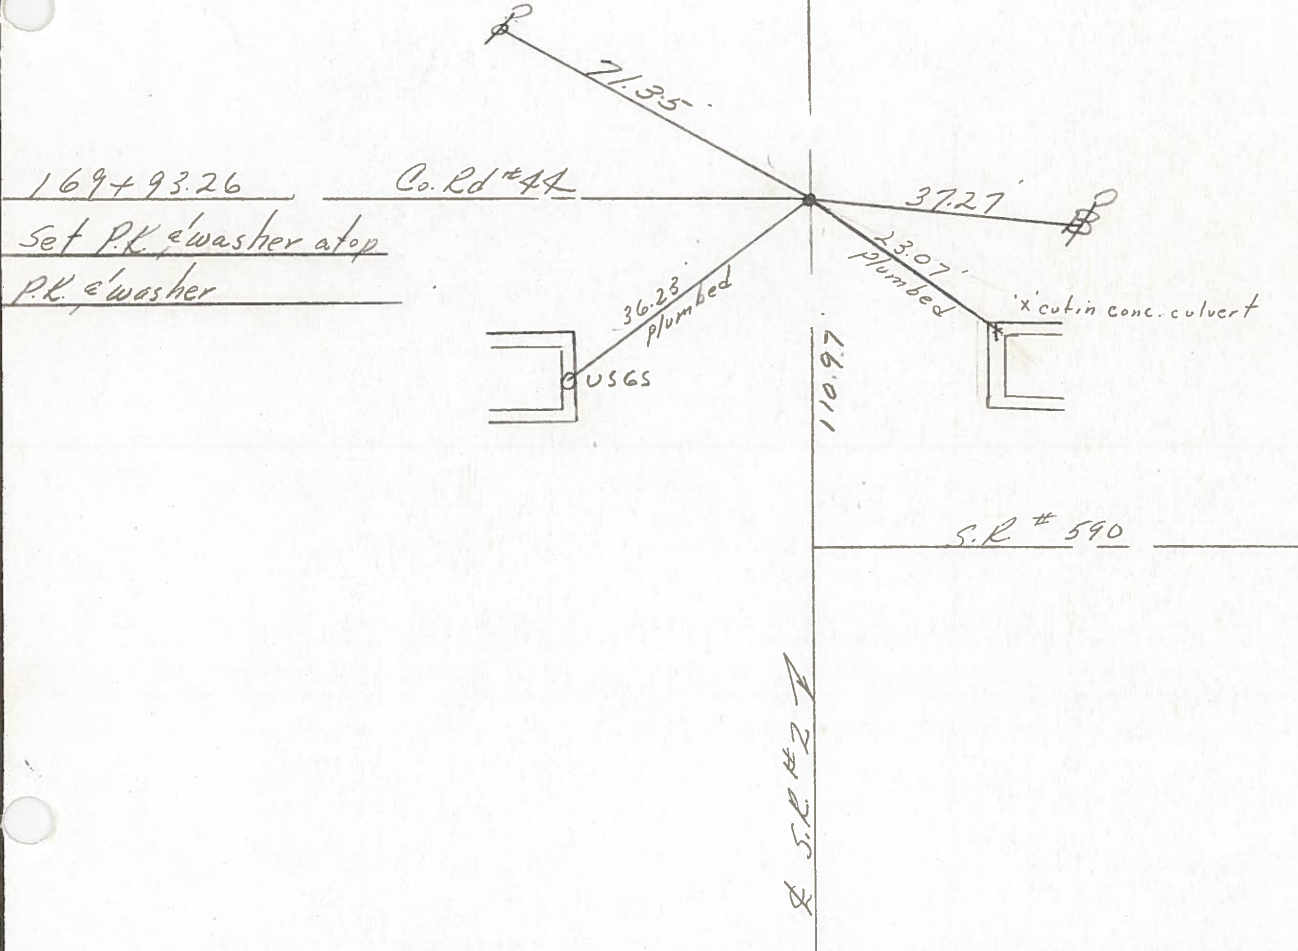

PERSONNEL	TITLE	PERSONNEL	TITLE
Schneider		Redding	
Masser			
Barbour			
Potts			

COUNTY Ottawa DATE 5-15-68
 S. R. 2 WEATHER Partly - Cloudy
 SEC. Lucas Co. Line - East TEMP. 80°

DESCRIPTION Ties for Control Points JOB NO. _____
 LEFT CENTER LINE RIGHT

