


O.D.O.T. DISTRICT 2 SURVEY OFFICE (USE ONLY)

PERSONNEL _____ REFERENCE NO. 26 SHEET 34 OF 38
 NOTES RHOADES DATE 5/7/13 ROUTE SR 2
 H.C. CODER WEATHER CLOUDY COUNTY OTTAWA
 R.C. RHOADES TEMP. 65° TOWNSHIP CARROLL
 _____ SECTION 2
 _____ T 7 N R 15 E

TYPE MONUMENT MON.BOX
 ON SURFACE - ~~BELOW~~ ON _____
 LEFT - ☉ PAV'T - RIGHT ON _____
17.9' TO RT EDGE PAVEMENT
 S.L.M. 492+66.45

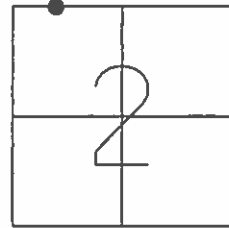


GRID: NORTHING: 706245.033 EASTING: 1803477.922

SET SHI
6" CLUSTER



66.78' P

RECORD:
 FD MON.BOX IN POOR
 CONDITION, W/NO LID
 GPS, REF26
 11/28/11, MC
 FD MON.BOX W/LID
 COULD NOT OPEN
 10/7/15, JFO

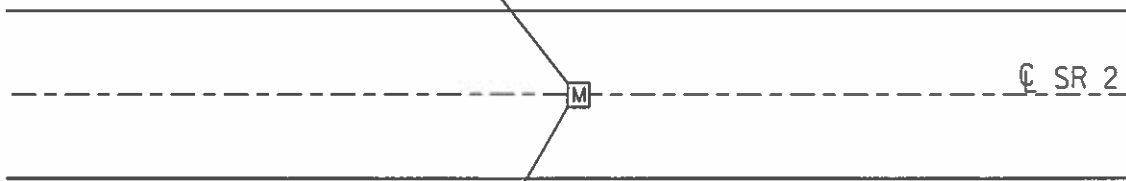

SET SHI



57.18' P

PERSONNEL TITLE PERSONNEL TITLE

COUNTY Ottawa DATE 10-31-74
7-18-74

S. R. R WEATHER SHAWY

SEC Bark Inn Curve TEMP. 80°

DESCRIPTION Carroll Twp. S.R. #19 E. JOB NO.

