

O.D.O.T. DISTRICT 2 SURVEY OFFICE (USE ONLY)

PERSONNEL

REFERENCE NO. 29

SHEET 37 OF 37

NOTES RHOADES

DATE 5/7/13

ROUTE SR 2

H.C. CODER

WEATHER CLOUDY

COUNTY OTTAWA

R.C. RHOADES

TEMP. 65°

TOWNSHIP CARROLL

DWG BY NIESE PID 107060

SECTION 2

T 7 N R 15 E

TYPE MONUMENT MONBOX

ON SURFACE - BELOW ON

OFFSET ☉ PAVEMENT ON LT : RT

- TO - EDGE PAVEMENT



STATION: 531+23.38

HORZ.DATUM: NAD83(2011)

GEOID: 2012A

GRID: NORTHING: 703462.963

EASTING: 1805267.425

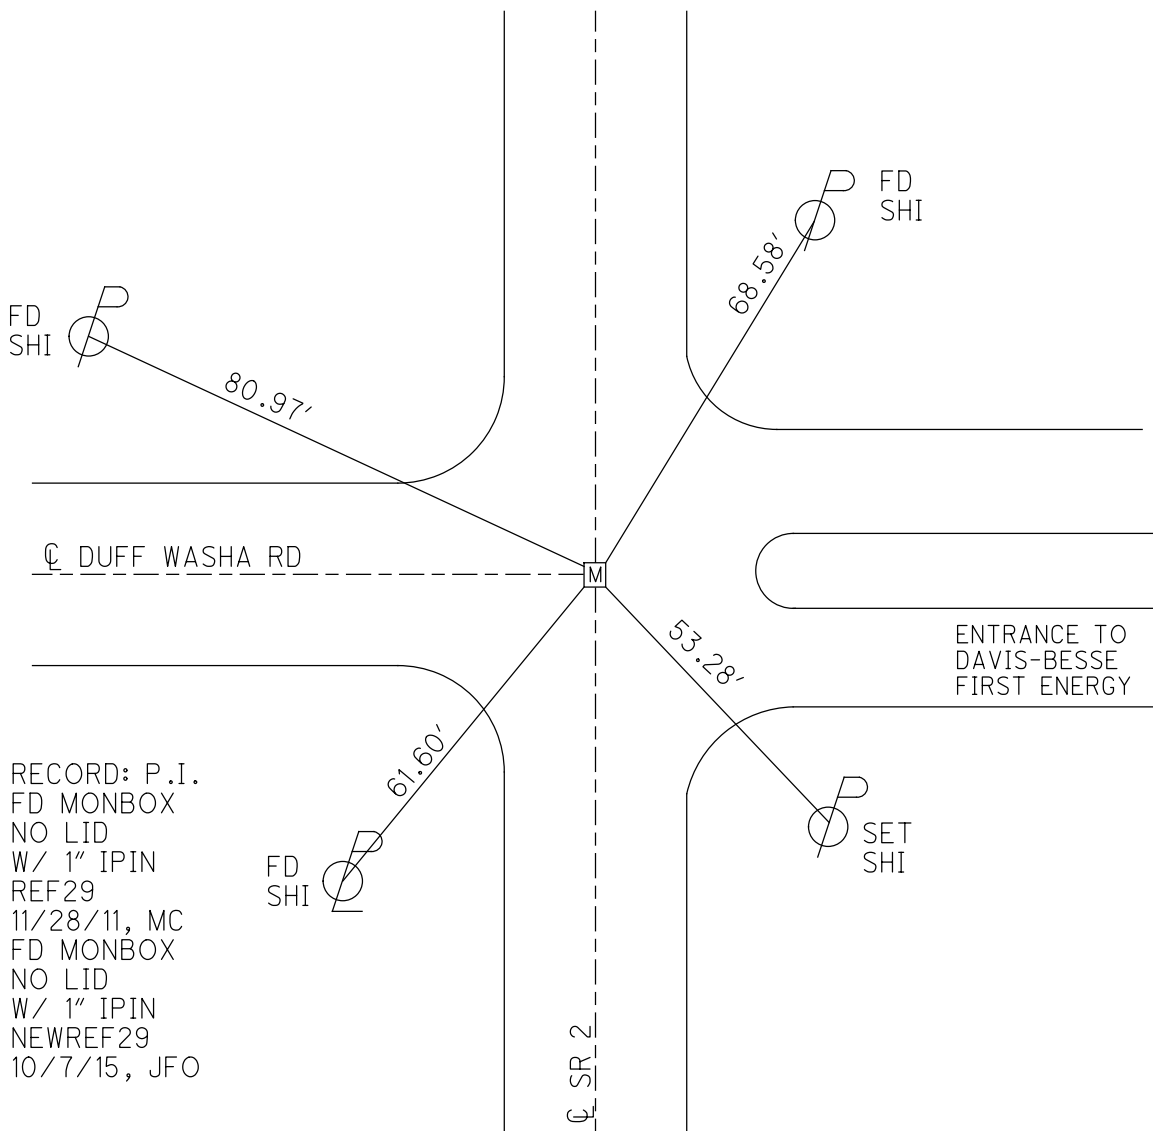
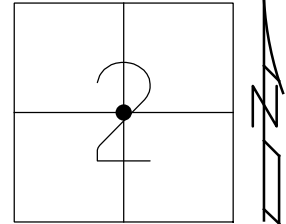


RECORD: P.I.
 FD MONBOX
 NO LID
 W/ 1" IPIN
 REF29
 11/28/11, MC
 FD MONBOX
 NO LID
 W/ 1" IPIN
 NEWREF29
 10/7/15, JFO

O.D.O.T. DISTRICT 2 SURVEY OFFICE (USE ONLY)

PERSONNEL	REFERENCE NO.	<u>29</u>	SHEET	<u>37</u> OF <u>38</u>	
NOTES	RHOADES	DATE	<u>5/7/13</u>	ROUTE	<u>SR 2</u>
H.C.	<u>CODER</u>	WEATHER	<u>CLOUDY</u>	COUNTY	<u>OTTAWA</u>
R.C.	<u>RHOADES</u>	TEMP.	<u>65°</u>	TOWNSHIP	<u>CARROLL</u>
				SECTION	<u>2</u>
				T	<u>7</u> N
				R	<u>15</u> E

TYPE MONUMENT MON.BOX
 ON SURFACE - ~~BELOW~~ ON
 LEFT - ☉ PAV'T - RIGHT ON
TO - EDGE PAVEMENT
 S.L.M. 531+23.38
 GRID: NORTHING: 703462.963 EASTING: 1805267.425

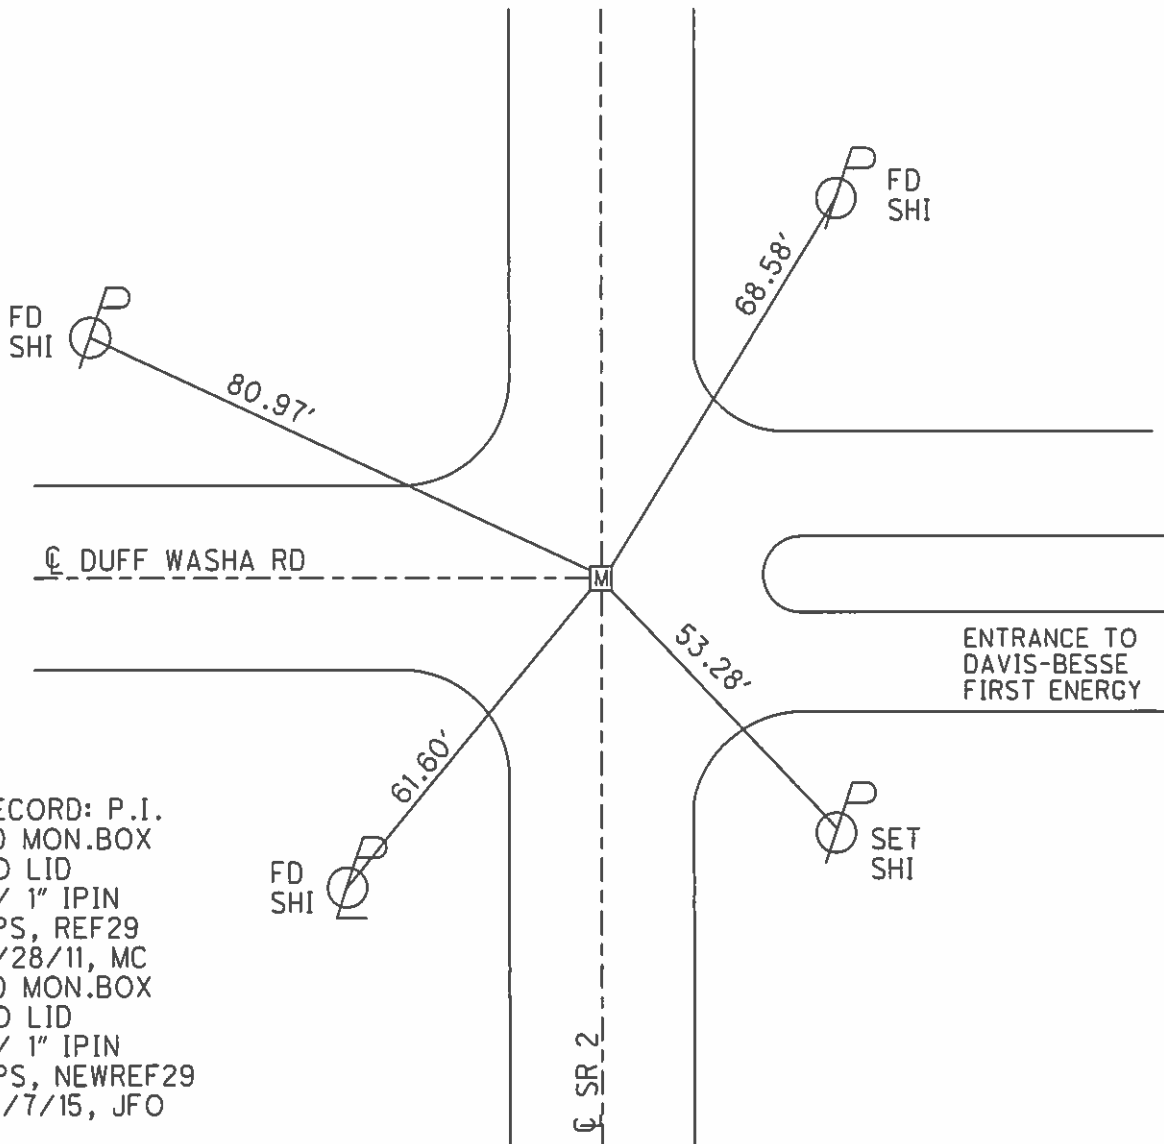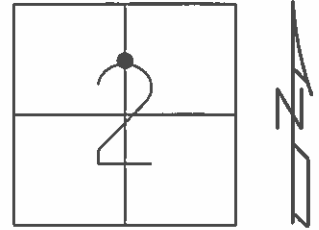

RECORD: P.I.
 FD MON.BOX
 NO LID
 W/ 1" IPIN
 GPS, REF29
 11/28/11, MC
 FD MON.BOX
 NO LID
 W/ 1" IPIN
 GPS, NEWREF29
 10/7/15, JFO

County Ottawa S.R. # 2

Date 11-7-74 (copy)

Township _____

Weather _____


Section _____

Temp. _____

T N, R E

Personnel Schneider
Mosser
Ripple
Geyman


29

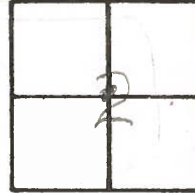

#22



☉ survey & R/W
 P.I. $\Delta = 0^{\circ}17'30''$ Lt.
 535 + 19.51
 Brass Pin &
 Mon. Box with I.P. inside
 6" down Reset P.K. Nails

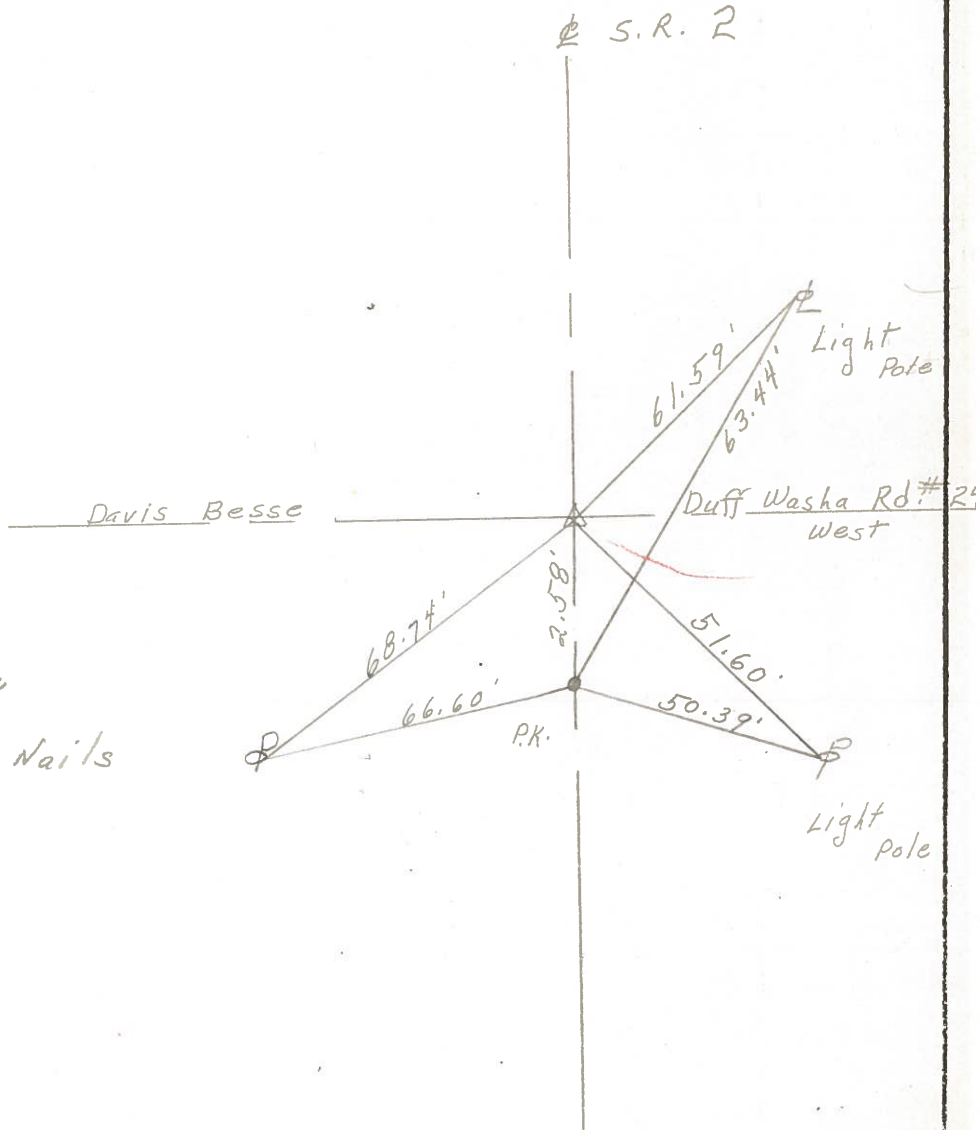

PERSONNEL TITLE PERSONNEL TITLE

Schneider
Barbour
Ripple
Geyman

COUNTY Ottawa

DATE 7-18-74

S. R. R

WEATHER Sunny

SEC. R

TEMP. 85°


DESCRIPTION Carroll Twp SR # 19 E.

JOB NO.


LEFT CENTER LINE RIGHT

3-19-80
35°

P.I.
568+49.5
1" Iron Pin
23A

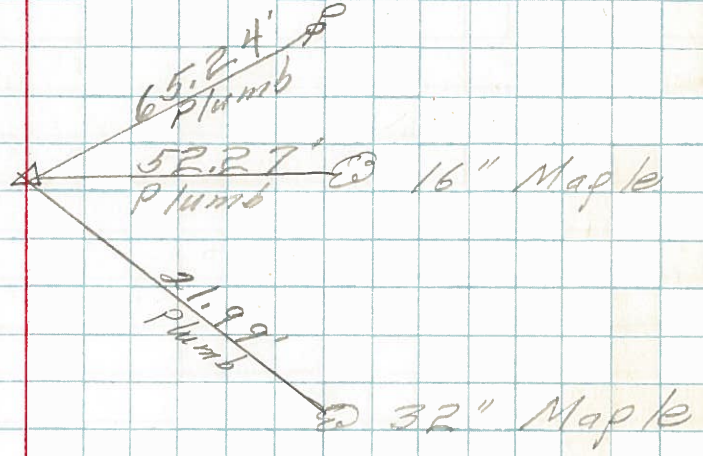

P.I. 30
561+59.56
Brass Mon. ✓
2" down ✓
Mon Box 10" below surf
SLM 1987-557+91
23

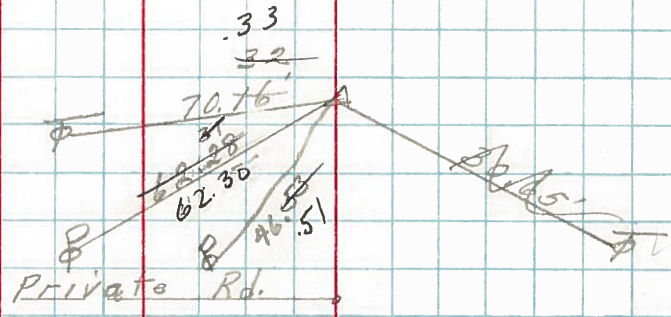


5/01/87
overcast
55°



Reset P.K. Nails

22

± surf & P.W.
P.I. Δ = 0° 17' 30" T.P.
535+19.51
Brass Pin &
Mon. Box
with I.P. inside
6" down

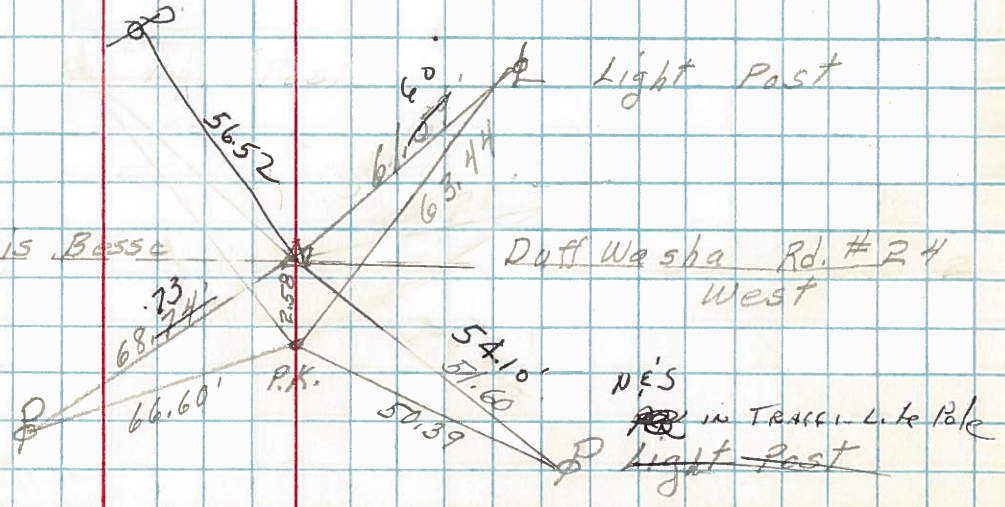

PERSONNEL TITLE PERSONNEL TITLE COUNTY Ottawa DATE 6-13-68
Schneider Potts
Mosser S. R. 2 WEATHER Fair
Barbour
Redding SEC. S.R.#19 East TEMP. 68°
 DESCRIPTION Ties for Control Points JOB NO.

LEFT CENTER LINE RIGHT

