



O.D.O.T. DISTRICT 2 SURVEY OFFICE (USE ONLY)

PERSONNEL _____ REFERENCE NO. 30 C SHEET 4 OF 25
 NOTES RHOADES DATE 8-15-23 ROUTE SR 2
 H.C. AUBLE WEATHER CLOUDY COUNTY OTTAWA
 R.C. NIESE TEMP. 72° TOWNSHIP CARROLL
 DWG BY NIESE PID 95755 SECTION 11
 T 7 N R 15 E

TYPE MONUMENT MAG/WASHER
 ON SURFACE - ~~BELOW~~ ON
 OFFSET C PAVEMENT 1.9' LT : ~~RT~~
- TO - EDGE PAVEMENT
 STATION: -

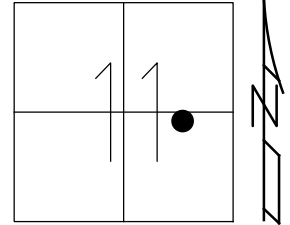

HORZ. DATUM: NAD83(2011) GEOID: 2012A
 GRID: NORTHING: 697632.838 EASTING: 1806613.386 CALC.

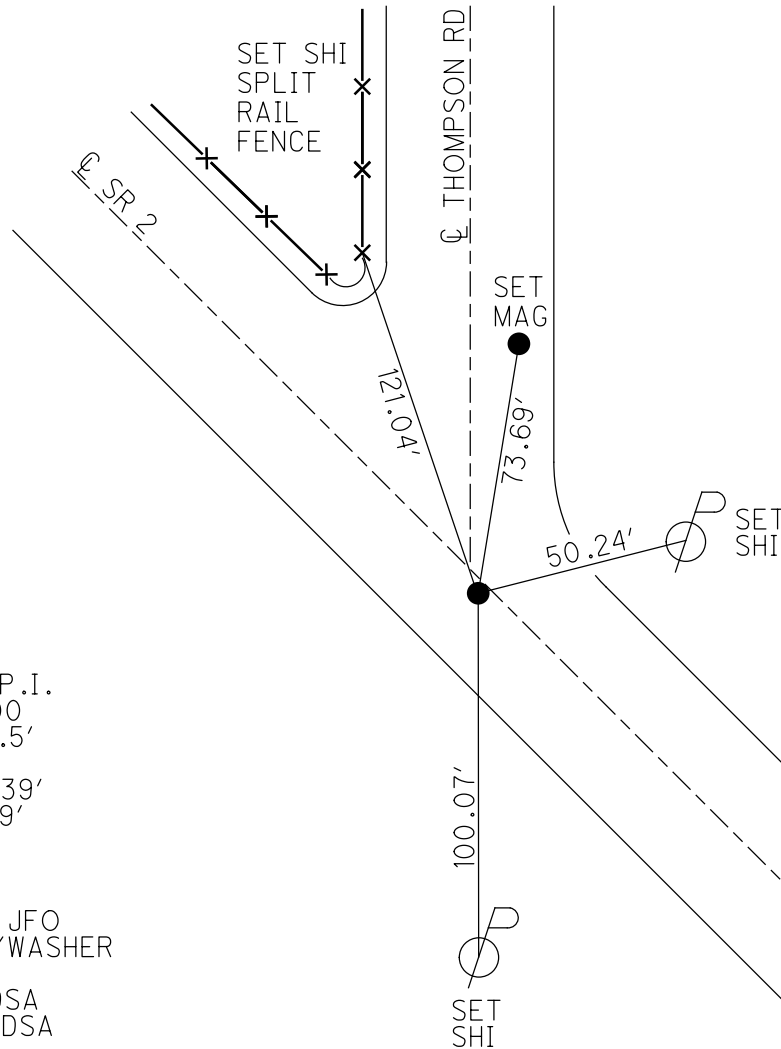


RECORD: P.I.
 STA 25+00
 $\Delta = 4^{\circ}53.5'$
 $D = 4^{\circ}0'$
 $R = 1432.39'$
 $L = 122.29'$
 $T = 61.19'$
 FD HOLE
 REFB23
 4/24/19, JFO
 SET MAG/WASHER
 BY CALC.
 REF30C-DSA
 8-15-23, DSA


O.D.O.T. DISTRICT 2 SURVEY OFFICE (USE ONLY)

PERSONNEL _____ REFERENCE NO. 30 C SHEET 4 OF 25
NOTES O'DONNELL DATE 4/24/19 ROUTE SR 2
H.C. _____ WEATHER _____ COUNTY OTTAWA
R.C. _____ TEMP. _____ TOWNSHIP CARROLL
DWG BY NIESE PID 107060 SECTION 11
T 7 N R 15 E

TYPE MONUMENT CNPT
ON SURFACE - ~~BELOW~~ ON
OFFSET \odot PAVEMENT _____ LT : RT
_____ TO _____ EDGE PAVEMENT
STATION: _____

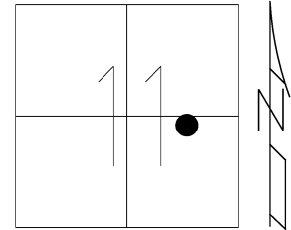

HORIZ.DATUM: NAD83(2011) GEOID: 2012A
GRID: NORTHING: 697632.838 EASTING: 1806613.386

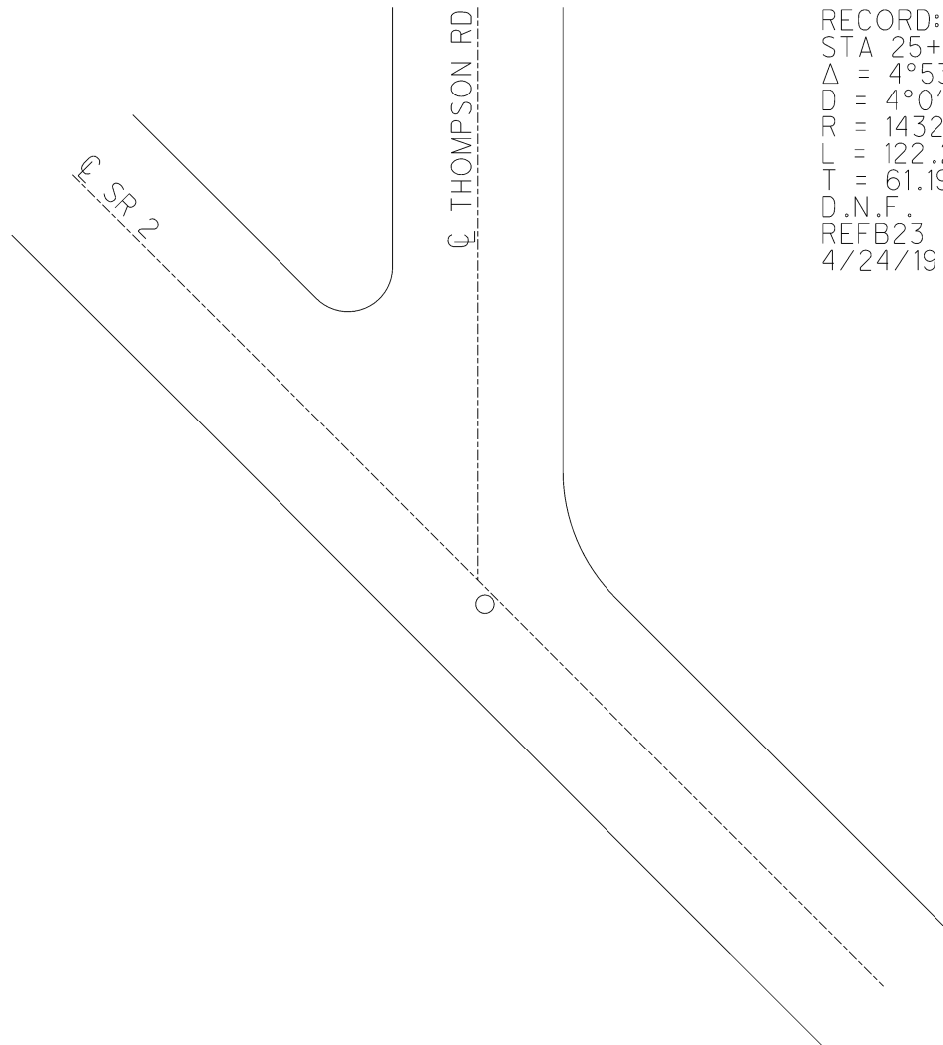

RECORD: P.I.
STA 25+00
 $\Delta = 4^{\circ}53.5'$
 $D = 4^{\circ}0'$
 $R = 1432.39'$
 $L = 122.29'$
 $T = 61.19'$
D.N.F.
REFB23
4/24/19, JFO