



O.D.O.T. DISTRICT 2 SURVEY OFFICE (USE ONLY)

PERSONNEL _____ REFERENCE NO. 30 D SHEET 5 OF 25
NOTES VAN DUSEN DATE 6/2/00 ROUTE SR 2
H.C. CORDES WEATHER SUNNY COUNTY OTTAWA
R.C. BROWN TEMP. 80° TOWNSHIP CARROLL
SECTION 12
DWG BY NIESE PID 95755 T 7 N R 15 E

TYPE MONUMENT P.K./WASHER
ON SURFACE - ~~BELOW~~ ON
OFFSET ☉ PAVEMENT 4.0' LT : RT
- TO - EDGE PAVEMENT
STATION: 621+46

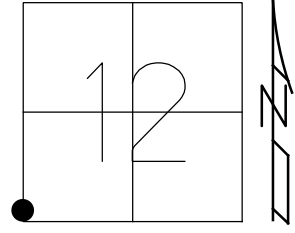

HORIZ.DATUM: NAD83(2011) GEOID: 2012A
GRID: NORTHING: 695600.567 EASTING: 1807913.856

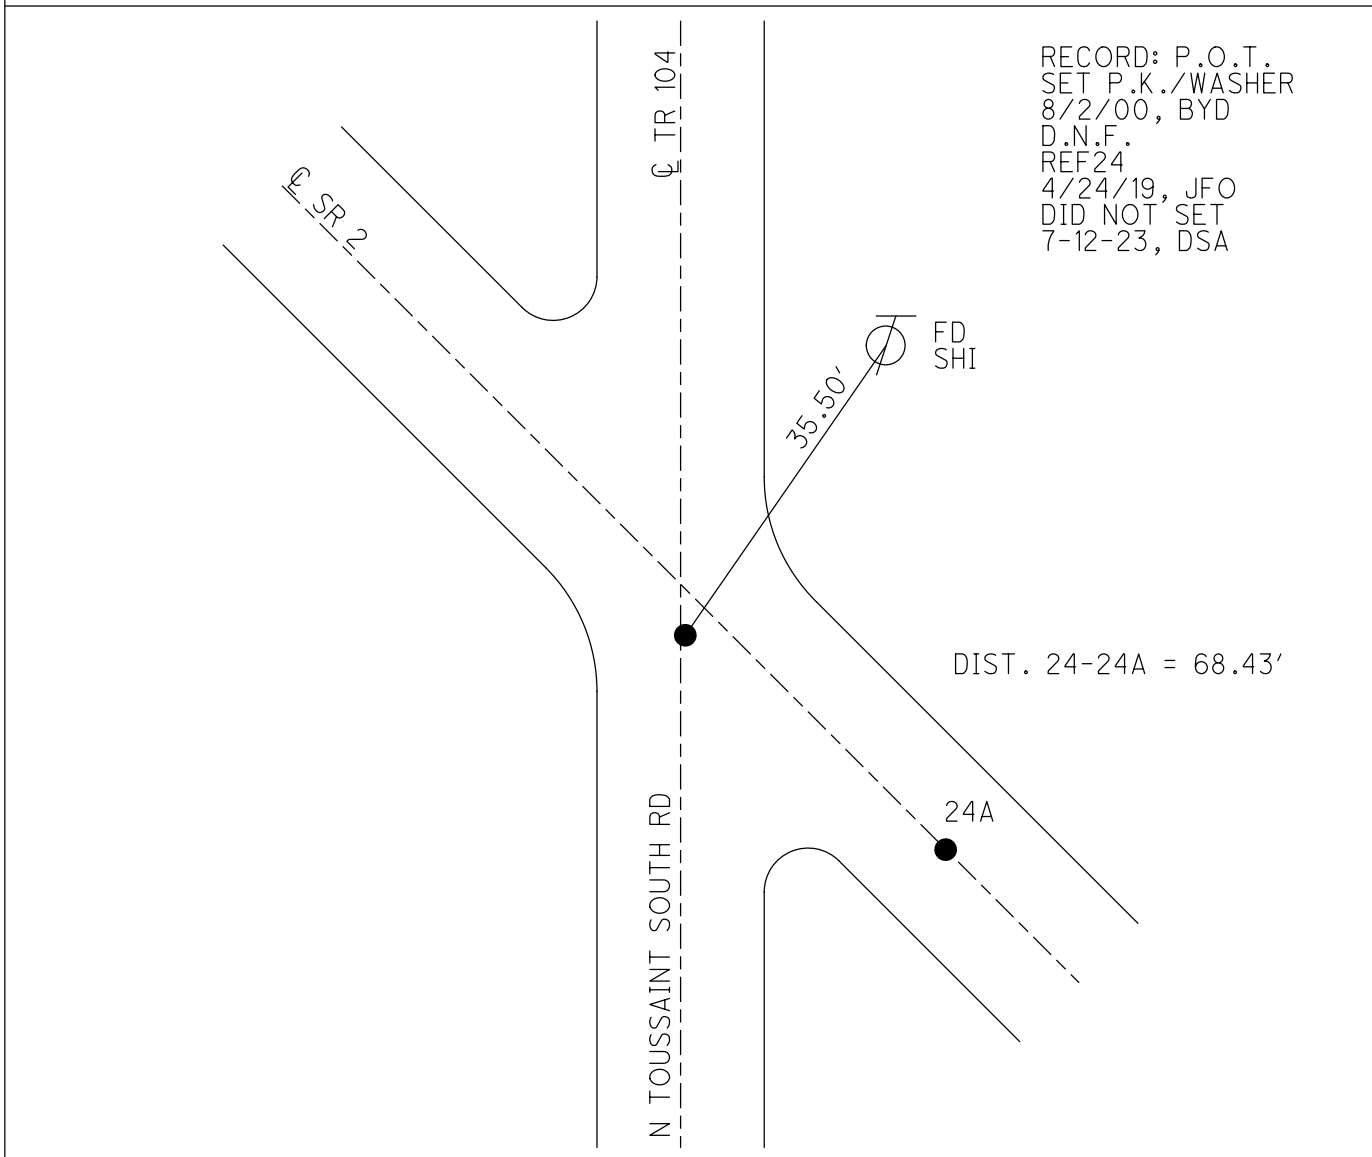

RECORD: P.O.T.
SET P.K./WASHER
8/2/00, BYD
D.N.F.
REF24
4/24/19, JFO
DID NOT SET
7-12-23, DSA

O.D.O.T. DISTRICT 2 SURVEY OFFICE (USE ONLY)

PERSONNEL

REFERENCE NO. 30 D

SHEET 5 OF 25

NOTES VAN DUSEN

DATE 6/2/00

ROUTE SR 2

H.C. CORDES

WEATHER SUNNY

COUNTY OTTAWA

R.C. BROWN

TEMP. 80°

TOWNSHIP CARROLL

SECTION 12

DWG BY NIESE PID 107060

T 7 N R 15 E

TYPE MONUMENT P.K./WASHER

ON SURFACE - ~~BELOW~~ ON

OFFSET \odot PAVEMENT 4.0' ~~LF~~ : RT

- TO - EDGE PAVEMENT


STATION: 621+46

HORIZ.DATUM: NAD83(2011)


GEOID: 2012A

GRID: NORTHING: 695600.567

EASTING: 1807913.856

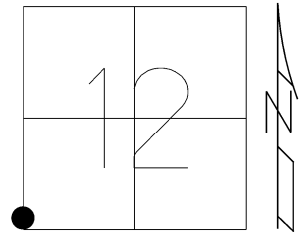

RECORD: P.O.T.
SET P.K./WASHER
8/2/00, BYD
D.N.F.
REF24
4/24/19, JFO

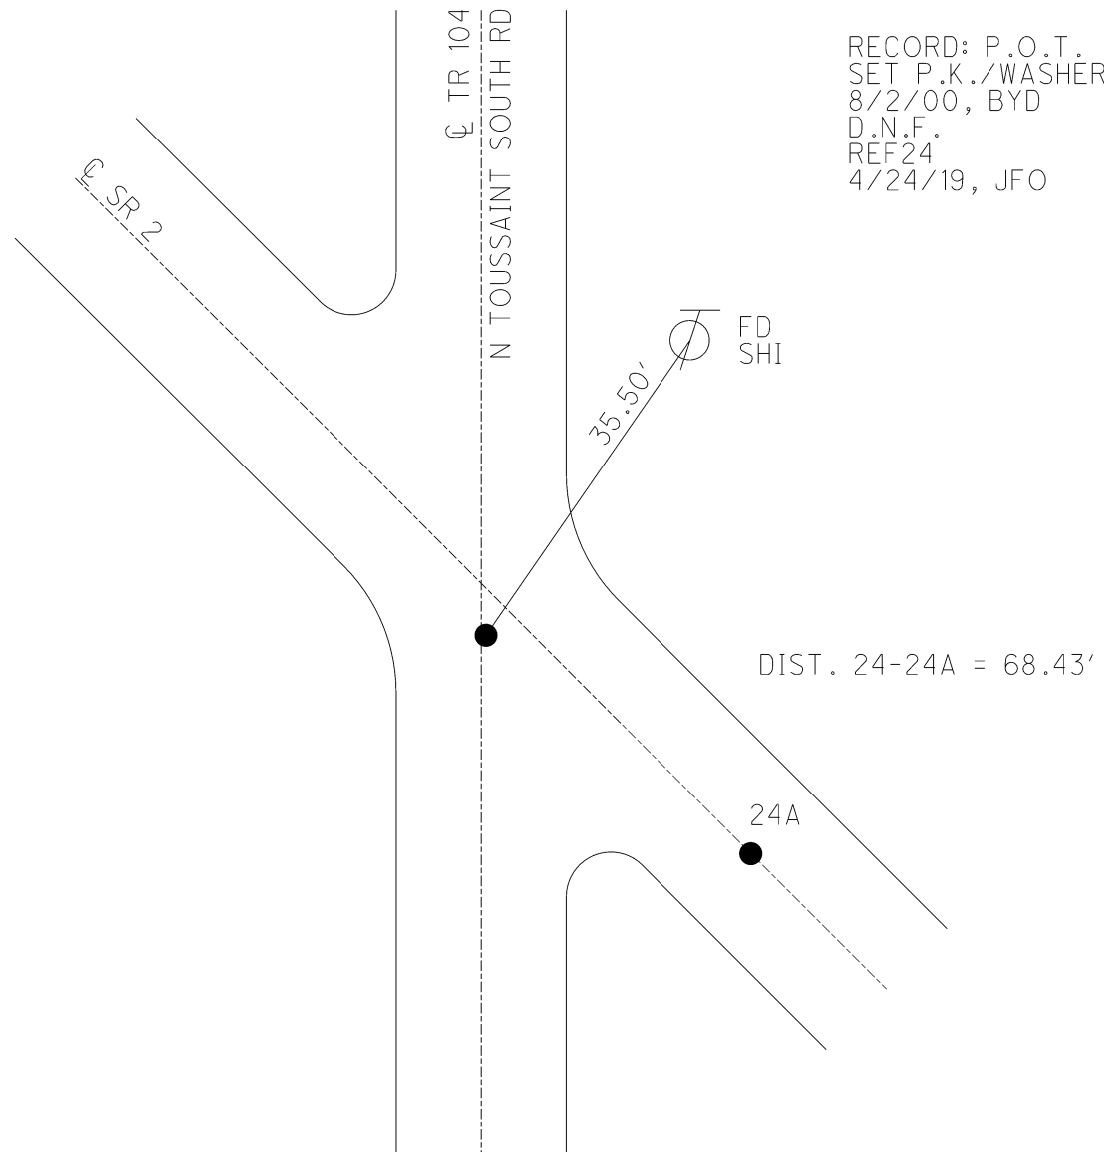

O.D.O.T. DISTRICT 2 SURVEY OFFICE

PERSONNEL _____

REFERENCE NO. _____

SHEET 1 OF 15

NOTES VAN DUSEN

H.C. CORDES

R.C. BROWN

DATE 6-2-00

WEATHER SUNNY

TEMP. +80°F

ROUTE 2

COUNTY OTTAWA

TOWNSHIP Carroll

SECTION 11+12

T. 7 N R. 15 E

TYPE MONUMENT A+B both PK/WASHER
 ON SURFACE - ~~BELOW~~ both on surface
 LEFT = ☉ PAV'T. - RIGHT A' 4' RT of E R+2 + 0.5' RT of TOWNSHIP S.
TO EDGE PAVEMENT 'B' ON ☉ SR2
 S.L.M. 621+46

11	12
14	13



RESET PK/WASHER
 8-2-00
 BYD

