


O.D.O.T. DISTRICT 2 SURVEY OFFICE (USE ONLY)


PERSONNEL _____ REFERENCE NO. 30 E SHEET 6 OF 25
 NOTES VAN DUSEN DATE 6/2/00 ROUTE SR 2
 H.C. CORDES WEATHER SUNNY COUNTY OTTAWA
 R.C. BROWN TEMP. 80° TOWNSHIP CARROLL
 DWG BY NIESE PID 95755 SECTION 12
 T 7 N R 15 E

TYPE MONUMENT P.K./WASHER
 ON SURFACE - ~~BELOW~~ ON
 OFFSET C PAVEMENT 0.5' ~~RT~~ : RT
- TO - EDGE PAVEMENT
 STATION: 622+14

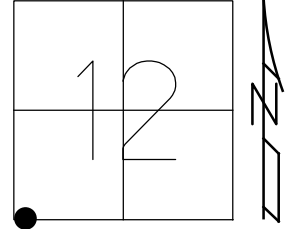

HORZ.DATUM: NAD83(2011) GEOID: 2012A
 GRID: NORTHING: 695544.240 EASTING: 1807952.615


RECORD:
 SET P.K./WASHER
 8/2/00, BYD
 D.N.F.
 4/1/19, JFO
 REFA24
 4/24/19, JFO
 DID NOT SET
 7-12-23, DSA

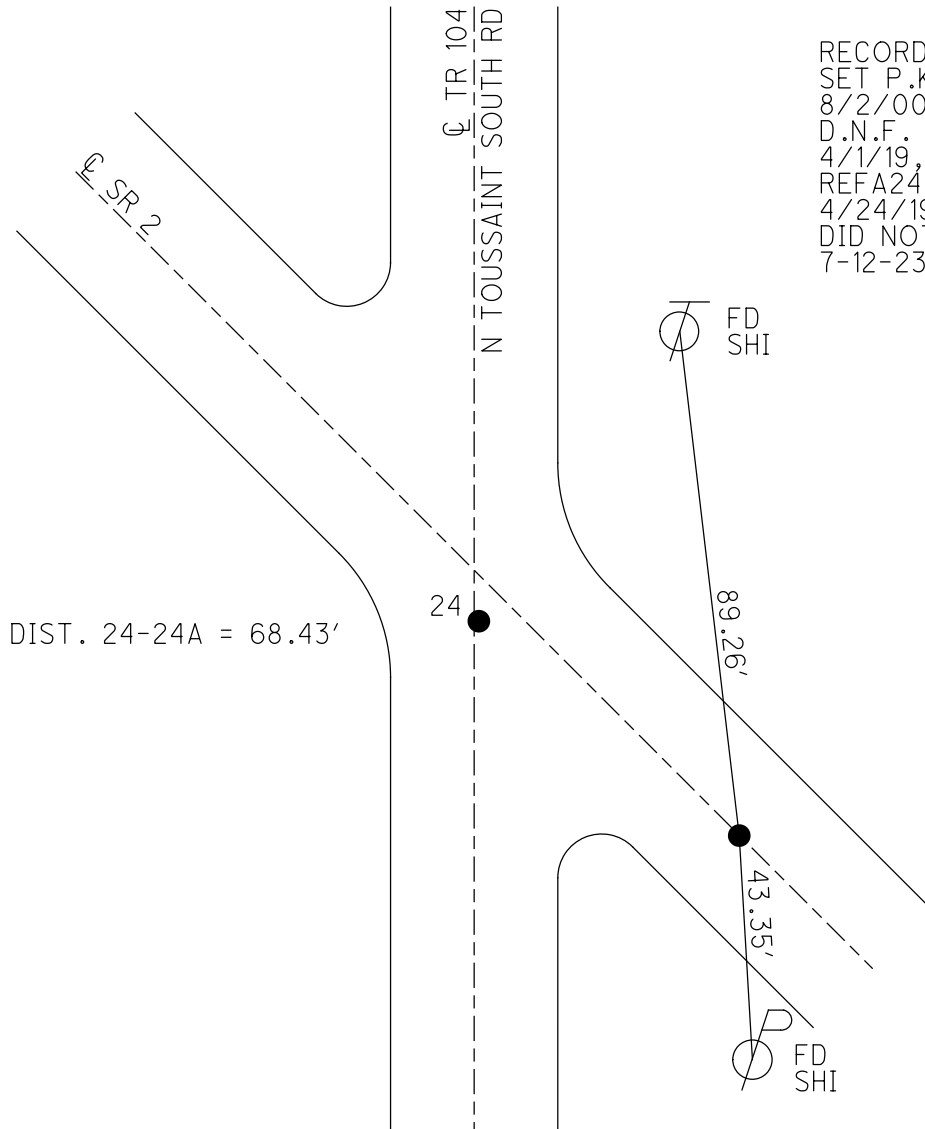

O.D.O.T. DISTRICT 2 SURVEY OFFICE (USE ONLY)


PERSONNEL _____ REFERENCE NO. 30 E SHEET 6 OF 25
 NOTES VAN DUSEN DATE 6/2/00 ROUTE SR 2
 H.C. CORDES WEATHER SUNNY COUNTY OTTAWA
 R.C. BROWN TEMP. 80° TOWNSHIP CARROLL
 SECTION 12
 DWG BY NIESE PID 107060 T 7 N R 15 E

TYPE MONUMENT P.K./WASHER
 ON SURFACE - ~~BELOW~~ ON
 OFFSET \odot PAVEMENT 0.5' ~~±~~ : RT
- TO - EDGE PAVEMENT
 STATION: 622+14

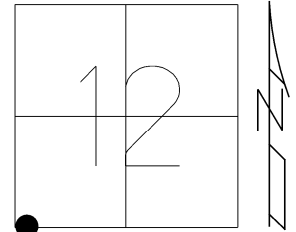

HORZ.DATUM: NAD83(2011) GEOID: 2012A
 GRID: NORTHING: 695544.240 EASTING: 1807952.615

RECORD:
 SET P.K./WASHER
 8/2/00, BYD
 D.N.F.
 4/1/19, JFO
 REFA24
 4/24/19, JFO

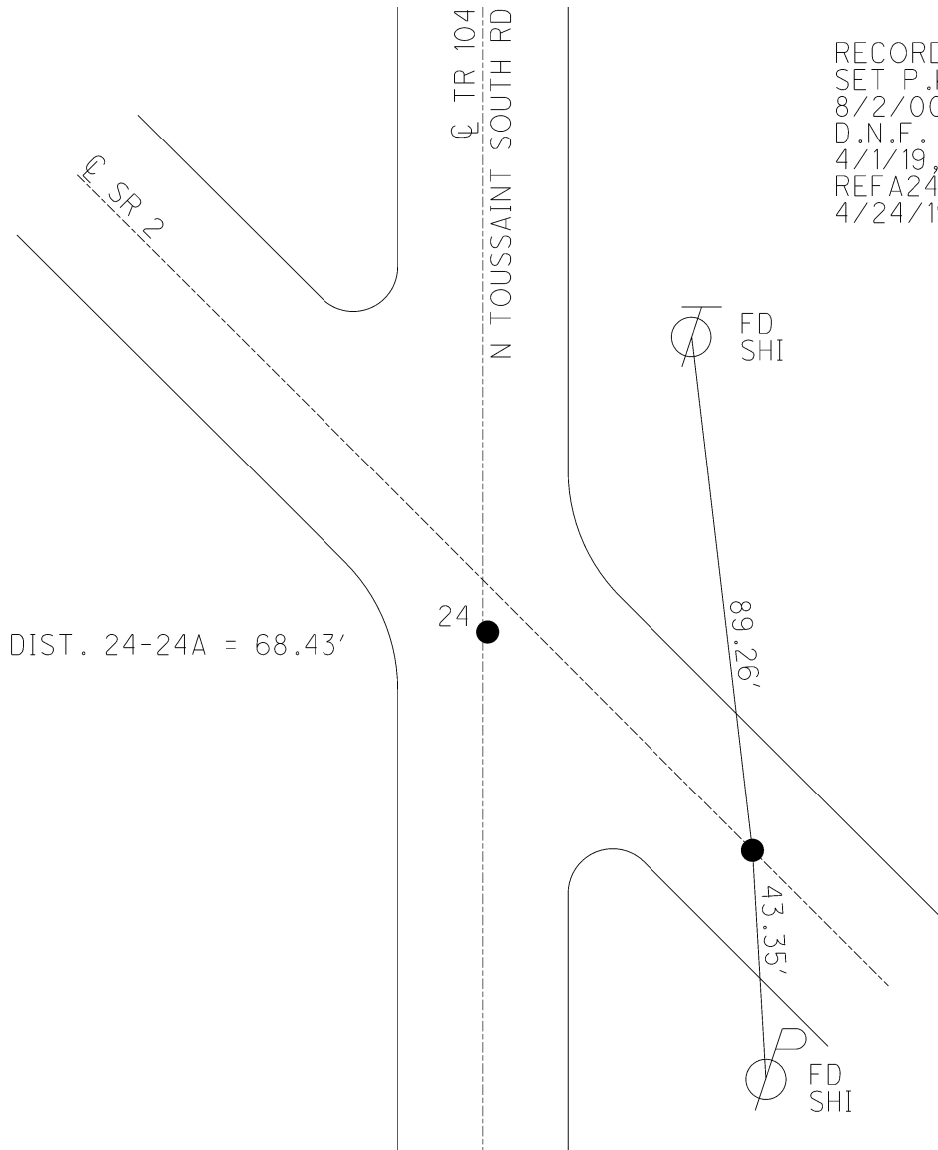

O.D.O.T. DISTRICT 2 SURVEY OFFICE

PERSONNEL _____

REFERENCE NO. _____

SHEET 1 OF 15

NOTES VAN DUSEN

H.C. CORDES

R.C. BROWN

DATE 6-2-00

WEATHER SUNNY

TEMP. +80°F

ROUTE 2

COUNTY OTTAWA

TOWNSHIP Carroll

SECTION 11+12

T. 7 N. R. 15 E.

TYPE MONUMENT A+B both PK/WASHER
 ON SURFACE - ~~BELOW~~ both on surface
~~LEFT = Ø PAV'T.~~ - RIGHT A' 4' RT of Ø R+2 + 0.5' RT Ø TOWNSHIP S.
TO EDGE PAVEMENT 'B' ON Ø SR2
 S.L.M. 621+46

