

O.D.O.T. DISTRICT 2 SURVEY OFFICE (USE ONLY)

PERSONNEL

REFERENCE NO. 37 D

SHEET 24 OF 25

NOTES ASTON

DATE 5-11-23

ROUTE SR 2

H.C. AUBLE

WEATHER SUNNY

COUNTY OTTAWA

R.C. NIESE

TEMP. 64°

TOWNSHIP ERIE

DWG BY NIESE

PID 107060

SECTION 29

T 7 N R 14 E

TYPE MONUMENT MONBOX W/IPIN

ON SURFACE - ~~BELOW~~ ON

OFFSET C PAVEMENT 12.0', EB C LT : RT

0.0' TO LT EDGE PAVEMENT



STATION: 797+84.71

HORZ.DATUM: NAD83(2011)

GEOID: 2012A

GRID: NORTHING: 683414.714

EASTING: 1820823.096

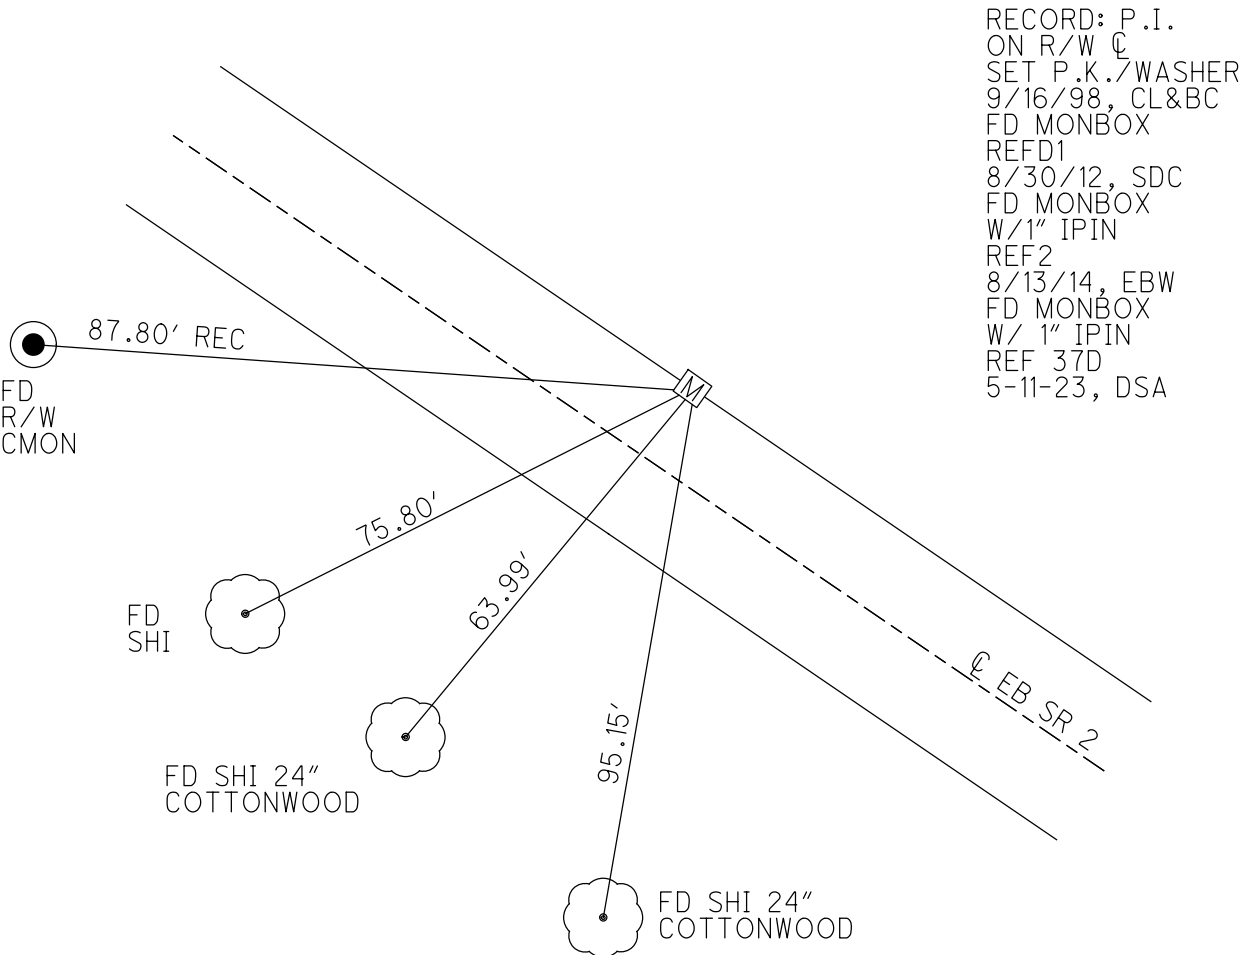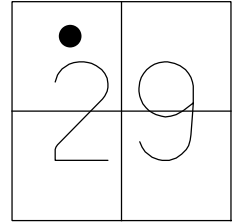

O.D.O.T. DISTRICT 2 SURVEY OFFICE (USE ONLY)

PERSONNEL

REFERENCE NO. 37 D

SHEET 24 OF 25

NOTES LEU DATE 8/13/14
 H.C. HOMAN WEATHER SUNNY
 R.C. WESTFALL TEMP. 73°

ROUTE SR 2
 COUNTY OTTAWA
 TOWNSHIP ERIE
 SECTION 29

DWG BY NIESE PID 107060

T 7 N R 14 E

TYPE MONUMENT MONBOX W/IPIN

ON SURFACE - ~~BELOW~~ ON

OFFSET 0.0' Q PAVEMENT 12.0', EB Q LT : ~~RT~~


STATION: 797+84.71

HORZ.DATUM: NAD83(2011)


GEOID: 2012A

GRID: NORTHING: 683414.714

EASTING: 1820823.096

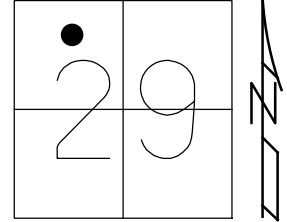


RECORD: P.I.
 ON R/W Q
 SET P.K.7 WASHER
 9/16/98, CL&BC
 FD MONBOX
 REF D1
 8/30/12, SDC
 FD MONBOX
 W/1" IPIN
 REF 2
 8/13/14, EBW

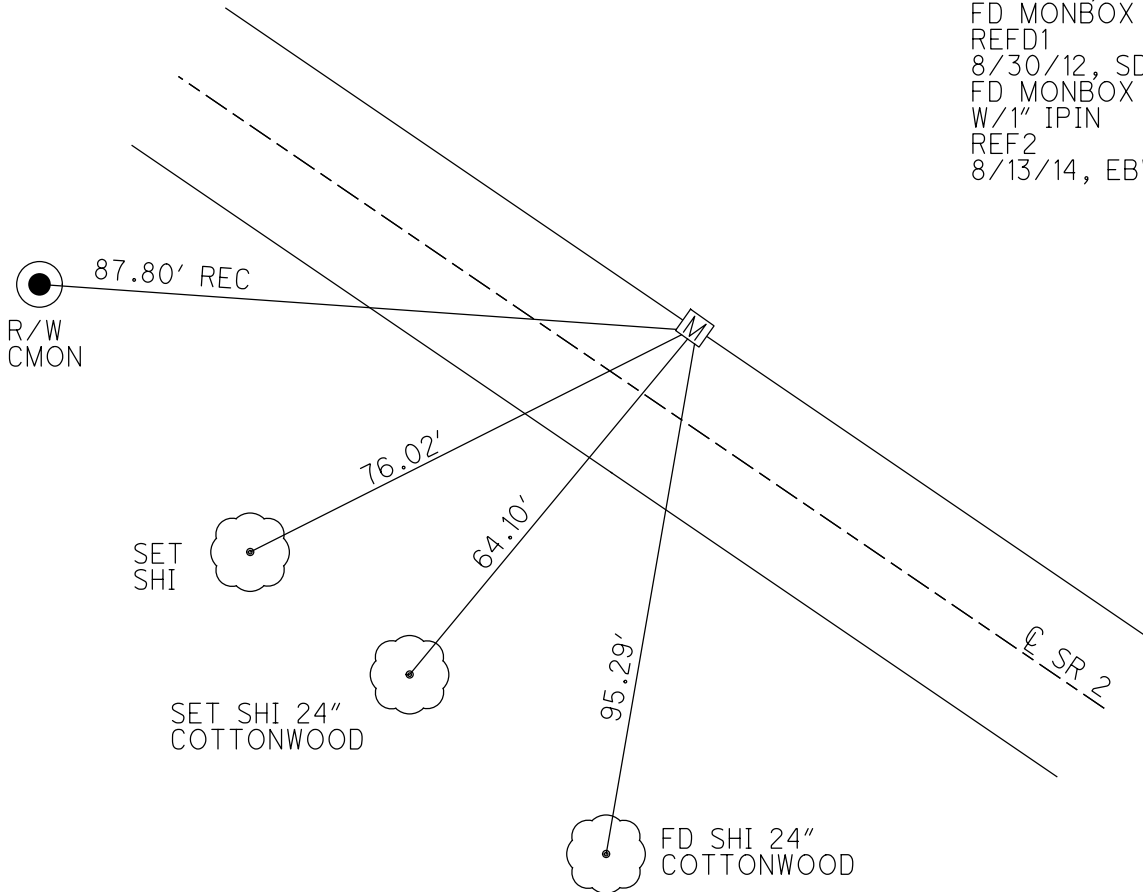

O.D.O.T. DISTRICT 2 SURVEY OFFICE (USE ONLY)

PERSONNEL _____ REFERENCE NO. 37 D SHEET 2 OF 3
 NOTES LEU DATE 8/13/14 ROUTE SR 2
 H.C. HOMAN WEATHER SUNNY COUNTY OTTAWA
 R.C. WESTFALL TEMP. 73° TOWNSHIP ERIE
 _____ SECTION 29
 _____ T 7 N R 14 E


TYPE MONUMENT MONBOX W/IPIN
 ON SURFACE - ~~BELOW~~ ON
 LEFT - ☉ PAV'T - ~~RIGHT~~ 12', EB ☉
0' TO LT EDGE PAVEMENT (EB)
 S.L.M. 797+85.16
 Grid: Northing: 683414.714 Easting: 1820823.096

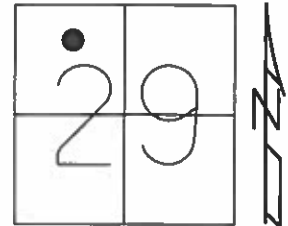


RECORD: P.I.
 P.I. IS ON R/W ☉
 SET P.K./WASHER
 9/16/98, CL&BC

FD MONBOX
 GPS, REF1
 8/30/12, SDC

FD MONBOX, W/1" IPIN
 GPS, REF2
 8/13/14, EBW

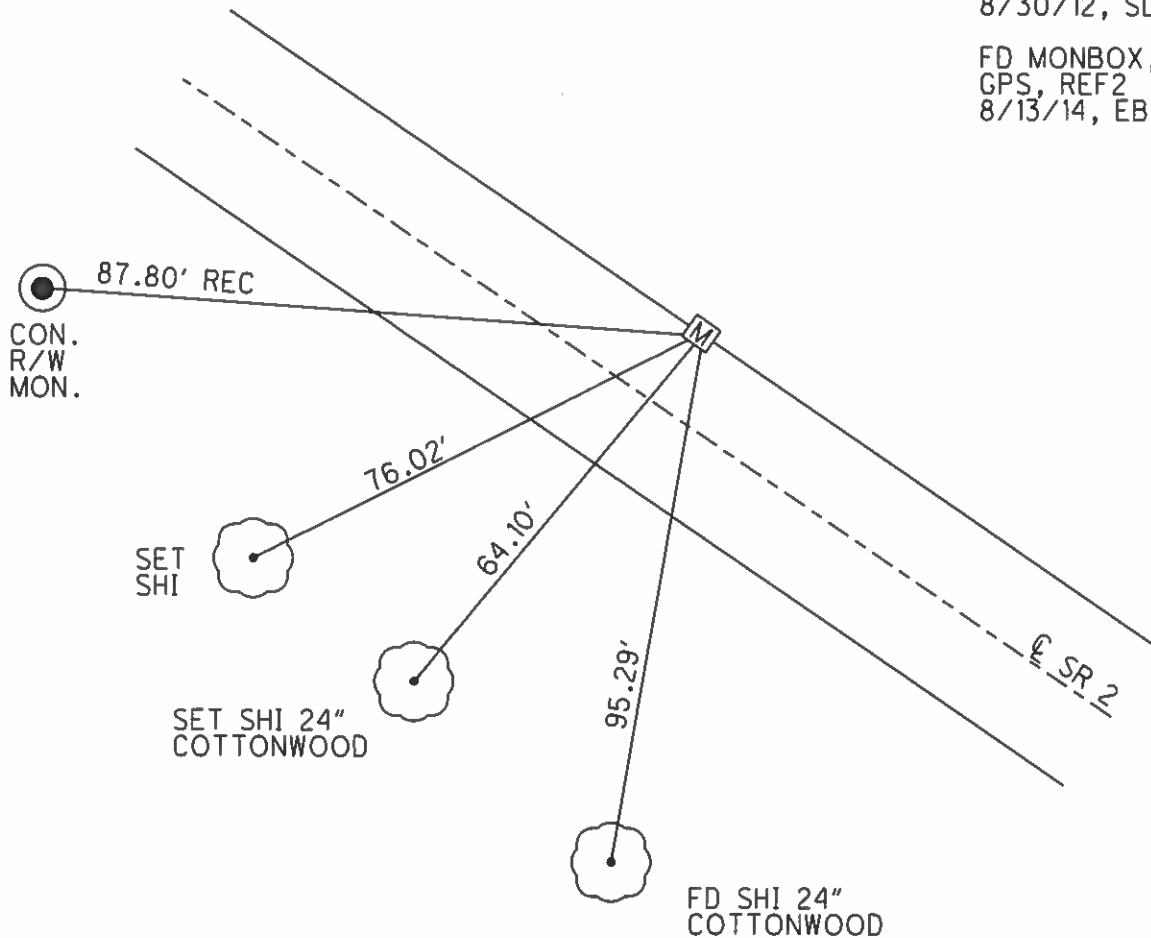

PERSONNEL	TITLE	PERSONNEL	TITLE	COUNTY	DATE
CRAIG LOEHRKE				OTT	10-8-99
TIM ROUSOS				S.R. 2	WEATHER CLOUDY
				SEC. 23, 24	TEMP +62°
DESCRIPTION Placement of New Boxes				JOB NO.	420120

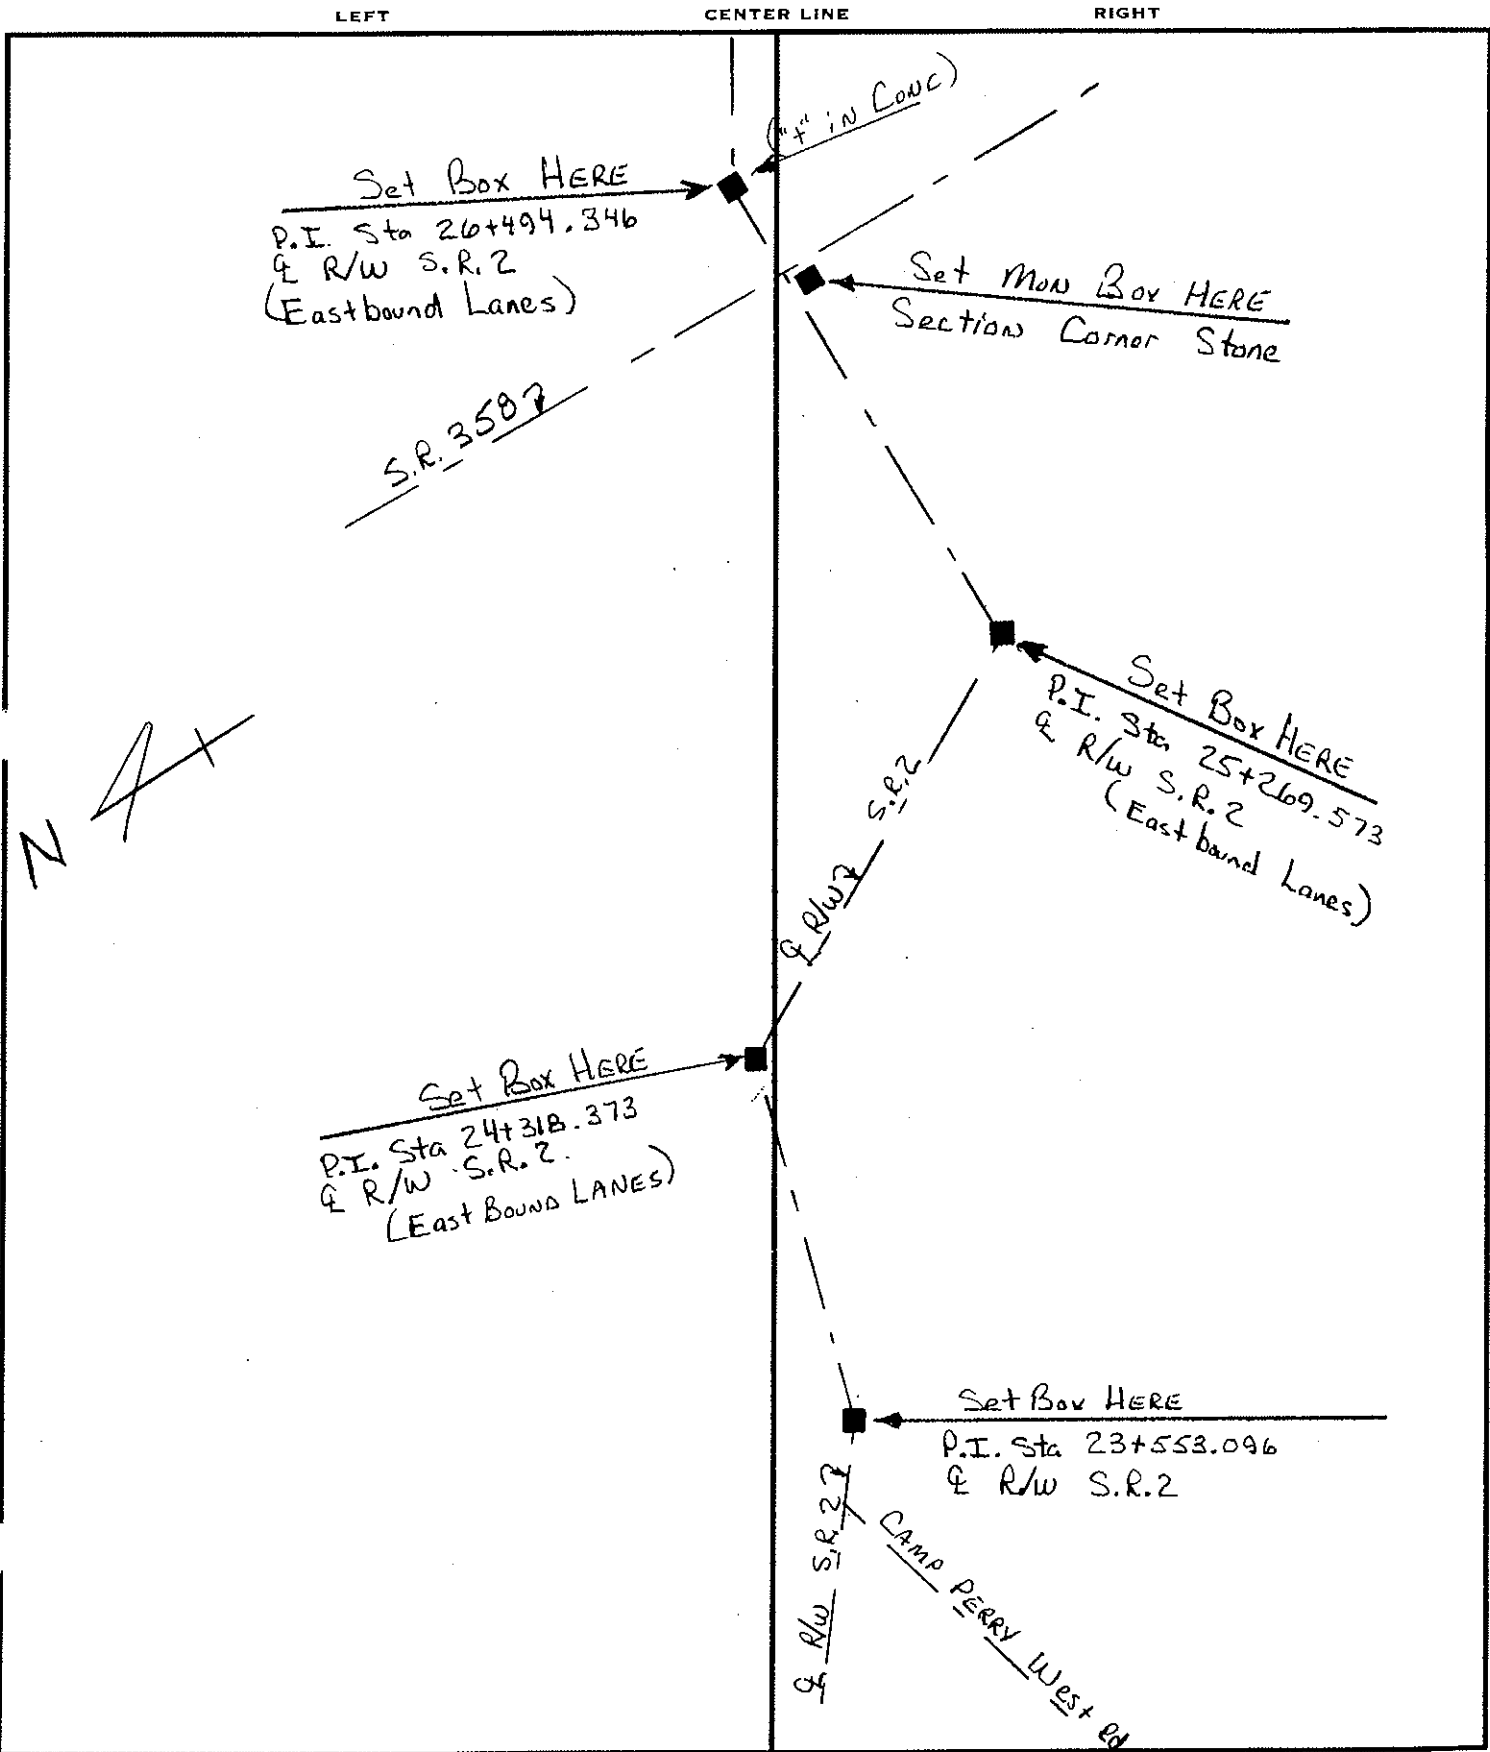

O.D.O.T. DISTRICT 2 SURVEY OFFICE

PERSONNEL

REFERENCE NO. 370

SHEET 3 OF

NOTES CORDES

H.C. LOEHERE

R.C. CORDES

DATE 9-16-98

WEATHER SUN

TEMP. 75

ROUTE Z

COUNTY OTTAWA

TOWNSHIP GRIS

SECTION 29

T2 N R 14 E

TYPE MONUMENT PK + WASHER


ON SURFACE YES

LEFT- - 8.0'


2.6' TO LT EDGE PAVEMENT

S.L.M. 24 + 318.373

370

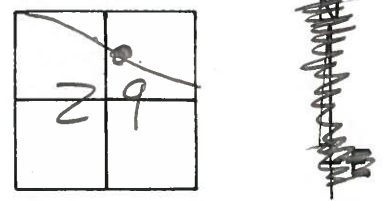

P.I.
PT # 307
NOTE
P.I. on
E R/W

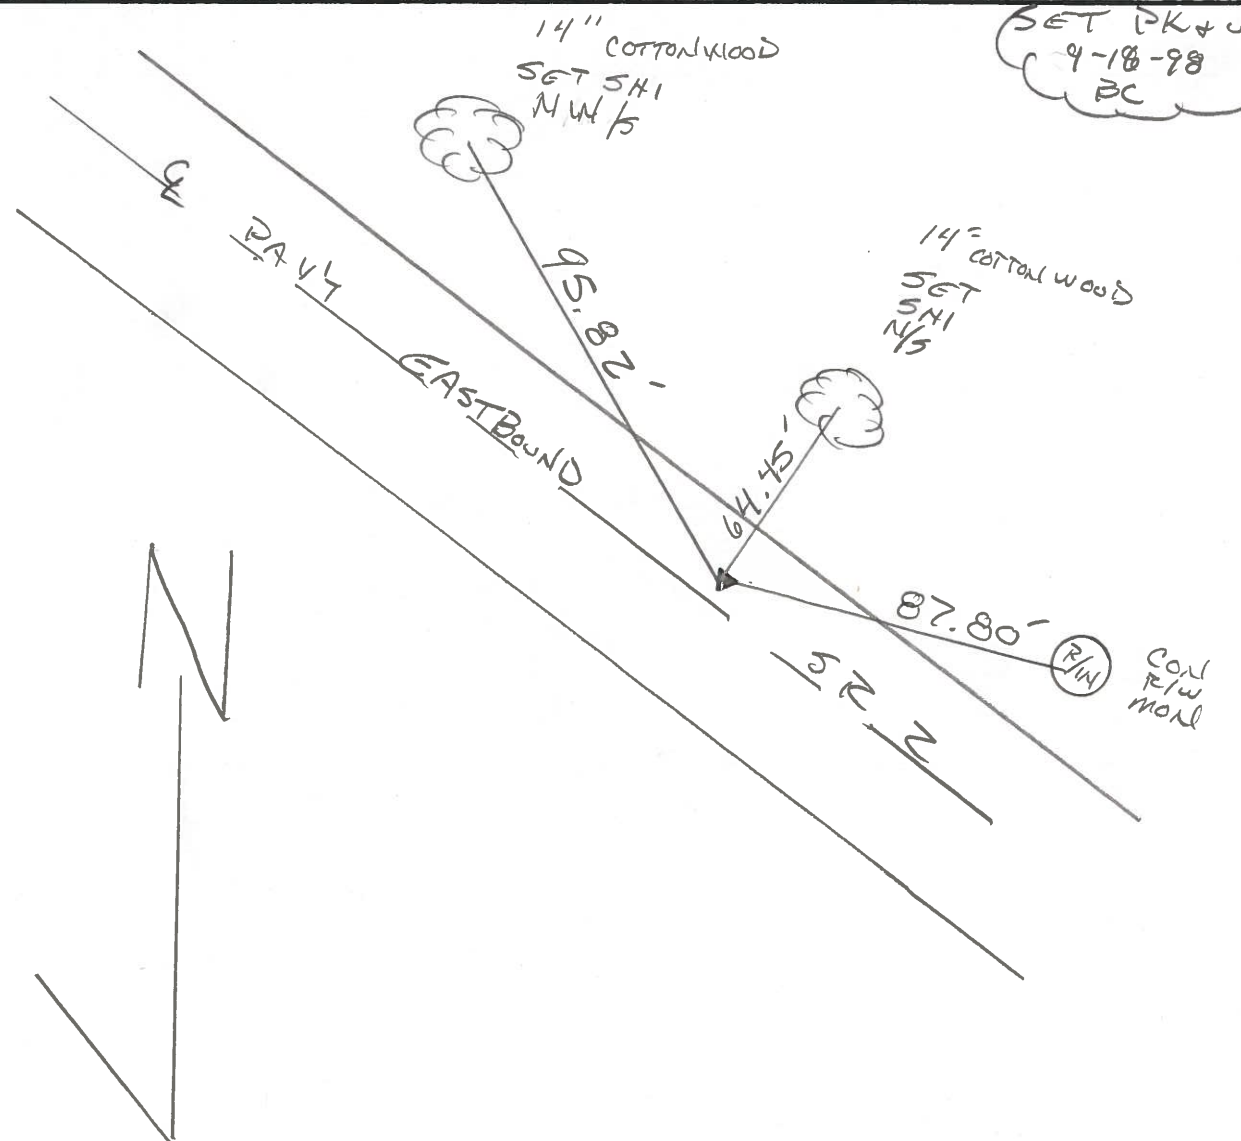

SET PK + WASHER
9-18-98
BC