

O.D.O.T. DISTRICT 2 SURVEY OFFICE (USE ONLY)

PERSONNEL

REFERENCE NO. 37 E

SHEET 25 OF 25

NOTES AUBLE

DATE 5-11-23

ROUTE SR 2

H.C. AUBLE

WEATHER CLOUDY

COUNTY OTTAWA

R.C. NIESE

TEMP. 59°

TOWNSHIP ERIE

ASTON

DWG BY RHOADES

PID 107959

SECTION 29

T 7 N R 14 E

TYPE MONUMENT MONBOX W/ 1" IPIN

ON SURFACE - ~~BELOW~~ ON

OFFSET 12.0' RT : RT

0.0' TO RT EDGE PAVEMENT


STATION: 829+04.55

HORZ.DATUM: NAD83(2011)


GEOID: NAVD88 2018

GRID: NORTHING: 681182.150

EASTING: 1823004.734

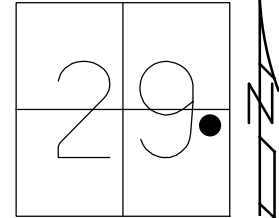


RECORD: P.I.
ON R/W CL
9/16/98, CL
FD P.K.NAIL
8/30/12, SDC
FD MONBOX
W/1" IPIN
8/13/14, EBW
FD MONBOX
W/1" IPIN
REFE37
1/21/21,
FD MONBOX
W/ 1" IPIN
REF 37E
5-11-23, DSA

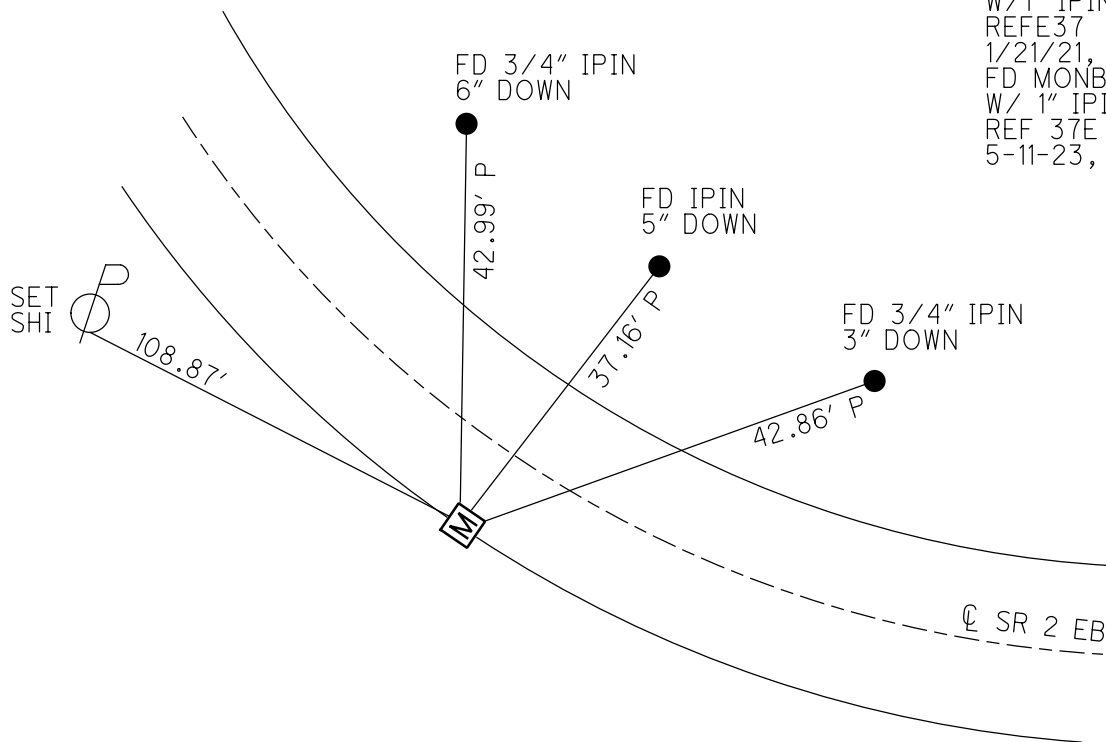


O.D.O.T. DISTRICT 2 SURVEY OFFICE (USE ONLY)

PERSONNEL _____ REFERENCE NO. 37 E SHEET 25 OF 25
 NOTES AUBLE DATE 5-11-23 ROUTE SR 2
 H.C. AUBLE WEATHER CLOUDY COUNTY OTTAWA
 R.C. NIESE TEMP. 59° TOWNSHIP ERIE
 ASTON SECTION 29
 DWG BY NIESE PID 107959 T 7 N R 14 E

TYPE MONUMENT MONBOX W/ 1" IPIN
 ON SURFACE - ~~BELOW~~ ON
 OFFSET \odot PAVEMENT 12.0' ~~LT~~ : RT
0.0' TO RT EDGE PAVEMENT
 STATION: 829+04.55
 HORZ.DATUM: NAD83(2011) GEOID: NAVD88 2018
 GRID: NORTHING: 681182.127 EASTING: 1823004.751

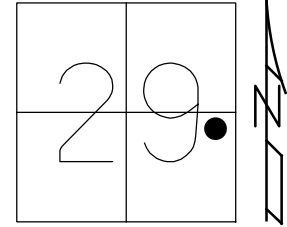



RECORD: P.I.
 ON R/W \odot
 9/16/98, CL
 FD P.K.NAIL
 8/30/12, SDC
 FD MONBOX
 W/1" IPIN
 8/13/14, EBW
 FD MONBOX
 W/1" IPIN
 REF37
 1/21/21,
 FD MONBOX
 W/ 1" IPIN
 REF 37E
 5-11-23, DSA

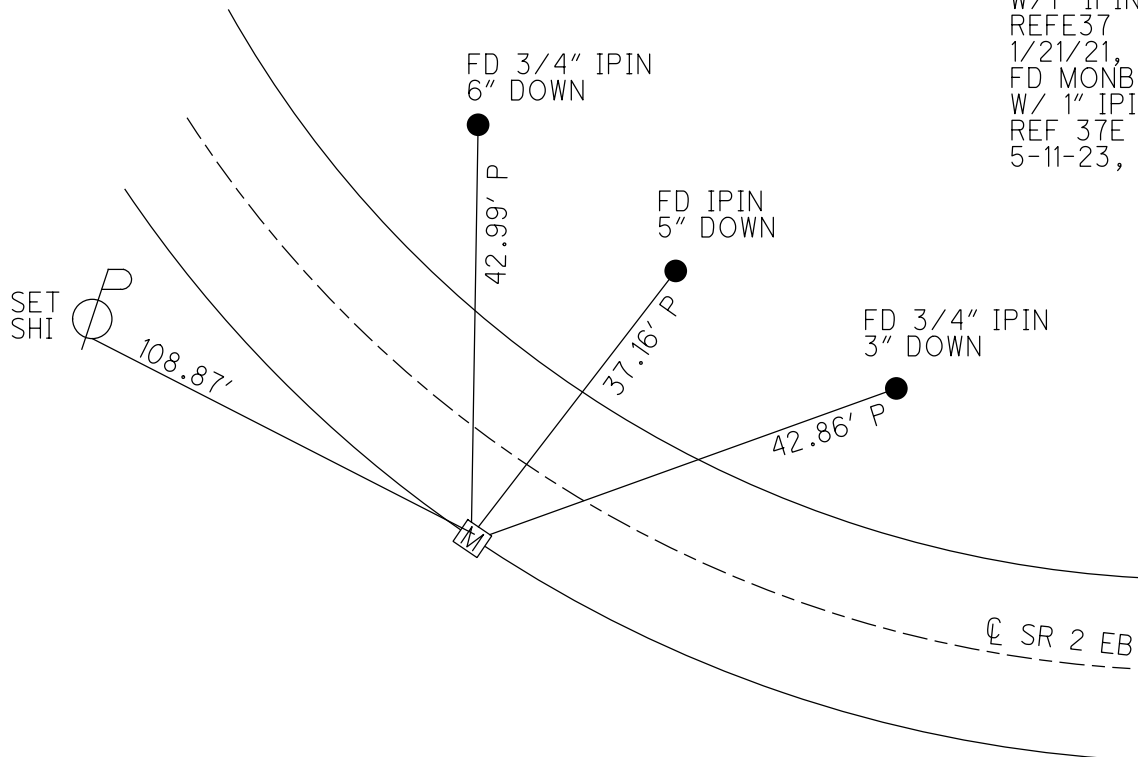

O.D.O.T. DISTRICT 2 SURVEY OFFICE (USE ONLY)

PERSONNEL _____ REFERENCE NO. 37 E SHEET 3 OF 3
 NOTES LEU DATE 8/13/14 ROUTE SR 2
 H.C. HOMAN WEATHER SUNNY COUNTY OTTAWA
 R.C. WESTFALL TEMP. 65° TOWNSHIP ERIE
 _____ SECTION 29
 _____ T 7 N R 14 E

TYPE MONUMENT MONBOW, W/1" IPIN
 ON SURFACE - ~~BELOW~~ ON
~~LEFT~~ - ☉ PAV'T - RIGHT 12'
0' TO RT EDGE PAVEMENT
 S.L.M. 829+05.67, 1300'± TETTAU RD
 Grid: Northing: 681182.127 Easting: 1823004.751

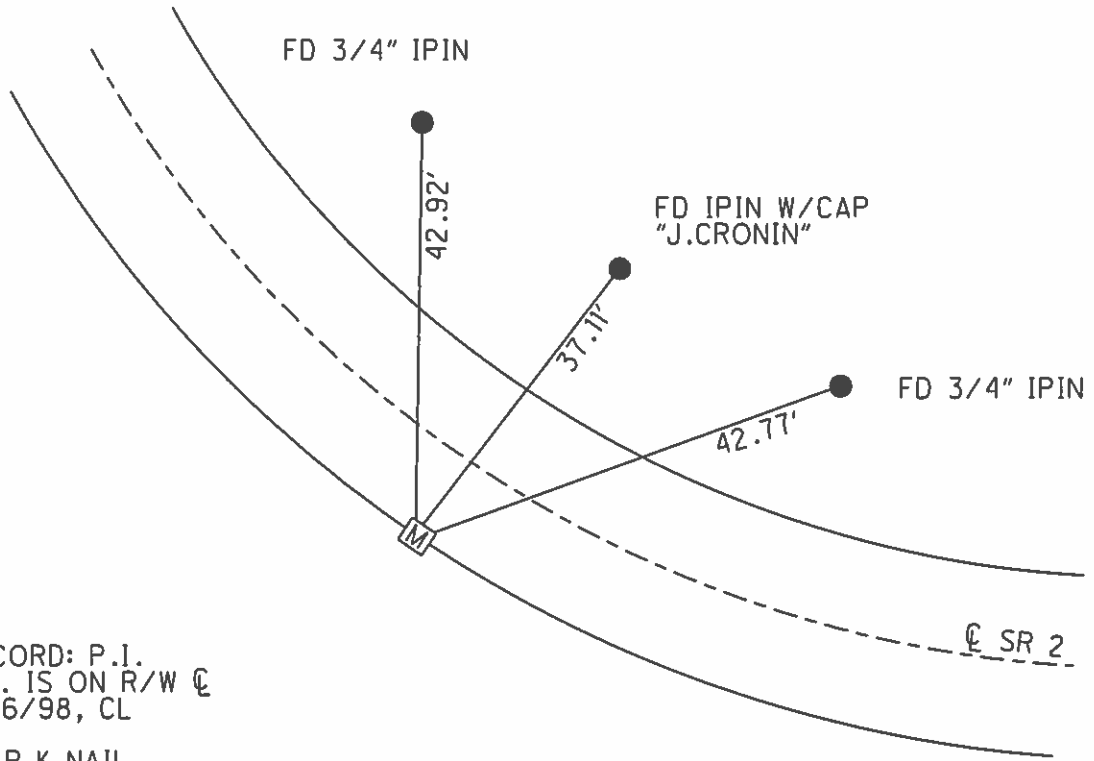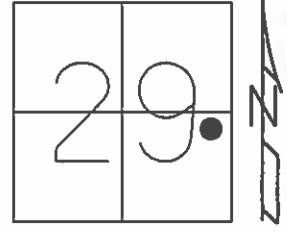


RECORD: P.I.
 P.I. IS ON R/W ☉
 9/16/98, CL

 FD P.K.NAIL
 GPS, REF1
 8/30/12, SDC

 FD MONBOX, W/1" IPIN
 GPS, REF3
 8/13/14, EBW

PERSONNEL	TITLE	PERSONNEL	TITLE	COUNTY	DATE
CRAIG LOEHRKE				OTT	10-8-99
TIM ROUSOS				S.R. 2	WEATHER CLOUDY
				SEC. 23, 240	TEMP +62°
DESCRIPTION Placement of New Boxes					JOB NO. 420120

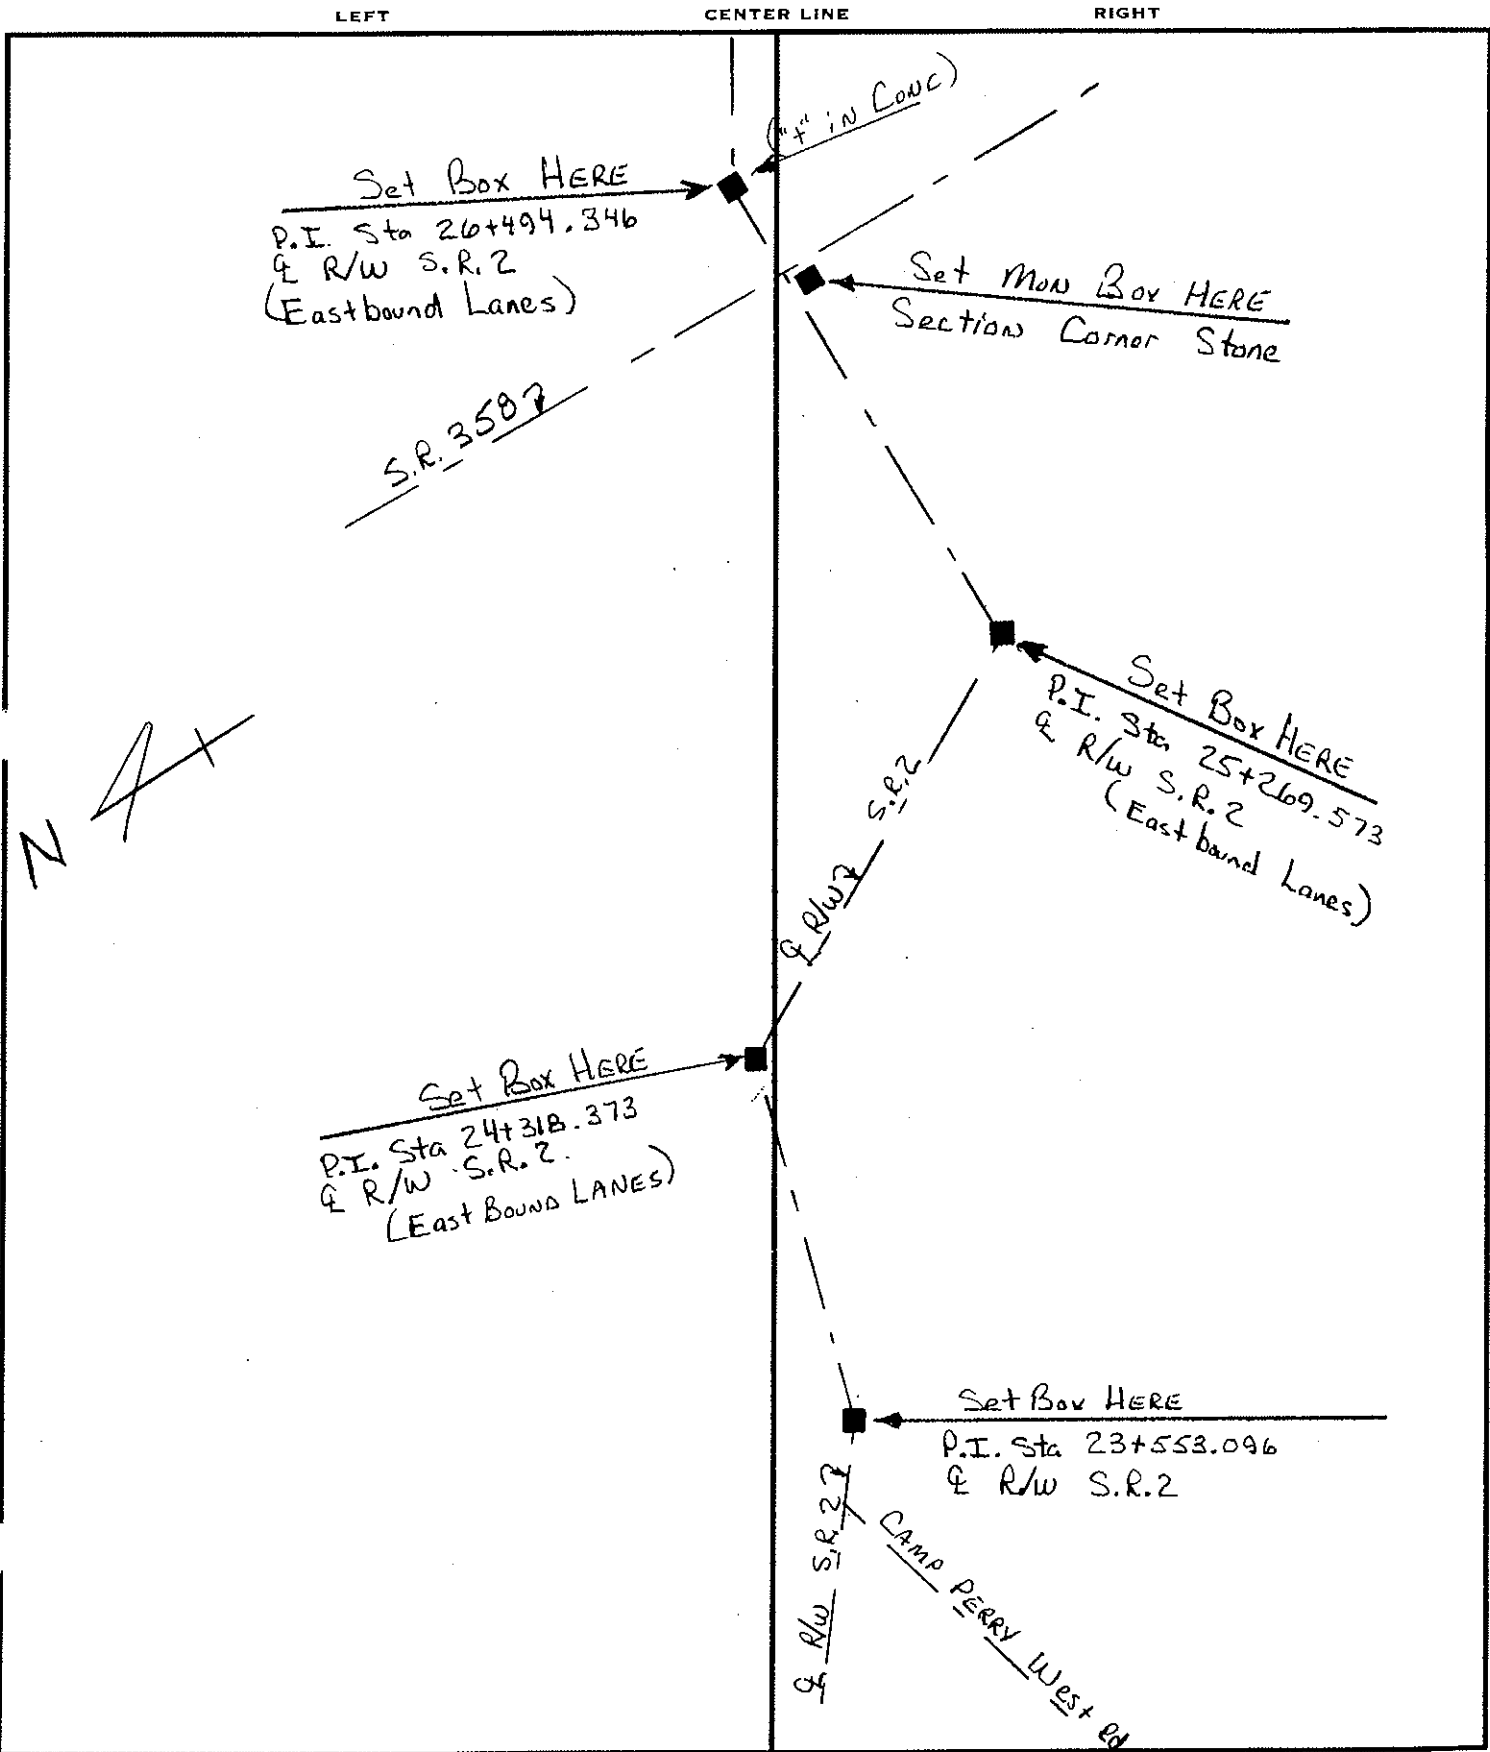

O.D.O.T. DISTRICT 2 SURVEY OFFICE

PERSONNEL _____

REFERENCE NO. 37D

SHEET 4 OF _____

NOTES LOEHRKE

H.C. CORDES

R.C. _____

DATE 9-16-98

WEATHER Wet

TEMP. +76°

ROUTE S.R. 2

COUNTY OTTAWA

TOWNSHIP ERIE

SECTION 29

T 7 N R 14 E

37E


TYPE MONUMENT Set P.K. NAIL

ON SURFACE - ~~BELOW~~ Yes

~~LEFT - & PAV'T. - RIGHT~~ 9.3' Rt

2.7 TO Rt EDGE PAVEMENT

S.L.M. 25+269.573

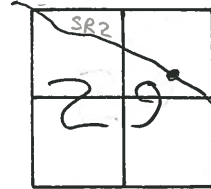

P.I LARGE Curve East of
Tattav Rd. & R/W

