

O.D.O.T. DISTRICT 2 SURVEY OFFICE (USE ONLY)

PERSONNEL

REFERENCE NO. 48

SHEET 14 OF 45

NOTES RHOADES

DATE 1/28/21

ROUTE SR 2

H.C. AUBLE

WEATHER CLOUDY

COUNTY OTTAWA

R.C. _____

TEMP. 22°

TOWNSHIP BAY

DWG BY NIESE PID 107959

SECTION 2

T 6 N R 16 E

TYPE MONUMENT FD 3 1/2" DISK ATOP CBAR

ON SURFACE - ~~BELOW~~ ON

OFFSET \varnothing PAVEMENT ON LT : RT

- TO - EDGE PAVEMENT


STATION: 979+12.85

HORZ.DATUM: NAD83(2011)


GEOID: NAVD88 2018

GRID: NORTHING: 672124.955

EASTING: 1834901.438

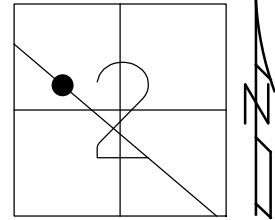

RECORD: P.O.T.
FROM 1963 PLAN
STA 135+00
FD 3 1/2" DISK
ATOP CBAR
CL11
1/28/21, DSA

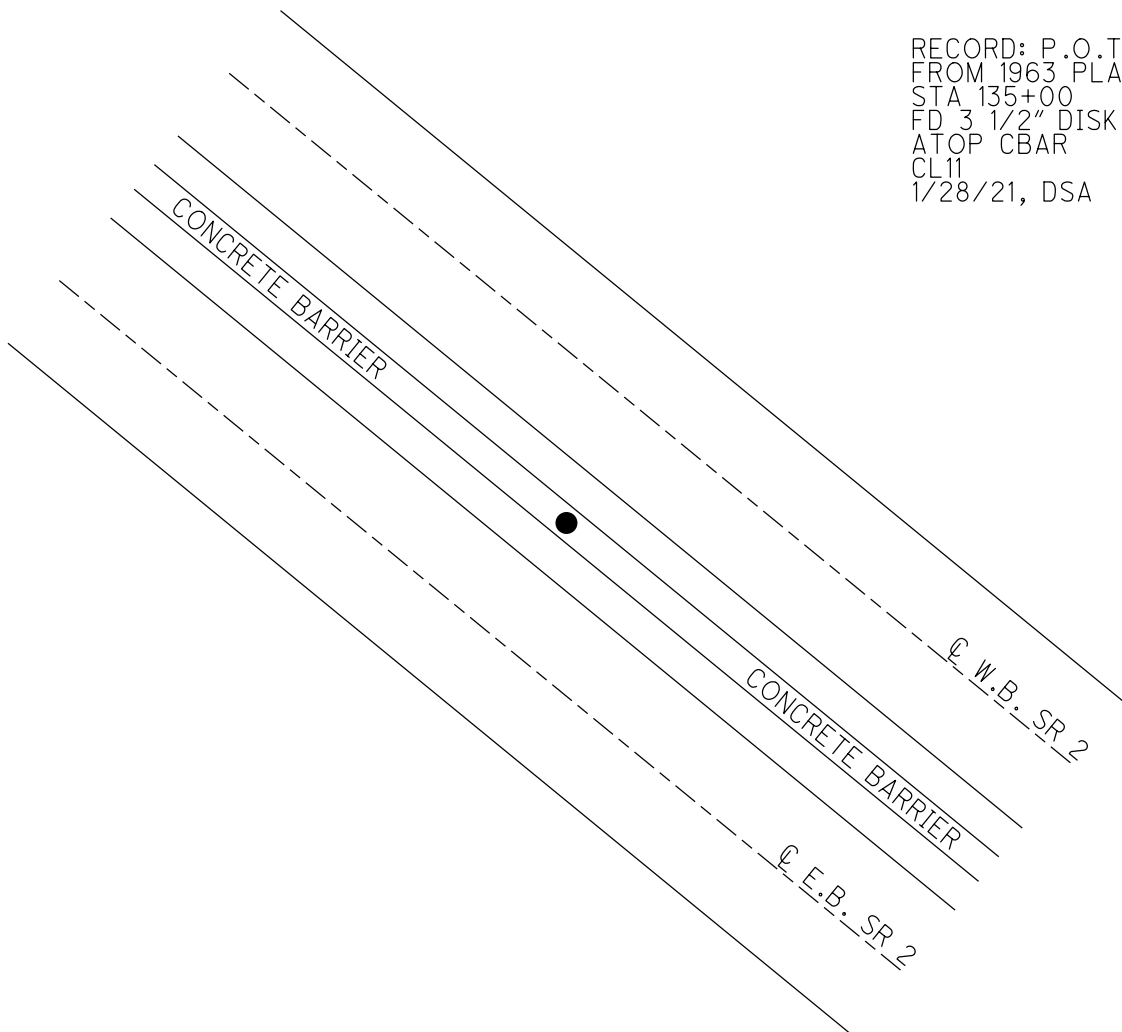

PERSONNEL	TITLE	PERSONNEL	TITLE

SHEET NO. 4
 DATE 1-3-73
 WEATHER cloudy
 TEMP. 350

COUNTY Ottawa
 S. R. 2
 SEC. 16.48

DESCRIPTION SEC-2 Bay Twp.

LEFT	CENTER LINE	RIGHT	JOB NO.
P.O.T. 176+00 Mon. Box set in conc.			
P.O.T. 168+00 Mon. Box set in conc.			
P.O.T. 160+00 Mon. Box set in conc.			
P.O.T. 157+00 Mon. Box set in conc.			
P.O.T. 143+00 Mon. Box set in conc.			
P.O.T. 135+00 Mon. Box set in conc.			
P.O.T. 127+00 Mon. Box set in conc.			

