


O.D.O.T. DISTRICT 2 SURVEY OFFICE (USE ONLY)


PERSONNEL _____ REFERENCE NO. 50 SHEET 16 OF 45
NOTES RHOADES DATE 1/28/21 ROUTE SR 2
H.C. AUBLE WEATHER CLOUDY COUNTY OTTAWA
R.C. _____ TEMP. 22° TOWNSHIP BAY
DWG BY NIESE PID 107959 SECTION 2
T 6 N R 16 E

TYPE MONUMENT FD 3 1/2" DISK ATOP CBAR
ON SURFACE - ~~BELOW~~ ON
OFFSET \varnothing PAVEMENT ON LT : RT
- TO - EDGE PAVEMENT
STATION: 995+12.84

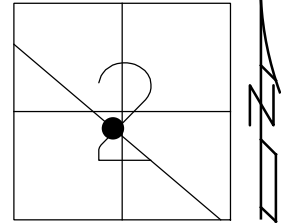

HORIZ.DATUM: NAD83(2011) GEOID: NAVD88 2018
GRID: NORTHING: 671088.087 EASTING: 1836119.978

RECORD: P.O.T.
FROM 1963 PLAN
STA 151+00
FD 3 1/2" DISK
ATOP CBAR
CL13
1/28/21, DSA

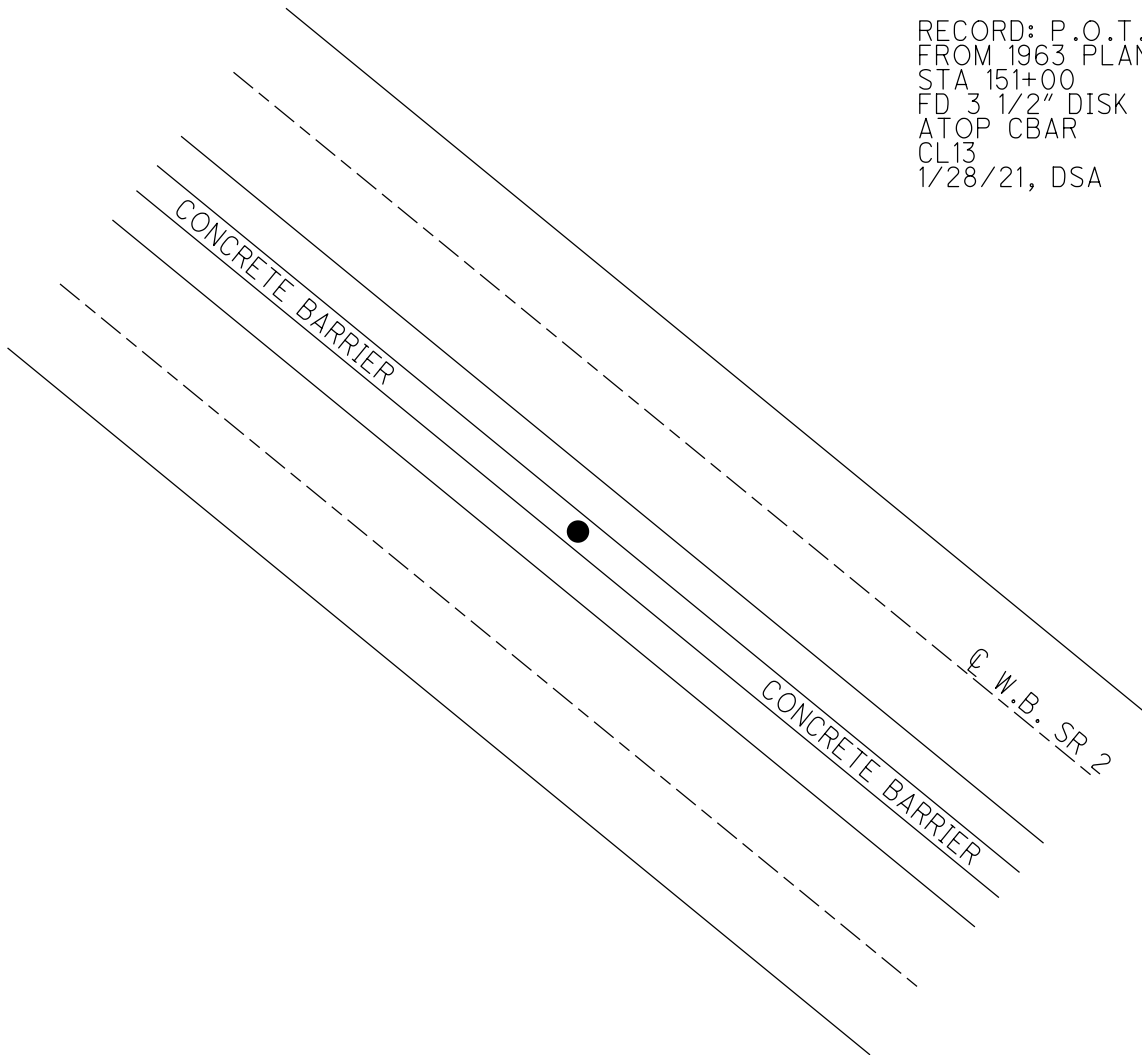

PERSONNEL	TITLE	PERSONNEL	TITLE

SHEET NO. 4
 COUNTY Ottawa DATE 1-3-73
 S. R. 2 WEATHER Cold-clear
 SEC. 16.48 TEMP. 350

DESCRIPTION SEC-2 Bay Twp. JOB NO. _____
 LEFT CENTER LINE RIGHT

P.O.T.
 176+00
 Mon. Box set in CONC-

P.O.T.
 168+00
 Mon. Box set in CONC.

P.O.T.
 160+00
 Mon. Box set in CONC-

P.O.T.
 157+00
 Mon. Box set in CONC.

P.O.T.
 143+00
 Mon. Box set in CONC-

P.O.T.
 135+00
 Mon. Box set in CONC.

P.O.T.
 127+00
 Mon. Box set in CONC-

