

O.D.O.T. DISTRICT 2 SURVEY OFFICE (USE ONLY)

PERSONNEL

REFERENCE NO. 51


SHEET 17 OF 45

NOTES RHOADES DATE 1/28/21
H.C. AUBLE WEATHER CLOUDY
R.C. _____ TEMP. 22°

ROUTE SR 2
COUNTY OTTAWA
TOWNSHIP BAY
SECTION 2
T 6 N R 16 E

DWG BY NIESE PID 107959

TYPE MONUMENT FD 3 1/2" DISK ATOP CBAR
ON SURFACE - ~~BELOW~~ ON
OFFSET Q PAVEMENT ON LT : RT
- TO - EDGE PAVEMENT
STATION: 1004+12.88

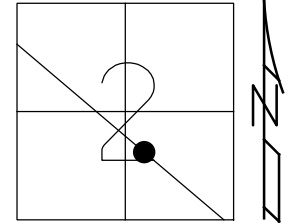


HORIZ.DATUM: NAD83(2011)

GEOID: NAVD88 2012A

GRID: NORTHING: 670504.661

EASTING: 1836805.318

RECORD: P.O.T.
FROM 1963 PLAN
STA 160+00
FD 3 1/2" DISK
ATOP CBAR
CL14
1/28/21, DSA

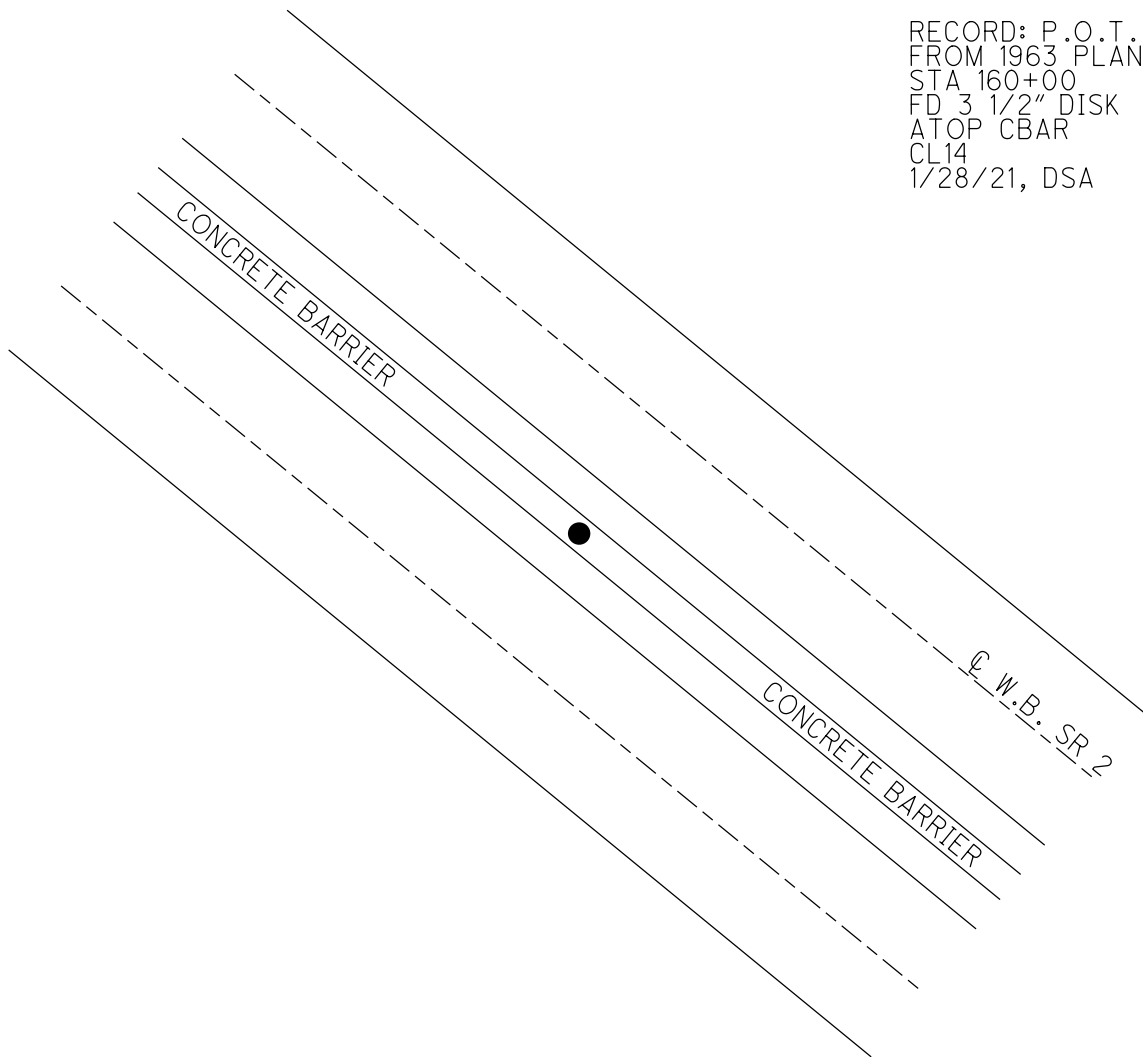

PERSONNEL	TITLE	PERSONNEL	TITLE

SHEET NO. 4
 COUNTY Ottawa DATE 1-3-73
 S. R. 2 WEATHER Cold-clear
 SEC. 16.48 TEMP. 350

DESCRIPTION SEC-2 Bay Twp. JOB NO. _____

LEFT	CENTER LINE	RIGHT
P.O.T. 176+00 Mon. Box set in conc.		
P.O.T. 168+00 Mon. Box set in conc.		
P.O.T. 160+00 Mon. Box set in conc.		
P.O.T. 157+00 Mon. Box set in conc.		
P.O.T. 143+00 Mon. Box set in conc.		
P.O.T. 135+00 Mon. Box set in conc.		
P.O.T. 127+00 Mon. Box set in conc.		

