



O.D.O.T. DISTRICT 2 SURVEY OFFICE (USE ONLY)

PERSONNEL _____ REFERENCE NO. 52 SHEET 18 OF 45
NOTES RHOADES DATE 1/28/21 ROUTE SR 2
H.C. AUBLE WEATHER CLOUDY COUNTY OTTAWA
R.C. _____ TEMP. 22° TOWNSHIP BAY
DWG BY NIESE PID 107959 SECTION 2
T 6 N R 16 E

TYPE MONUMENT FD 3 1/2" DISK ATOP CBAR
ON SURFACE - ~~BELOW~~ ON
OFFSET ☉ PAVEMENT ON LT : RT
- TO - EDGE PAVEMENT
STATION: 1012+12.82

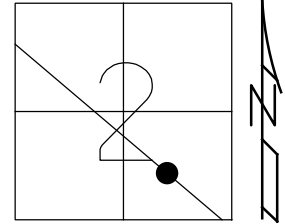

HORZ. DATUM: NAD83(2011) GEOID: NAVD88 2018
GRID: NORTHING: 669986.345 EASTING: 1837414.611

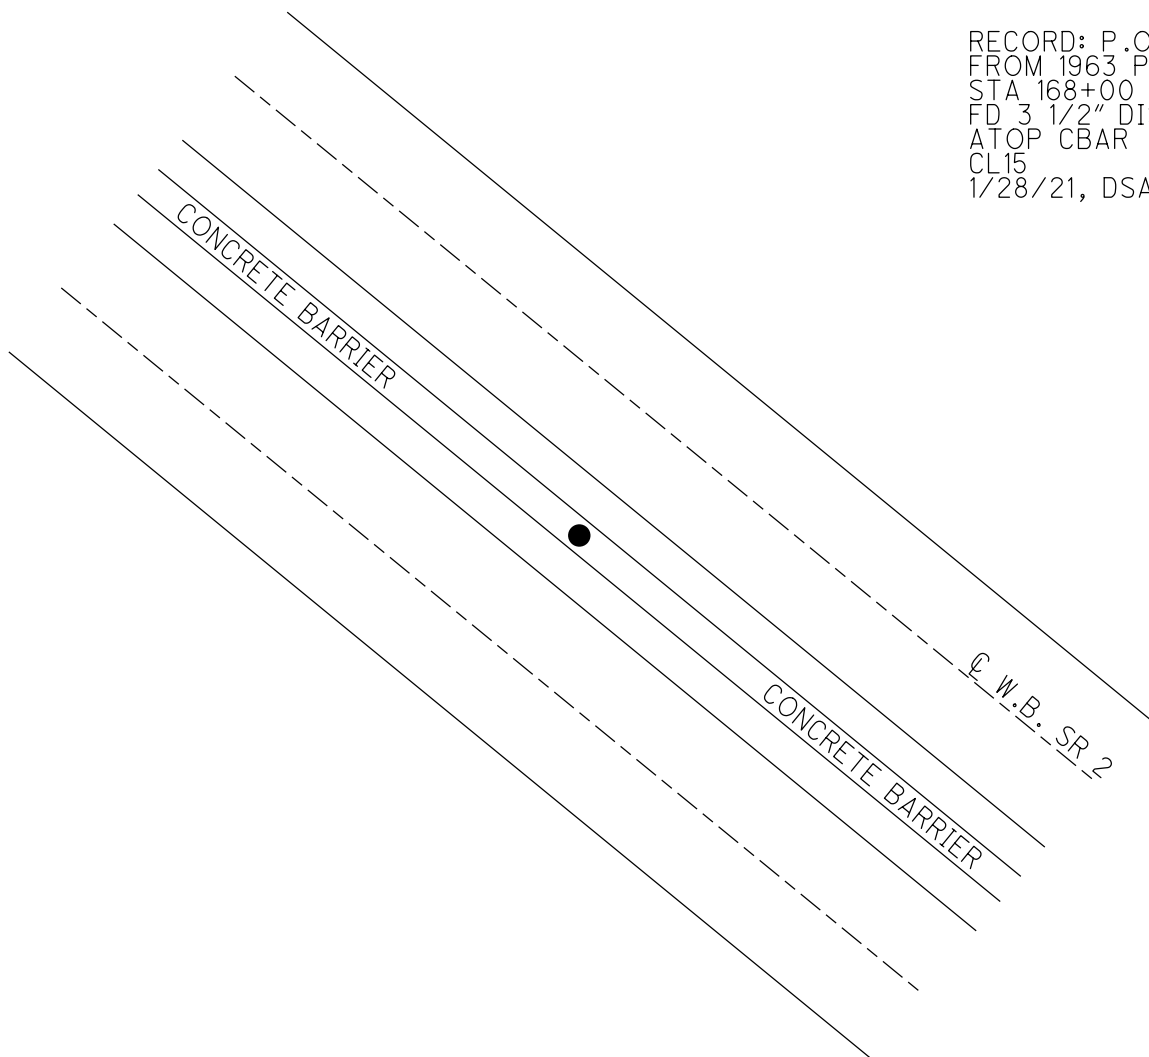

RECORD: P.O.T.
FROM 1963 PLAN
STA 168+00
FD 3 1/2" DISK
ATOP CBAR
CL15
1/28/21, DSA

PERSONNEL	TITLE	PERSONNEL	TITLE

SHEET NO. 4
 COUNTY Ottawa DATE 1-3-73
 S. R. 2 WEATHER Cold-clear
 SEC. 16.48 TEMP. 350

DESCRIPTION SEC-2 Bay Twp. JOB NO.

LEFT	CENTER LINE	RIGHT
P.O.T. 176+00 Mon. Box set in CONC-		
P.O.T. 168+00 Mon. Box set in CONC.		
P.O.T. 160+00 Mon. Box set in CONC-		
P.O.T. 157+00 Mon. Box set in CONC.		
P.O.T. 143+00 Mon. Box set in CONC-		
P.O.T. 135+00 Mon. Box set in CONC-		
P.O.T. 127+00 Mon. Box set in CONC-		

