

O.D.O.T. DISTRICT 2 SURVEY OFFICE (USE ONLY)

PERSONNEL

REFERENCE NO. 54

SHEET 20 OF 45

NOTES RHOADES

DATE 1/28/21

ROUTE SR 2

H.C. AUBLE

WEATHER CLOUDY

COUNTY OTTAWA

R.C. _____

TEMP. 22°

TOWNSHIP BAY

DWG BY NIESE PID 107959

SECTION 2

T 6 N R 16 E

TYPE MONUMENT FD 3 1/2" DISK ATOP CBAR

ON SURFACE - ~~BELOW~~ ON

OFFSET CL PAVEMENT ON LT : RT

- TO - EDGE PAVEMENT


STATION: 1028+11.77

HORZ.DATUM: NAD83(2011)


GEOID: NAVD88 2018

GRID: NORTHING: 668949.874

EASTING: 1838632.136

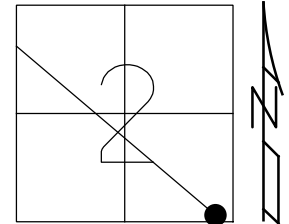

RECORD: P.O.T.
SET MONBOX
IN CONC
STA 184+00
1/5/73
FD 3 1/2" DISK
ATOP CBAR
CL17
1/28/21, DSA

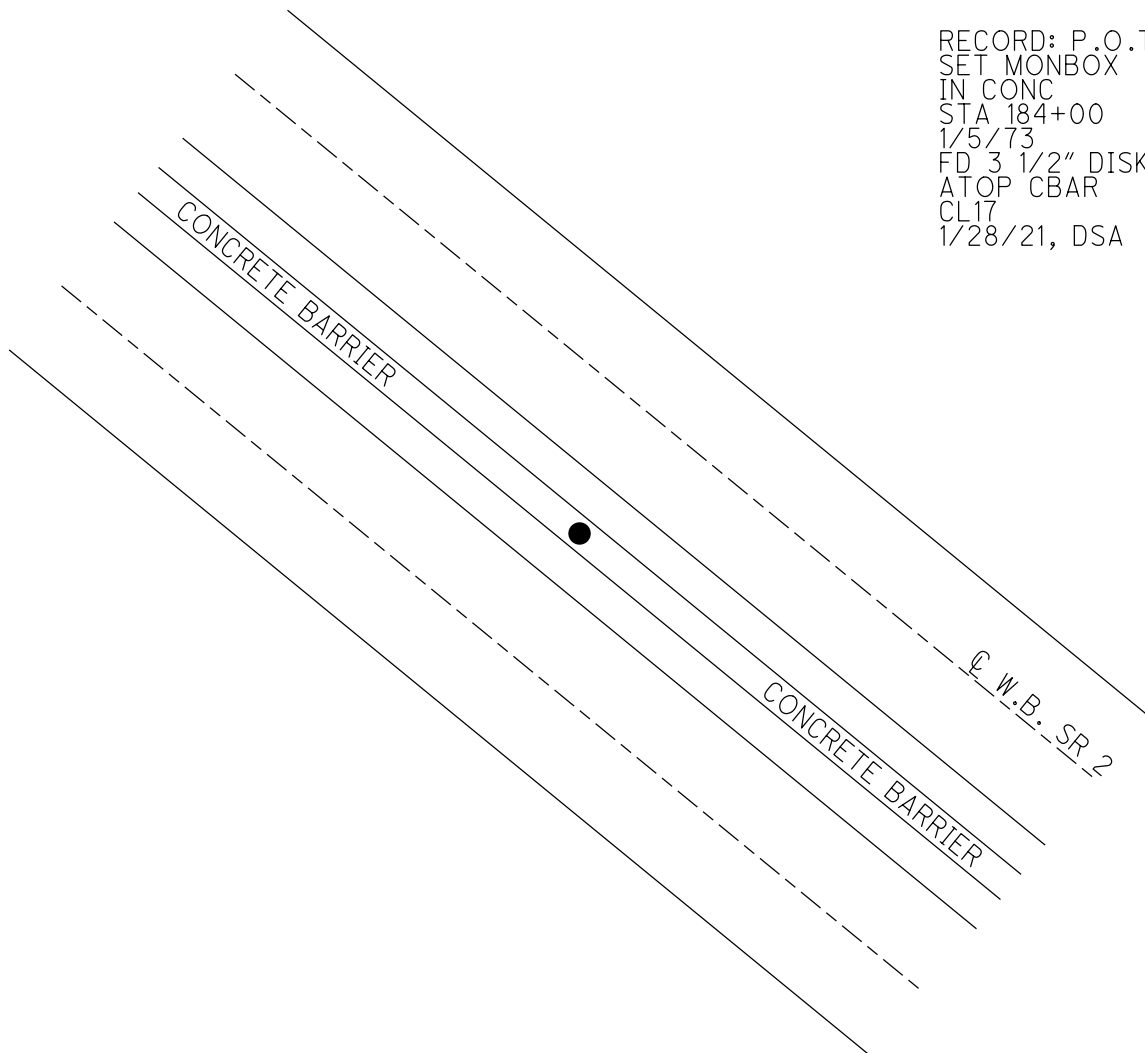

PERSONNEL TITLE PERSONNEL TITLE
 Schneider _____
 Mosser _____
 Barbour _____
 Geyman _____

COUNTY Ottawa DATE 1-5-73
 S. R. 2 WEATHER cloudy-windy
 SEC. 19.60 TEMP. 20°

DESCRIPTION sec 2-11 & 12 Bay Twp. JOB NO. _____

