

O.D.O.T. DISTRICT 2 SURVEY OFFICE (USE ONLY)

PERSONNEL

REFERENCE NO. 55

SHEET 21 OF 45


NOTES RHOADES DATE 1/29/21
H.C. AUBLE WEATHER CLOUDY
R.C. _____ TEMP. 30°

ROUTE SR 2
COUNTY OTTAWA
TOWNSHIP BAY
SECTION 11

DWG BY NIESE PID 107959

T 6 N R 16 E

TYPE MONUMENT FD 3 1/2" DISK ATOP CBAR
ON SURFACE - ~~BELOW~~ ON
OFFSET CL PAVEMENT ON LT : RT
- TO - EDGE PAVEMENT
STATION: 1035+65.51

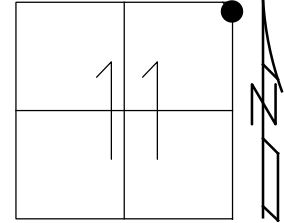


HORIZ.DATUM: NAD83(2011)

GEOID: NAVD88 2018

GRID: NORTHING: 668461.431

EASTING: 1839206.609

RECORD: P.C.
FROM 1963 PLAN
STA 191+54.28
" + " IN CONC
1/5/73
FD 3 1/2" DISK
ATOP CBAR
CL42
1/28/21, DSA

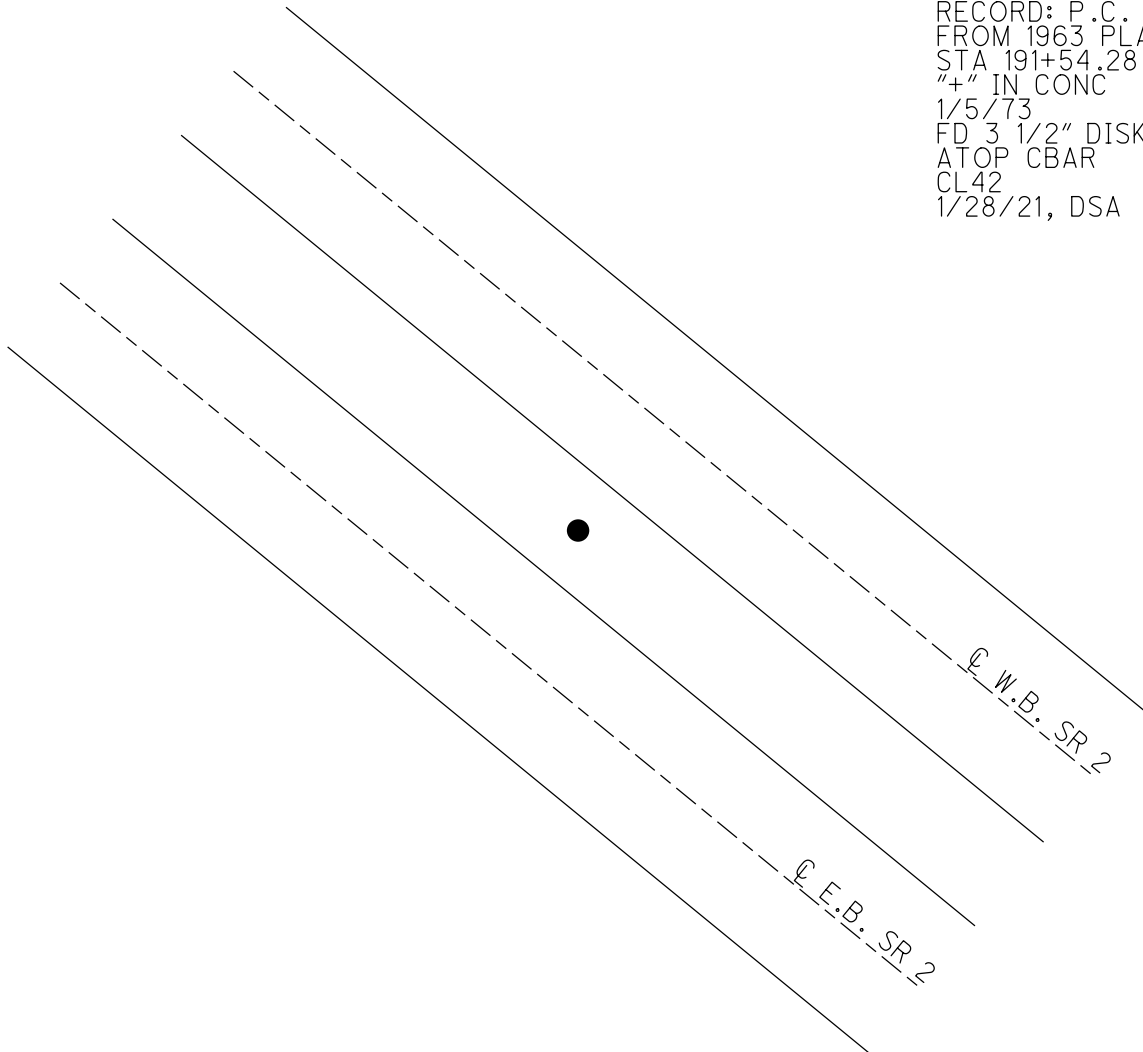

PERSONNEL TITLE PERSONNEL TITLE
 Schneider _____
 Mosser _____
 Barbour _____
 Geyman _____

COUNTY Ottawa DATE 1-5-73
 S. R. 2 WEATHER cloudy-windy
 SEC. 19.60 TEMP. 20°

DESCRIPTION sec 2-11 & 12 Bay Twp. JOB NO. _____

