

O.D.O.T. DISTRICT 2 SURVEY OFFICE (USE ONLY)

PERSONNEL

REFERENCE NO. 62

SHEET 27 OF 45

NOTES RHOADES

DATE 1/19/21

ROUTE SR 2

H.C. AUBLE

WEATHER CLOUDY

COUNTY OTTAWA

R.C. \_\_\_\_\_

TEMP. 30°

TOWNSHIP PORTAGE

DWG BY NIESE PID 107959

SECTION 7

T 6 N R 17 E

TYPE MONUMENT CMON

ON SURFACE - ~~BELOW~~ ON

OFFSET ☉ PAVEMENT ON LT : RT

- TO - EDGE PAVEMENT


STATION: 1101+88.15

HORIZ.DATUM: NAD83(2011)


GEOID: NAVD88 2018

GRID: NORTHING: 667609.366

EASTING: 1845605.616

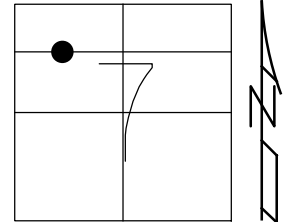

RECORD: P.C.  
FROM 1963 PLAN  
STA 257+75.74  
FD CMON W/  
BROKEN CONCRETE  
CL23  
CALC P.C.  
STA.1101+79.99  
1/21/21, DSA

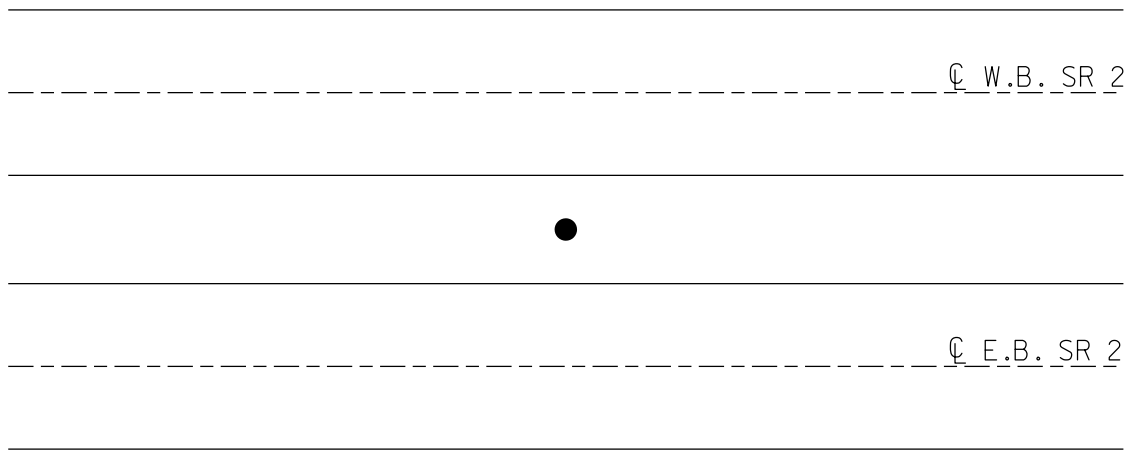

PERSONNEL	TITLE	PERSONNEL	TITLE	COUNTY	Ottawa	DATE	1-17-73
<u>Schneider</u>				S. R.	2	WEATHER	Fair-Windy
<u>Mosser</u>				SEC.	19.60	TEMP.	55°
<u>Barbour</u>				DESCRIPTION	Portage Twp. Sec-7		JOB NO.
<u>Geyman</u>							

