


O.D.O.T. DISTRICT 2 SURVEY OFFICE (USE ONLY)


PERSONNEL _____ REFERENCE NO. 65 SHEET 28 OF 45
 NOTES RHOADES DATE 1/19/21 ROUTE SR 2
 H.C. AUBLE WEATHER CLOUDY COUNTY OTTAWA
 R.C. _____ TEMP. 30° TOWNSHIP PORTAGE
 _____ SECTION 7
 DWG BY NIESE PID 107959 T 6 N R 17 E

TYPE MONUMENT 1/2" IPIN
 ON SURFACE - ~~BELOW~~ ON
 OFFSET ☐ PAVEMENT ON LT : RT
- TO - EDGE PAVEMENT
 STATION: 1123+34.35

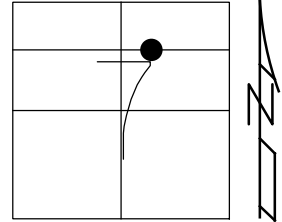

HORZ.DATUM: NAD83(2011) GEOID: NAVD88 2018
 GRID: NORTHING: 667569.000 EASTING: 1847751.269

RECORD: P.O.T.
 FROM 1963 PLAN
 STA 280+00
 FD CMON
 W/ 1/2" IPIN
 1/18/73
 FD 1/2" IPIN
 CL24
 1/21/21, DSA

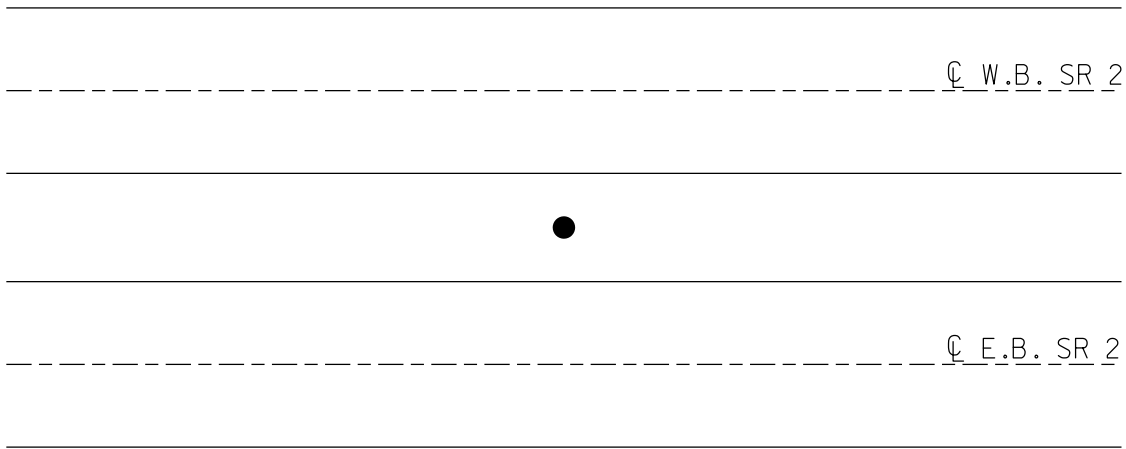

PERSONNEL	TITLE	PERSONNEL	TITLE
Schneider			
Mosser			
Barbour			
Geyman			

COUNTY Ottawa DATE 1-18-73
 S. R. 2 WEATHER Fair
 SEC. 19.60 TEMP. 50°

DESCRIPTION Sec-7 Portage Twp. JOB NO. _____

