

O.D.O.T. DISTRICT 2 SURVEY OFFICE (USE ONLY)

PERSONNEL

REFERENCE NO. 66

SHEET 29 OF 45

NOTES RHOADES

DATE 1/19/21

ROUTE SR 2

H.C. AUBLE

WEATHER CLOUDY

COUNTY OTTAWA

R.C. \_\_\_\_\_

TEMP. 30°

TOWNSHIP PORTAGE

DWG BY NIESE PID 107959

SECTION 7

T 6 N R 17 E


TYPE MONUMENT CMON

ON SURFACE - ~~BELOW~~ ON

OFFSET ☉ PAVEMENT ON LT : RT

- TO - EDGE PAVEMENT

STATION: 1133+77.42

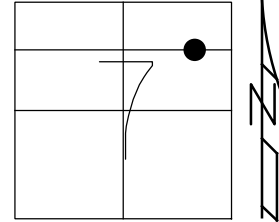


HORZ.DATUM: NAD83(2011)

GEOID: NAVD88 2018

GRID: NORTHING: 667540.252

EASTING: 1848792.960

RECORD: P.O.T.  
FROM 1963 PLAN  
STA 290+00  
FD CMON  
W/ 1/2" IPIN  
1/18/73  
FD CMON  
CL25  
1/21/21, DSA

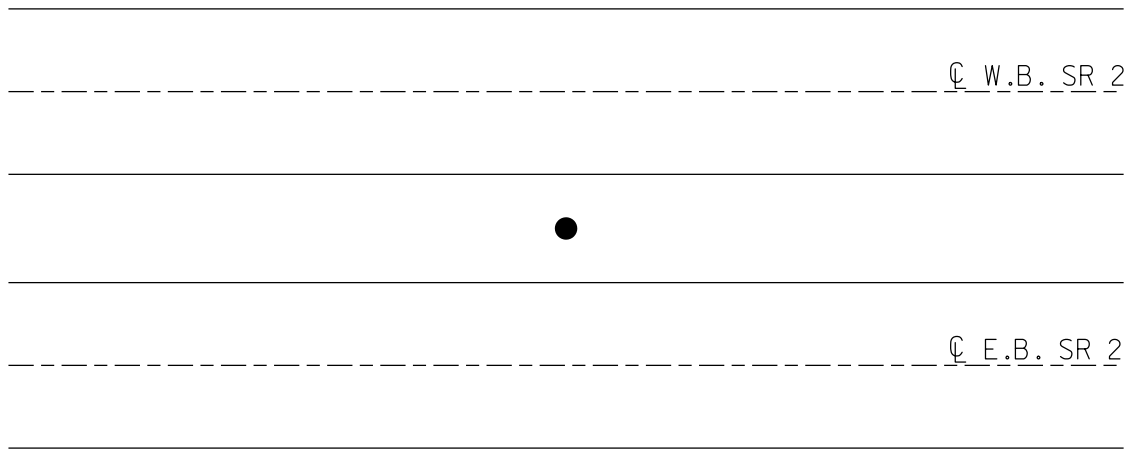

PERSONNEL	TITLE	PERSONNEL	TITLE
Schneider			
Mosser			
Barbour			
Geyman			

COUNTY Ottawa DATE 1-18-73  
 S. R. 2 WEATHER Fair  
 SEC. 19.60 TEMP. 50°

DESCRIPTION Sec-7 Portage Twp. JOB NO. \_\_\_\_\_

