

O.D.O.T. DISTRICT 2 SURVEY OFFICE (USE ONLY)

PERSONNEL

REFERENCE NO. 67

SHEET 30 OF 45

NOTES RHOADES

DATE 1/19/21

ROUTE SR 2

H.C. AUBLE

WEATHER CLOUDY

COUNTY OTTAWA

R.C. _____

TEMP. 30°

TOWNSHIP PORTAGE

DWG BY NIESE

PID 107959

SECTION 8

T 6 N R 17 E

TYPE MONUMENT CMON

ON SURFACE - ~~BELOW~~ ON

OFFSET Q PAVEMENT ON LT : RT

- TO - EDGE PAVEMENT


STATION: 1143+74.78

HORZ. DATUM: NAD83(2011)


GEOID: NAVD88 2018

GRID: NORTHING: 667514.416

EASTING: 1849790.995

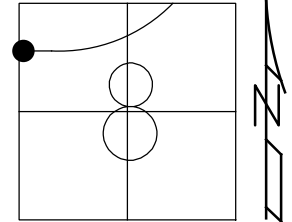

RECORD: P.O.T.
FROM 1963 PLAN
STA 300+00
FD CMON
W/ 1/2" IPIN
1/18/73
FD CMON
CL26
1/21/21, DSA

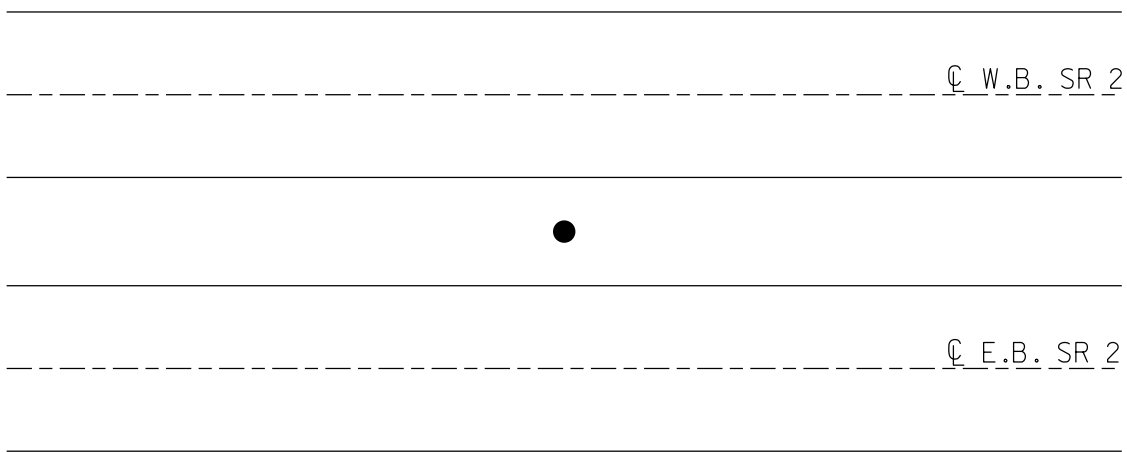

PERSONNEL	TITLE	PERSONNEL	TITLE
Schneider			
Mosser			
Barbour			
Geyman			

COUNTY Ottawa DATE 1-19-73
 S. R. 2 WEATHER Fair
 SEC. 19.60 TEMP. 50°

DESCRIPTION Sec-7 Portage Twp. JOB NO. _____

