

O.D.O.T. DISTRICT 2 SURVEY OFFICE (USE ONLY)

PERSONNEL

REFERENCE NO. 83

SHEET 43 OF 45

NOTES RHOADES

DATE 1/29/21

ROUTE SR 2

H.C. AUBLE

WEATHER CLOUDY

COUNTY OTTAWA

R.C. \_\_\_\_\_

TEMP. 30°

TOWNSHIP PORTAGE

DWG BY NIESE

PID 107959

SECTION 4

T 6 N R 17 E

TYPE MONUMENT CMON W/ 1/2" IPIN

ON SURFACE - ~~BELOW~~ ON

OFFSET  $\varnothing$  PAVEMENT ON \_\_\_\_\_ LT : RT

- TO - EDGE PAVEMENT


STATION: 1254+10.41

HORZ.DATUM: NAD83(2011)


GEOID: NAVD88 2018

GRID: NORTHING: 672634.936

EASTING: 1858910.018

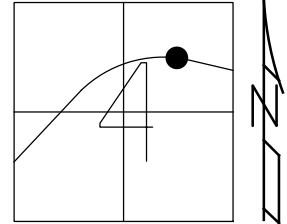

RECORD: P.C.C.  
FROM 1963 PLAN  
STA 410+39.14  
FD CMON  
W/ 1/2" IPIN  
2/7/73  
FD CMON  
W/ 1/2" IPIN  
CL39  
P.C.C.  
STA. 1254+04.94  
1/27/21, DSA

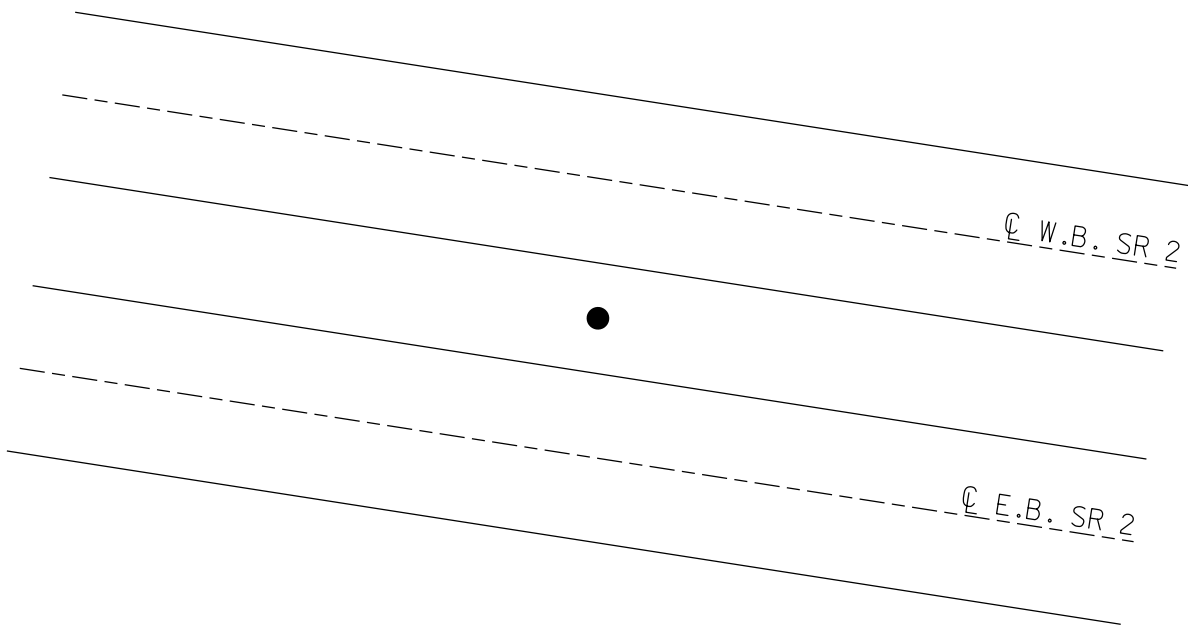

PERSONNEL	TITLE	PERSONNEL	TITLE	COUNTY	<u>Ottawa</u>	DATE	<u>2-7-73</u>
<u>Schnaider</u>				S. R.	<u>2</u>	WEATHER	<u>Cloudy</u>
<u>Mosser</u>				SEC.	<u>23,43</u>	TEMP.	<u>35°</u>
<u>Barbour</u>							
<u>Geyman</u>							
DESCRIPTION	<u>sec 4 Portage Twp.</u>			JOB NO.			

