

O.D.O.T. DISTRICT 2 SURVEY OFFICE (USE ONLY)

PERSONNEL

REFERENCE NO. 84

SHEET 44 OF 45

NOTES RHOADES

DATE 1/29/21

ROUTE SR 2

H.C. AUBLE

WEATHER CLOUDY

COUNTY OTTAWA

R.C. _____

TEMP. 30°

TOWNSHIP PORTAGE

DWG BY NIESE PID 107959

SECTION 4
T 6 N R 17 E

TYPE MONUMENT CMON W/ 1/2" IPIN

ON SURFACE - ~~BELOW~~ ON

OFFSET ☉ PAVEMENT ON LT : RT

- TO - EDGE PAVEMENT


STATION: 1257+10.51

HORIZ.DATUM: NAD83(2011)


GEOID: NAVD88 2018

GRID: NORTHING: 672571.731

EASTING: 1859203.338

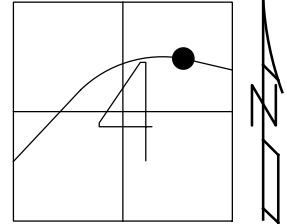

RECORD: P.T.
FROM 1963 PLAN
STA 412+39.14
FD CMON
W/ 1/2" IPIN
2/7/73
FD CMON
W/ 1/2" IPIN
CL40
1/27/21, DSA

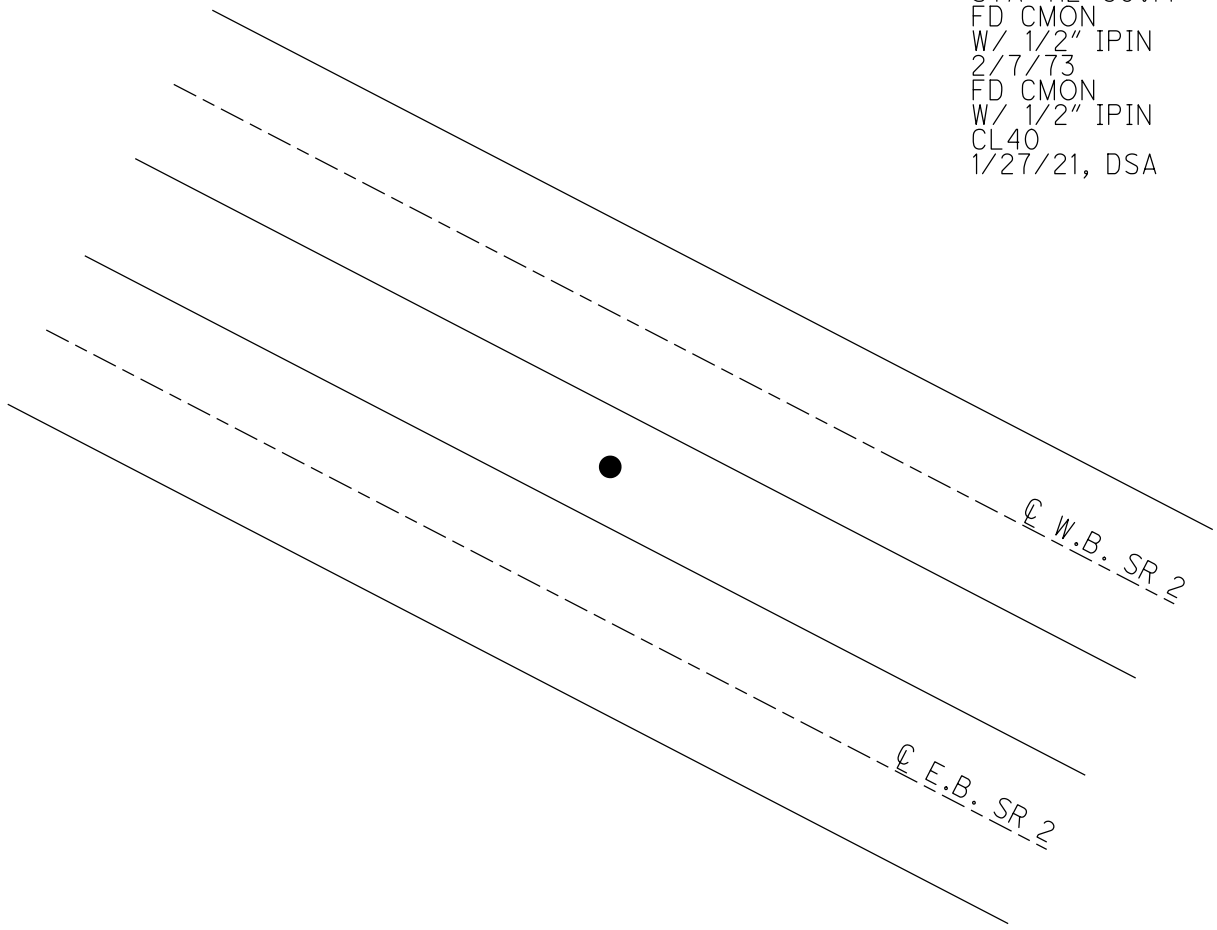

PERSONNEL	TITLE	PERSONNEL	TITLE	COUNTY	Ottawa	DATE	2-7-73
Schnaider				S. R.	2	WEATHER	Cloudy
Mosser				SEC.	23,43	TEMP.	35°
Barbour							
Geyman							

DESCRIPTION sec 4 Portage Twp. JOB NO. _____

