

O.D.O.T. DISTRICT 2 SURVEY OFFICE (USE ONLY)

PERSONNEL

REFERENCE NO. 108

SHEET 23 OF 23

NOTES RHOADES

DATE 3/1/22

ROUTE SR 2

H.C. O'DONNELL

WEATHER CLOUDY

COUNTY OTTAWA

R.C. AUBLE

TEMP. 44°

TOWNSHIP DANBURY

NIESE

SECTION 4-32

DWG BY RHOADES PID 96755

TYPE MONUMENT MONBOX W/1" IPIN

~~ON SURFACE~~ - BELOW ON

OFFSET Q PAVEMENT ON LT : RT

- TO - EDGE PAVEMENT

STATION: 1487+36.75


HORZ.DATUM: NAD83 2011

GEOID: NAVD88 2018


GRID: NORTHING: 663355.865

EASTING: 1876643.443

NOTE:  
THIS MAP IS FOR ODOT PURPOSES ONLY.  
TO INDEX REFERENCE TIES, AND DOES NOT  
REPRESENT TRUE LAND SUBDIVISION.

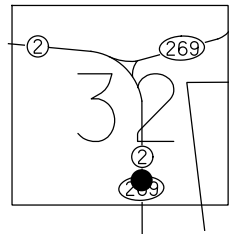

RECORD: P.O.T.  
STA 96+00  
MONBOX  
3/1/73, SCHNEIDER  
FD MONBOX  
W/ 1" IPIN  
REF108  
3/1/22, JFO

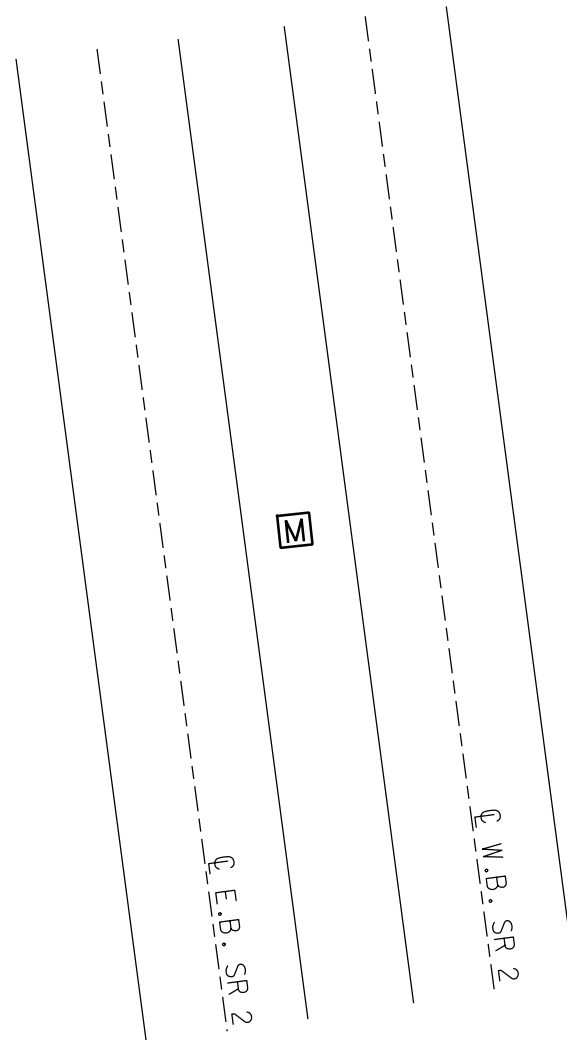

PERSONNEL TITLE PERSONNEL TITLE

COUNTY Ottawa DATE 3-6-73

S. R. 2 WEATHER Fair

SEC. 27.36 TEMP. 65°

DESCRIPTION sec 17 Danbury Twp. JOB NO.

LEFT CENTER LINE RIGHT

|  |  |  |  |                         |  |  |  |  |  |
|--|--|--|--|-------------------------|--|--|--|--|--|
|  |  |  |  |                         |  |  |  |  |  |
| 120+00.00 Bk. =<br>0+00 Ahead                  |  |  |  | Eric Co.<br>Ottawa Co.  |  |  |  |  |  |
| #116<br>P.O.T.<br>106+45<br>Mon. Box in Median |  |  |  | □                       |  |  |  |  |  |
| P.O.T.<br>96+00<br>Mon Box in Median           |  |  |  | □                       |  |  |  |  |  |
| P.O.T.<br>85+00<br>Mon Box in Median           |  |  |  | □                       |  |  |  |  |  |
| P.O.T.<br>75+00<br>Mon. Box in Median          |  |  |  | □                       |  |  |  |  |  |
| P.O.T.<br>64+00<br>Mon Box in Median           |  |  |  | □ on Bridge didn't find |  |  |  |  |  |
| S.T.<br>54+00.05<br>Mon Box in Median          |  |  |  | □                       |  |  |  |  |  |