



PERSONNEL TITLE PERSONNEL TITLE COUNTY Ottawa DATE 11-25-80
Schneider _____
Mosser _____ S. R. 19 WEATHER Clear-cold
Barbour _____ SEC. 0.00-3.23 TEMP. 30°
 DESCRIPTION Maintenance Program 1981 JOB NO. _____
 LEFT CENTER LINE RIGHT

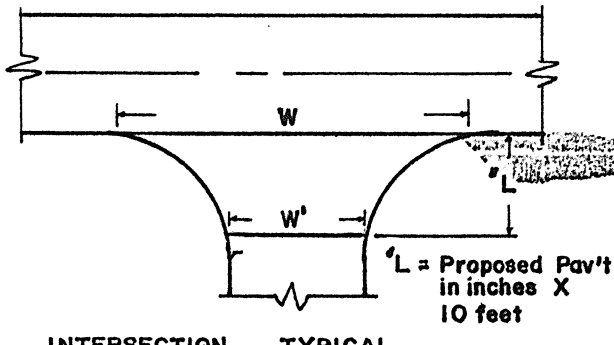

INTERSECTION TYPICAL

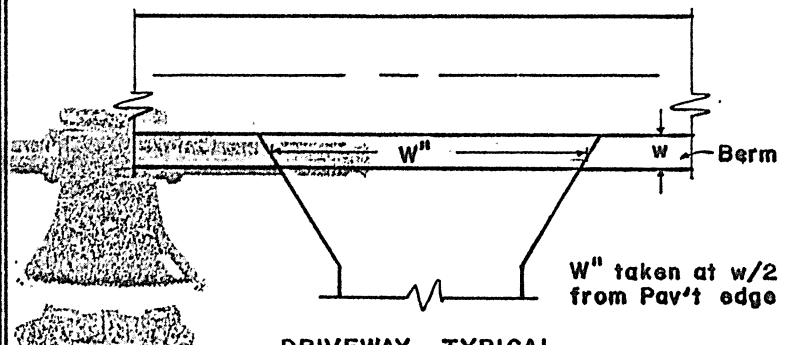

DRIVEWAY TYPICAL

STATION	RT. LT.	L	W	W'	Asph	Conc	STATION	RT. LT.	w	W''	Asph	Conc	Aggr	Dropped Curb Feather NOT Req'd
(11+11)	Lt.	7'	58	40	✓		2+03	Lt	2	34'	✓			
(11+11)	Lt.	55'	40	27	✓		6+44	Rt.	2	45'	✓			
21+58	Rt.	12.5	50	17	✓		6+77	Rt.	2	36	✓			
21+58	Lt.	12.5	55	21	✓		108+77	Lt.	2	74	✓			
52+99	Rt.	12.5	88	47	✓		109+72	Lt.	2	77	✓			
61+28	Lt.	12.5	48	22	✓		135+24	Lt.	2	68	✓			
79+61	Rt.	12.5	45	19	✓		137+42	Lt.	2	75	✓			
106+11	Rt.	12.5	44	19	✓		139+61	Lt.	2	70	✓			
106+11	Lt.	12.5	47	20	✓		145+15	Lt.	2	145	✓			Parking & drive
(144+15)	Rt.	12.5	107	46	✓		153+10	Rt.	2	26	✓			
This one year we don't need anything							155+43	Lt.	2	36	✓			
146+77	Lt.	12.5	100	59	✓		159+00	Lt.	2	77	✓			
							161+13	Rt.	2	36	✓			
							143+13	Rt.	2	50	✓			
							164+54	Lt.	2	67				Brick