
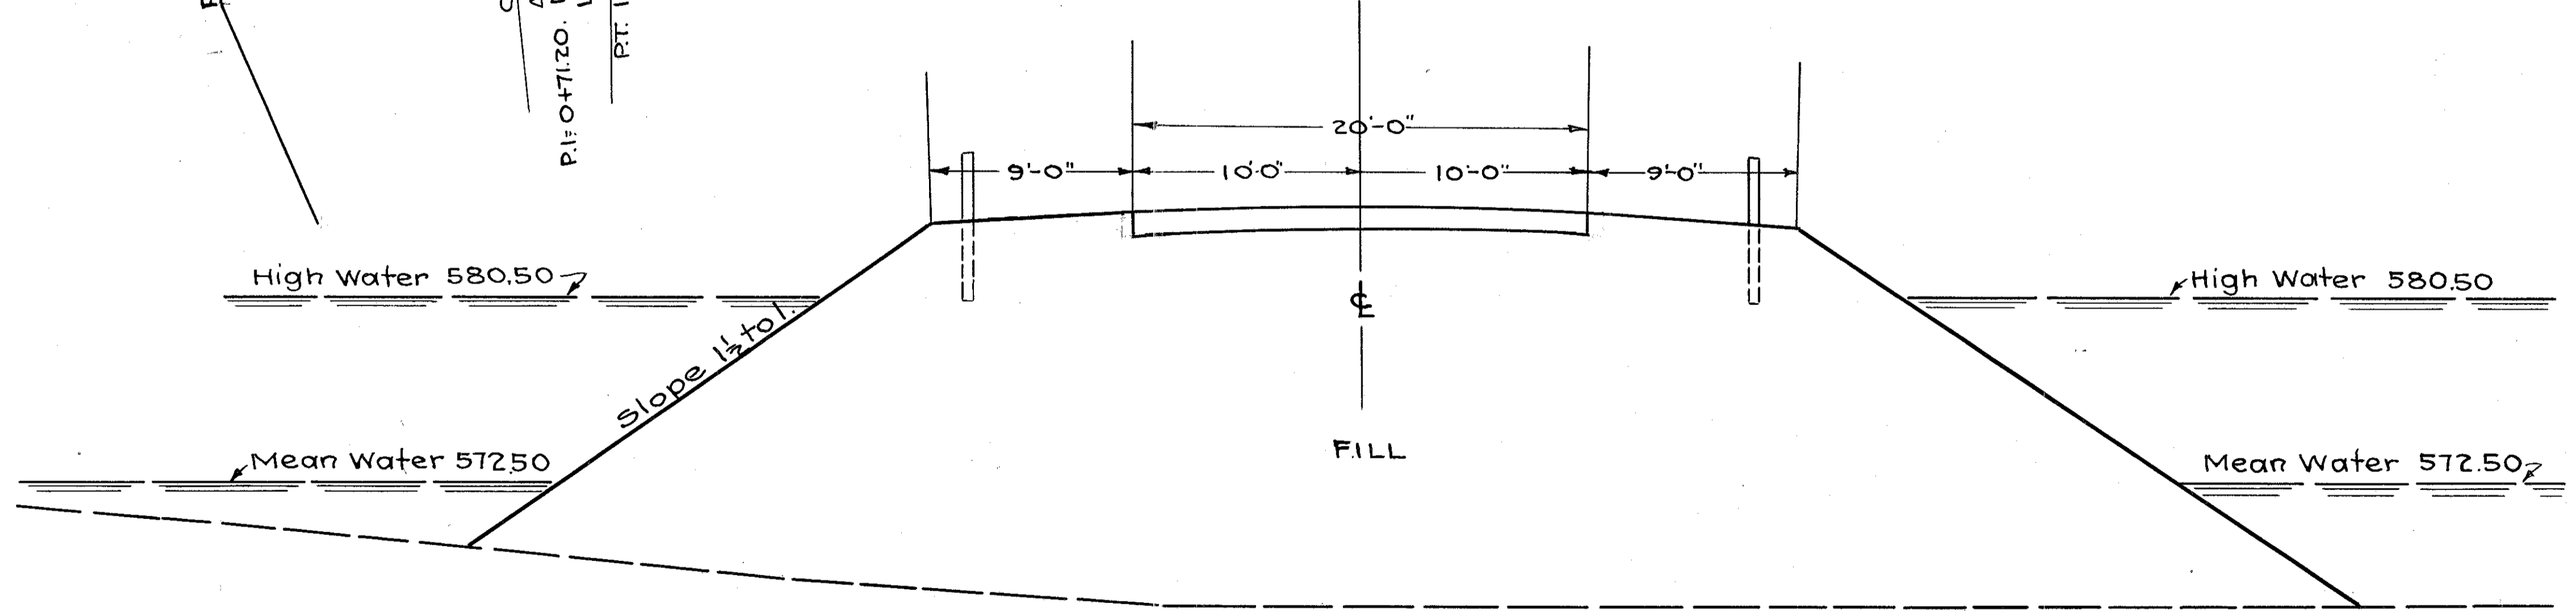
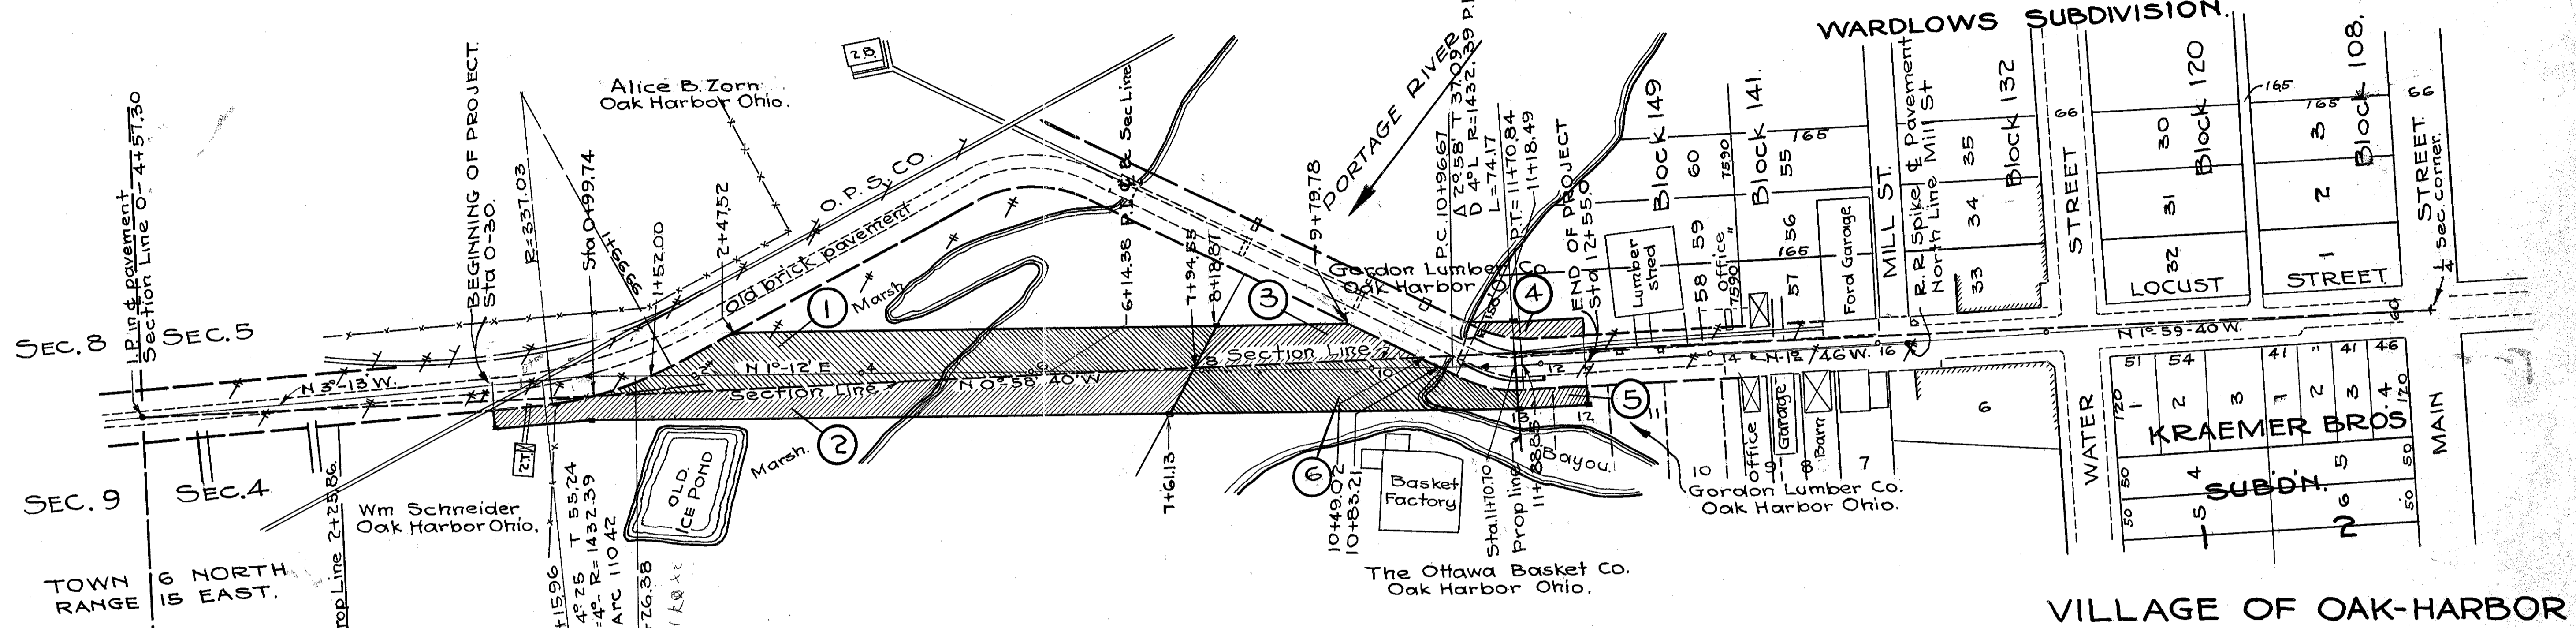


FED AID DIST	STATE	FED AID PRONO	FISCAL YEAR
10	OHIO		1931

SH 280 SEC A-1 (BRIDGE)
OTTAWA CO.
RIGHT-OF-WAY.

*RW OK as shown
FJF
3/8/44*

*Scanned
July 1997*

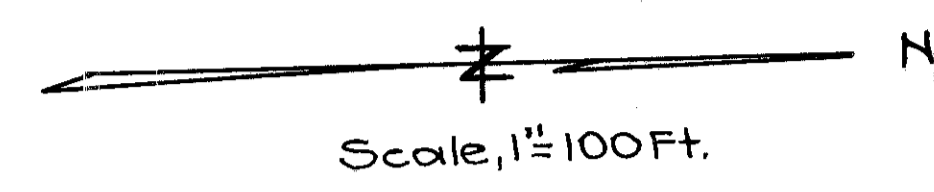

TYPICAL SECTION
Scale 1" = 5 Ft.

R-4019 #2 E-21

10046