

O.D.O.T. DISTRICT 2 SURVEY OFFICE (USE ONLY)

PERSONNEL

REFERENCE NO. 1 A

SHEET 2 OF 23

NOTES LEU

DATE 7/31/14

ROUTE SR 19

H.C. WESTFALL

WEATHER SUNNY

COUNTY OTTAWA

R.C. LEU

TEMP. 75°

TOWNSHIP SALEM

DWG BY AUBLE PID 107060

SECTION 20

T 6 N R 15 E

TYPE MONUMENT MAG NAIL

~~ON SURFACE~~ - BELOW ON

OFFSET \odot PAVEMENT 6" LT : ~~RT~~

4.8' TO LT EDGE PAVEMENT


STATION: 0+00

HORZ.DATUM: NAD83 (2011)

GEOID: 2012A

GRID: NORTHING: 653186.605

EASTING: 1791749.703

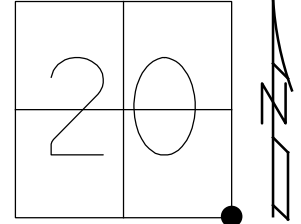

NOTE: SAN 19 REF 26

RECORD: P.I.
FD R.R.SPIKE
5/7/07
SET MAG NAIL
2008, MC
FD MAG NAIL
GPS, REF A1
1/15/13, MC
GPS, REF 2
6/5/14, EBW
FD MAG/W REF 26
3/19/19, JFO

