



O.D.O.T. DISTRICT 2 SURVEY OFFICE (USE ONLY)

PERSONNEL _____ REFERENCE NO. 20 A SHEET 3 OF 29
 NOTES HUSS DATE 10/28/09 ROUTE SR 19
 H.C. CANTERBURY WEATHER FAIR COUNTY OTTAWA
 R.C. HUSS TEMP. 55° TOWNSHIP SALEM
 _____ SECTION 5
 _____ T 6 N R 15 E

TYPE MONUMENT P.K./WASHER
 ON SURFACE - ~~BELOW~~ ON _____
~~LEFT~~ - Q PAV'T - RIGHT 0.6'
12.8' TO LT EDGE PAVEMENT
 S.L.M. 194+54.14

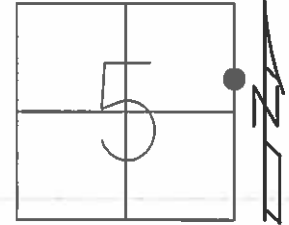



GRID: NORTHING: 672614.315 EASTING: 1791841.654

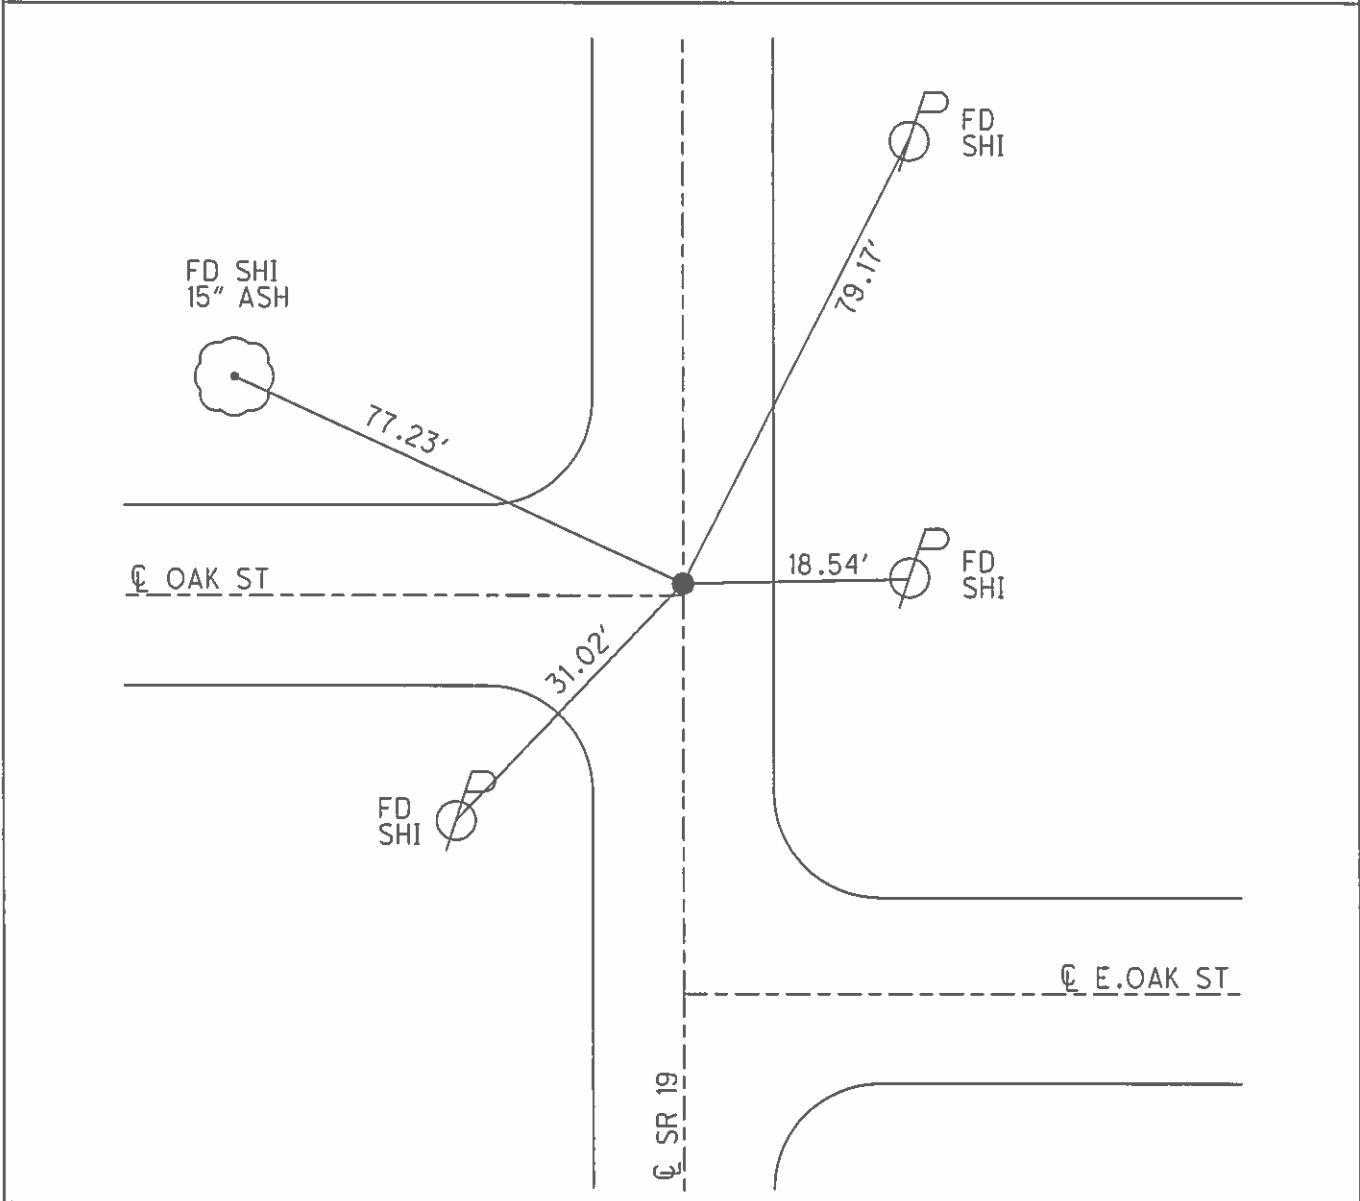

O.D.O.T. DISTRICT 2 SURVEY OFFICE (USE ONLY)

PERSONNEL _____ REFERENCE NO. 20 A SHEET 7 OF 33
 NOTES HUSS DATE 10/28/09 ROUTE SR 19
 H.C. CANTERBURY WEATHER FAIR COUNTY OTTAWA
 R.C. HUSS TEMP. 55° TOWNSHIP SALEM
 SECTION 5
 T 6 N R 15 E

TYPE MONUMENT P.K./WASHER
 ON SURFACE ~~-BELOW~~ ON
~~LEFT~~ - Q PAV'T - RIGHT 0.6'
12.8' TO LT EDGE PAVEMENT
 S.L.M. 194+54.14
 Grid: Northing: 672614.315 Easting: 1791841.654

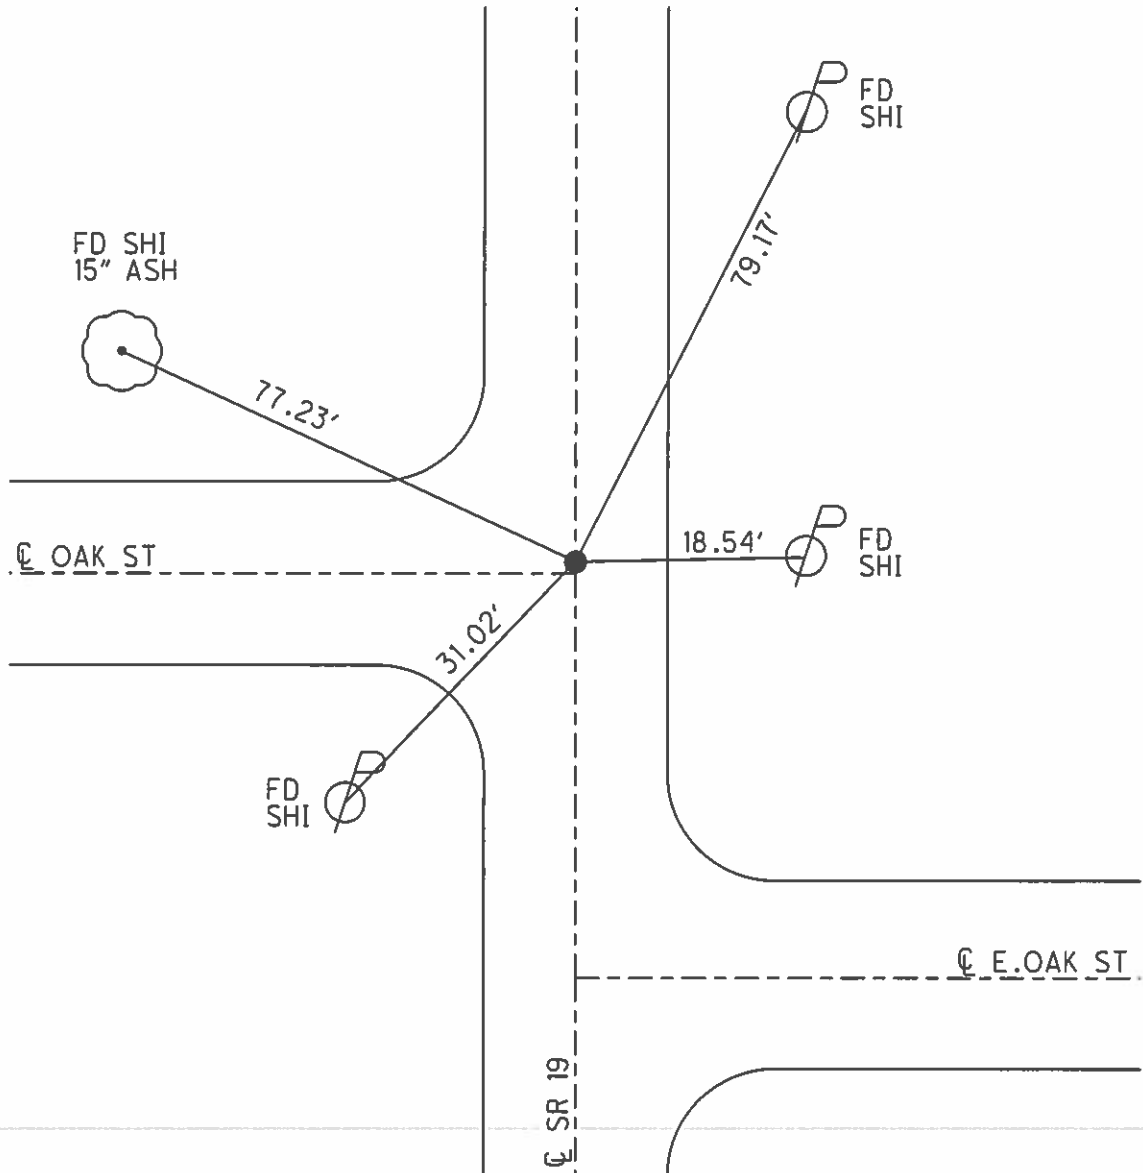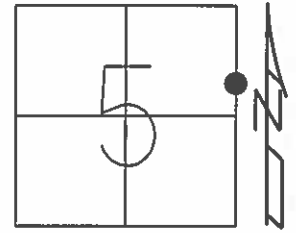

O.D.O.T. DISTRICT 2 SURVEY OFFICE

PERSONNEL _____

REFERENCE NO. _____

SHEET 21 OF 22

NOTES BARNHISEL

H.C. ROUSOS

DATE 8-5-96

ROUTE 19

R.C. HANES

WEATHER SUNNY

COUNTY OTTAWA

TEMP. +85°

TOWNSHIP SALEM

SECTION 5

T4 N R 15 E


TYPE MONUMENT NEW SEWER LINE REMOVED

ON SURFACE - BELOW @ CONTROL

~~LEFT-@ PAV'T.~~ - RIGHT ON E of Oak st. to the West;
0.6' RT & SR 19

12.8 TO LT EDGE PAVEMENT


S.L.M. 194+46

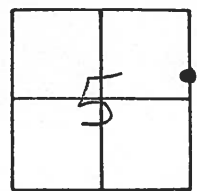

RESET PK + WASHER 3/19/97
FROM OLD TIES,


POINT DISTURBED BY
SEWER LINE CONSTRUCTION 1994

20A

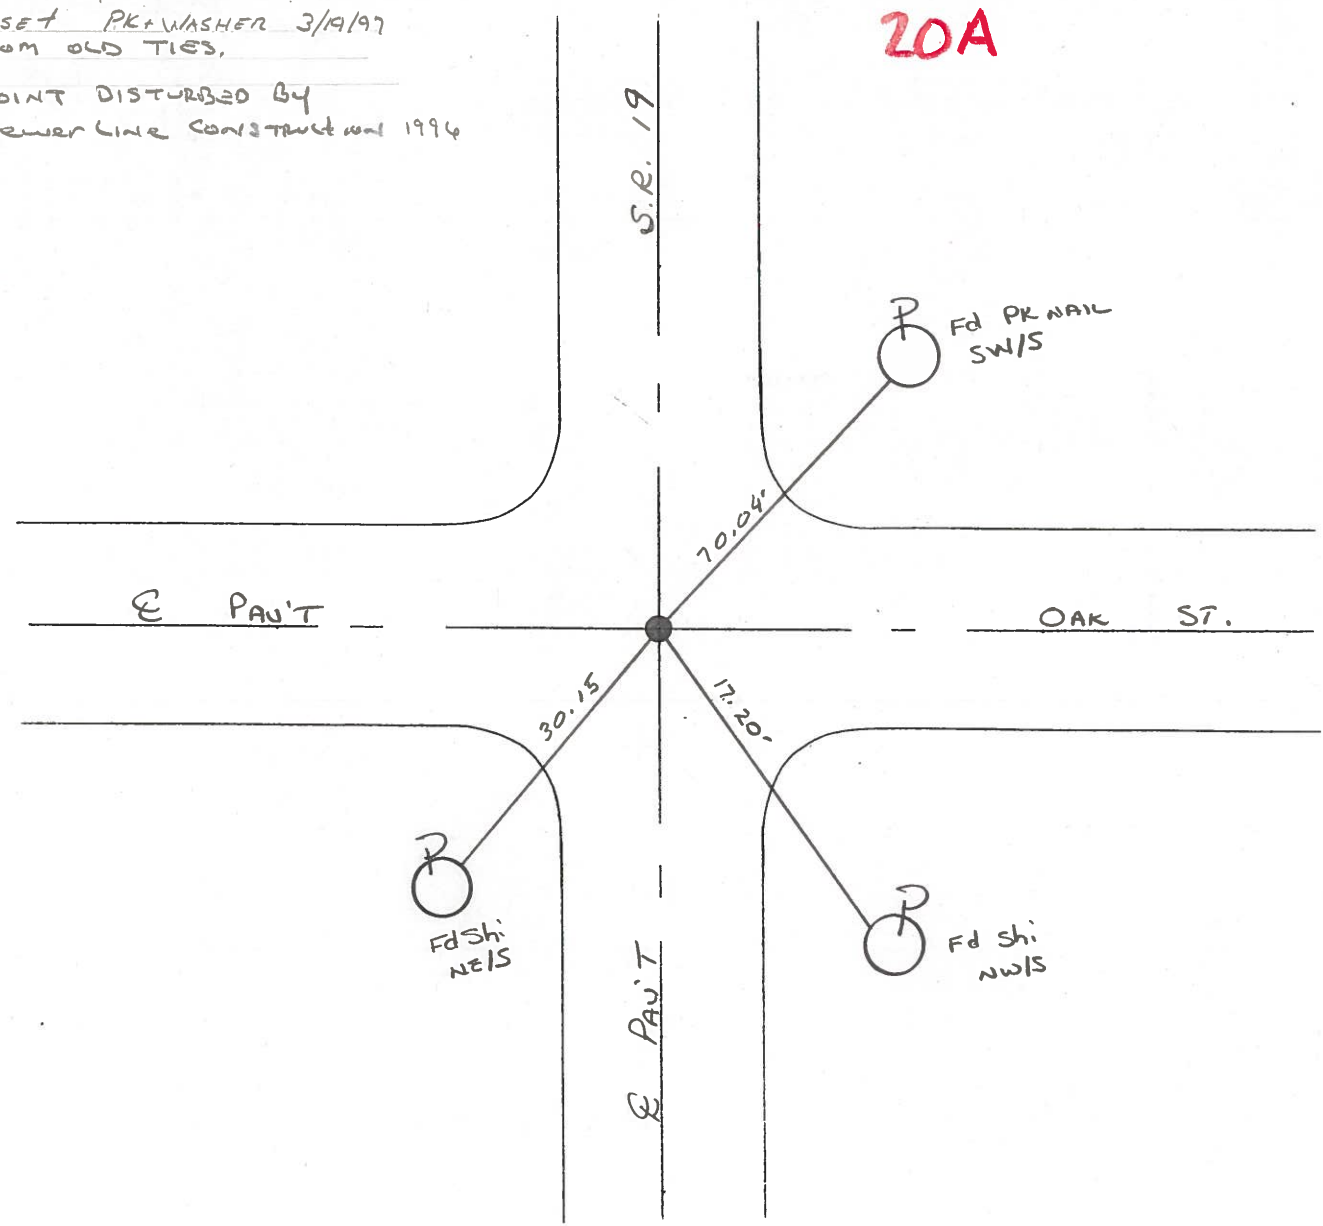

PERSONNEL	TITLE	PERSONNEL	TITLE	COUNTY	DATE	WEATHER	TEMP.
CRONIN				OTTAWA	4/20/89	SUNNY	63°
RIFFLE				S. R. #19			
GEYMAN				SEC. OAK HARBOR			


DESCRIPTION TIES - INTERSECTING STREETS - SET BY OTHERS JOB NO. _____

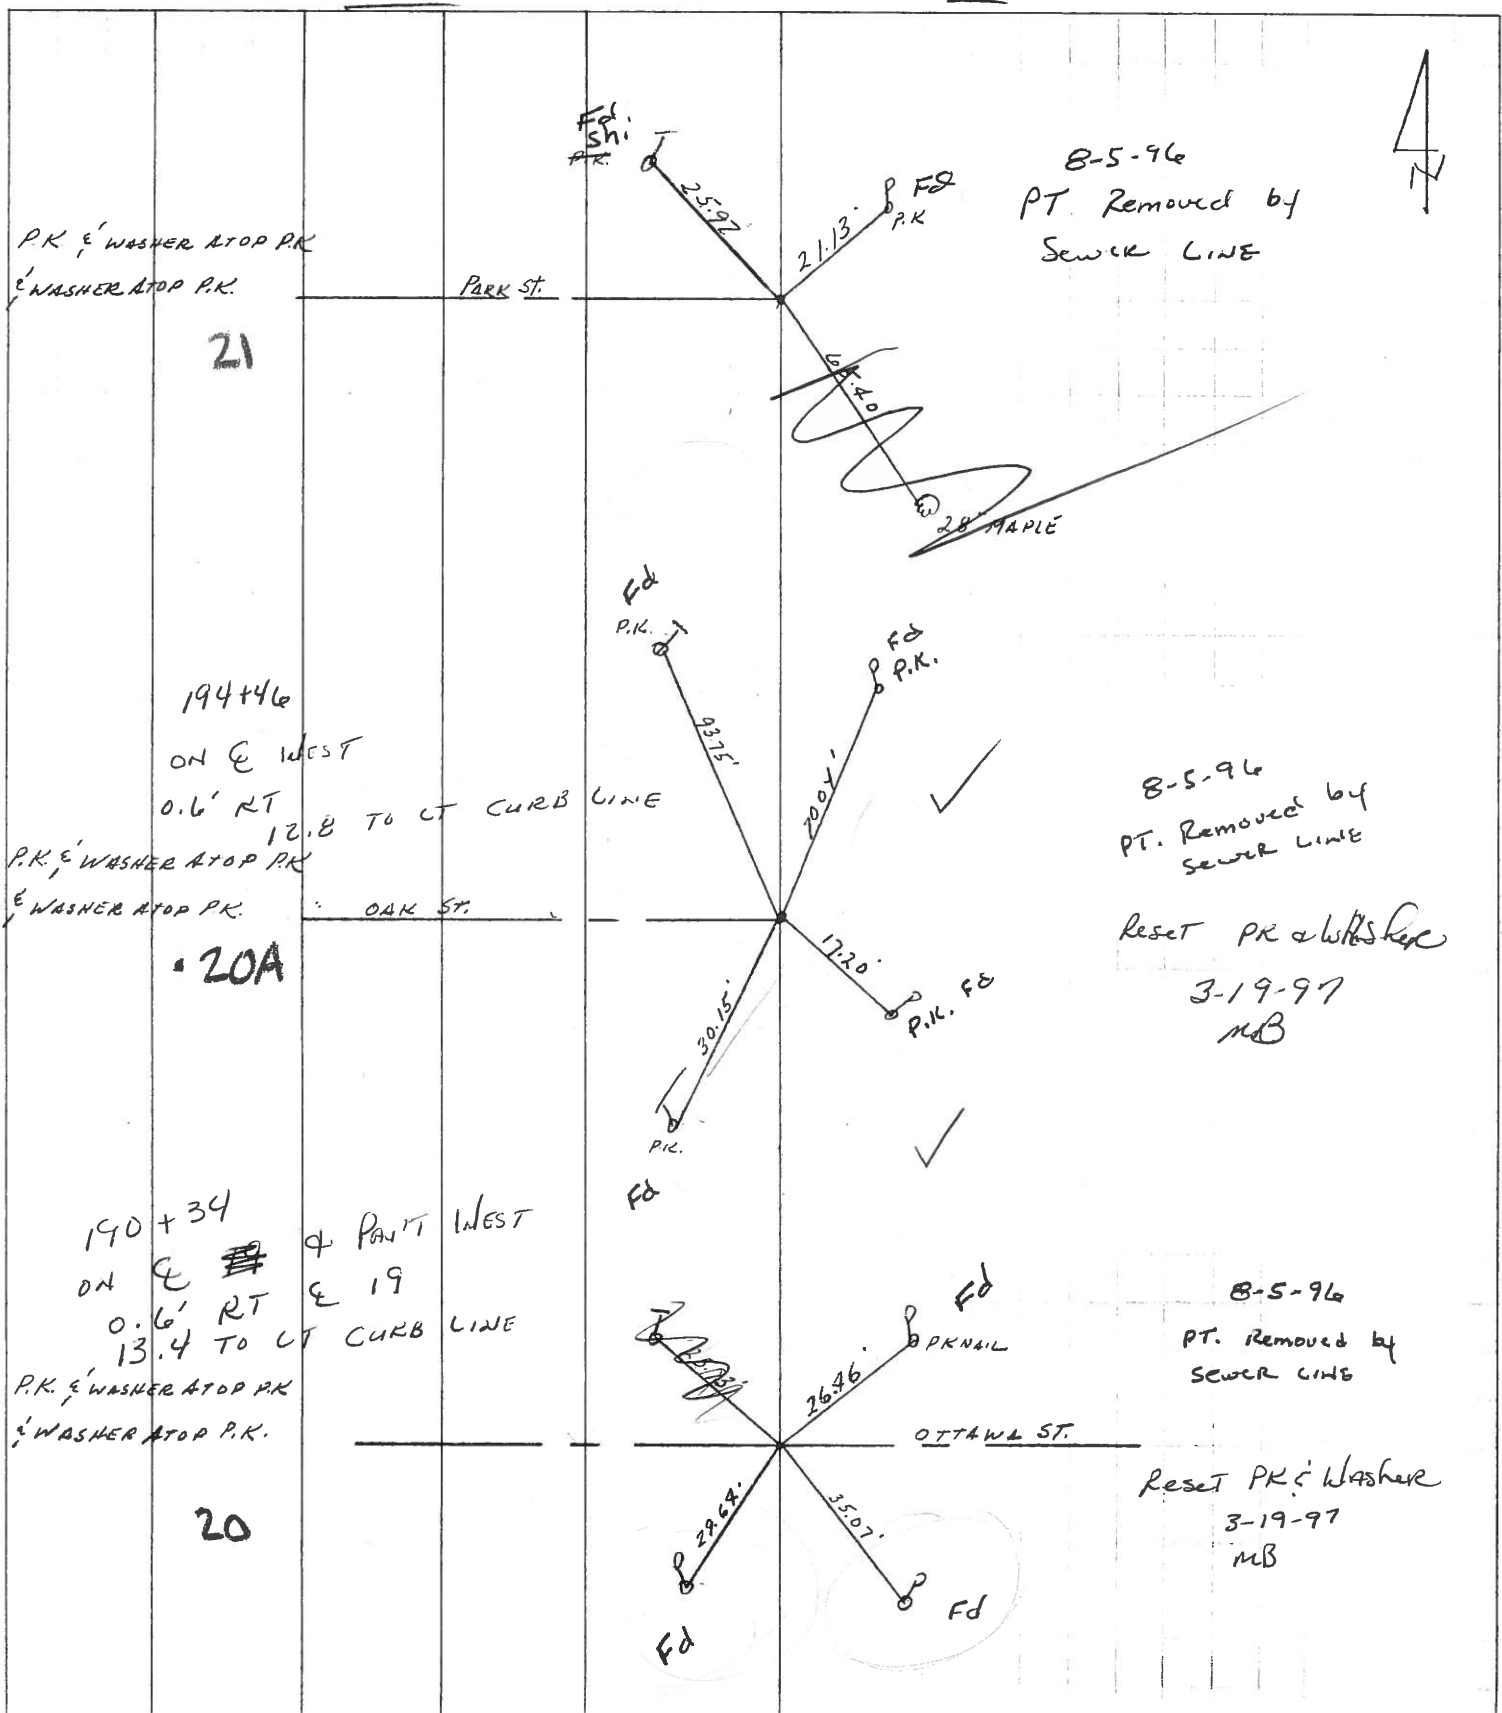

PERSONNEL	TITLE	PERSONNEL	TITLE
<u>CRONIN</u>			
<u>RIPPLE</u>			
<u>GEYMAN</u>			

COUNTY OTTAWA DATE 4/20/89
 S. R. #19 WEATHER SUNNY
 SEC. OAK HARBOR TEMP. 63°

DESCRIPTION TIES - INTERSECTING STREETS - SET BY OTHERS JOB NO. _____

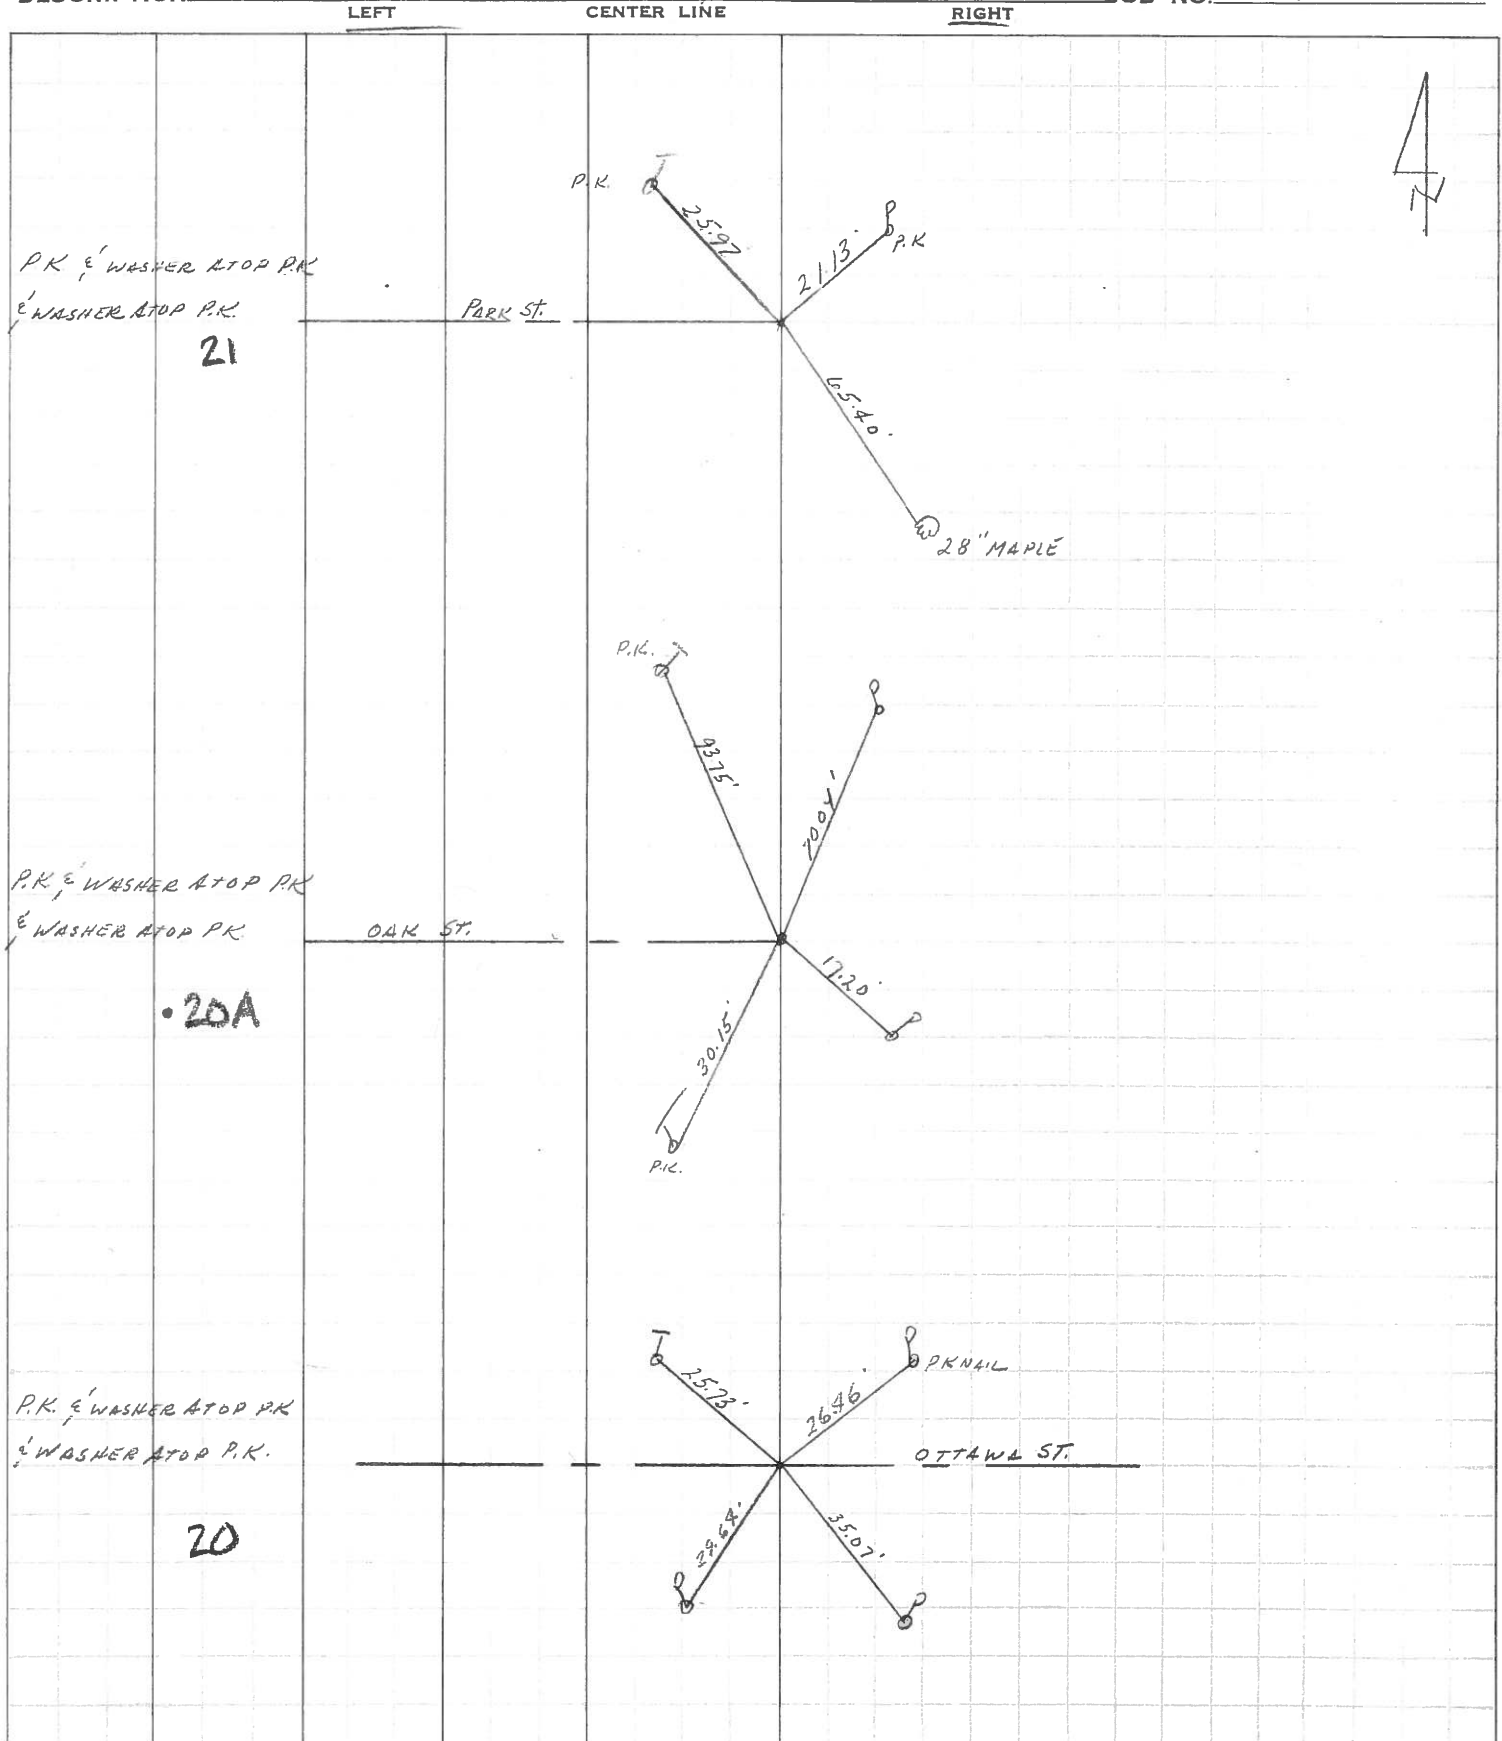

PERSONNEL TITLE PERSONNEL TITLE

COUNTY Ottawa DATE 4-25-78

S. R. 19 WEATHER Fair

SEC. 554 TEMP. 45°

DESCRIPTION Oak Harbor LEFT CENTER LINE RIGHT JOB NO.

