

O.D.O.T. DISTRICT 2 SURVEY OFFICE (USE ONLY)

PERSONNEL _____ REFERENCE NO. 21 A SHEET 5 OF 29

NOTES HUSS DATE 10/28/09 ROUTE SR 19
H.C. CANTERBURY WEATHER FAIR COUNTY OTTAWA
R.C. HUSS TEMP. 55° TOWNSHIP SALEM
SECTION 5
T 6 N R 15 E


TYPE MONUMENT _____ NAIL/SHI _____

ON SURFACE - ~~BELOW~~ ON _____


~~LEFT~~ - CL PAV'T - RIGHT 0.4'

11.9' TO RT EDGE PAVEMENT

S.L.M. 202+78.29

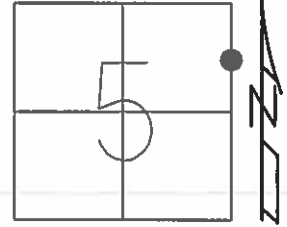



GRID: NORTHING: 673438.453 EASTING: 1791850.494

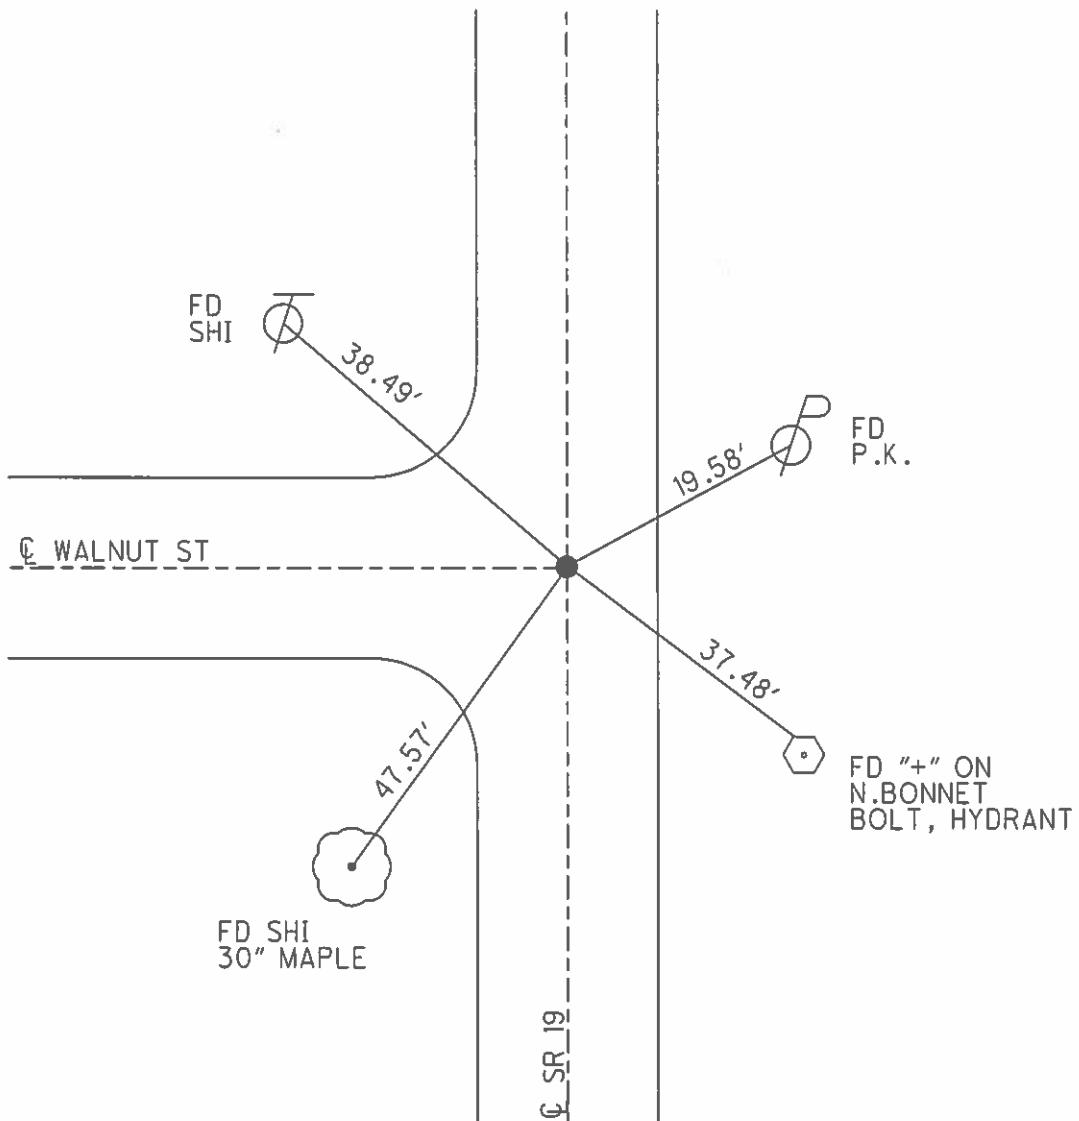

O.D.O.T. DISTRICT 2 SURVEY OFFICE (USE ONLY)

PERSONNEL _____ REFERENCE NO. 21 A SHEET 9 OF 33
 NOTES HUSS DATE 10/28/09 ROUTE SR 19
 H.C. CANTERBURY WEATHER FAIR COUNTY OTTAWA
 R.C. HUSS TEMP. 55° TOWNSHIP SALEM
 SECTION 5
 T 6 N R 15 E

TYPE MONUMENT NAIL / SHINNER
 ON SURFACE - ~~BELOW~~ ON
~~LEFT~~ - Q PAV'T - RIGHT 0.4'
11.9' TO RT EDGE PAVEMENT
 S.L.M. 202+78.29
 Grid: Northing: 673438.453 Easting: 1791850.494

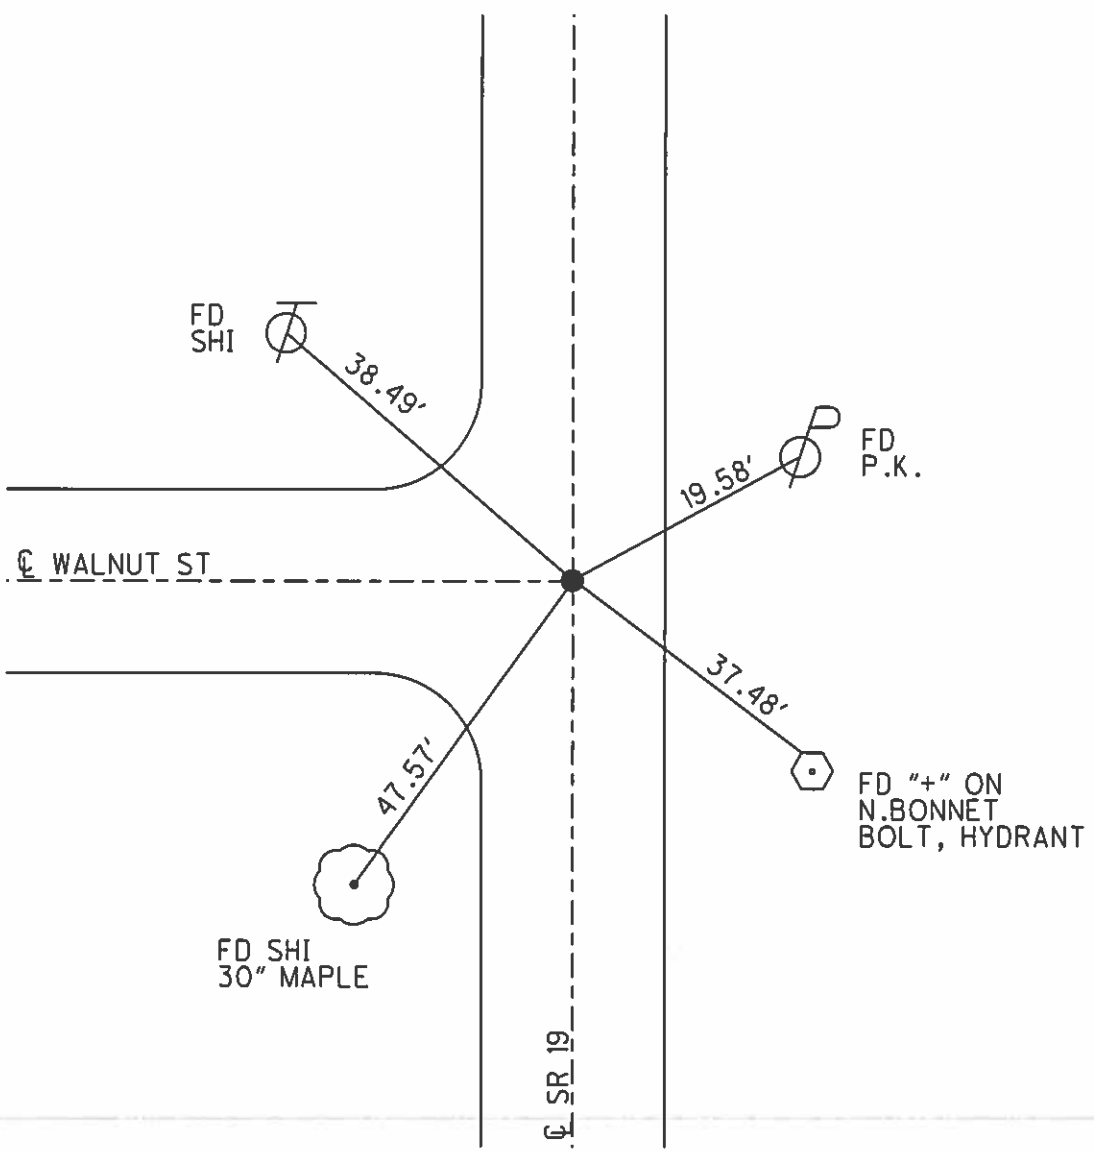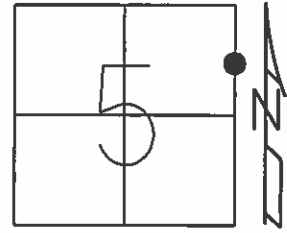

PERSONNEL

TITLE

PERSONNEL

TITLE

COUNTY OTTAWA

WEATHER SUNNY

CRONIN

RIPPLE

GEYMAN

S. R. #19

SEC. OAK HARBOR

TEMP. 63°

DESCRIPTION TIES - INTERSECTING STREETS - SET BY OTHERS

JOB NO. _____

LEFT

CENTER LINE

RIGHT



22

ON E BOTA
12.6 TO RT
ZOL + 87

P.K. & WASHER
ATOP P.K.

21B

P.K. & WASHER ATOP SAME
ATOP P.K.

21A

JEFFERSON ST.

Fd Shi 51.88'

Fd Shi
but
pole has
been hit

8-5-96
PT. Removed by
Sewer Line

WASHINGTON ST.

Fd Shi 27.72'

Fd Shi
22" WALNUT

8-5-96
PT. Removed by
Sewer Line

Reset P.K. & Washer
3-19-97
MPL

Fd P.K.

Fd P.K. 27.53'

Fd P.K.

Fd P.K. 18.18'

8-5-96
PT. Removed by
Sewer Line

WALNUT ST.

FACE OF H₂O
3" UP

PERSONNEL

TITLE

PERSONNEL

TITLE

DRAWN 4/24/89

DATE 4/20/89

Cronin

COUNTY OTTAWA

Ripple

S. R. #19

WEATHER SUNNY

Geyman

SEC. OAK HARBOR

TEMP. 63°

DESCRIPTION TIES - INTERSECTING STREETS - SET BY OTHERS


JOB NO.

LEFT

CENTER LINE


RIGHT

22

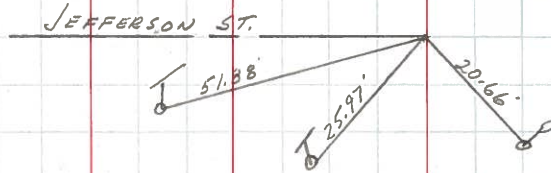


P.K. & WASHER ATOP P.K.

21B

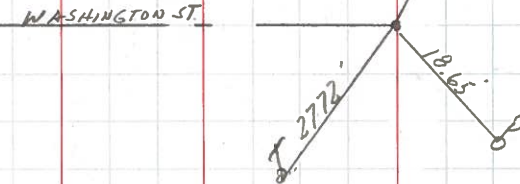

P.K. & WASHER ATOP SAME ATOP P.K.

21A

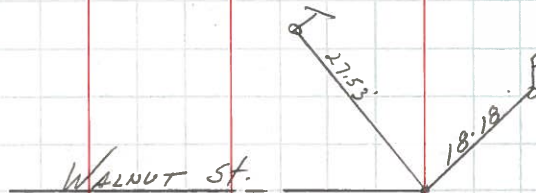

FACE OF H₂O

HYDRANT 3\" UP



PERSONNEL TITLE PERSONNEL TITLE

COUNTY Ottawa DATE 4-25-78

S. R. 19 WEATHER Fair - Windy

SEC. 554 TEMP. 45°

DESCRIPTION Cork Harbor JOB NO. _____

LEFT

CENTER LINE

RIGHT

