


O.D.O.T. DISTRICT 2 SURVEY OFFICE (USE ONLY)


PERSONNEL _____ REFERENCE NO. 21 B SHEET 6 OF 29
 NOTES HUSS DATE 10/28/09 ROUTE SR 19
 H.C. CANTERBURY WEATHER FAIR COUNTY OTTAWA
 R.C. HUSS TEMP. 55° TOWNSHIP SALEM
 _____ SECTION 32
 _____ T 6 N R 15 E

TYPE MONUMENT P.K./WASHER
 ON SURFACE - ~~BELOW~~ ON
 LEFT - ☉ PAV'T - RIGHT ON
12.6' TO RT EDGE PAVEMENT
 S.L.M. 206+90.67

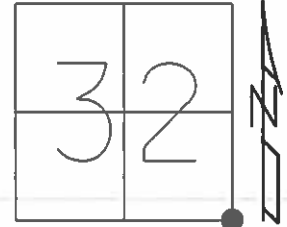

GRID: NORTHING: 673850.812 EASTING: 1791854.670


RECORD:
 FD P.K./WASHER
 1/9/06, RGN

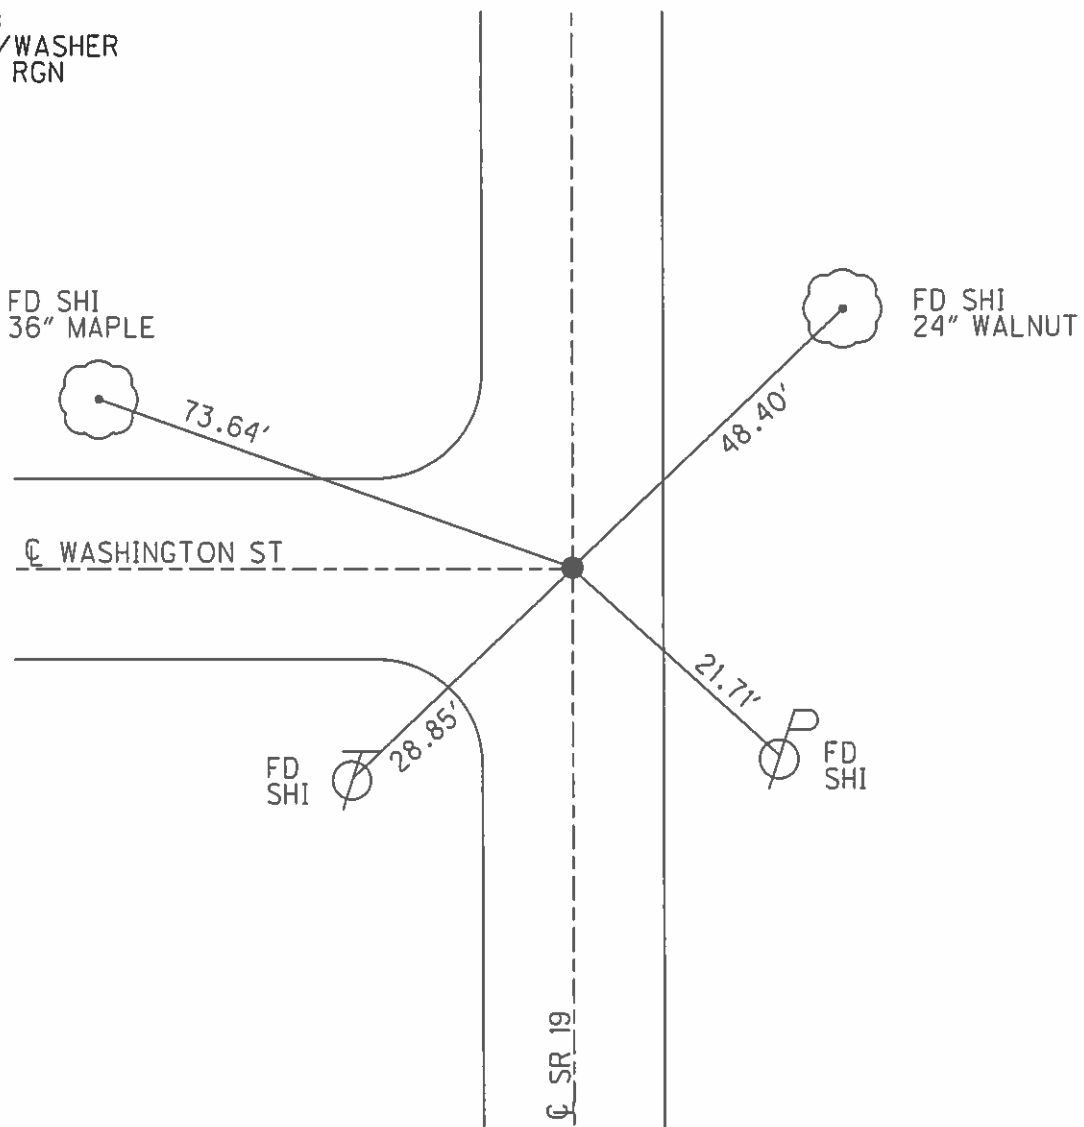


O.D.O.T. DISTRICT 2 SURVEY OFFICE (USE ONLY)

PERSONNEL _____ REFERENCE NO. 21 B SHEET 10 OF 33
 NOTES HUSS DATE 10/28/09 ROUTE SR 19
 H.C. CANTERBURY WEATHER FAIR COUNTY OTTAWA
 R.C. HUSS TEMP. 55° TOWNSHIP SALEM
 _____ SECTION 32
 _____ T 6 N R 15 E

TYPE MONUMENT P.K./WASHER
 ON SURFACE - ~~BELOW~~ ON
 LEFT - ☉ PAV'T - RIGHT ON
12.6' TO RT EDGE PAVEMENT
 S.L.M. 206+90.67
 Grid: Northing: 673850.812 Easting: 1791854.670

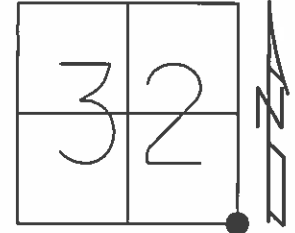

FD P.K./WASHER
 1/9/06, RGN

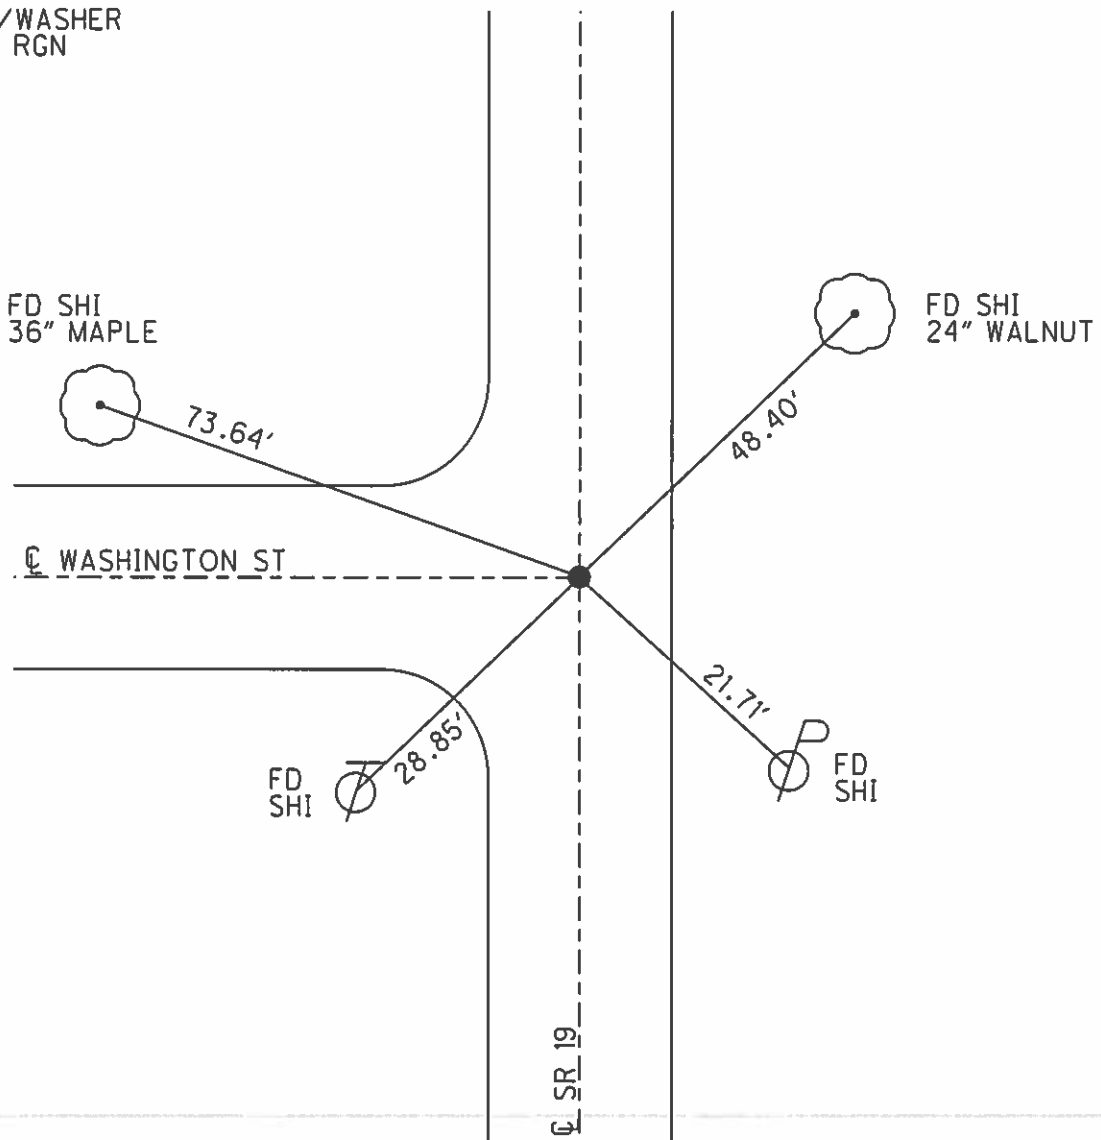

O.D.O.T. DISTRICT 2 SURVEY OFFICE

PERSONNEL _____

REFERENCE NO. _____

SHEET 22 OF 22

NOTES BARNHISEL

H.C. POUSSOS

DATE 8-5-96

ROUTE 19

R.C. HANES

WEATHER SUNNY

COUNTY OTTAWA

TEMP. +85°

TOWNSHIP SALEM


SECTION 32

T. 6 N. R. 15 E


TYPE MONUMENT NEW SEWER LINE Removed
ON SURFACE - BELOW ☒ CONTROL

~~LEFT~~ - ☒ PAV'T. - ~~RIGHT~~ ON ☒ OF Both Pmnts. ZIB
12.6' TO RT EDGE PAVEMENT

S.L.M. 206+87

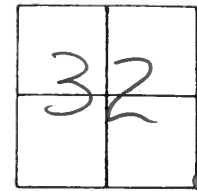

PT. REMOVED by SEWER LINE 8-5-96
RESET P.K. & WASHER 3-19-97
FROM OLD TIES

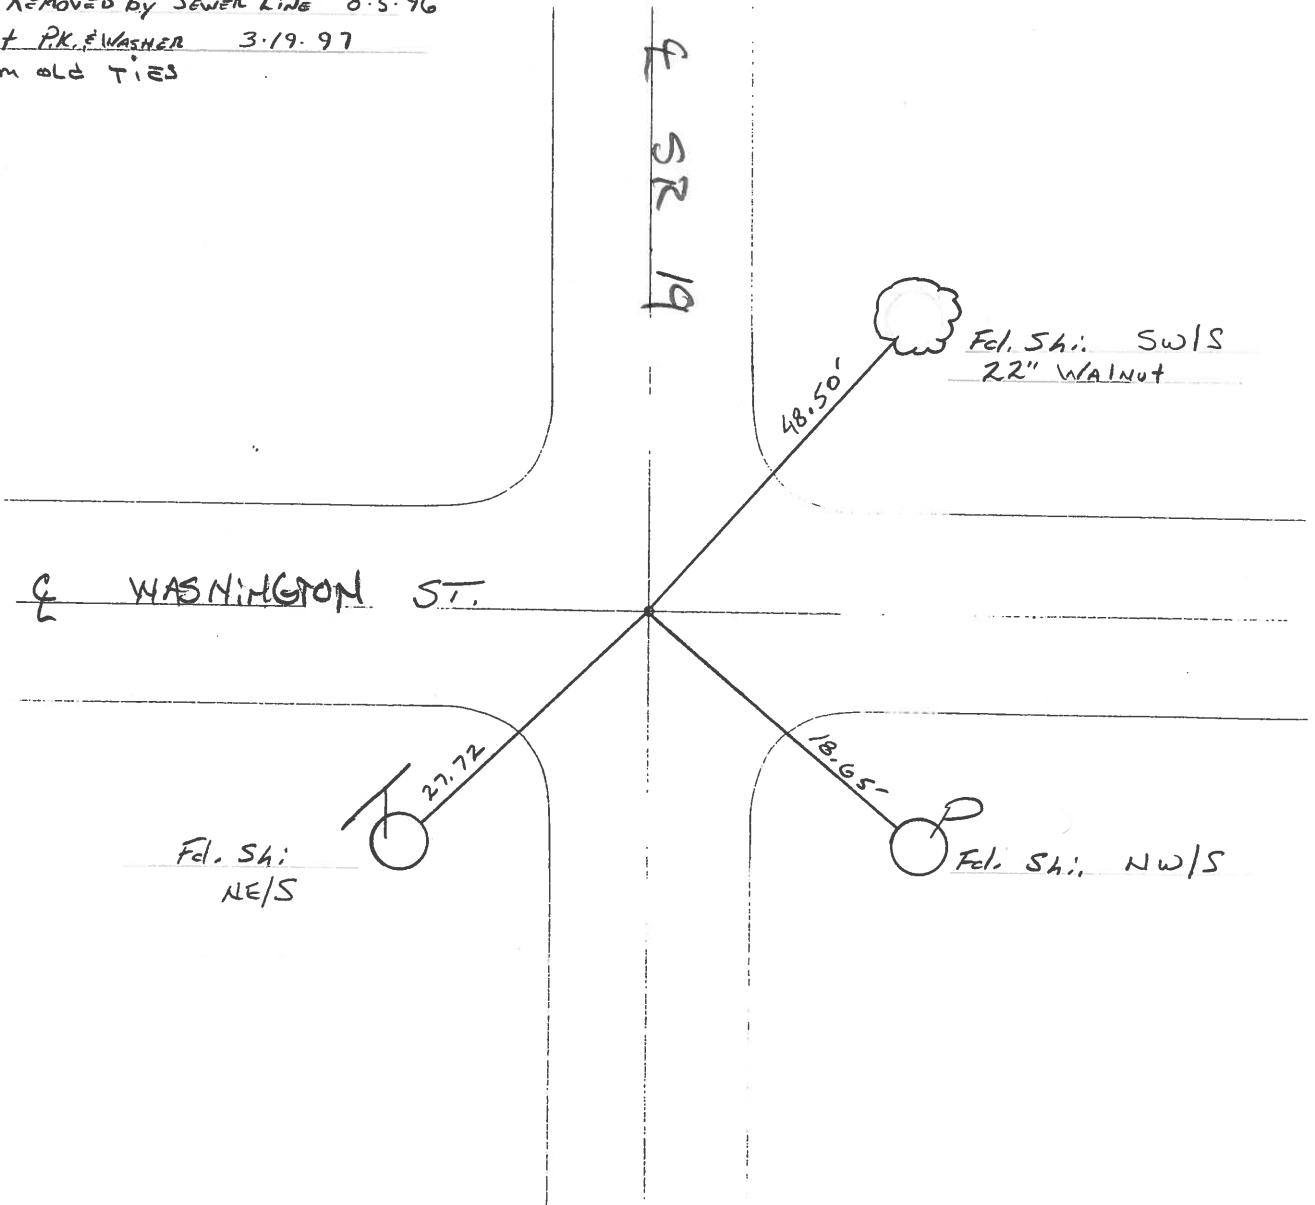

PERSONNEL TITLE PERSONNEL TITLE

COUNTY OTTAWA

DRAWN 4/24/89

DATE 4/20/89

CRONIN

RIPPLE

GEYMAN

S. R. #19

WEATHER SUNNY

SEC. OAK HARBOR

TEMP. 63°

DESCRIPTION TIES - INTERSECTING STREETS - SET BY OTHERS

JOB NO.

LEFT

CENTER LINE

RIGHT



22


ON E BOTA
12.6 TO RT
ZOLC + 87

P.K. WASHNER
ATOP P.K.

21B

P.K. WASHNER ATOP SAME
ATOP P.K.

21A

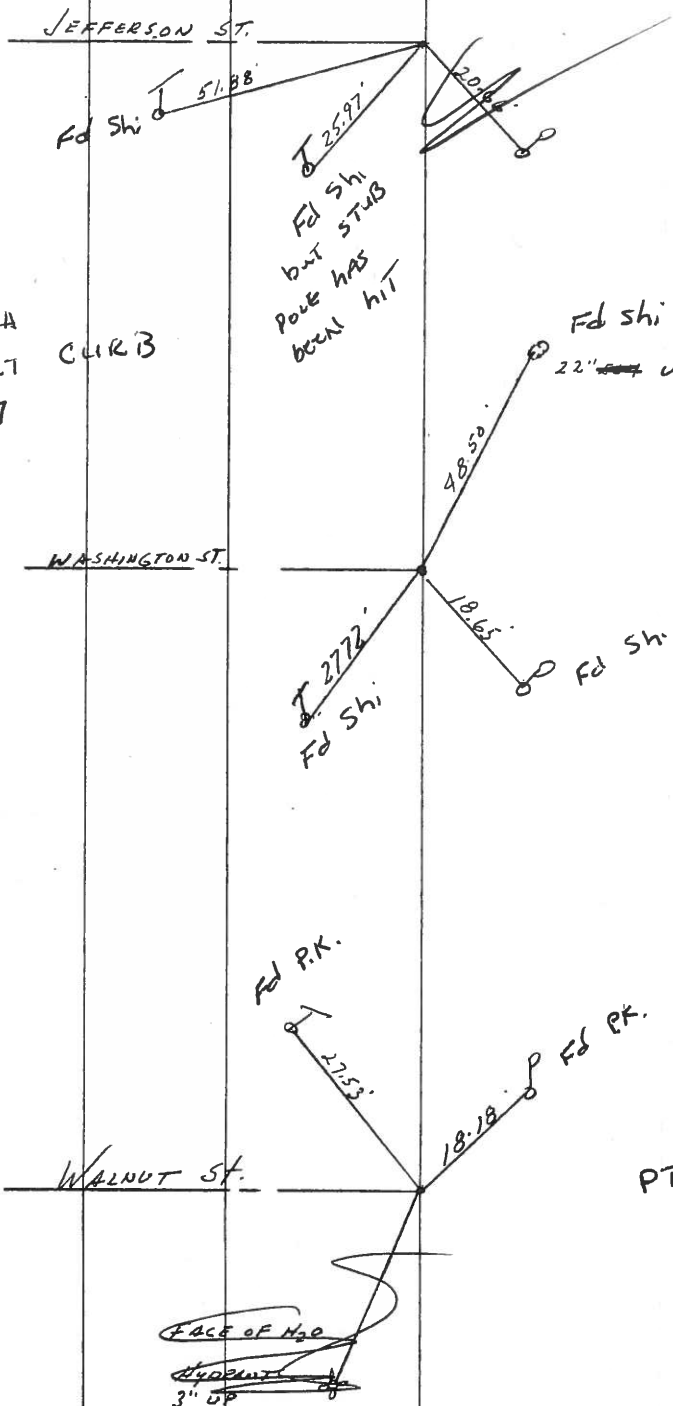

8-5-96
PT. Removed by
SEWER LINE

8-5-96
PT. Removed by
SEWER LINE

Reset P.K. WASHNER
3-19-97
MPL

8-5-96
PT. Removed by
SEWER LINE

PERSONNEL	TITLE	PERSONNEL	TITLE
<u>CRONIN</u>			
<u>RIPPLE</u>			
<u>GEYMAN</u>			

COUNTY OTTAWA
 DATE 4/20/89
 S. R. #19
 WEATHER SUNNY
 SEC. oak harbor
 TEMP. 63°

DESCRIPTION TIES - INTERSECTING STREETS - SET BY OTHERS JOB NO. _____

