



O.D.O.T. DISTRICT 2 SURVEY OFFICE (USE ONLY)

PERSONNEL _____ REFERENCE NO. 24 SHEET 9 OF 29
 NOTES HUSS DATE 10/29/09 ROUTE SR 19
 H.C. CANTERBURY WEATHER FAIR COUNTY OTTAWA
 R.C. GOLDBERG TEMP. 50° TOWNSHIP SALEM
 SECTION 32
 T 6 N R 15 E

TYPE MONUMENT NAIL/SHI
 ON SURFACE - ~~BELOW~~ ON _____
 LEFT - ☉ PAV'T - ~~RIGHT~~ 0.5'
12.4' TO RT EDGE PAVEMENT
 S.L.M. 218+97

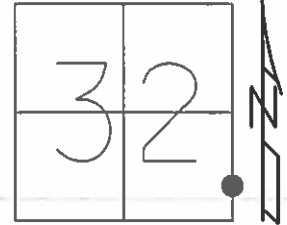

GRID: NORTHING: 675057.347 EASTING: 1791859.178


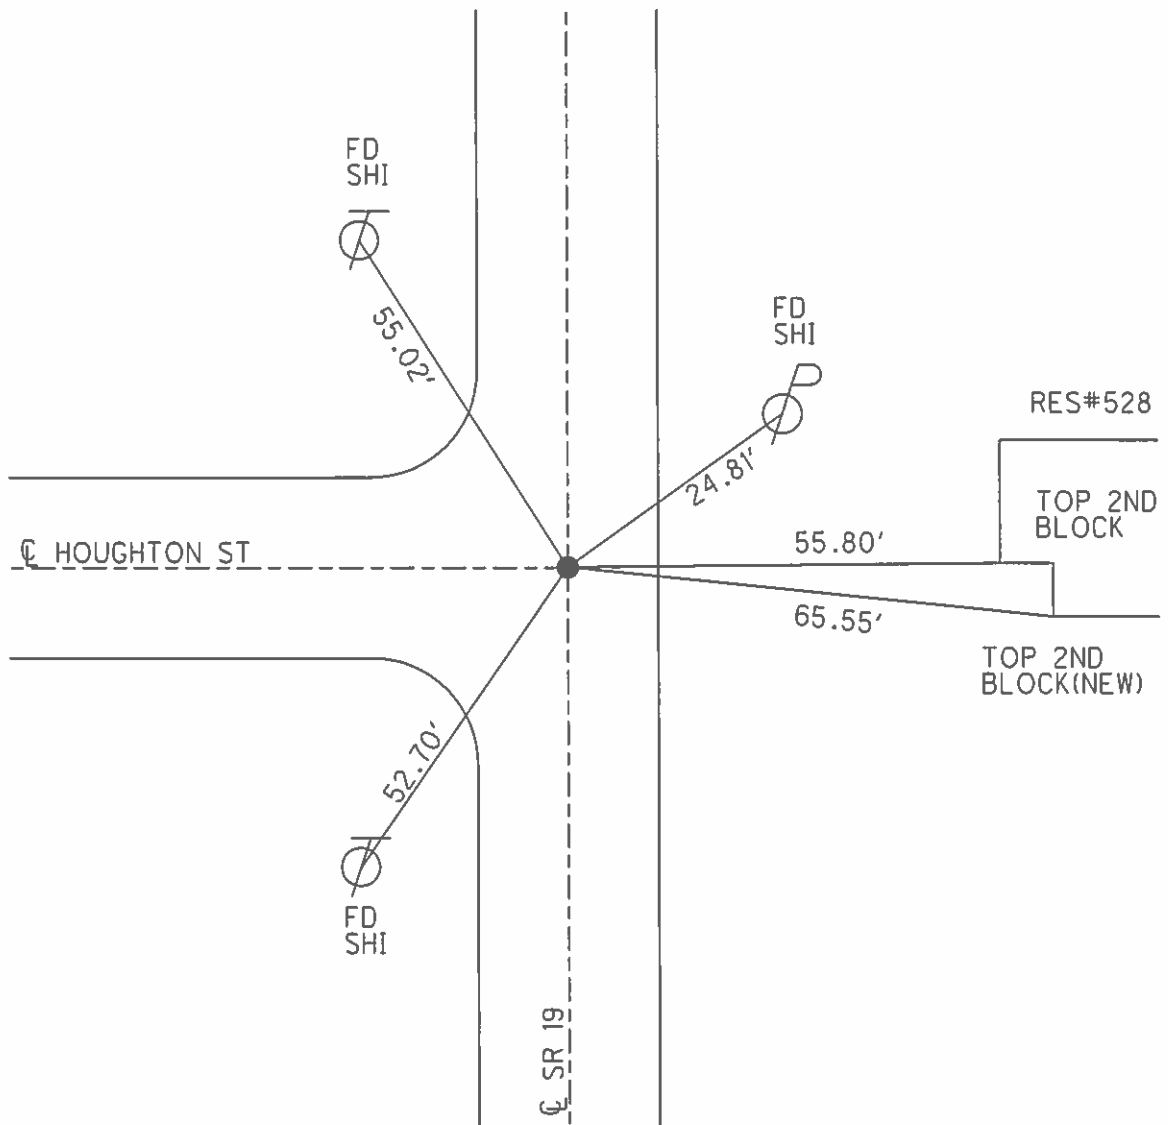


O.D.O.T. DISTRICT 2 SURVEY OFFICE (USE ONLY)

PERSONNEL _____ REFERENCE NO. 24 SHEET 13 OF 33
 NOTES HUSS DATE 10/29/09 ROUTE SR 19
 H.C. CANTERBURY WEATHER FAIR COUNTY OTTAWA
 R.C. GOLDBERG TEMP. 50° TOWNSHIP SALEM
 _____ SECTION 32
 _____ T 6 N R 15 E

TYPE MONUMENT NAIL/SHINNER
 ON SURFACE - ~~BELOW~~ ON
 LEFT - ☉ PAV'T - ~~RIGHT~~ 0.5'
12.4' TO RT EDGE PAVEMENT
 S.L.M. 218+97

Grid: Northing: 675057.347 Easting: 1791859.178

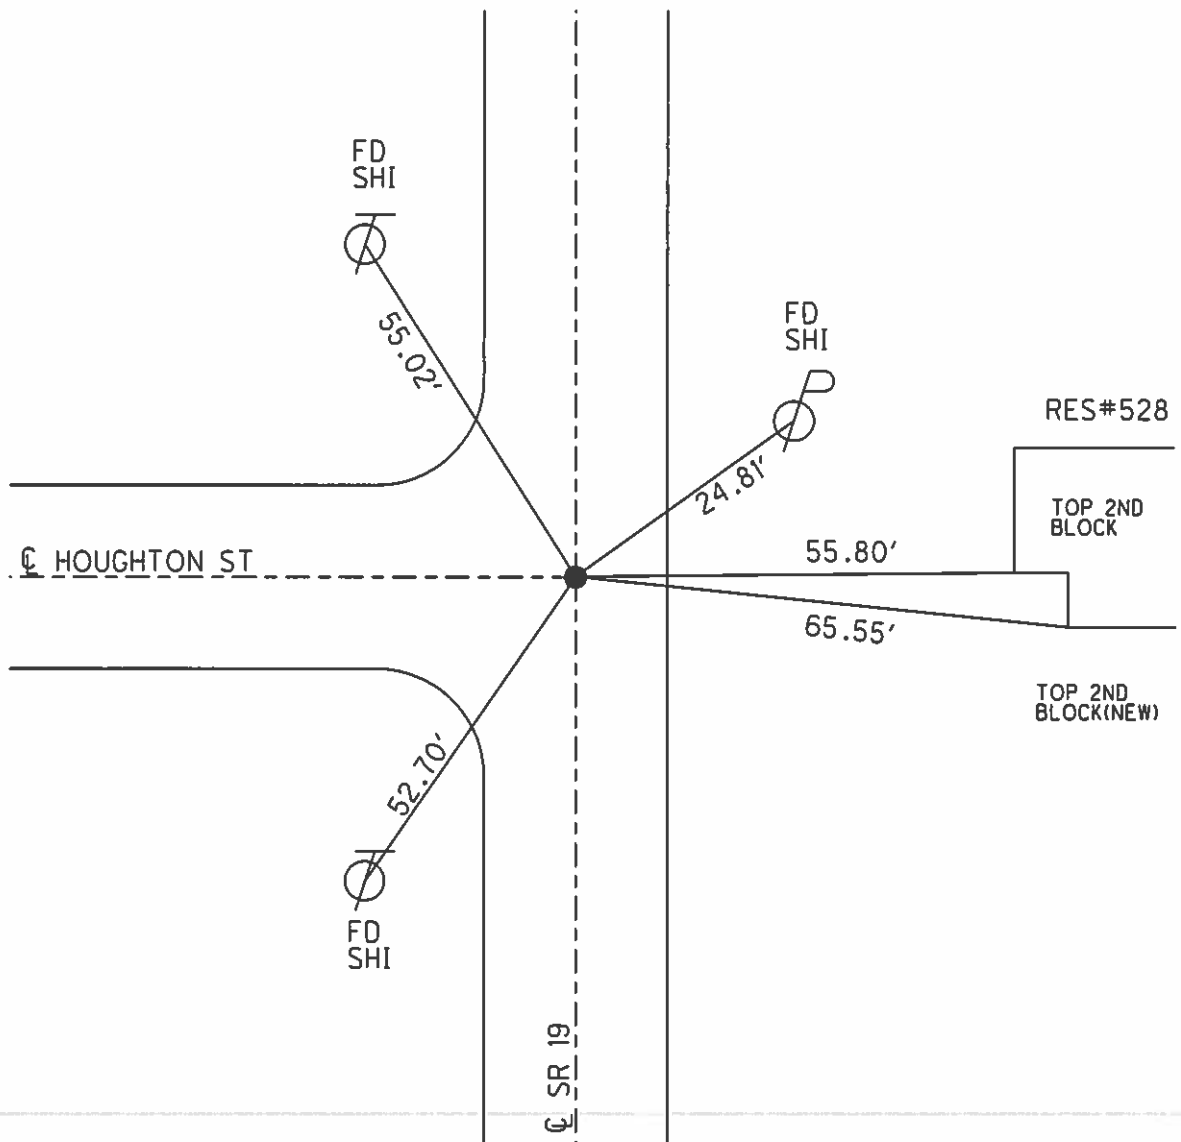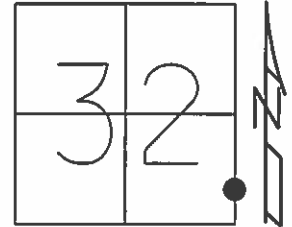

PERSONNEL

TITLE

PERSONNEL

TITLE

COUNTY OTTAWA

DRAWN 4/24/89

DATE 4/20/89

CRONIN

RIPPLE

GEYMAN

S. R. #19

WEATHER SUNNY

SEC. OAK HARBOR

TEMP. 63°

DESCRIPTION TIES INTERSECTING STREETS - SET BY OTHERS

JOB NO.

LEFT

CENTER LINE


RIGHT




P.K. & WASHER ATOP SAME
ATOP P.K.

25

BANK ST.

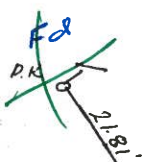


8-5-96
PT. Removed by
SEWER LINE

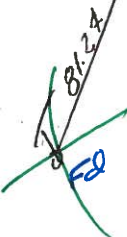


P.K. & WASHER ATOP SAME
ATOP P.K.

.24

Houghton ST

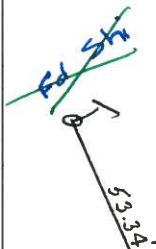

8-5-96
PT. Removed by
SEWER LINE
THESE TIES DIDN'T
CROSS

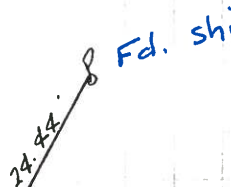


5580

6547

2 STORY RES
528

TOP 2ND BLOCK

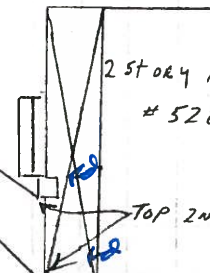

PERSONNEL TITLE PERSONNEL TITLE

COUNTY OTTAWA

DRAWN 4/24/89

RONIN

DATE 4/20/89

RIPPLE

S. R. #19

WEATHER SUNNY

GEYMAN

SEC. OAK HARBOR

TEMP. 63°


DESCRIPTION TIES INTERSECTING STREETS - SET BY OTHERS

JOB NO.

LEFT

CENTER LINE

RIGHT

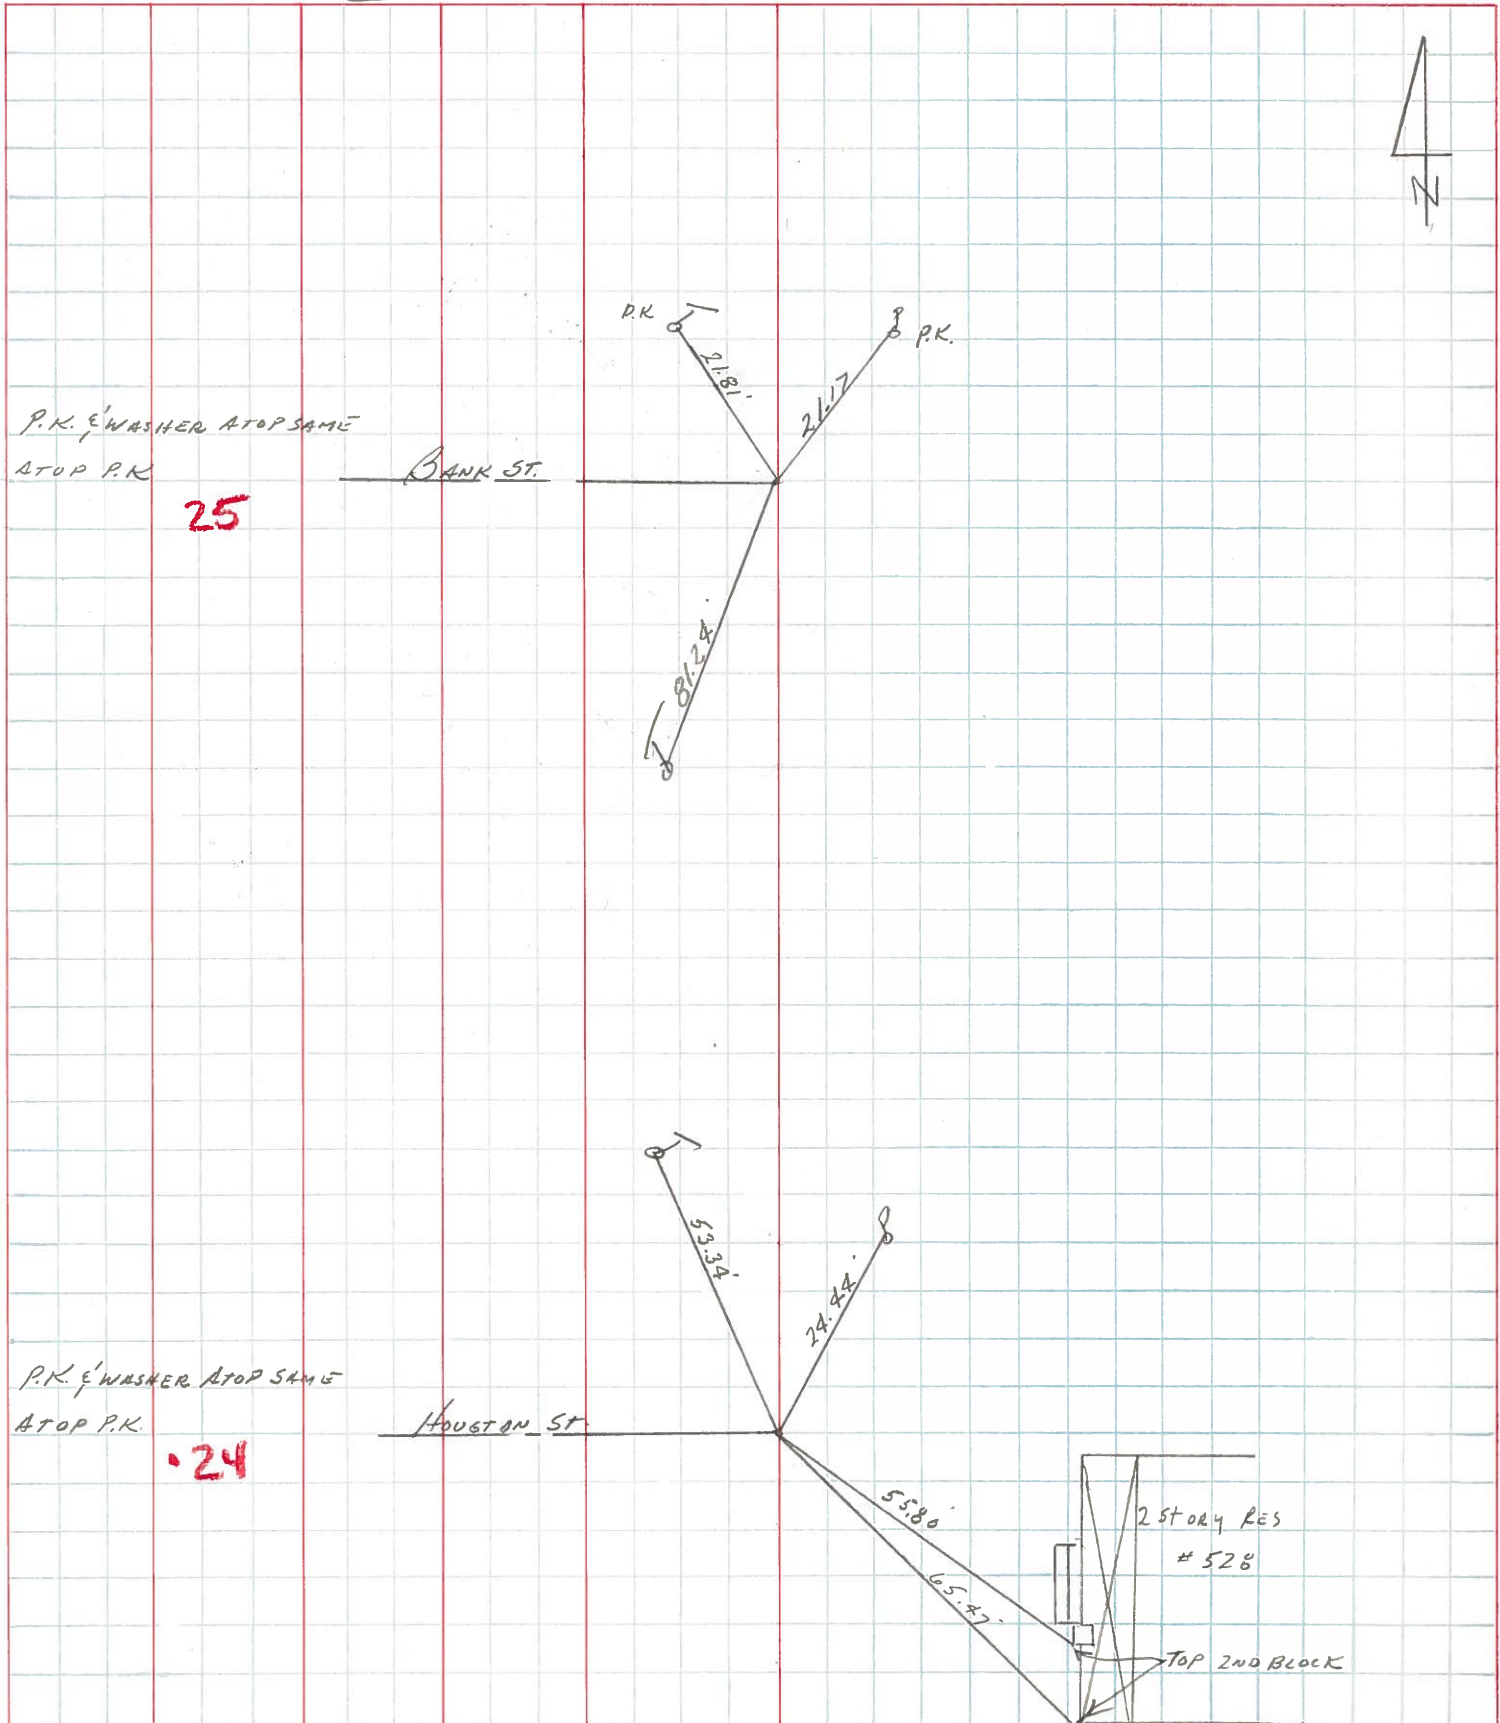


PERSONNEL TITLE PERSONNEL TITLE

COUNTY Ottawa DATE 4-25-78


S. R. 19 WEATHER Fair - Windy

SEC. 32 E 33 TEMP. 50°

DESCRIPTION Oak Harbor LEFT CENTER LINE RIGHT JOB NO.

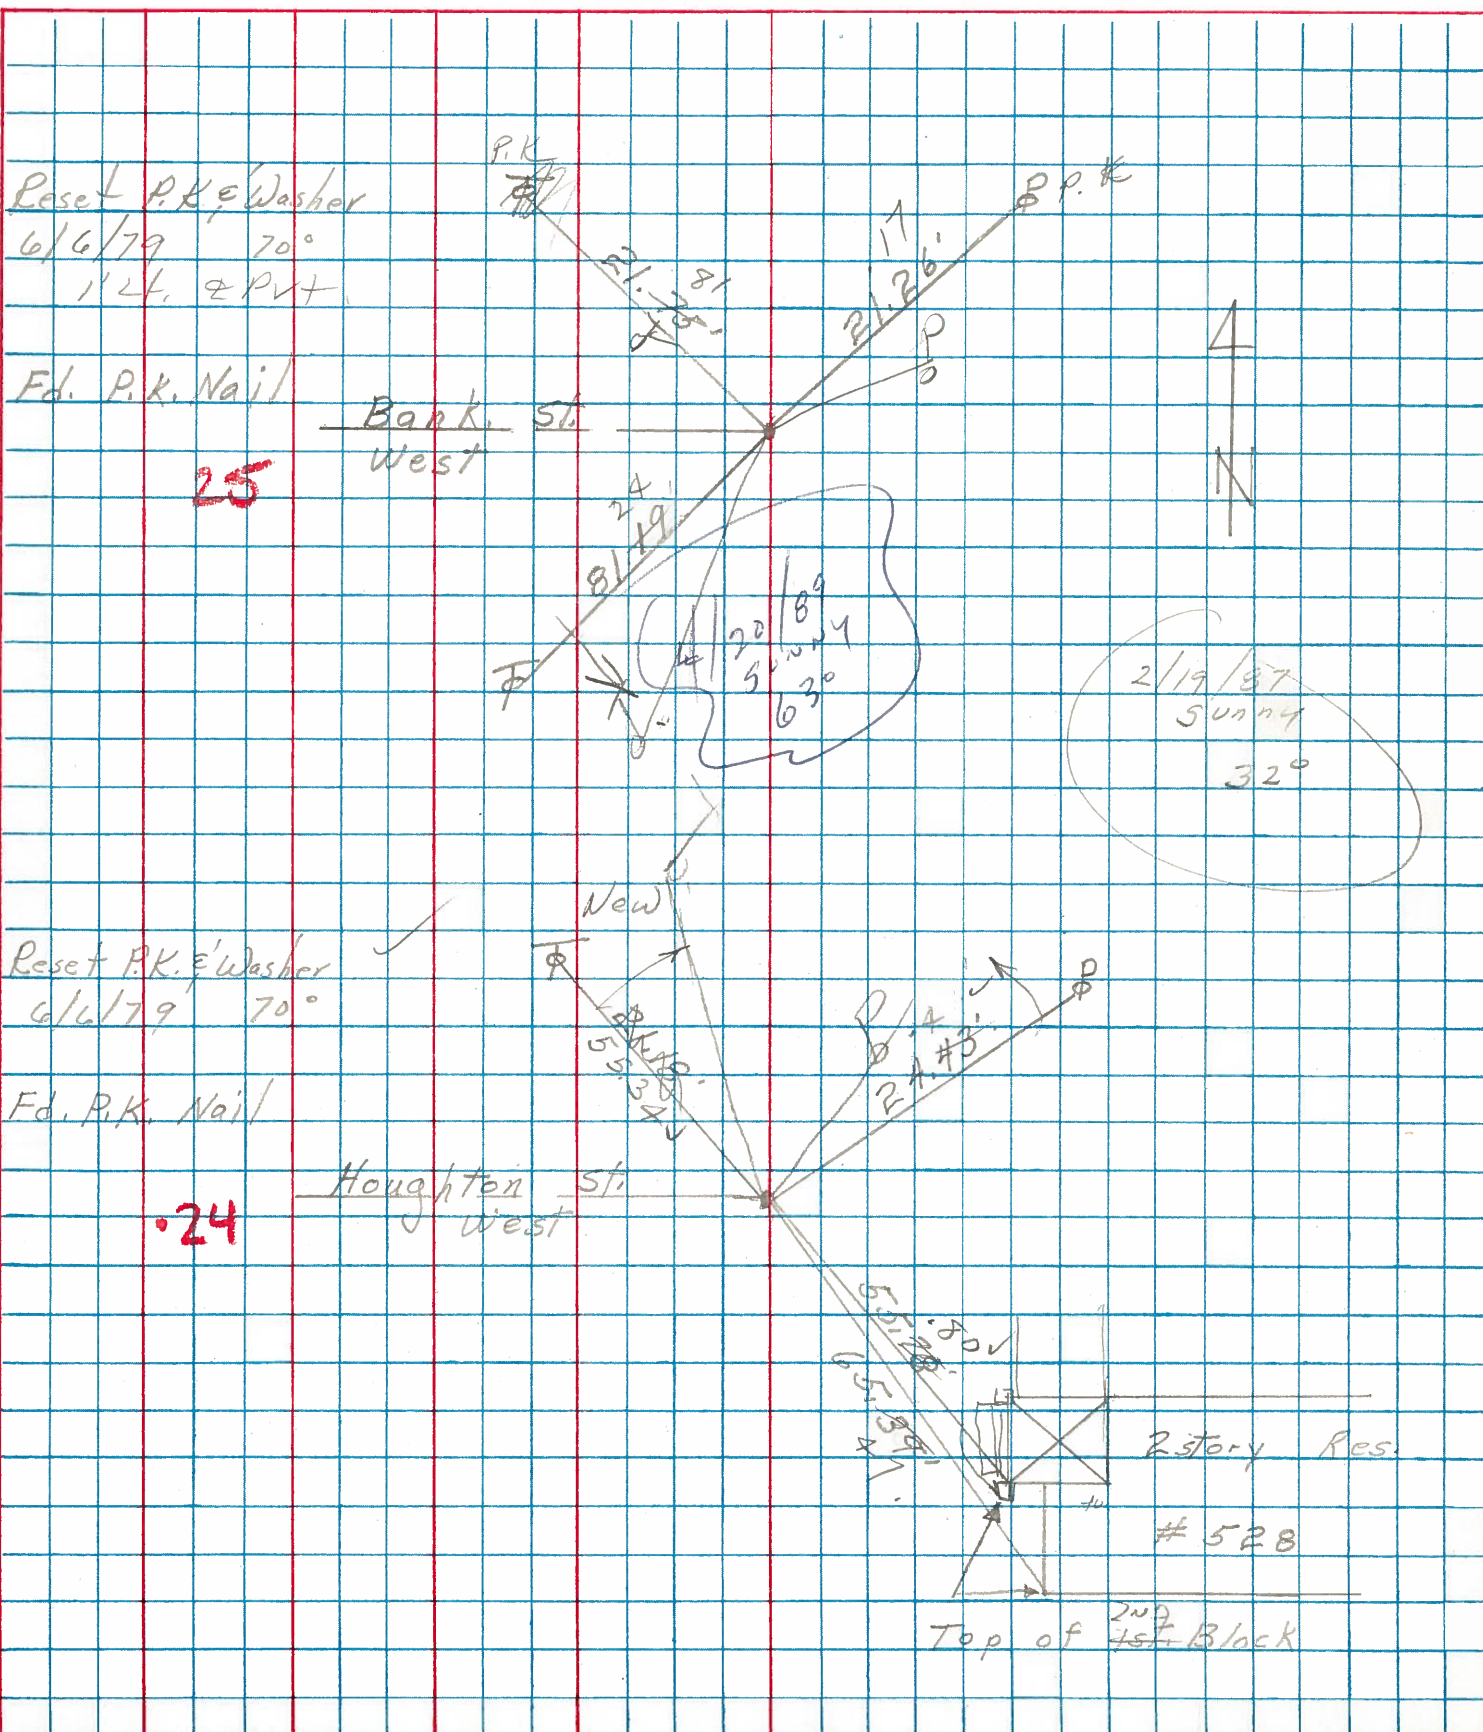

PERSONNEL	TITLE	PERSONNEL	TITLE
COUNTY <u>Ottawa</u>		DATE <u>5-4-71</u>	
S. R. <u>19</u>		WEATHER _____	
SEC. <u>32E 33</u>		TEMP. _____	
DESCRIPTION <u>Oak Harbor</u>			JOB NO. _____
	LEFT	CENTER LINE	RIGHT

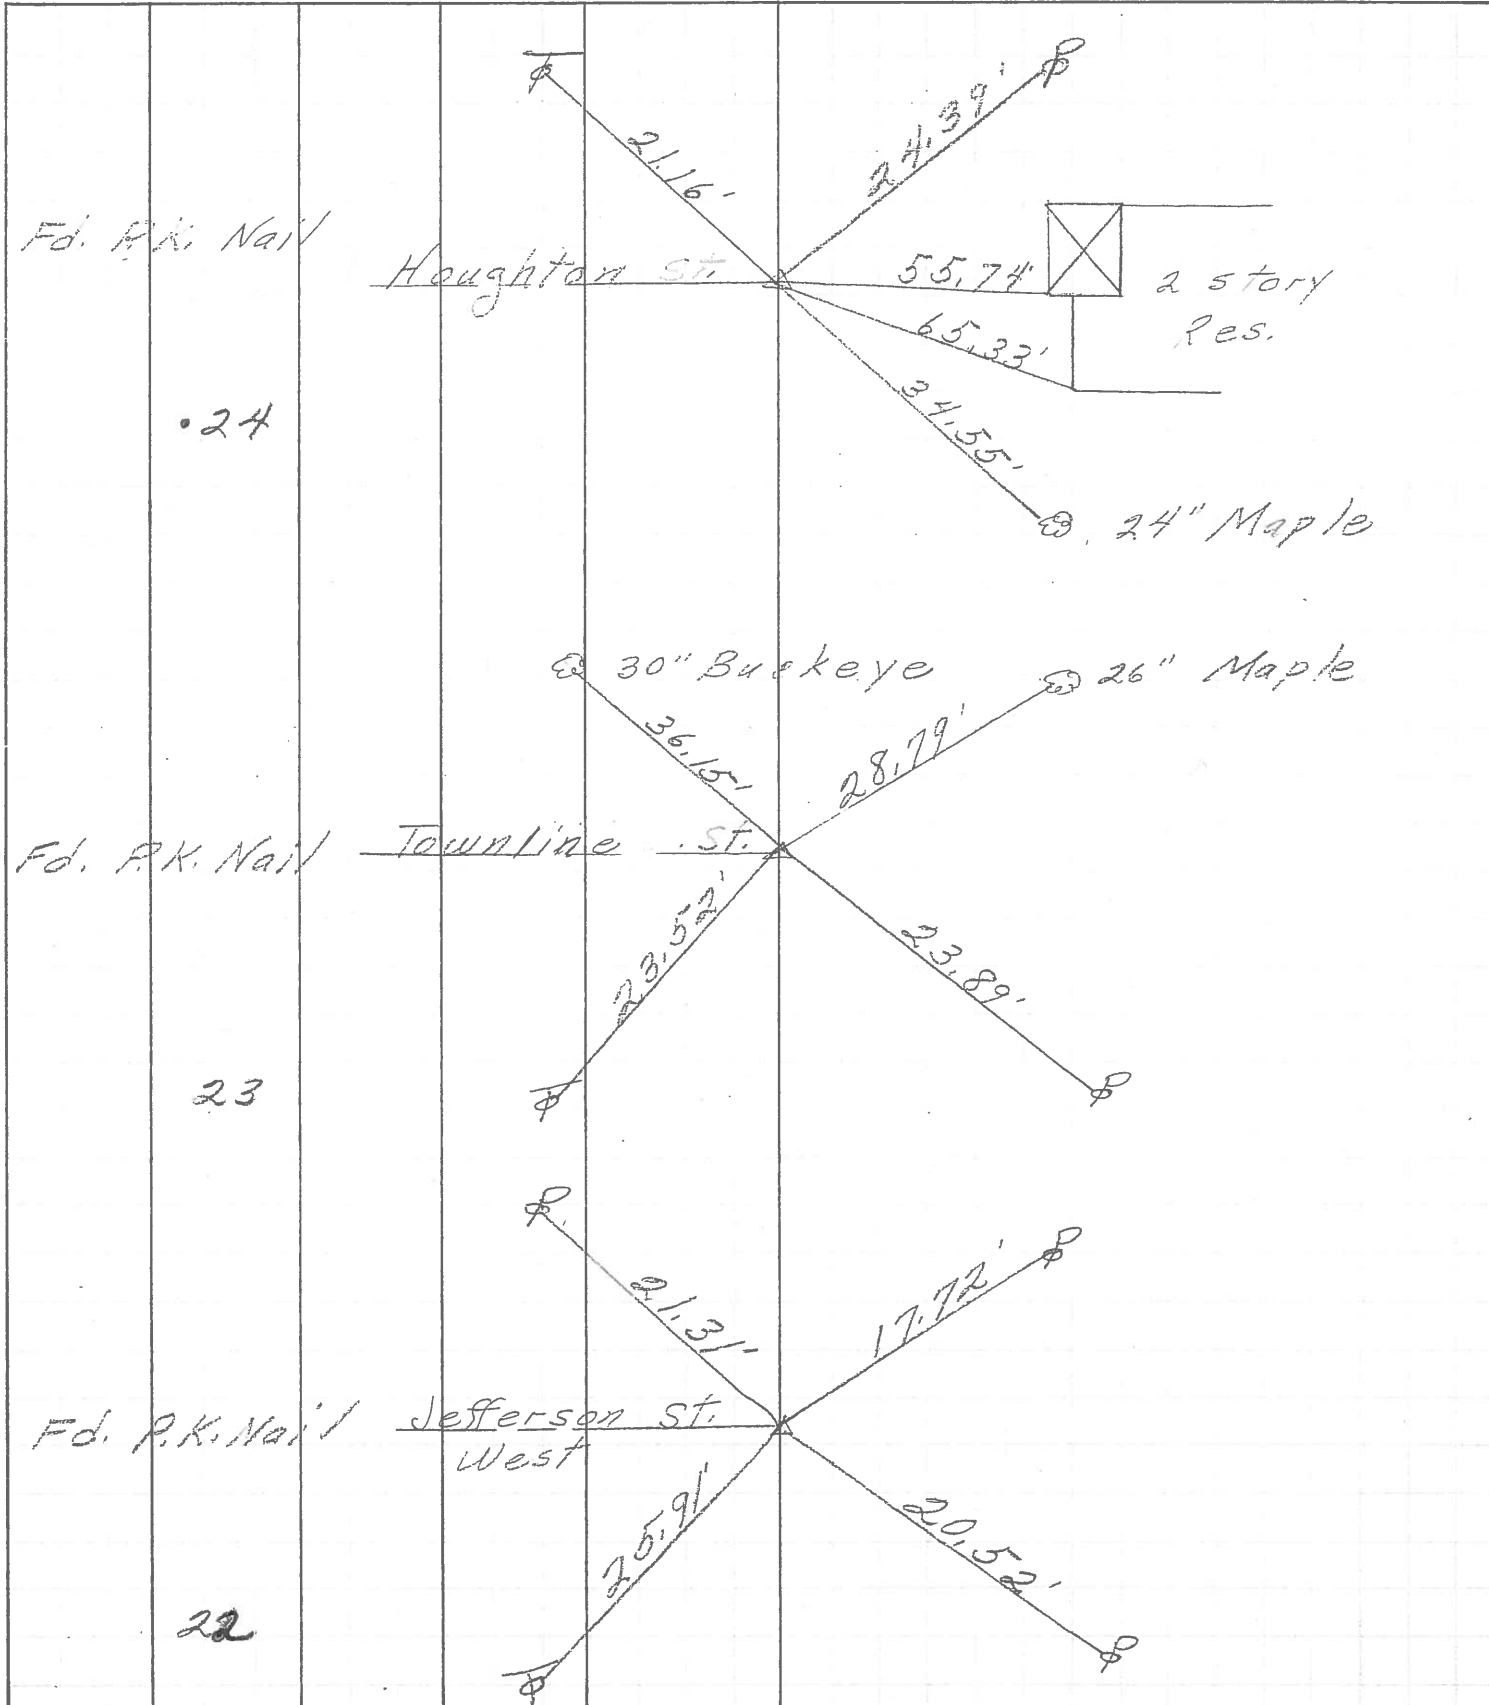

PERSONNEL	TITLE	PERSONNEL	TITLE	COUNTY	<u>Ottawa</u>	DATE	<u>5-13-68</u>	
<u>Schneider</u>				S. R.	<u>19</u>	WEATHER	<u>Fair</u>	
<u>Mosser</u>				SEC.	<u>Oak Harbor</u>	TEMP.	<u>65°</u>	
<u>Barbour</u>								
<u>Redding</u>								
DESCRIPTION	<u>Ties for Control Points</u>						JOB NO.	

