

NOTES To: B. Kasebeck 2-28-77

6001 (2)

1994 TWO-LANE RESURFACING PROGRAM

1995

33

PERSONNEL CHEWNEY

RIPPLE

GEYMAN

PRIORITY NO. 47 PART 3 OF 3 SHEET 1 OF 12

COUNTY OTTAWA ROUTE SR 51 SECTION 00.00

BEGIN LOG (SLM) 0.00 TERMINII Sandusky Co Line

END LOG (SLM) 4.91 TERMINII SR 163

TOTAL LENGTH 4.91 MILES

MUNICIPALITY Elmore BEGIN LOG (SLM) 0.02 RT, 100 LT END LOG (SLM) 1.46

MUNICIPALITY Elmore BEGIN LOG (SLM) 0.02 RT, 100 LT END LOG (SLM) 1.46

PROPOSED WORK: Resurfacing

PAVEMENT In place recycling #1 1/4" 404 SHOULDER SAME, 6017

OTHER "BEGIN SEC. 2"

STATION ESTABLISHED FROM: 0+00 @ REF. #1 (SR #51 OTTAWA COUNTY)

FEATHERED CONST. JOINT @ STA 0+03

STRUCTURES:

NUMBER	STATION	WIDTH	LENGTH	PROPOSED WORK
0022	11+18	34'	65'	
0051	26+97	28'	200'	
0144	75+87	30'	285'	
0385	203+57	39.5'	95'	

RAILROAD CROSSING: None

(NO WORK)

NAME Elmore STATION 0+00 NO. TRACKS 2 LENGTH ALONG C L 100 FT

NAME Elmore STATION 0+00 NO. TRACKS 2 LENGTH ALONG C L 100 FT

DATE 2-24-1994

1994 TWO-LANE RESURFACING PROGRAM
INTERSECTIONS

SHEET 2 OF 12

COUNTY OTTAWA

ROUTE SR # 51

SECTION 0.00

L - PROP PAVT DEPTH (IN) X IO; W - WIDTH @ MOUTH; W-I - WIDTH @ THROAT

STATION	SIDE	NAME OR NO.	L	W	W-I	ASPH	CONC	REMARKS
49+69	RT.	JACKSON ST.	12.5'	41'	18.5'	✓		
52+70	LT.	C.R. #18		172'	99'	✓		
53+05	RT.	FREMONT		91'	46'	✓		
58+78	RT.	CONGRESS		41'	24'	✓		
58+78	LT.	CONGRESS		41'	24'	✓		
64+48	RT.	OTTAWA		44'	28'	✓		
66+73	RT.	MAPLE ST.		59'	29'	✓		
66+73	LT.	MAPLE ST.		42'	21'	✓		
* SEE NOTES	RT.	TOLEDO ST.		* NOTE: SEE SKETCH OF INTERSECTION DETAILS TOLEDO, RICE & SR #51				* NOTE: TOLEDO & RICE ARE BOTH ASPHALT PAVED
@ RIGHT	RT.	RICE ST.						
74+90	LT.	MAPLE ST. LUCKY AVE.		116'	74'	✓		
80+46	LT.	T.R. #135		52'	25'	✓		
83+71	RT.	S.R. #105		110'	65'	✓		
83+71	LT.	SR #105		115'	55'	✓		
87+12	LT.	TR #1065		49'	29'	✓		
101+53	RT.	C.R. #213		146'	85'	✓		
119+50	LT.	T.R. #50		87'	47'	✓		
183+21	RT.	T.R. #57		84'	38'	✓		
183+21	LT.	T.R. #4		71'	32'	✓		
198+00	RT.	T.R. #214		116'	58'	✓		

DATE 3-23-1984

SHEET 3 OF 12

1994 TWO-LANE RESURFACING PROGRAM

UTILITIES (CATCH BASIN, MANHOLE, INLET, WATERVALVE, BOX AND MONUMENT BOX)

COUNTY OTTAWA ROUTE #51 SECTION 000

R - RAISE F - FEATHER

STATION	OUT (FT) RT/LT OF Q	CATCH BASIN	MAN- HOLE	INLET	W V BOX	MON BOX	CASTING		REMARKS Re: RECONSTRUCT, NO WORK
							R	F	
49+55	18' RT.	✓						✓	
52+12	14' RT.	✓						✓	
53+60	23' RT.	✓						✓	
58+72	21' RT.		✓					✓	
60+31	14' RT.	✓						✓	
60+31	14' LT.	✓						✓	
60+36	14' RT.	✓						✓	
60+36	14' LT.	✓						✓	
64+67	24' LT.				✓			✓	
66+12	15' RT.	✓						✓	
66+12	15' LT.	✓						✓	
66+66	27' LT.	✓						✓	
66+80	21' RT.		✓					✓	
66+87	15' LT.				✓			✓	
66+90	18' LT.				✓			✓	
67+60	15' RT.	✓						✓	
67+60	15' LT.	✓						✓	
70+11	15' RT.	✓						✓	
70+11	15' LT.	✓						✓	
70+89	15' LT.	✓						✓	

TITLE	PERSONNEL	COUNTY	DATE
P.C.	CHENEY	OTAWA	3-23-1974
	RIPPLE	#51	WEATHER FAIR
	GLEYMAN		TEMP. 70°
		S. R.	SEC. 0.00
			JOB NO. 624034

[illegible]

SHEET 5 OF 12

1994 TWO-LANE RESURFACING PROGRAM
PAVEMENT DATA

NOTE: LOCATE ALL
CHANGES IN PVMT WIDTH

COUNTY OTAWA ROUTE # 51 SECTION 0.00

PAVEMENT MARKINGS:

[illegible]

DATE 3-23-1974

SHEET 6 OF 12

1994 TWO-LANE RESURFACING PROGRAM

PAVEMENT DATA

NOTE: LOCATE ALL
CHANGES IN PVMT WIDTH

COUNTY OTTAWA ROUTE #51 SECTION 0.00

MILE MARKER	STATION	LEFT BERM WIDTH (TYPE)	PAVEMENT WIDTH OUT/OUT WHITE LINES	RIGHT BERM WIDTH (TYPE)
	0+00	2' PAVED	26'	2.5' PAVED
	10+00	2'	24'	3'
	10+00	2'	24'	3'
	22+00	2.5'	24'	2.5'
Elmore Corp. Line	32+38	3'	24'	2'
	38+00	6'	24'	5'
	47+05	3'	24'	2.5'
Begin CURB LT.	47+55	3'	24'	2.5'
END CURB LT.	50+68	3'	24'	2.5'
Begin CURB RT.	51+43	3'	27'	0'
#1	52+58	—	—	—
Begin CURB LT.	53+42	—	—	—
	54+00	CURB	30.5'	CURB
Begin to Widen	64+65	"	30.5'	"
End widening	66+10	"	50.5'	"
WIDENING SEE PLAN	71+12	"	50'	"
SH. #1	73+30	"	26.5'	"
END CURBS, CORP. LINE	75+61	"	28.5'	"
	80+00	2.5'	24.5'	3'
#2	105+73	2'	24.8'	3.5'
#2	101+00	2'	25'	3.5'

1994 TWO-LANE RESURFACING PROGRAM
DEFECTIVE PAVEMENT AREAS

SHEET 7 OF 21

COUNTY OTAWA ROUTE #51 SECTION 0.00

[illegible]

SHEET 8 OF 12

1994 TWO-LANE RESURFACING PROGRAM
CENTERLINE PAVEMENT MARKINGS
INSIDE CITY LIMITS ONLY

COUNTY OTTAWA ROUTE #51 SECTION 0.00

[illegible]

DATE 3-23-1994

21 OF 6 SHEETS

SECTION 0.00

[illegible]

OHIO DEPARTMENT OF TRANSPORTATION


SHEET NO. 10-12

PERSONNEL CHENEY TITLE H. TAPE PERSONNEL TITLE COUNTY OTTAWA DATE 2-25-1994
 PERSONNEL RIPLEY TITLE L. TAPE PERSONNEL S. R. # 51 WEATHER CLOUDY
 PERSONNEL GEYMAN TITLE PERSONNEL SEC. 0.00 TEMP. 25°
 DESCRIPTION SPEED BUMP LOCATION JOB NO. 624034

RIGHT

CENTER LINE PAV'T

LEFT

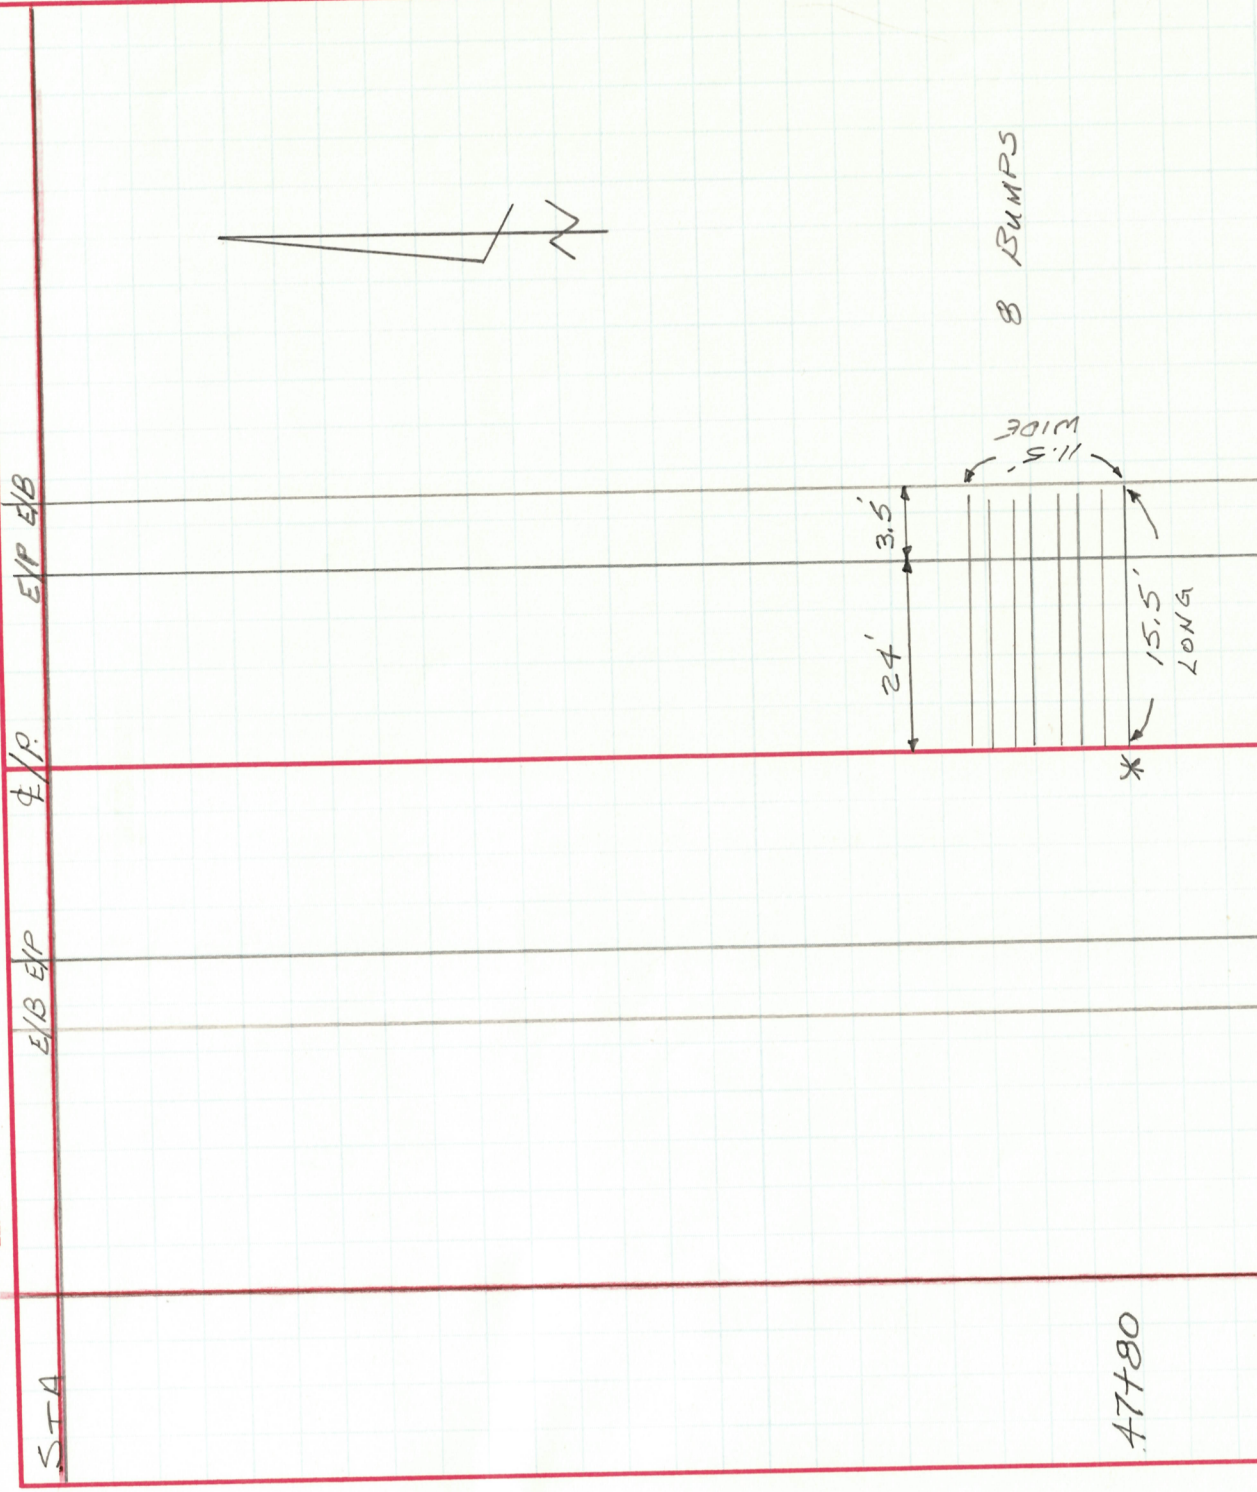

COUNTY OTAWA


S. R. #51

WEATHER Cloudy

SEC. 0.00

TEMP: 10°

DESCRIPTION	CENTER LINE	RIGHT	JOB NO.
INTERSECTION DETAIL: S.R. #51, TOLEDO STREET			629034

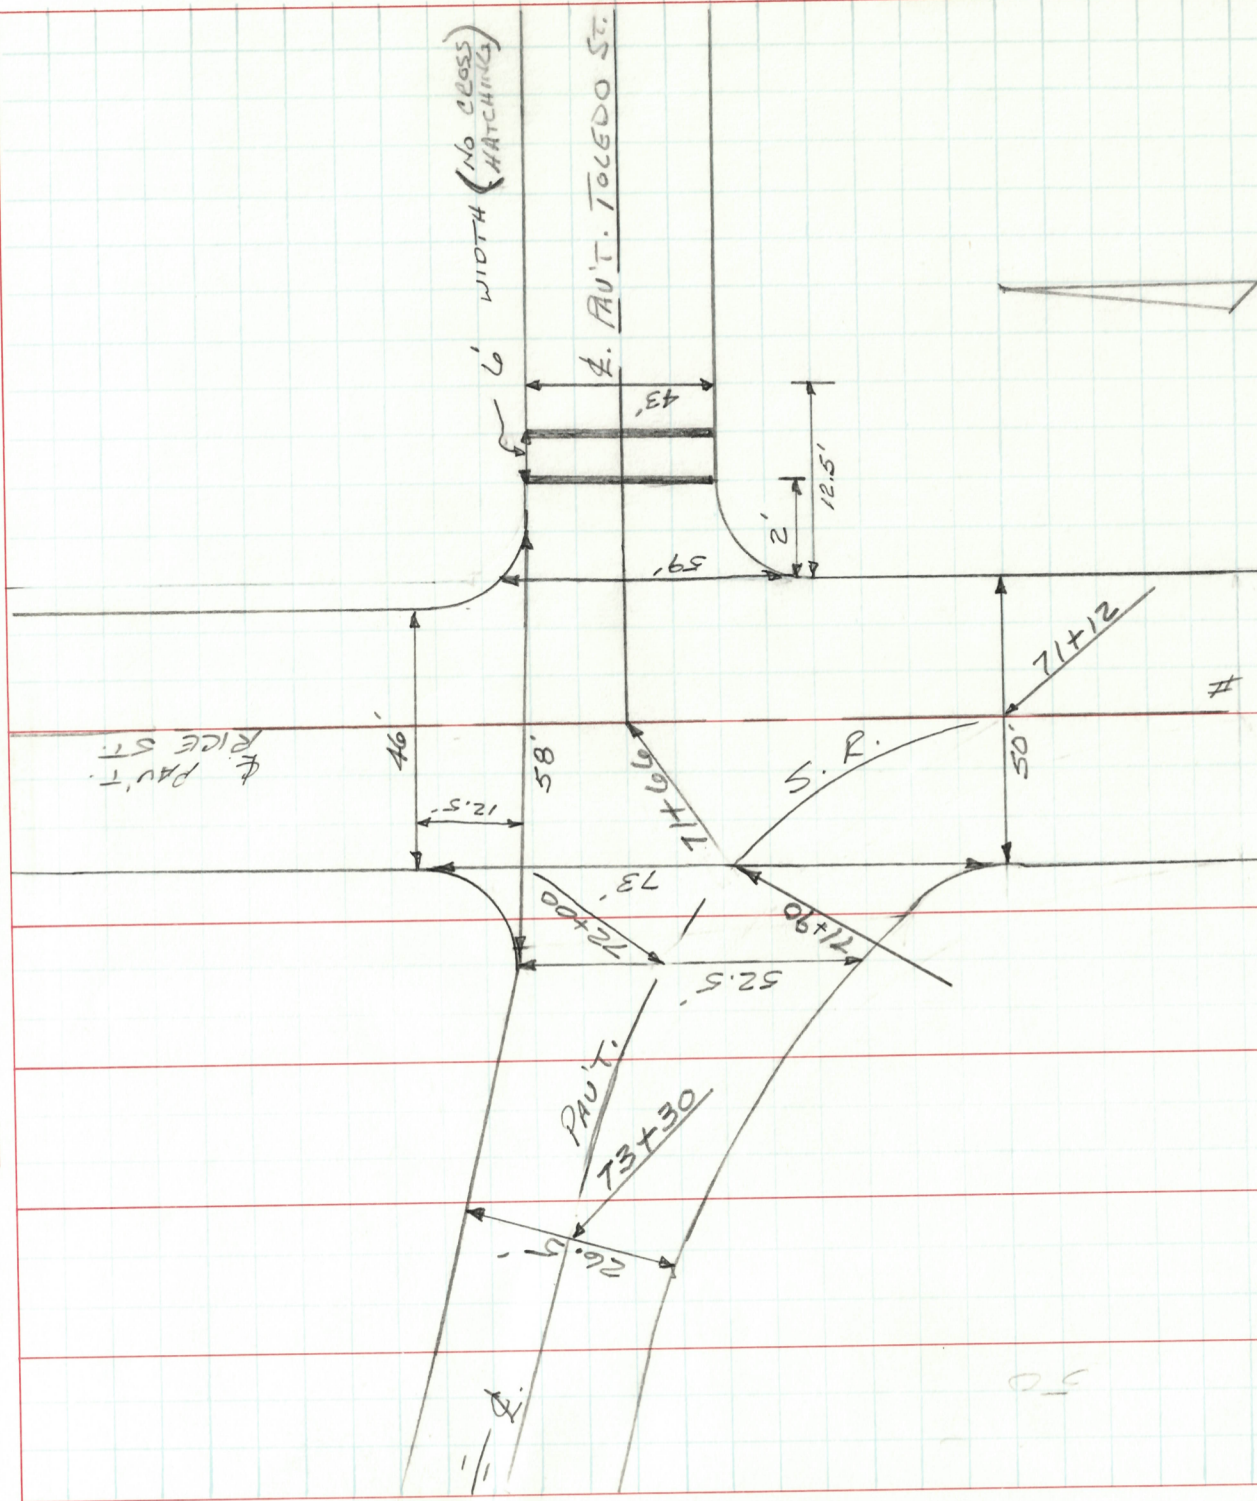


PERSONNEL
 CHENEY
 R. PALE
 GEYMAN

TITLE
 H. TAPE
 R. TAPE

PERSONNEL
 COUNTY OTAWA
 # 51
 S. R. # 51
 SEC. 0.00

DATE 2-28-1994
 WEATHER Cloudy
 TEMP. 15°

DESCRIPTION INTERSECTION DETAIL: S.R. # 51 & S.R. # 163
 JOB NO. 624034

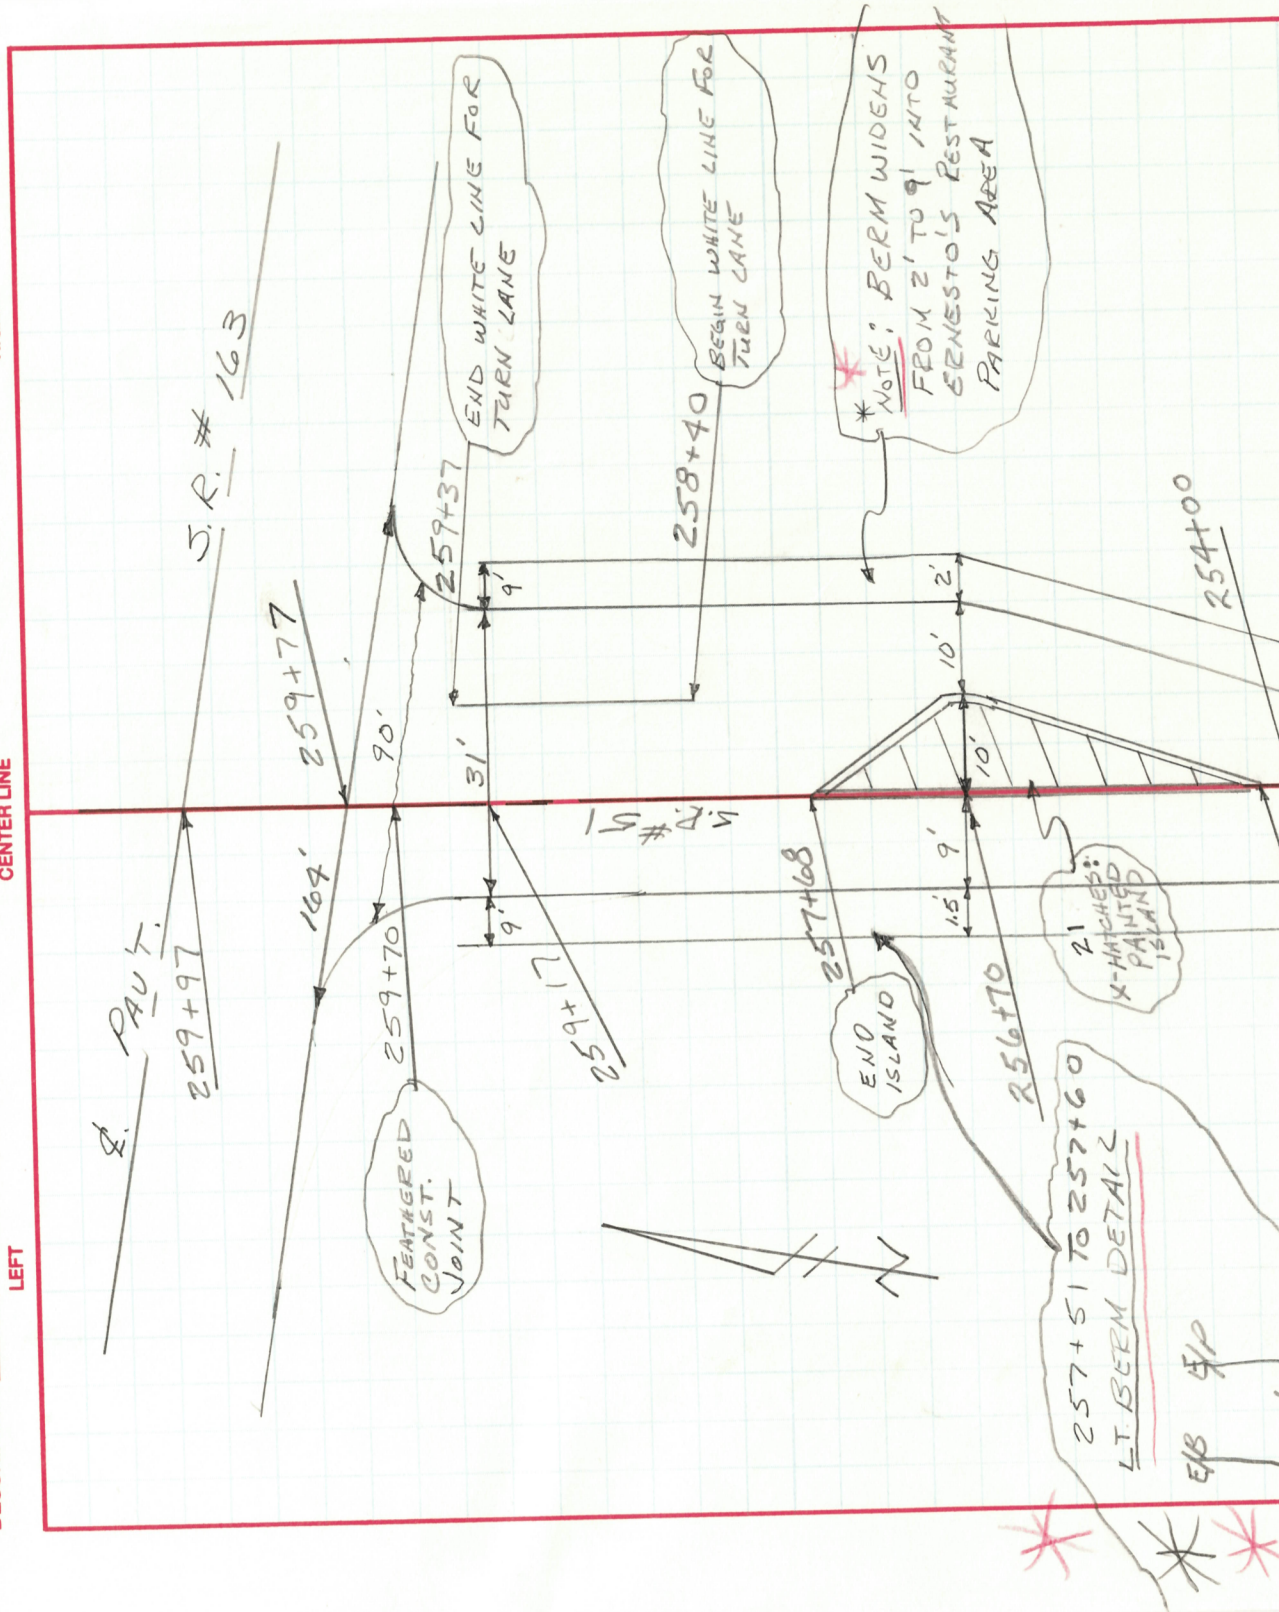




O.D.O.T. DISTRICT 2 SURVEY OFFICE

PERSONNEL _____ REFERENCE NO. 1 SHEET 1 OF _____

NOTES Cronin
H.C. Burish
R.G. Barbour
Cyman

DATE 9/21/87 ROUTE # 51
WEATHER sunny COUNTY Sandusky
TEMP. 63° TOWNSHIP Woodville
SECTION 30
T 6 U 1 R 14 E

TYPE MONUMENT R.R. spike
ON SURFACE - BELOW 2" below surface
LEFT - 6 PAV'T. - RIGHT 2 Pav't
TO _____ EDGE PAVEMENT
S.L.M. _____

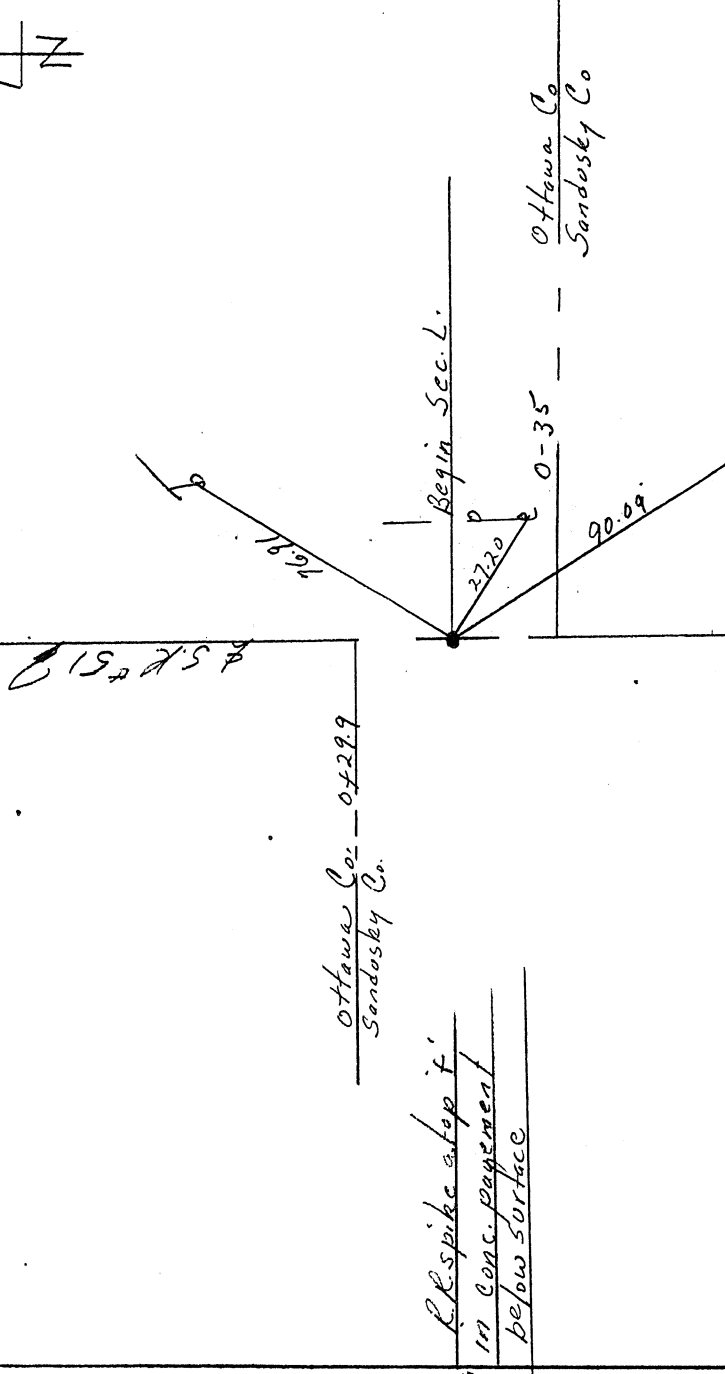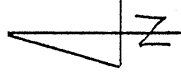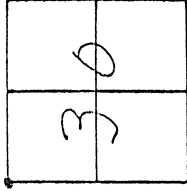

O.D.O.T. DISTRICT 2 SURVEY OFFICE

PERSONNEL

REFERENCE NO. 2 SHEET 2 OF

NOTES

Cranin

H.C.

Pierpa

R.C.

Borbour

Geyman

DATE

9/21/87

WEATHER

sunny

TEMP.

63°

ROUTE

51

COUNTY

Ottawa

TOWNSHIP

Harris

SECTION

19

T 6 N R 14 E




TYPE MONUMENT PK's & washers

ON SURFACE - BELOW on surface

LEFT- & PAV'T. - RIGHT & Pav't.

TO EDGE PAVEMENT

S.L.M. 26+79

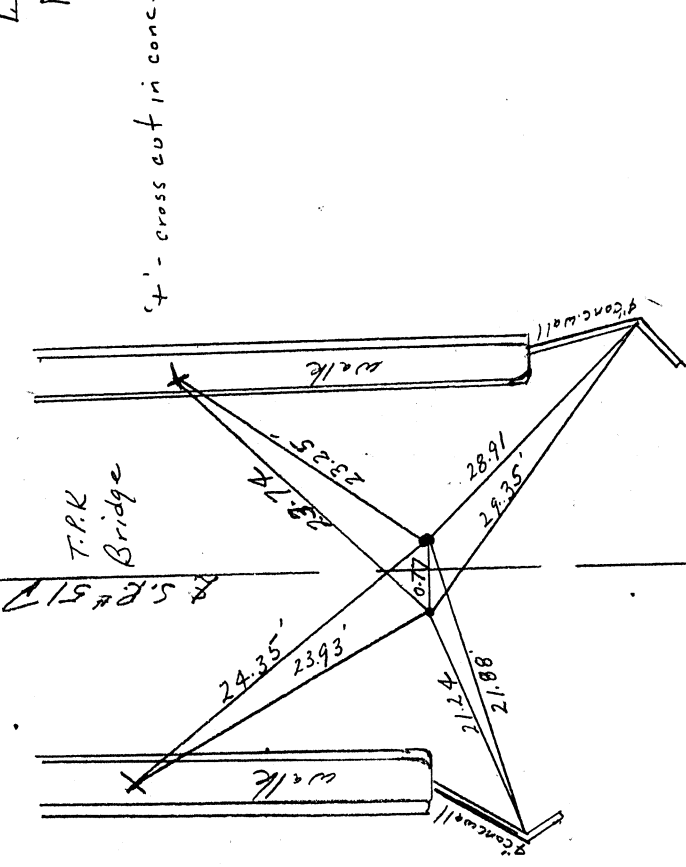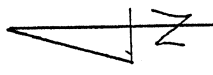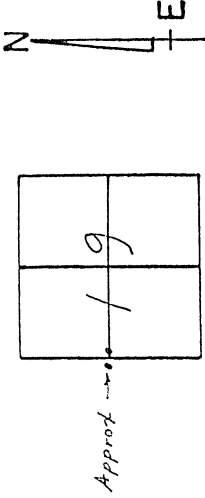

P.K.s at top P.K.s
origin unknown

PERSONNEL _____
NOTES Cronin
H.C. Ripich
R.C. Gorbun
Gorman

REFERENCE NO. 3
SHEET 3 OF _____
DATE 9/21/87
ROUTE 51
WEATHER sunny
COUNTY Ottawa
TOWNSHIP Harris
TEMP. 63°
SECTION 19
T 6 N 14 E

PERSONNEL

NOTES

五

5

Added

—

•



TYPE MONUMENT P.L.

ON SURFACE - BFLOW *on surface*

LEFT - C PAVT - BRIGHT 28' Lt & Pavt.

TO EDGE PAVEMENT

51 M 51+98.39??

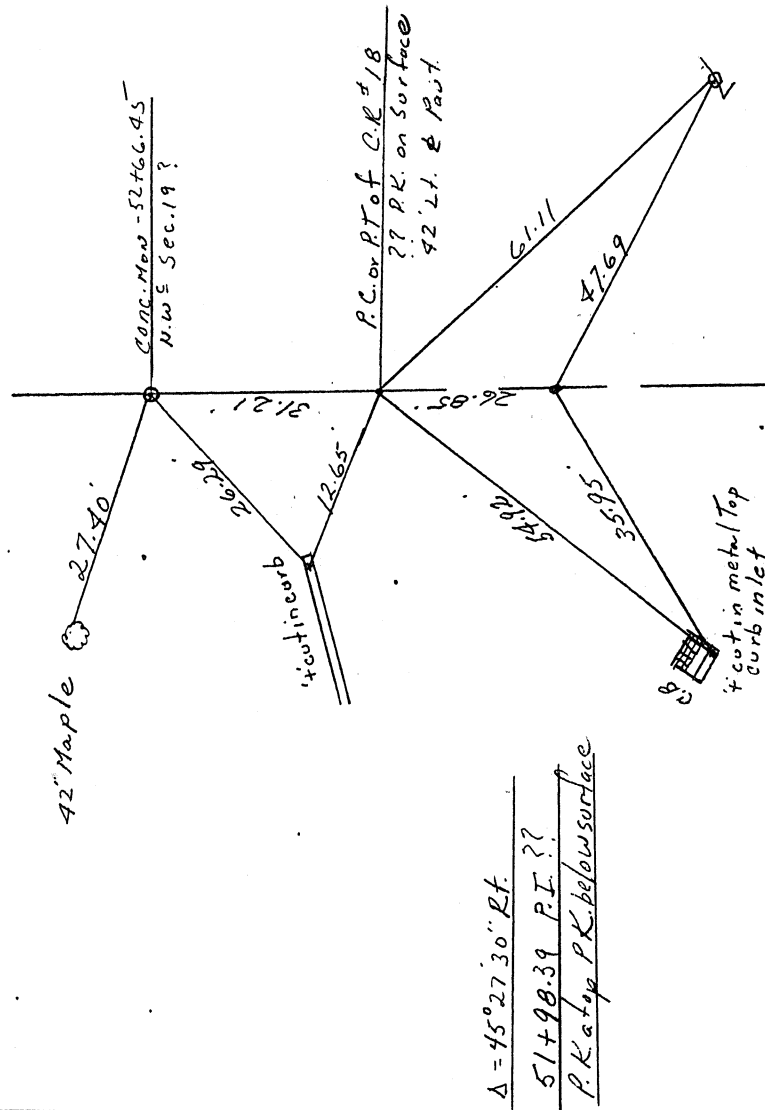
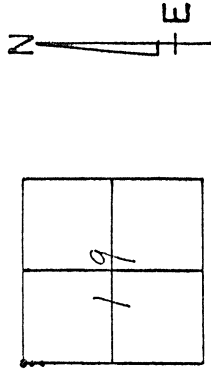


PERSONNEL _____
 NOTES Croan
 H.C. Pipolo
 R.C. Barbour
Geyman

REFERENCE NO. 5
 DATE 7/21/87
 WEATHER cloudy
 TEMP. 65°

SHEET 4 OF _____
 ROUTE 51
 COUNTY Ottawa
 TOWNSHIP Harris
 SECTION 18
 T 6 N R 14 E

TYPE MONUMENT P.K. & washer
ON SURFACE - BELOW on surface
LEFT- & PAW'T. - RIGHT 5 1/2 ft. & Post.
TO EDGE PAVEMENT
S.L.M. 7/140662

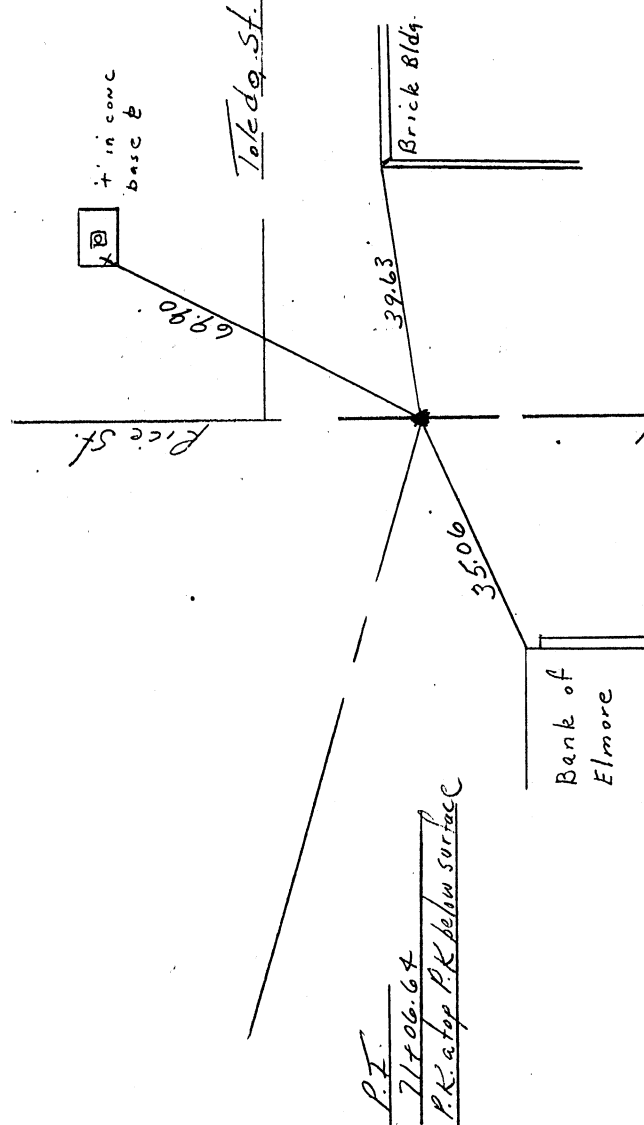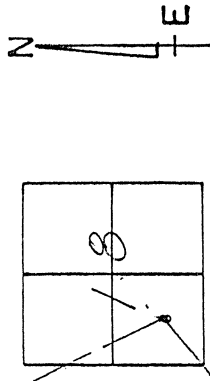

PERSONNEL _____
REFERENCE NO. 6 SHEET 5 OF _____

PERSONNEL

SHEET 5 OF 13

NOTES

NOTES Crenini

٥١

Private.

DATE 9/21/67

ROUTE 51

6.

Garbour

WEATHER c/oudy

COUNTY Ottawa

•

Сержан

TEMP: 65° /

TOWNSHIP Harris

1

SECTION 18

T6 NR 14 E



TYPE MONUMENT P. K. Ewings

ON SURFACE - BELOW *on surface*

LEFT - & PAW'T - RIGHT 2.5 R/L & PAW'T.

TO EDGE PAVEMENT

S1 M 83+40.50

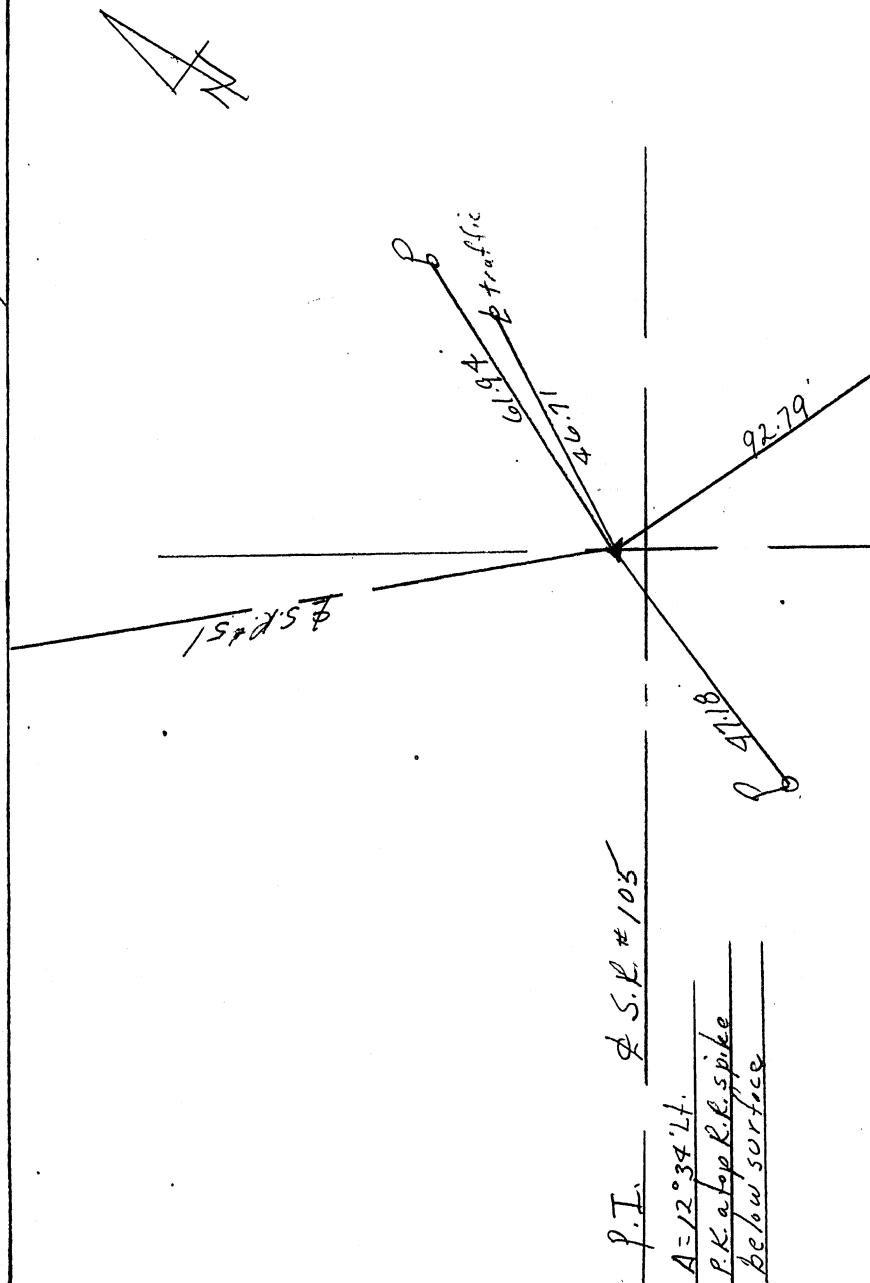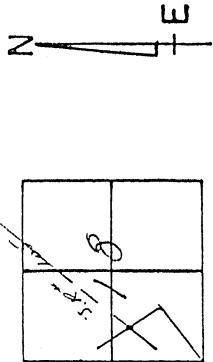



O.D.O.T. DISTRICT 2 SURVEY OFFICE

PERSONNEL _____ REFERENCE NO. 17 SHEET 6 OF _____

NOTES Cronin
H.C. Ripke
R.G. Barbour
Geyman

DATE 9/21/87 ROUTE 51
WEATHER cloudy COUNTY Ottawa
TEMP. 65° TOWNSHIP Harris
SECTION 18
T 6 N 14 E

TYPE MONUMENT P.K.'s washer
ON SURFACE - BELOW on surface
LEFT- & PAW'T. - RIGHT & Pav
TO EDGE PAVEMENT
S.L.M. 88+59.23

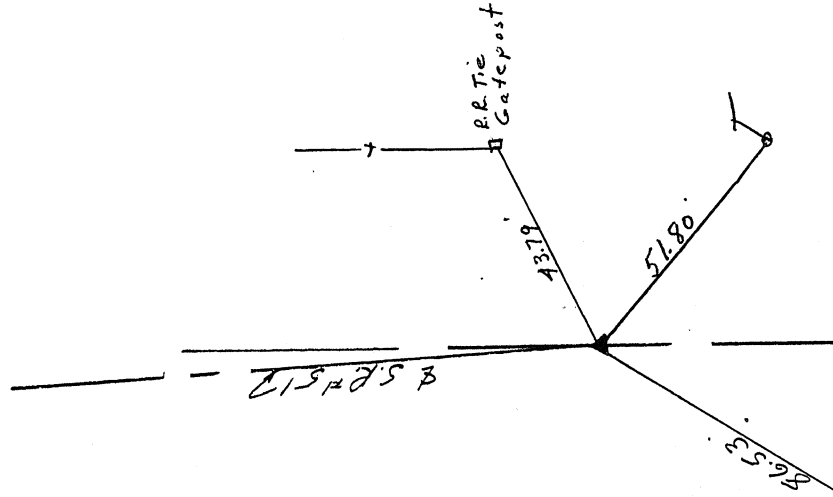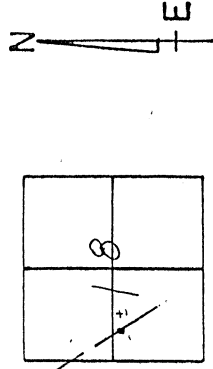


P.I. A = 00°44'00" Lt.
P.K.'s washer at top
tail's shiner below surface

O.D.O.T. DISTRICT 2 SURVEY OFFICE


PERSONNEL _____ REFERENCE NO. 8 SHEET 1 OF _____

NOTES Cronin
 H.C. _____
 R.C. _____
 DATE 9/22/57
 WEATHER Rain
 TEMP. 60°
 ROUTE 51
 COUNTY Ottawa
 TOWNSHIP Harris
 SECTION 13

T 6 N R 14 E

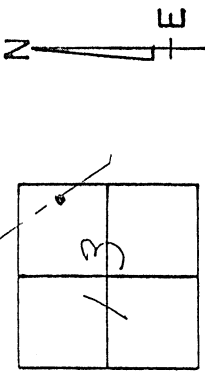

TYPE MONUMENT _____
 ON SURFACE - BELOW _____
 LEFT - & PAW'T. - RIGHT _____
 TO _____ EDGE PAVEMENT _____
 S.L.M. 105+40.08

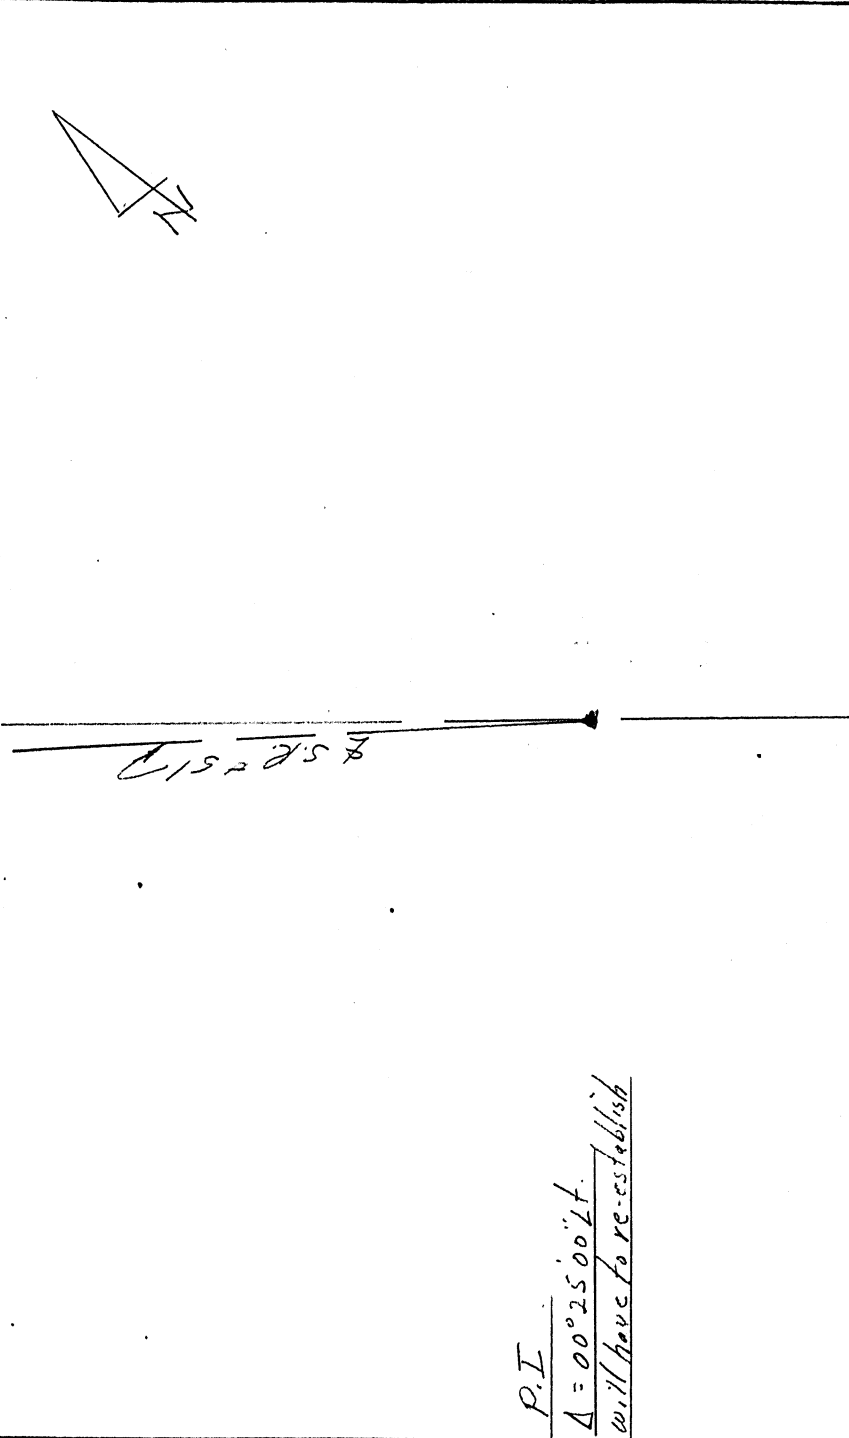

O.D.O.T. DISTRICT 2 SURVEY OFFICE

PERSONNEL _____ REFERENCE NO. 10 SHEET 9 OF _____

NOTES Cronin

H.C. Ripple

R.C. Barbour

Geyman

ROUTE 51

COUNTY Ottawa

TOWNSHIP Clay

SECTION 12

T 6 N R 13 E



TYPE MONUMENT P.K. washer

ON SURFACE - BELOW on surface

LEFT- & PAV'T. - RIGHT & Pavt.

TO EDGE PAVEMENT

S.L.M. 138+68.60

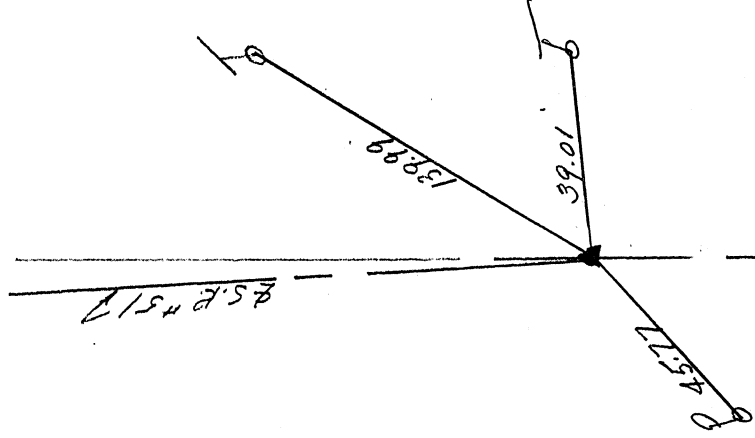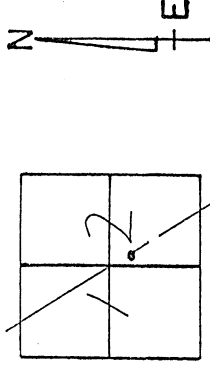

P.F. A = 00° 53' 00" Lt.
P.K. at top small RR spike
below surface

O.D.O.T. DISTRICT 2 SURVEY OFFICE

PERSONNEL _____ REFERENCE NO. 11 SHEET 10 OF _____

NOTES Cronin ROUTE 51

H.C. Ripple COUNTY Ottawa

R.C. Barbour TOWNSHIP C/24

Geyman SECTION 121

DATE 9/24/87 T 6 N R 13 E

WEATHER overcast

TEMP. 57°



TYPE MONUMENT P.K. washer

ON SURFACE - BELOW on surface

LEFT-CL PAV'T. - RIGHT R. Pav't

TO EDGE PAVEMENT

S.L.M. 15/470.04

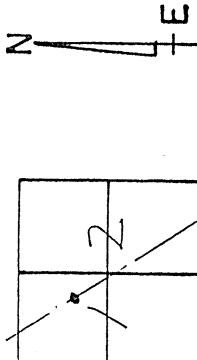
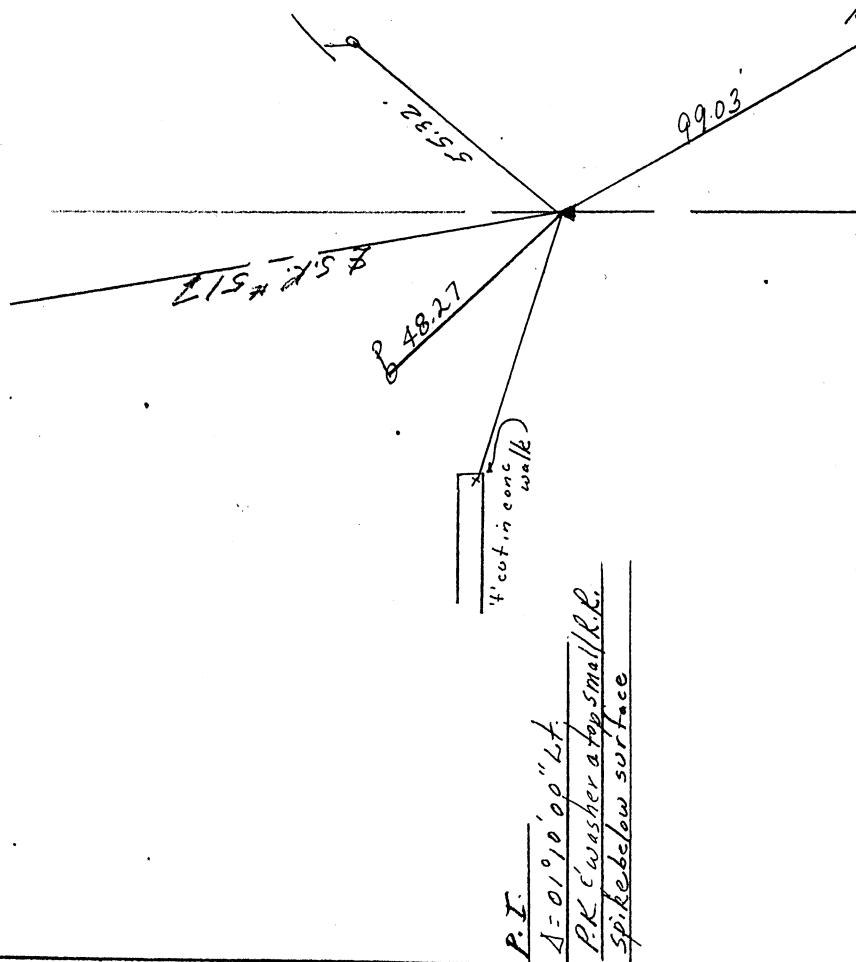



O.D.O.I. DISTRICT 2 SURVEY OFFICE

PERSONNEL _____ REFERENCE NO. 12 SHEET 11 OF _____

NOTES Cronin ROUTE 51
H.C. Ripple COUNTY Ottawa
R.C. Barbour TOWNSHIP Clay
Geyman SECTION 12
DATE 9/24/87 T 6 N R 13 E
WEATHER sunny
TEMP. 62°

TYPE MONUMENT P. Kewasher
ON SURFACE - BELOW on surface
LEFT- & PAV'T. - RIGHT & Pavmt.
TO EDGE PAVEMENT
S.L.M. 161+69.85

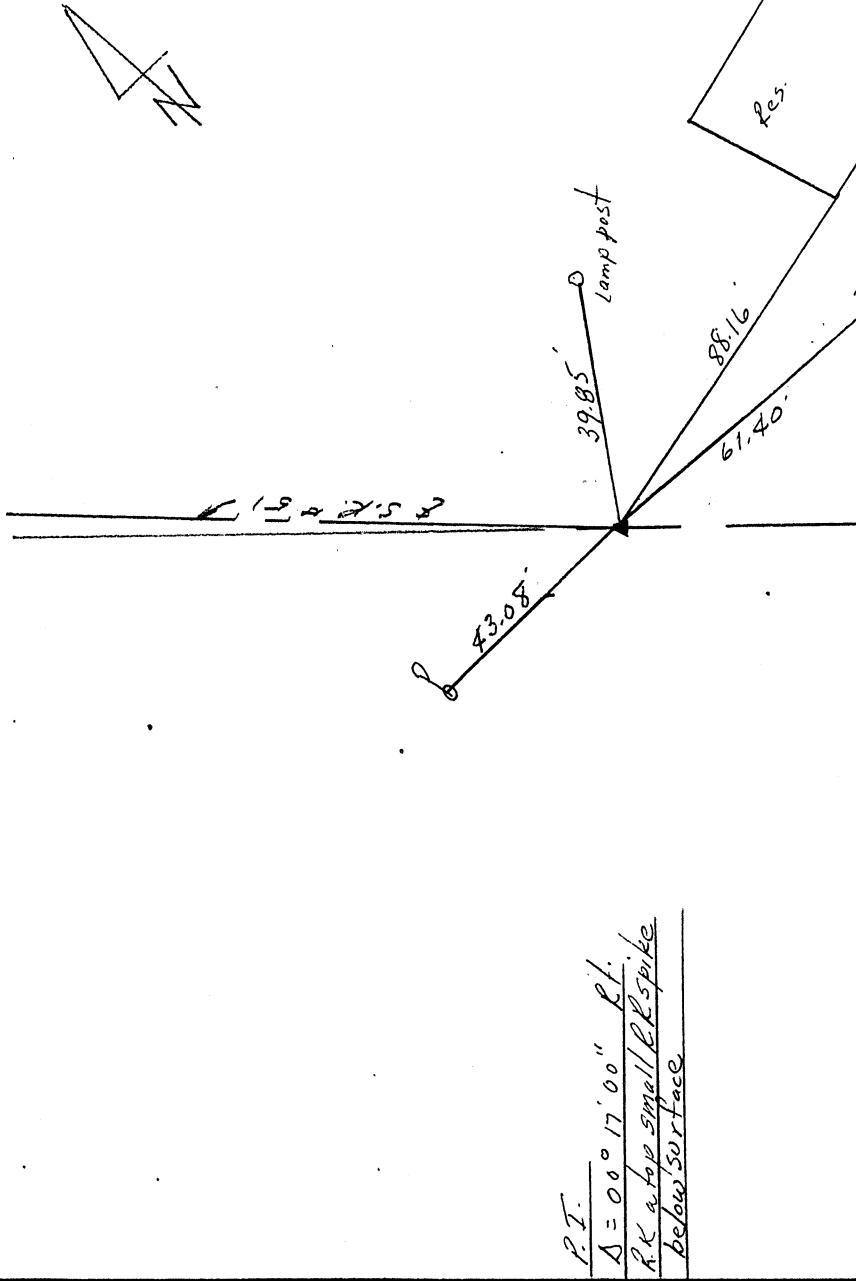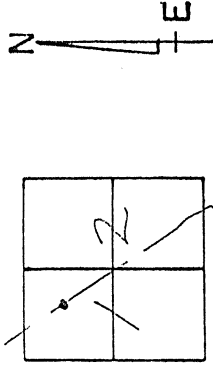

O.D.O.T. DISTRICT 2 SURVEY OFFICE

PERSONNEL _____ REFERENCE NO. 13 SHEET 12 OF _____

NOTES Cronin ROUTE 51

H.C. Ripple COUNTY Ottawa

R.C. Barbour TOWNSHIP Clay

Geyman SECTION 12

DATE 9/24/87 T 6 N R 13 E

WEATHER sunny

TEMP. 66°



TYPE MONUMENT P.K. washer

ON SURFACE - BELOW on surface

LEFT- & PAW'T. - RIGHT & Pavt.

TO EDGE PAVEMENT

S.L.M. 1714 57.77

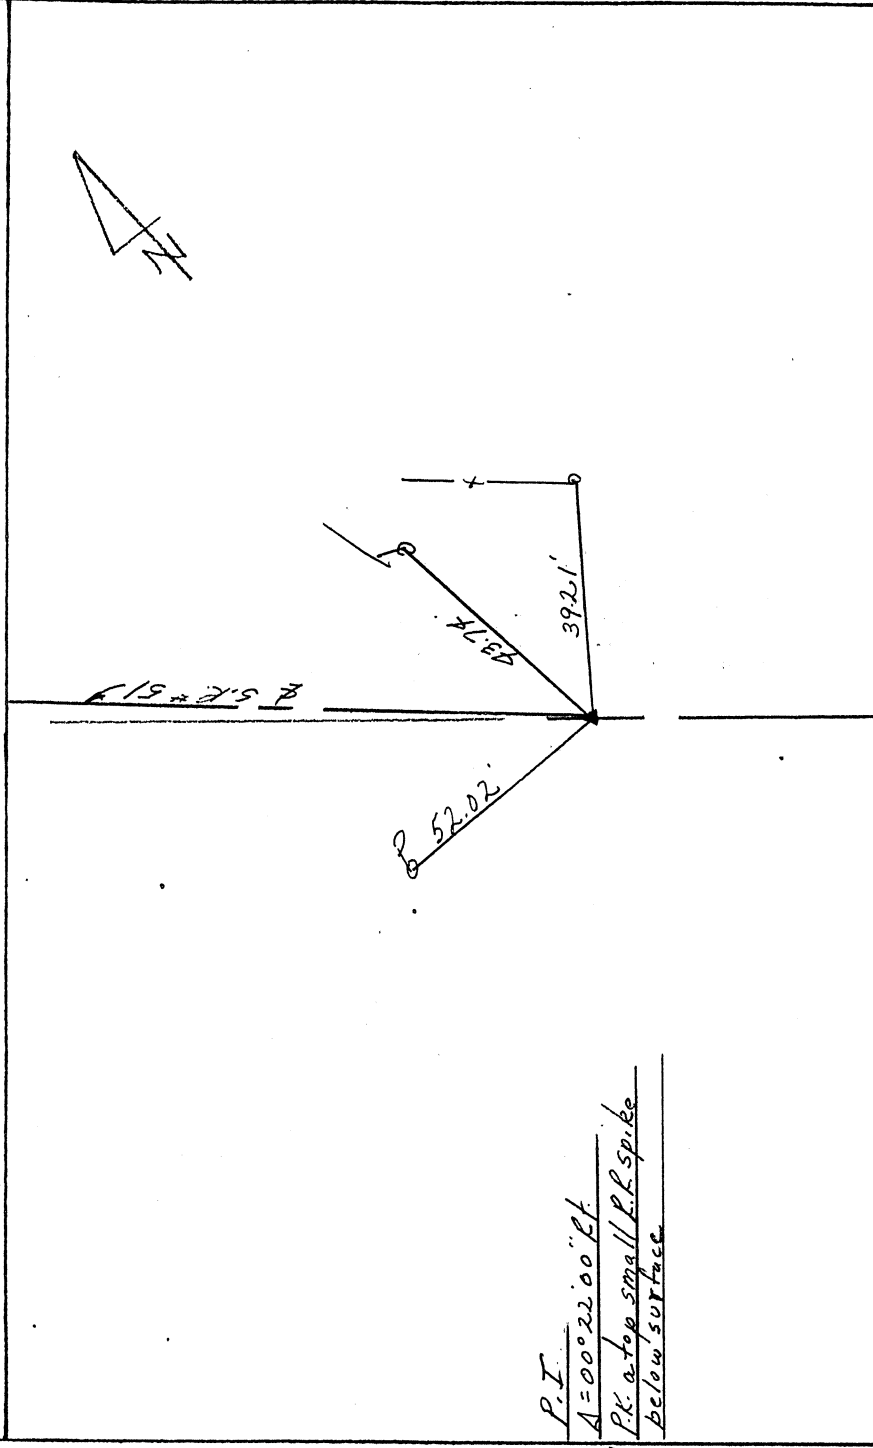
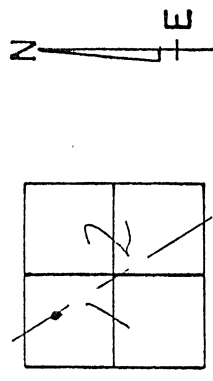


O.D.O.T. DISTRICT 2 SURVEY OFFICE

PERSONNEL _____ REFERENCE NO. 14 SHEET 13 OF _____

NOTES Cronin ROUTE 51
H.C. Ripple COUNTY Ottawa
R.C. Barbour TOWNSHIP Clay
Geyman SECTION 12
DATE 9/24/87 T6 N R 13 E
WEATHER sunny
TEMP. 66°

TYPE MONUMENT P.K. washer
ON SURFACE - BELOW on surface
LEFT- & PAW'T. - RIGHT & Pav.
TO EDGE PAVEMENT
S.L.M. 182 + 62.06

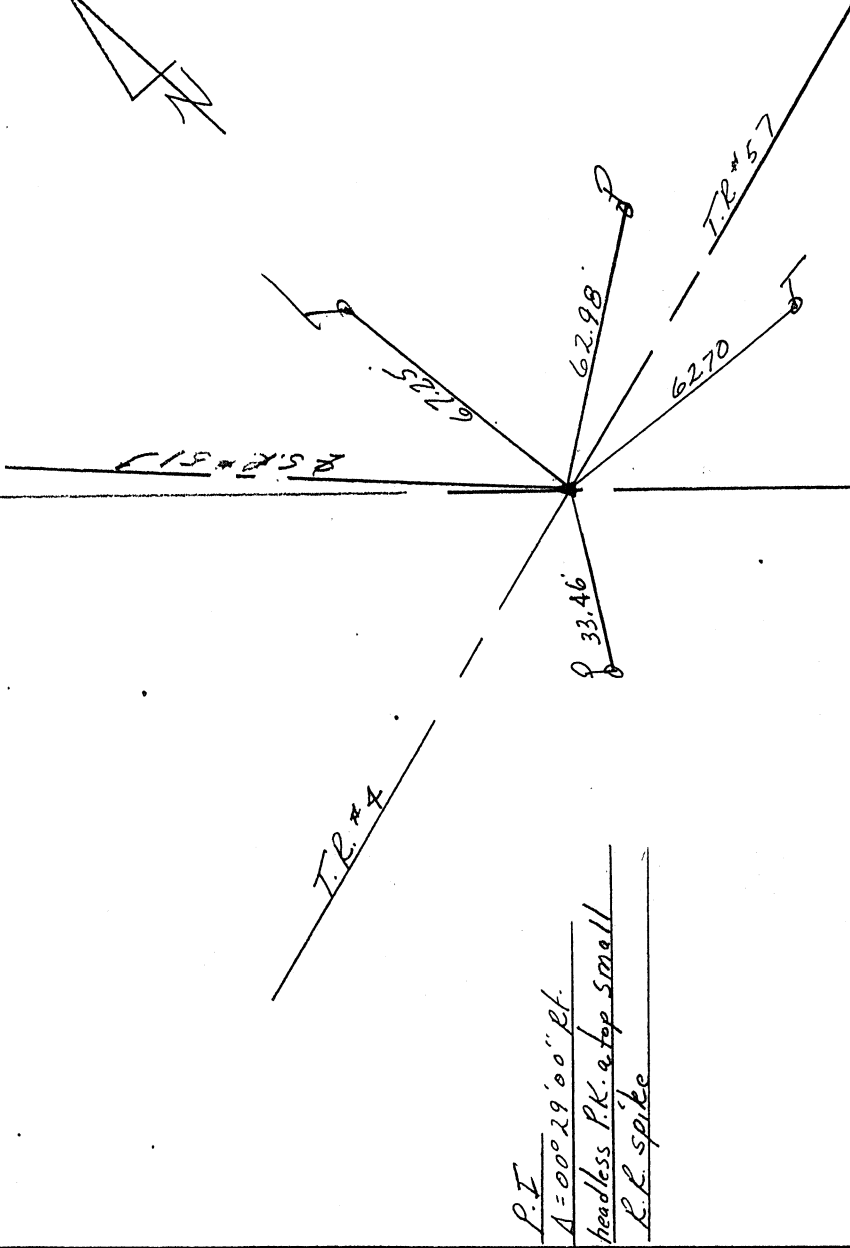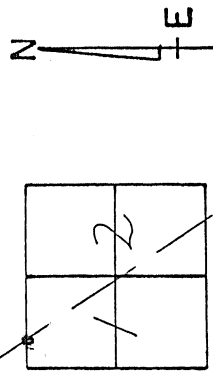

P.I. A=00°29'00" left
headless P.K. at top small
R.R. spike



O.D.O.T. DISTRICT 2 SURVEY OFFICE

PERSONNEL _____ REFERENCE NO. 15 SHEET 14 OF _____

NOTES Cronin
H.C. Lippie
R.G. Barbour
Geyman

DATE 9/24/87 ROUTE 51
WEATHER overcast COUNTY Ottawa
TEMP. 64° TOWNSHIP Clay
SECTION 2

TYPE MONUMENT P.K. washer
ON SURFACE - BELOW on surface
LEFT-CL PAV'T. - RIGHT & Pavt.
TO EDGE PAVEMENT
S.L.M. 1994 42.70

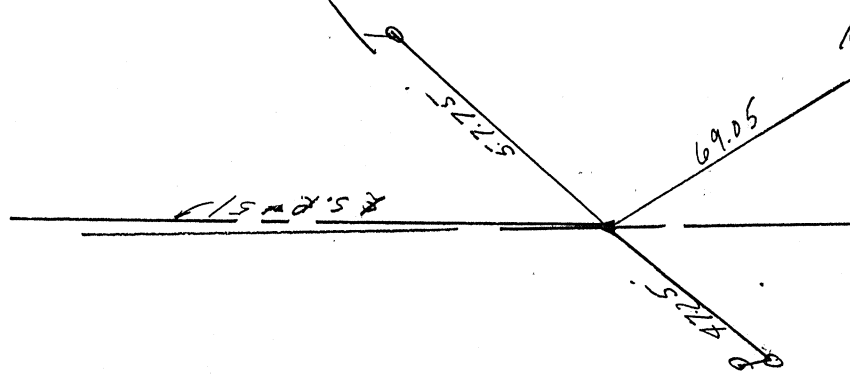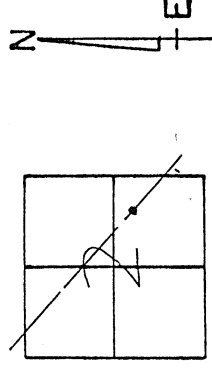

P.I. A=00°07'00" Pt.
P.K. washer at top P.K.
below surface

O.D.O.I. DISTRICT 2 SURVEY OFFICE

PERSONNEL _____ REFERENCE NO. 16 SHEET 15 OF _____

NOTES Cronin DATE 9/24/87 ROUTE 51

H.C. Pippit COUNTY Ottawa

R.C. Barbour TOWNSHIP Chap

Gezman SECTION 21

T 6 N R 13 E



TYPE MONUMENT Iron Rod

ON SURFACE - BELOW on surface

LEFT-¢ PAV'T. - RIGHT 21 ft. & Post.

TO EDGE PAVEMENT

S.L.M. 207+43.83

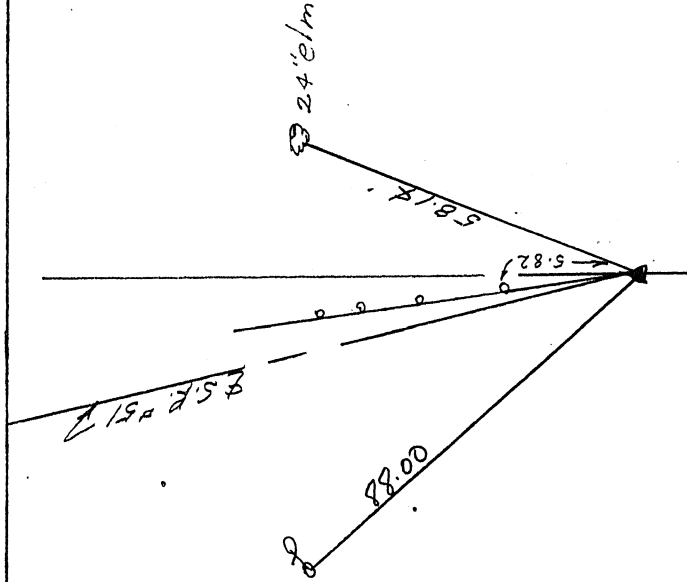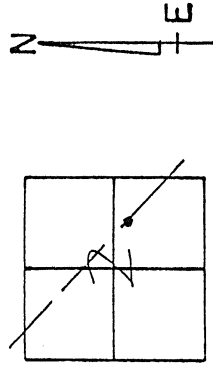

P.I.
Δ = 20° 36' 00" Lt.

O.D.O.T. DISTRICT 2 SURVEY OFFICE

PERSONNEL _____ REFERENCE NO. 17 SHEET 16 OF _____

NOTES Cronin ROUTE 51

H.C. Ripple COUNTY Ottawa

R.C. Barbour TOWNSHIP Clay

Geyman SECTION 21

T 6 N R 13 E



TYPE MONUMENT P.K. washer

ON SURFACE - BELOW on surface

LEFT- & PAV'T. - RIGHT R Pav't.

TO EDGE PAVEMENT

S.L.M. 217 + 1991

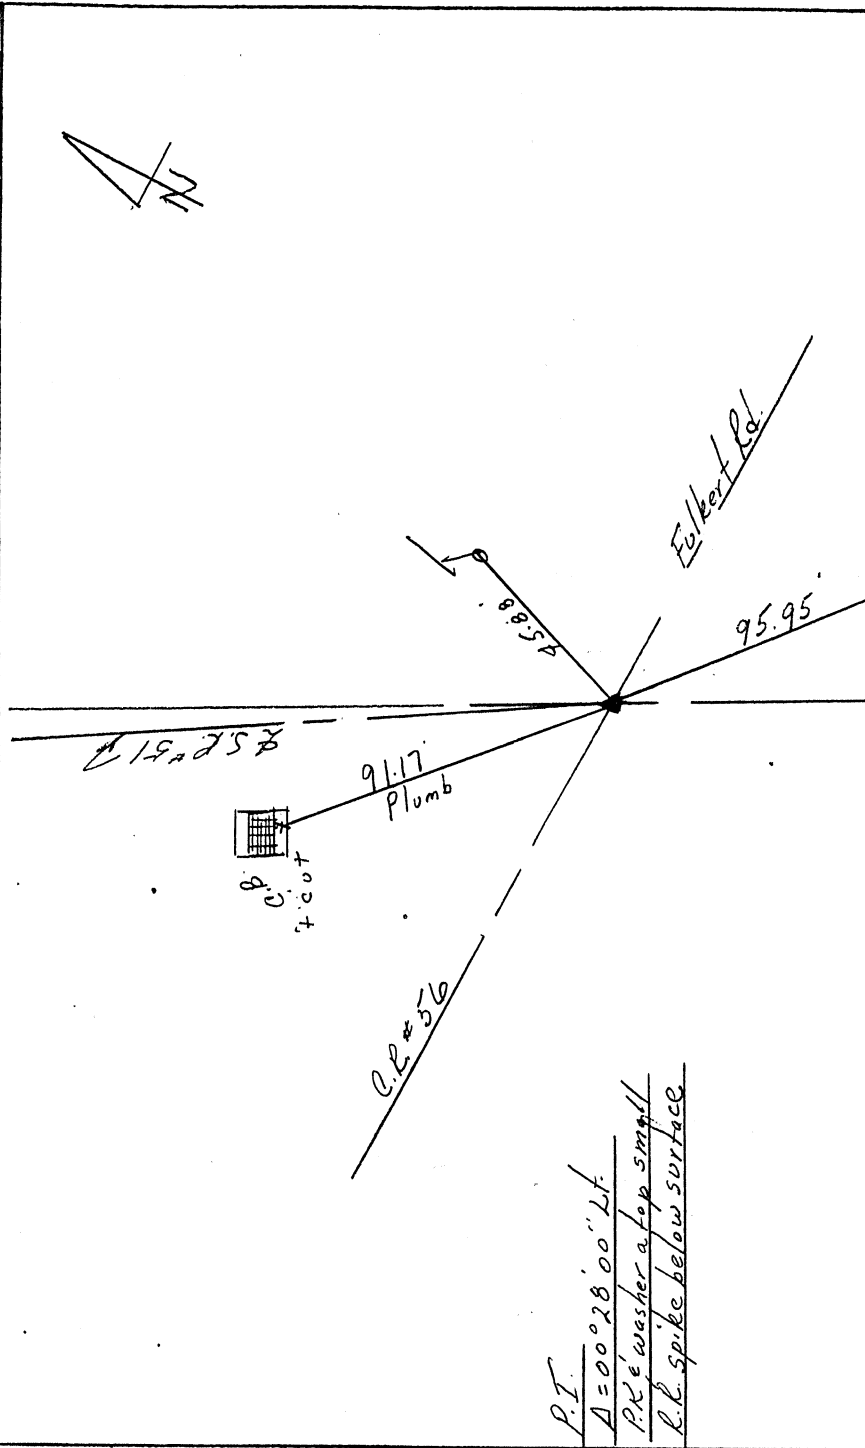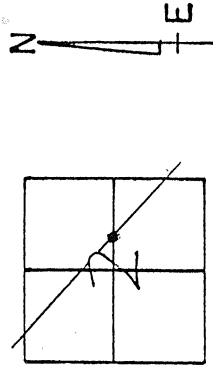

O.D.O.T. DISTRICT 2 SURVEY OFFICE

PERSONNEL _____ REFERENCE NO. 18 SHEET 17 OF _____

NOTES Crain ROUTE 51

H.C. Rippke COUNTY Ottawa

R.C. Barbour TOWNSHIP Clay

Geyman SECTION 2

DATE 9/24/87 T 6 N R 13 E

WEATHER overcast

TEMP. 66°



TYPE MONUMENT P.K. & washer

ON SURFACE - BELOW on surface

LEFT- & PAW'T. - RIGHT & Pavt.

TO EDGE PAVEMENT

S.L.M. 224 + 69.80

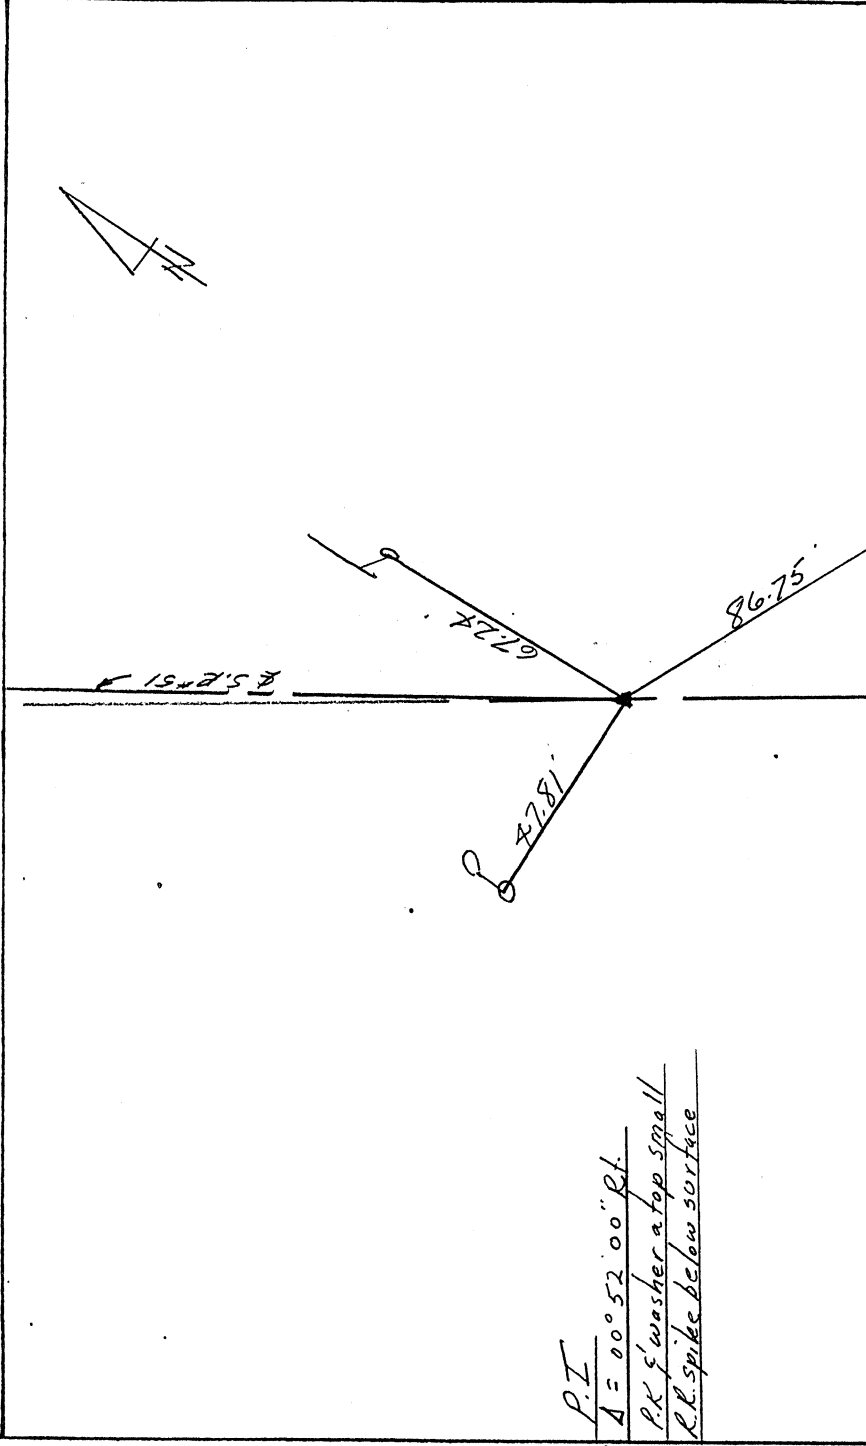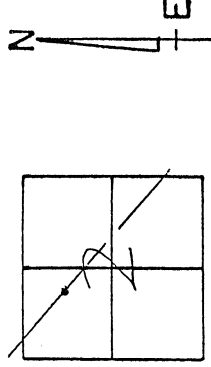

O.D.O.T. DISTRICT 2 SURVEY OFFICE

PERSONNEL _____ REFERENCE NO. 19 SHEET 18 OF _____

NOTES Cronin ROUTE 51

H.C. Ripple COUNTY Ottawa

R.C. Barbour TOWNSHIP Clay

Geyman SECTION 2

DATE 9/24/87 T 6 N R 13 E

WEATHER overcast

TEMP. 6.6°


TYPE MONUMENT P.R. washer

ON SURFACE - BELOW on surface

LEFT - & PAV'T. - RIGHT & Pav't.

TO EDGE PAVEMENT


S.L.M. 232+20.13

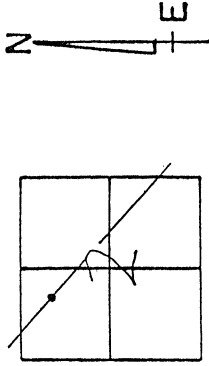

P.T. A=00°30'00" Rt.

P.R. at top small P.R. spike

below surface

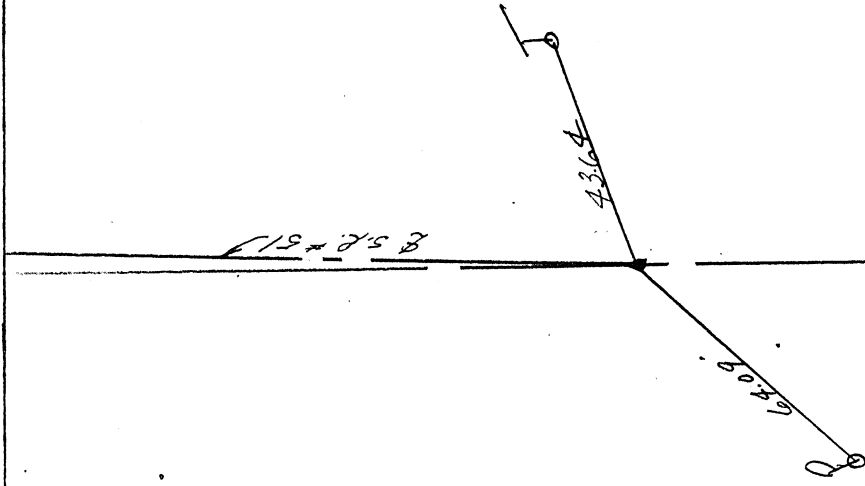

O.D.O.I. DISTRICT 2 SURVEY OFFICE

PERSONNEL _____ REFERENCE NO. 20 SHEET 19 OF _____

NOTES Cronin ROUTE 51

H.C. Lippke DATE 9/24/87 COUNTY Ottawa

R.C. Barbour WEATHER overcast TOWNSHIP Clay

Coyman TEMP. 66° SECTION 2

T 6 N R 13 E



TYPE MONUMENT P.K.

ON SURFACE - BELOW below surface

LEFT- & PAW'T. - RIGHT 45.8 Pavt.

TO EDGE PAVEMENT

S.L.M. 2434 69.95

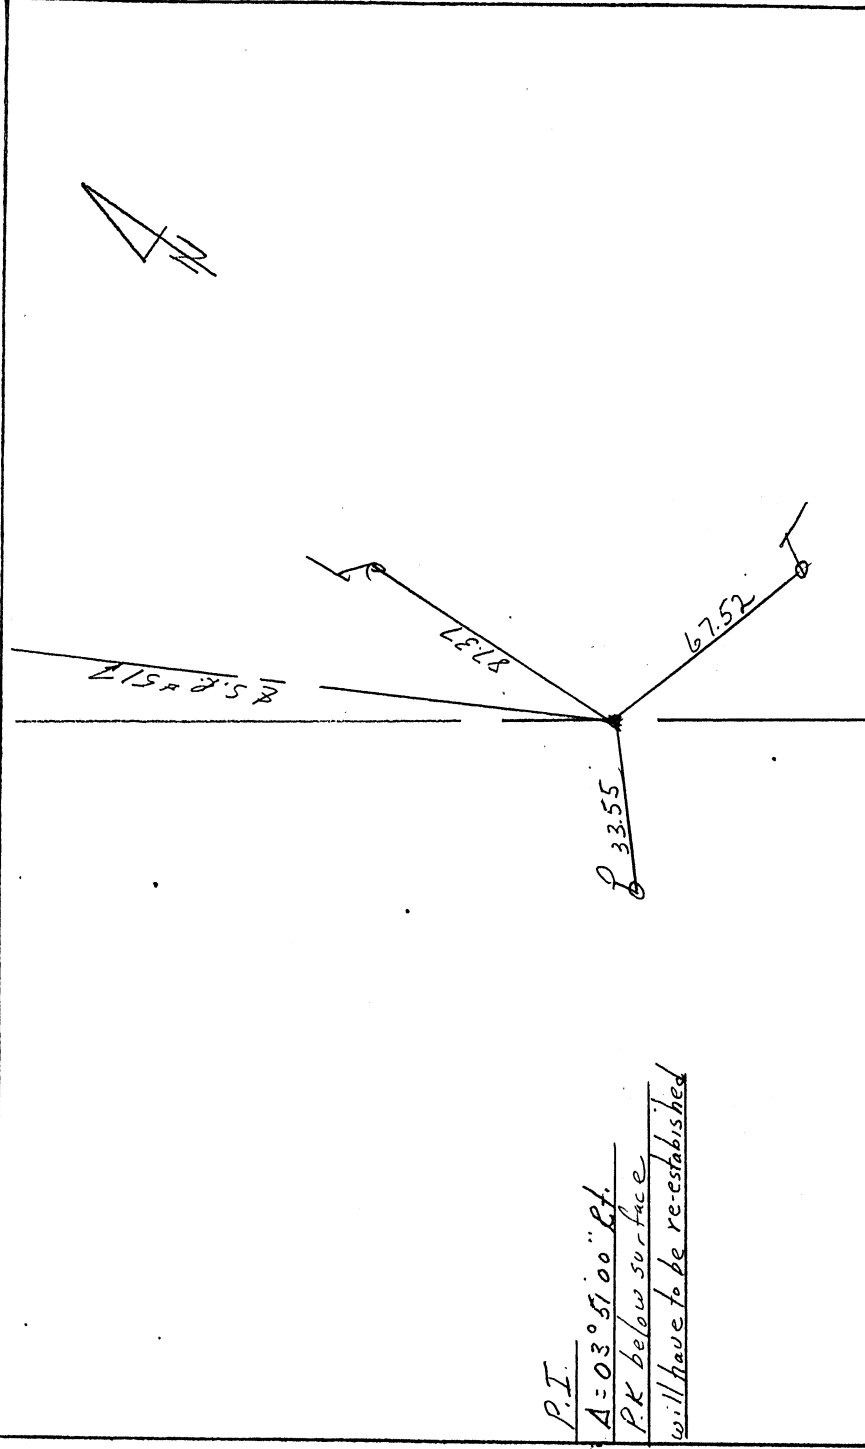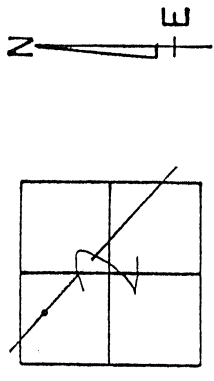

P.I.
 $A = 03^{\circ} 51' 00''$ Rht.
 P.K. below surface
 will have to be re-established

O.D.O.T. DISTRICT 2 SURVEY OFFICE

PERSONNEL _____ REFERENCE NO. 21 SHEET 20 OF _____

NOTES Cronin ROUTE 51

H.C. Ripple COUNTY Ottawa

R.C. Barbour TOWNSHIP Clay

Coyman SECTION 2

DATE 9/24/87 T 6 N R 13 E

WEATHER overcast

TEMP. 66°



TYPE MONUMENT P.K. washer

ON SURFACE - BELOW on surface

LEFT- & PAV'T. - RIGHT & Pavt.

TO EDGE PAVEMENT

S.L.M. 247469.98'

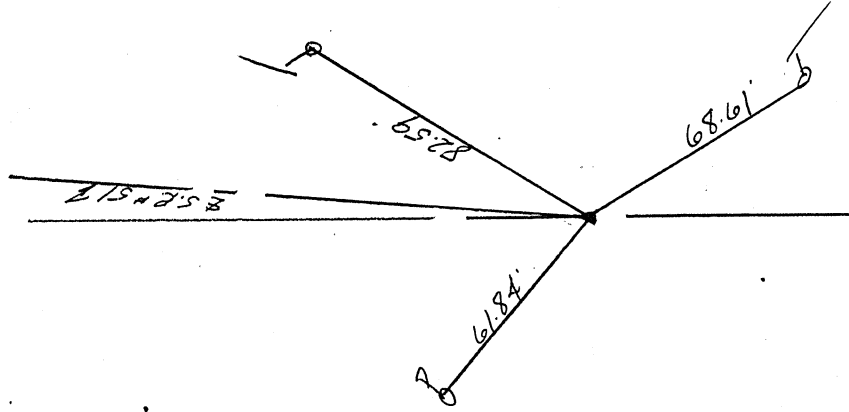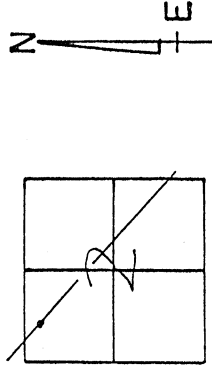

P.T. A=02°30'00" Rt.

P.K. washer at top of footing

rail below surface

O.D.O.T. DISTRICT 2 SURVEY OFFICE

PERSONNEL

REFERENCE NO. 22 SHEET 21 OF

NOTES

H.C. Cronin
R.C. Ripple
Barbour
Guyman

DATE 9/24/87

ROUTE 51

WEATHER overcast

COUNTY Ottawa

TEMP. 66°

TOWNSHIP Clay

SECTION 21

T 6 N R 13 E


TYPE MONUMENT P.K. washer

ON SURFACE - BELOW on surface

LEFT- ϕ PAV'T. - RIGHT ± Pavt.

TO EDGE PAVEMENT

S.L.M. 250+70.10

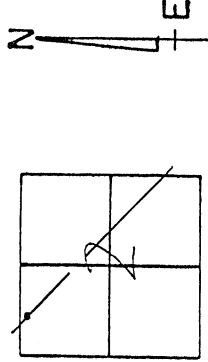


P.I.

A = 01°52.00" Rt.

P.K. at top P.K. below

surface

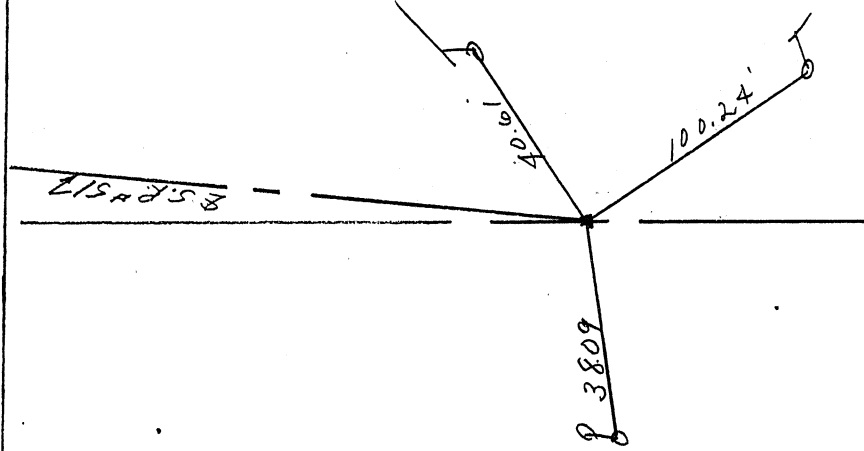

O.D.O.T. DISTRICT 2 SURVEY OFFICE

PERSONNEL _____ REFERENCE NO. 23 SHEET 22 OF _____

NOTES Cronin ROUTE 51

H.C. Ripple COUNTY Ottawa


R.C. Garbour TOWNSHIP Clay

Geyman SECTION 2

DATE 9/24/87 T.G. NR 13 E

WEATHER overcast

TEMP. 66°

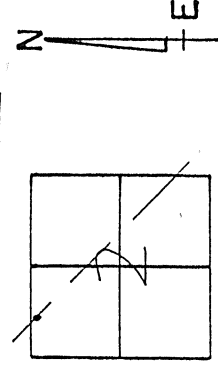


TYPE MONUMENT P.K. washer

ON SURFACE - BELOW on surface

LEFT- & PAV'T. - RIGHT & Pav't.

TO EDGE PAVEMENT

S.L.M. 25847020

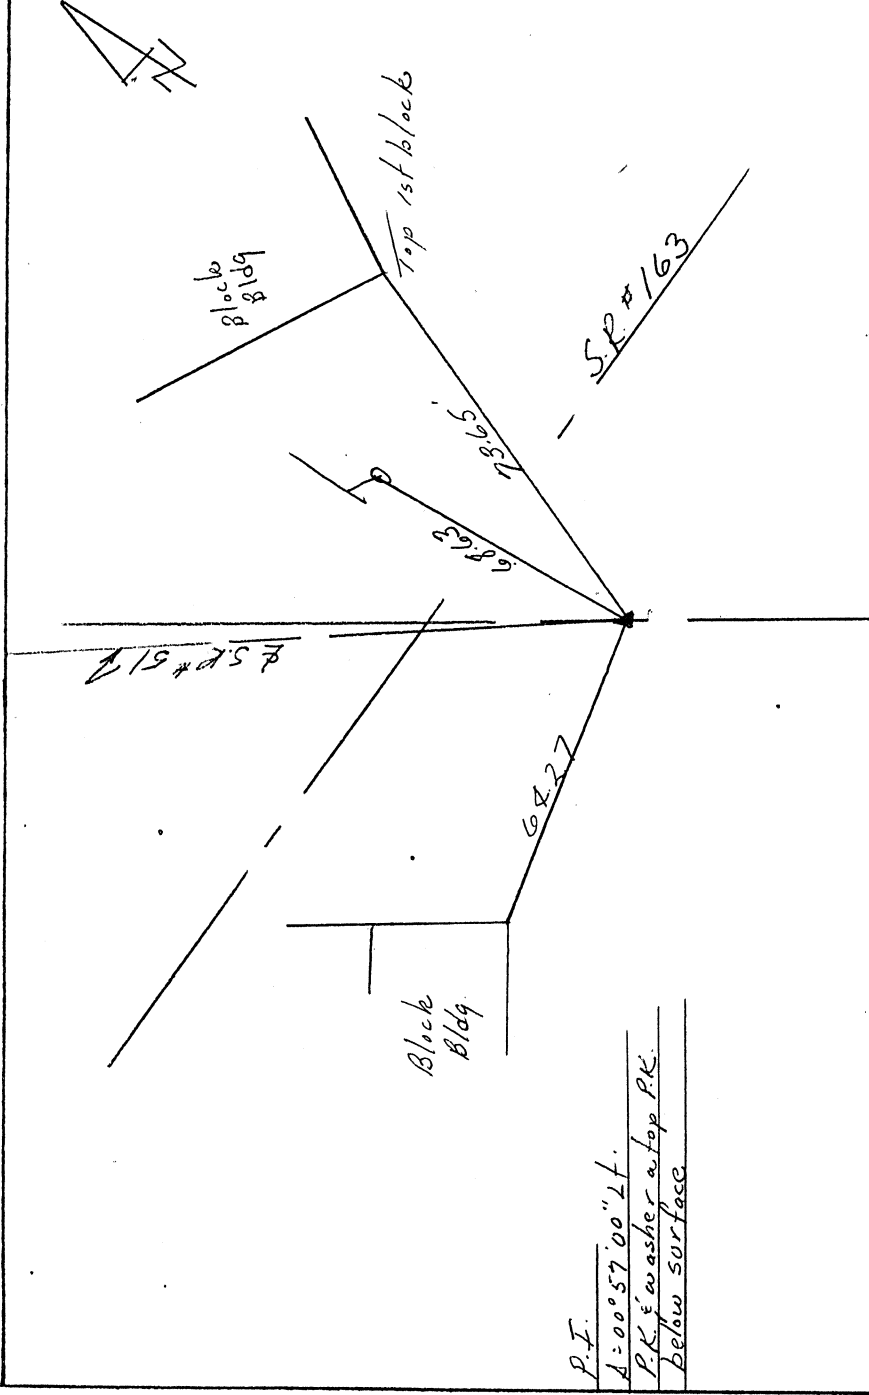

SHEET NO. 8

COUNTY OTTAWA DATE 1-11-73


WEATHER Cloudy

TEMP. 11.0

PERSONNEL TITLE PERSONNEL TITLE

S. R. 51 SEC. 2

DESCRIPTION Play Twp. LEFT CENTER LINE RIGHT JOB NO.

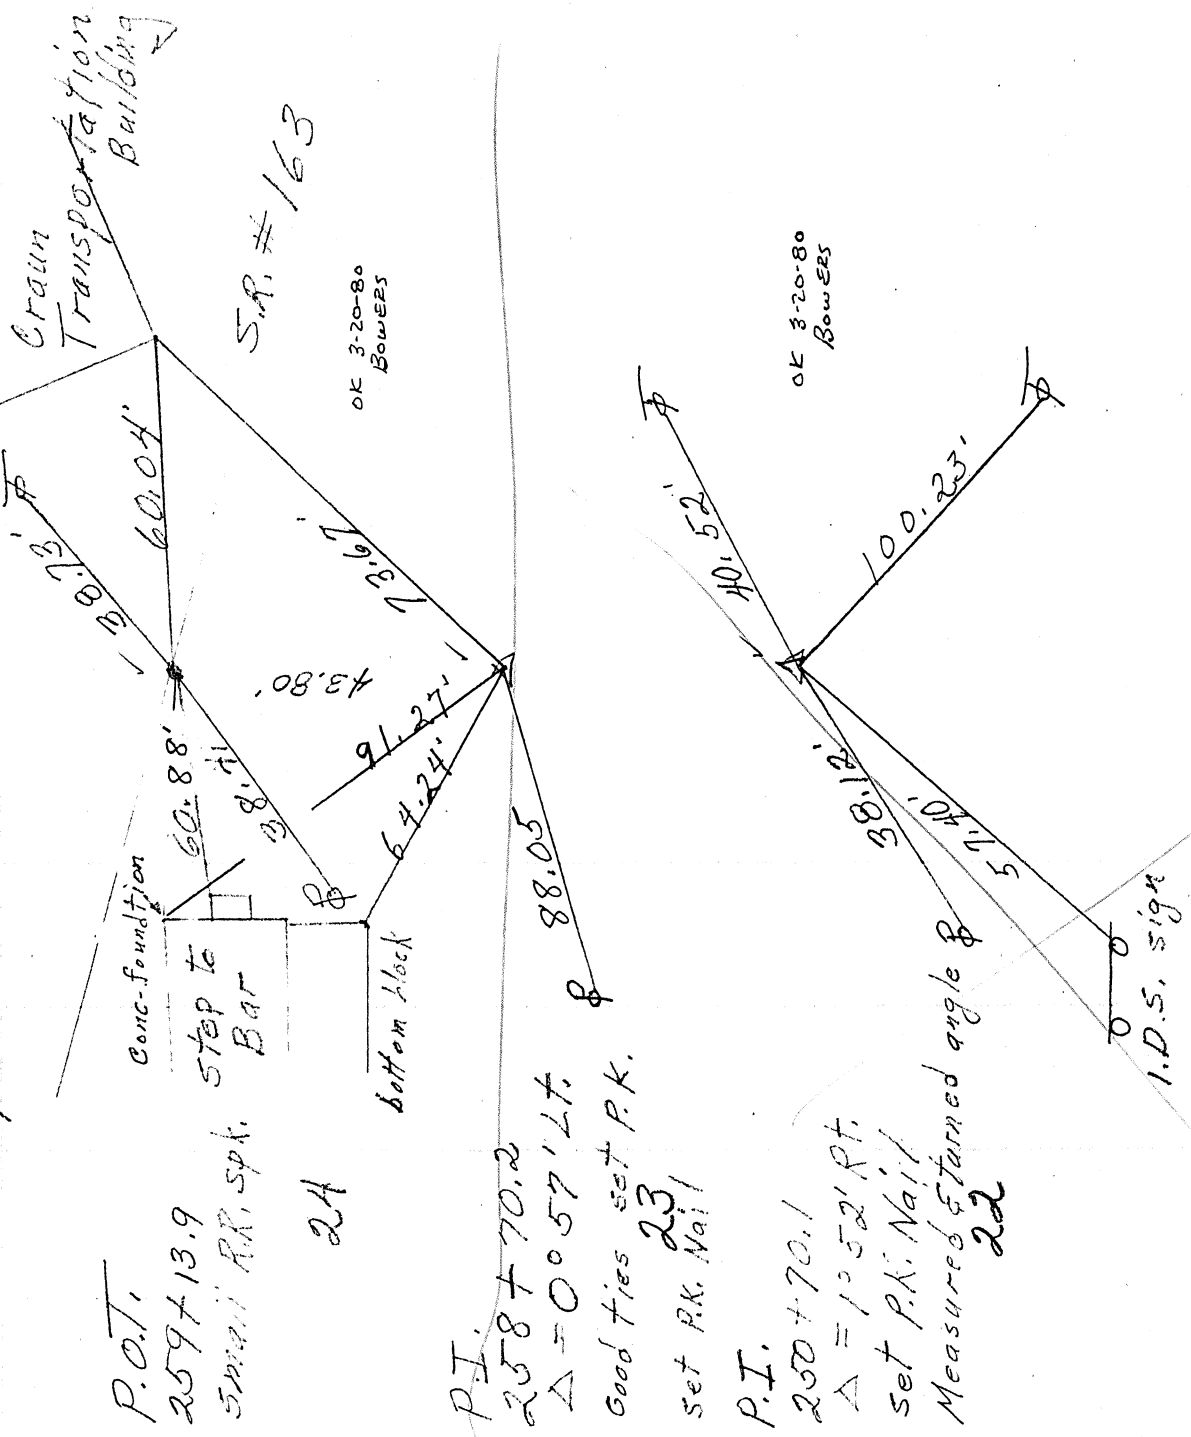

SHEET NO. 9

COUNTY Adair DATE 1-11-70


PERSONNEL TITLE PERSONNEL TITLE

S. R. 51 WEATHER Fair

SEC. 21st St TEMP. 40°

DESCRIPTION Clay Twp. JOB NO. _____

LEFT CENTER LINE RIGHT

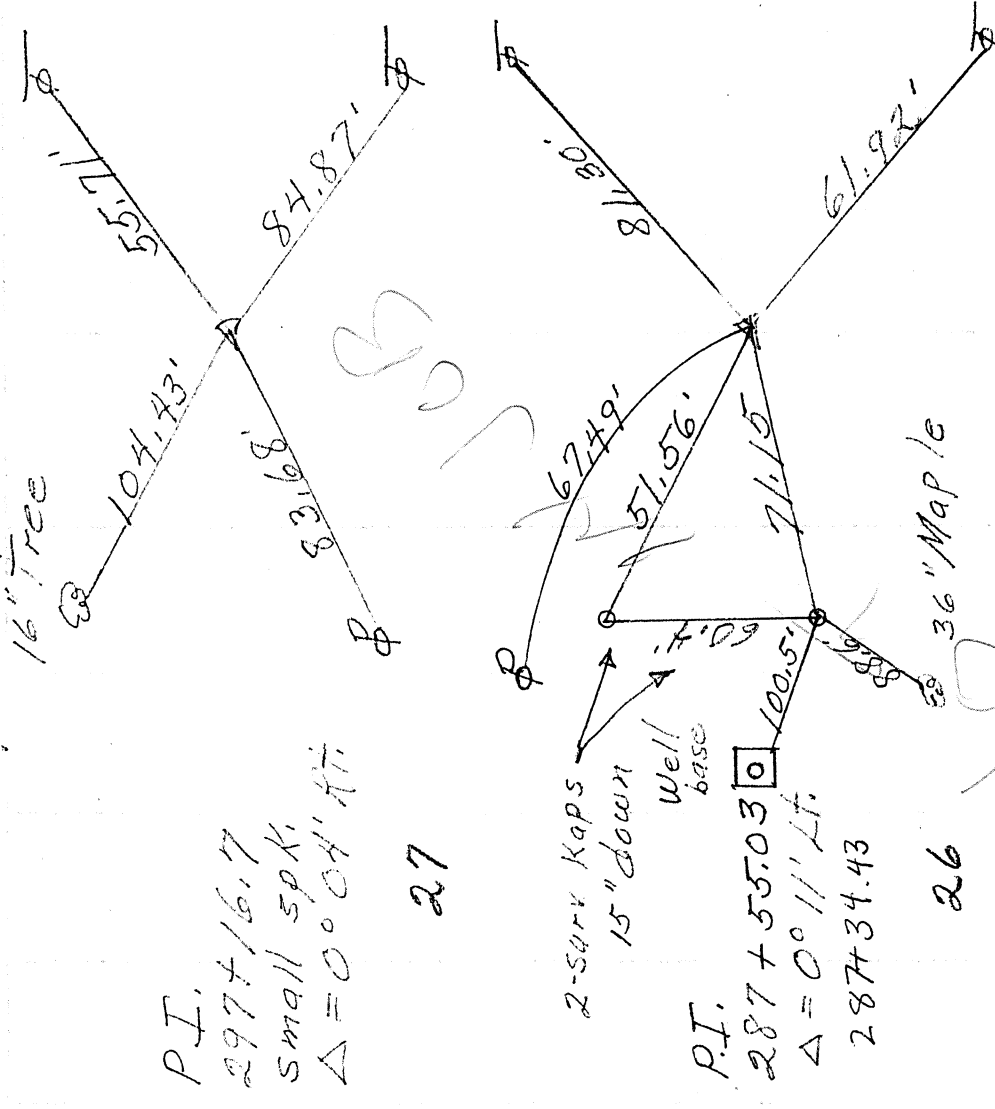

SHEET NO. 1 of 6

PERSONNEL TITLE PERSONNEL TITLE


RIPPLE BARBOUR COYMAN

COUNTY OTTAWA DATE 12/15/86 WEATHER SUNNY

S. R. 51 SEC. 28 TEMP. 34°

DESCRIPTION Clay Twp. JOB NO. _____

LEFT CENTER LINE RIGHT

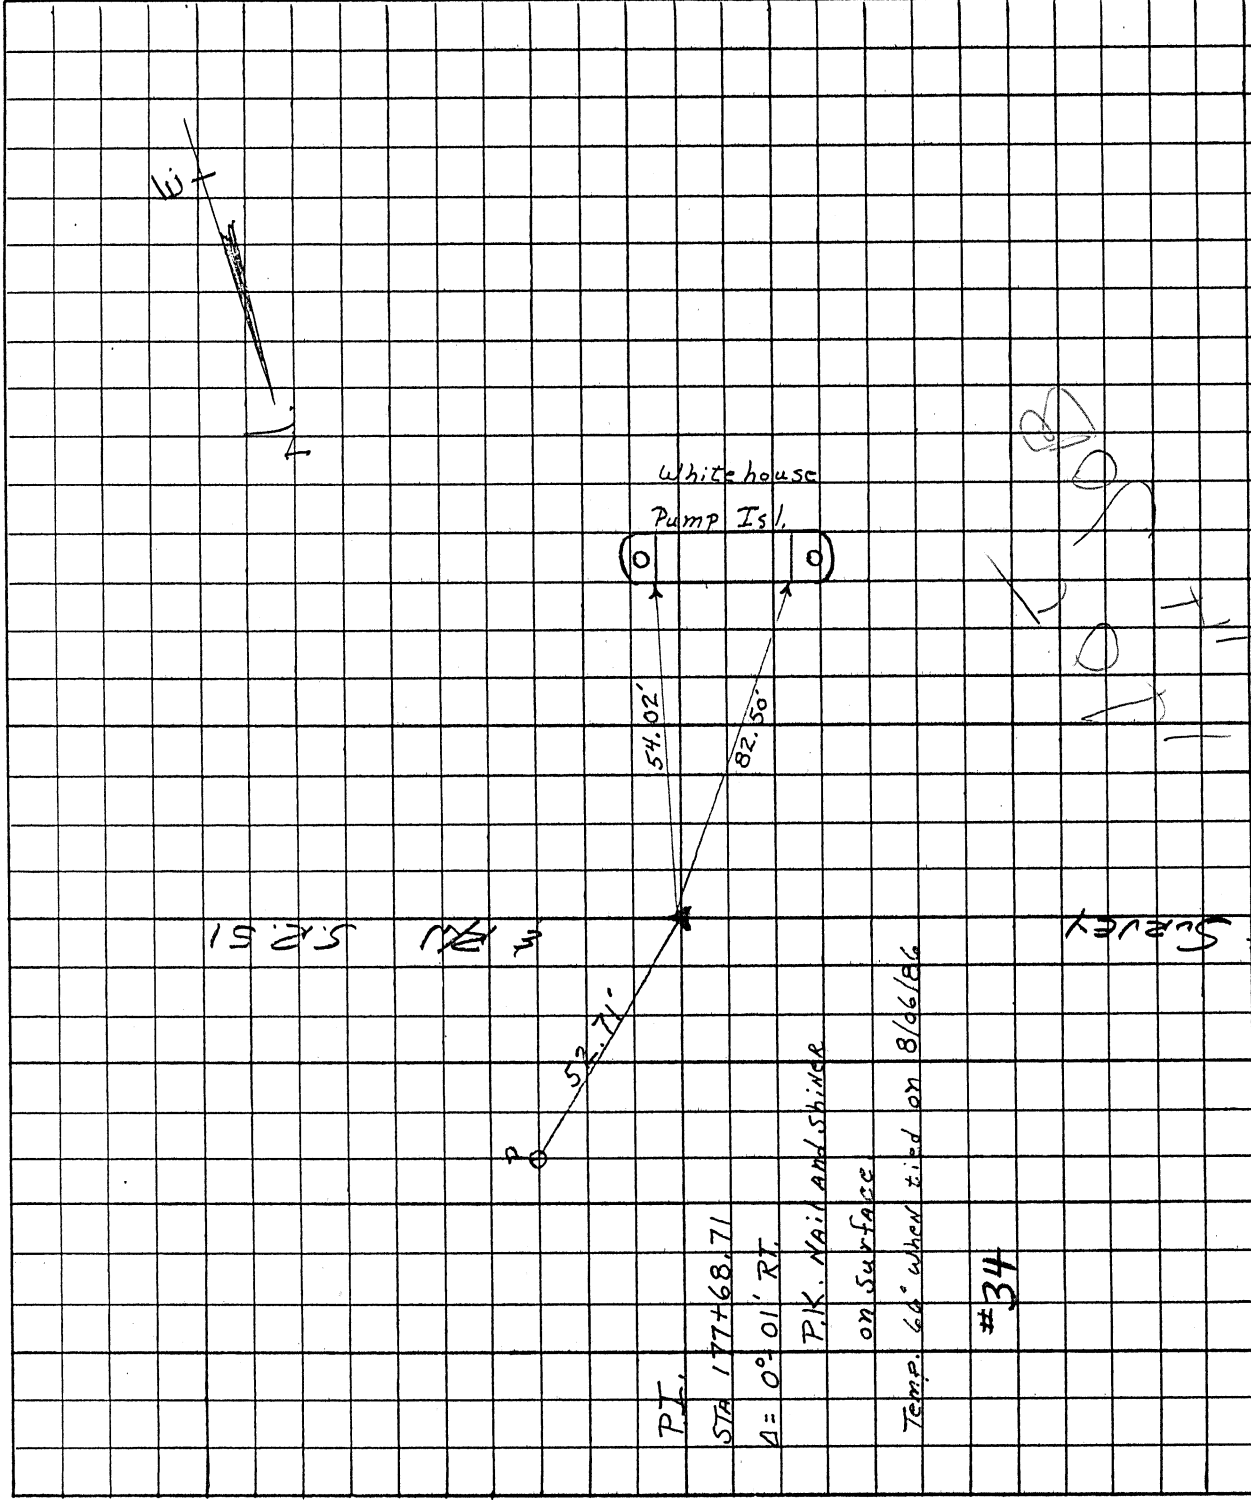


#34

SHEET NO. 2 OF 6

PERSONNEL	TITLE	PERSONNEL	TITLE
R. P. P. / P.		COUNTY	OTTAWA
Barbour		DATE	12/15/86
Geyman		S. R.	#51
		WEATHER	Sunny
		SEC.	27.28
		TEMP	34°

DESCRIPTION _____ LEFT _____ CENTER LINE _____ RIGHT _____ JOB NO. _____

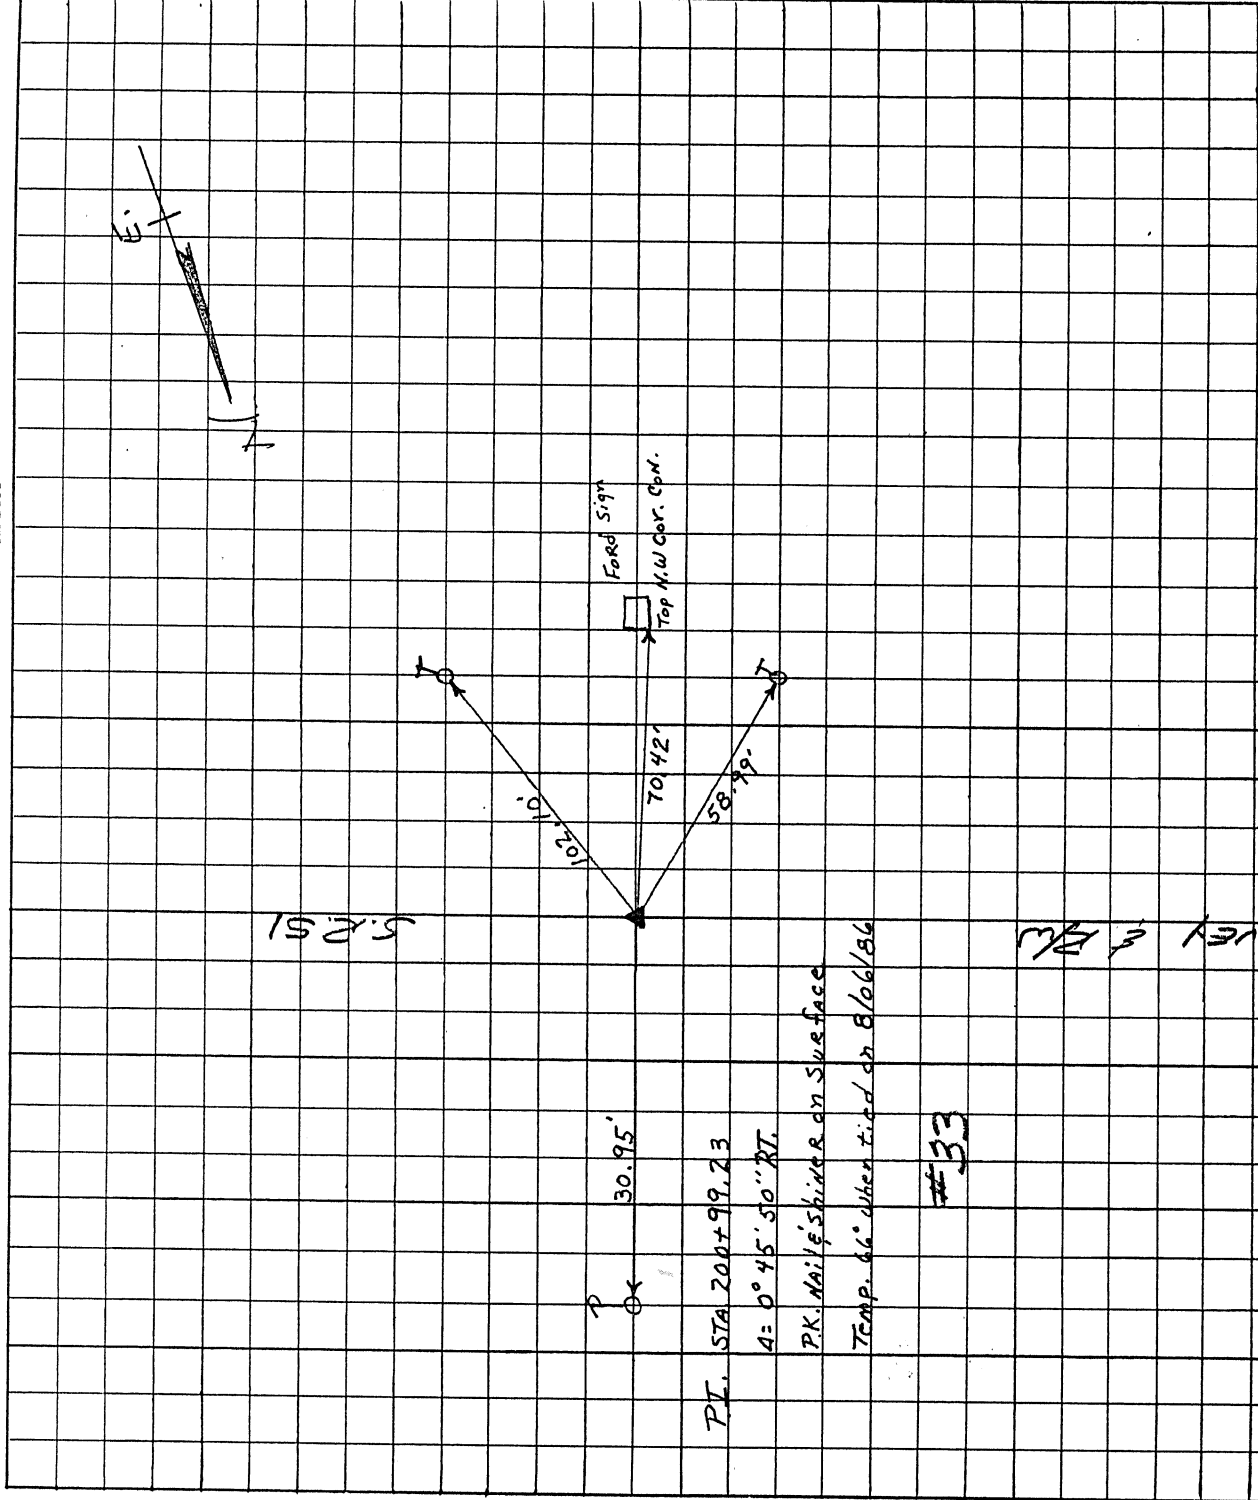

SHEET NO. 4 of 6

COUNTY OTTAWA DATE 12/15/86

PERSONNEL TITLE PERSONNEL TITLE


RIPPLE BARBOUR

GEYMAN

S. R. #51 WEATHER SUNNY

SEC. 27 34 TEMP. 34°

DESCRIPTION Clay Twp. CENTER LINE LEFT RIGHT JOB NO.

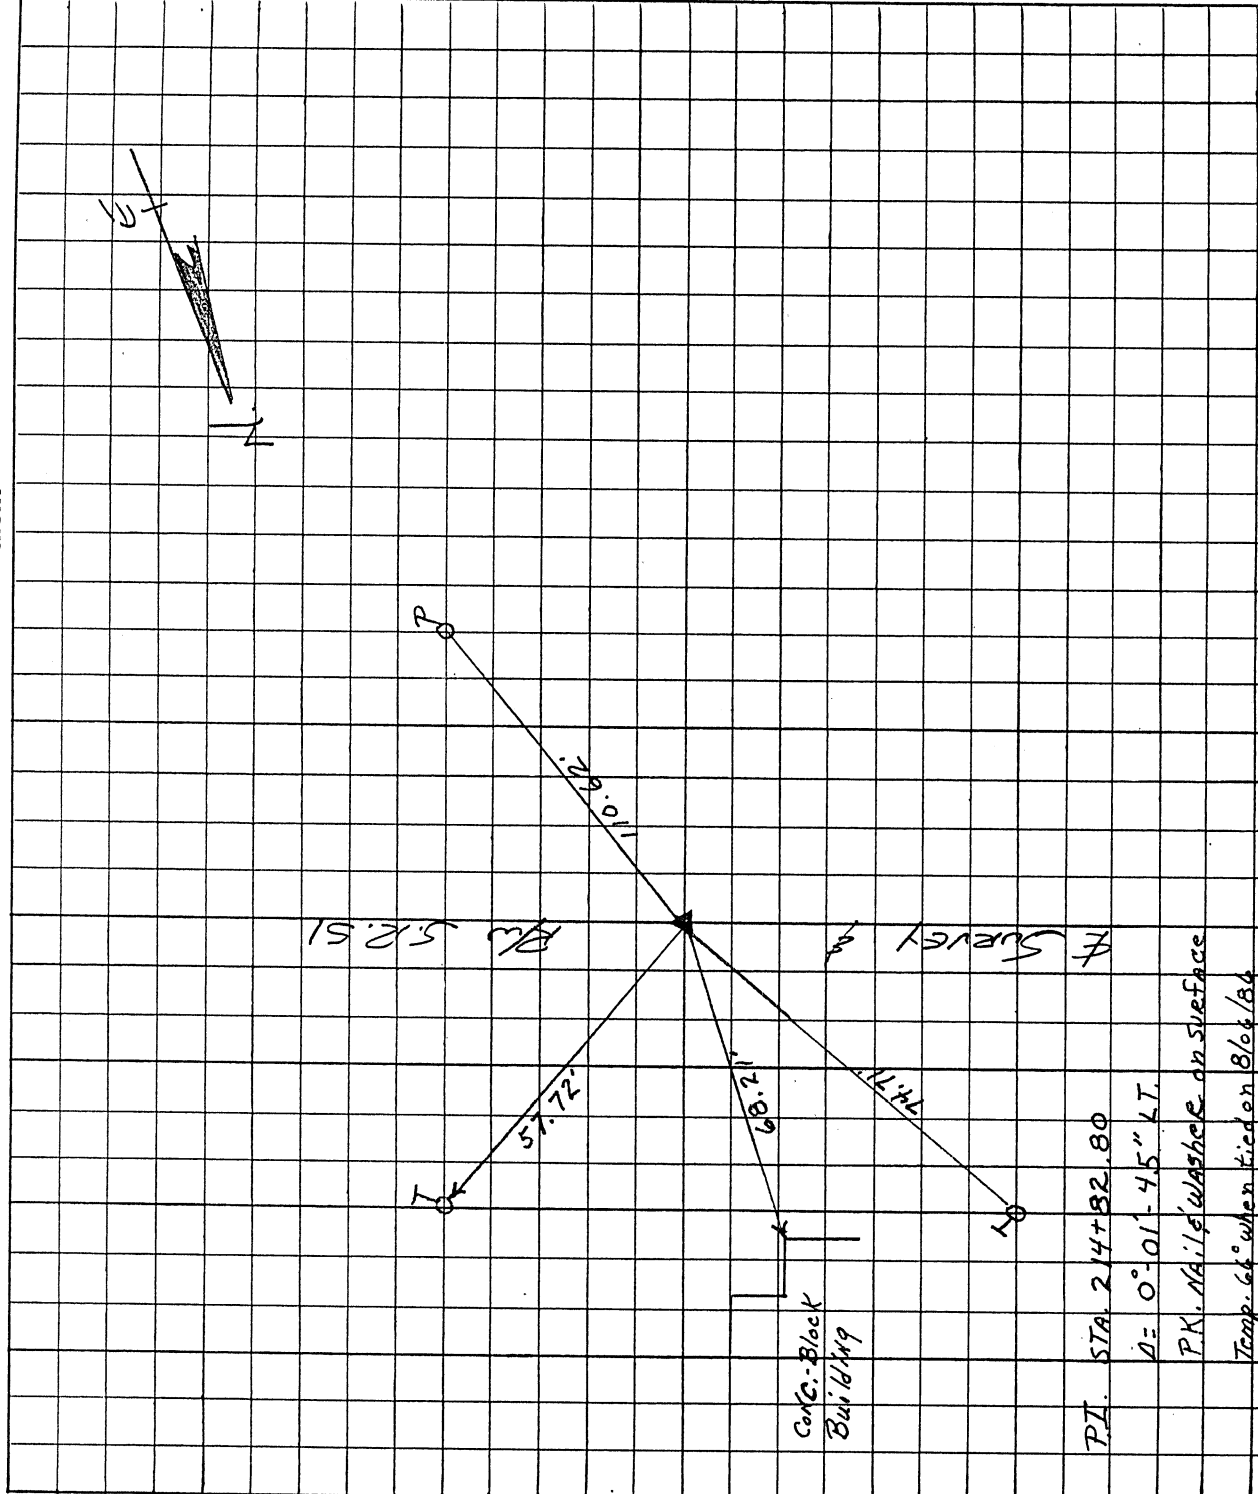

SHEET NO. 506

COUNTY OTTAWA DATE 12/15/86

PERSONNEL TITLE PERSONNEL TITLE

RIPPLE BARBOUR

GEYMAN

WEATHER SUNNY

TEMP. 34°

SEC. 34

DESCRIPTION CLAY TWP.

LEFT

CENTER LINE

RIGHT

JOB NO.

