

PERSONNEL TITLE PERSONNEL TITLE COUNTY Lucas DATE 17 June 87
Stone _____
_____ S. R. #51 WEATHER Warm
Crew _____ SEC. 11.28 TEMP. 84°
 DESCRIPTION Supplemental Data. JOB NO. 022050

① - Put joint station west of Loskey Rd. Int. = Sta. 596+01.6


Pavement X-Sections

② -

597+50	5.18 0 TC	5.63 0 EP	5.38 13	5.25 19	5.03 26	4.78 39 Crown	5.01 53	5.33 66 EP	4.95 66 TC
623+00	5.62 0 TC	6.04 0 EP	5.70 13	5.35 27 Crown	5.35 40	5.46 54 EP	7.96 54 TC		
655+00	5.98 0 TC	6.39 0 EP	6.17 13	5.96 27 Crown	5.84 40	5.58 54 EP	5.12 54 TC		
662+00	5.08 0 TC	5.50 0 EP	5.25 13	5.04 27 Crown	5.15 40	5.19 54 EP	4.74 54 TC		

Guardrail

③ -

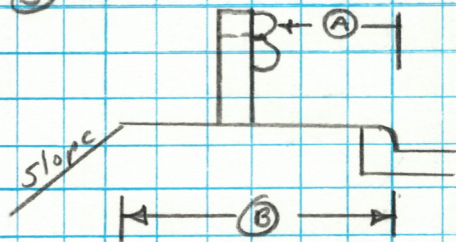

REG. STA.	END STA.	DIST (A)	DIST (B)
627+62	628+53	9.5'	12.5
643+51	644+54	9.6	13.5
648+94	650+01	10.0	10.2
Dist (A) to 648+94 = 9.0'			
Dist (A) to 650+01 = 10.6			

Light pole = Sta. 649+85 - dist Face curb to face con base = 7.5'
 size con base = 3' x 3'


④ - Exact place to put joint for end of resurfacing = Sta. 667+32.6

PERSONNEL	TITLE	PERSONNEL	TITLE	COUNTY	DATE
Stone				Lucas	25 June 87
				S. R. #51	WEATHER Sunny
Crow				SEC. Monroe St.	TEMP. 80°

DESCRIPTION

Sign Information

JOB NO. 022050

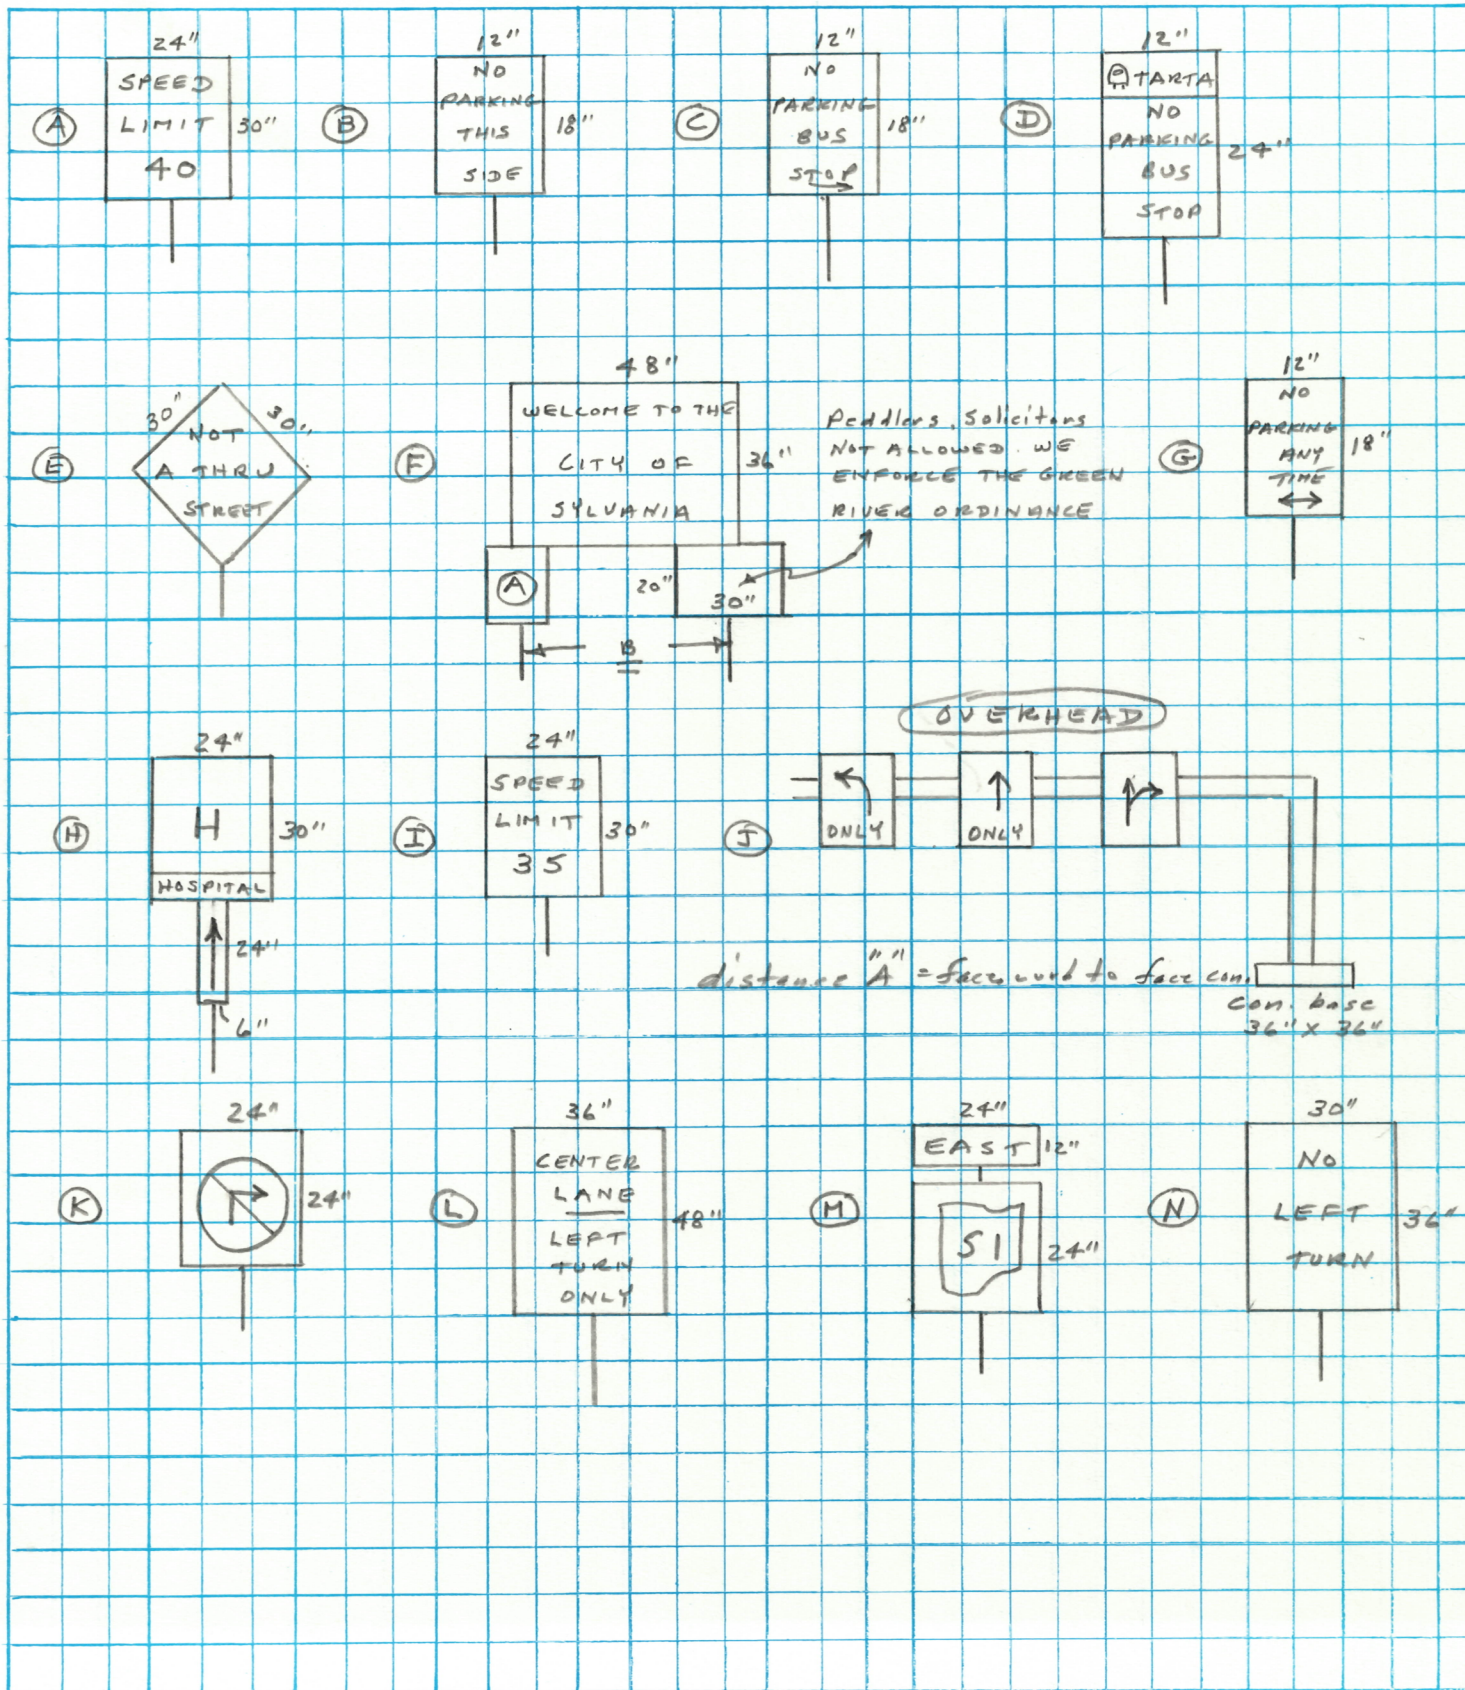

PERSONNEL TITLE PERSONNEL TITLE COUNTY Lucas DATE 25 June 87
Stone E Craw S. R. #51 WEATHER Sunny
 SEC. Monroe St. TEMP. 800

DESCRIPTION Sign Information JOB NO. 022050

STA.	SIGN	DIST		HOW IN GROUND	COND.	COND
		LEFT	RIGHT			
		A	B			
602+38	A	2.5' RT		DRIVEN IN	G	G = Good F = FAIR P = Poor
604+00	A	2.5' LT		" "	G	
604+72	C	5.5' LT		" "	Post rust sign bent	
608+01	E	5.5' LT		" "	G	
609+09	F	2.5' RT	3.0	" "	G	
617+01	D	2.5' RT		" "	G	
617+99	D	5.0' LT		" "	G	
618+43	A	2.5' RT		" "	F	
619+27	B	1.5' LT		" "	P	
622+29	G	2.0' RT		" "	F	
622+90	H	2.0' RT		" "	G	
623+85	A	2.0' LT		" "	G	
624+07	D	3.5' LT		" "	F	
624+17	D	2.5' RT		" "	F	
625+04	G	4.0' RT		" "	F	
626+43	G	3.5' RT		" "	F	
627+33	G	3.5' RT		" "	F	
629+80	G	1.5' RT		" "	F	
630+67	D	3.0' RT		" "	F	
631+67	D	2.5' LT		" "	F	
635+73	D	2.5' LT		" "	F	
644+65	A	4.0' LT		" "	G	
644+85	J	6.5' RT		36" X 36" con. base	G	
645+50	I	2.0' RT		DRIVEN IN	G	
646+96	D	1.5' RT		" "	F	
648+04	D	5.0' LT		" "	G	
649+85	J	7.5' LT		36" X 36" con. base	G	
650+61	K	4.0' LT		DRIVEN IN	G	
651+21	L	4.0' LT		" "	G	
651+24	L	4.0' RT		" "	G	
653+08	L	3.5' RT		" "	G	
653+71	G	2.5' RT		" "	G	
654+55	I	3.0' RT		" "	G	

PERSONNEL TITLE PERSONNEL TITLE

COUNTY Lucas DATE 25 June 87

S. R. #51 WEATHER Sunny

SEC. Monroe St TEMP. 80°

DESCRIPTION

Sign Information

JOB NO. 022050

Sta.	SIGN	DIST.		HOW IN GROUND	COND.	
		A	B			
657+83	L	5.5' Lt		DRIVEN IN	sign slightly bent	
658+58	D	3.0' Lt		"	G	
658+98	I	3.0' Lt		"	"	
663+13	I	2.0' Rt		"	"	
664+05	G	2.0' Lt		"	"	
665+18	L	4.0' Lt		"	Post Bent sign G	
667+03	M	4.0' Lt		" (X)	G	This is a double post
667+42	N	3.0' Rt		"	"	

NOTE: All posts are single except where noted