

STONE & CREW
FEB. 87

MAINTENANCE PROGRAM _____

PART 1
OF _____

TOP) TYPE _____ THICKNESS _____ PRIORITY _____

BASE) TYPE _____ THICKNESS _____ PENETRATION _____

END LOG S.L.M. 12.66 (Acres Rd. 668+44.8 (Calc.) 668+23.22 (Meas.))

BEGIN LOG S.L.M. 11.27 (South Radius Lantry Rd. = 594+93 (Meas.) (Meas.))

TOTAL LENGTH 1.39

COUNTY LUCAS SECTION _____ WIDTH () () BERM CURBED () ()

ROUTE S.R. 51 SECTION _____ WIDTH () () () ()

SECTION _____ WIDTH () () () ()

ORDINANCE _____ SECTION _____ WIDTH () () () ()

END LOG _____ SECTION _____ WIDTH () () () ()

BEGIN LOG _____ SECTION _____ WIDTH () () () ()

EXISTING EXISTING MAILBOX
ERM TYPE _____ BERM WIDTH _____ APPROACHES No. None

(PAVED, STABILIZED, AGGREGATE)

MANHOLES 24

PROPOSED PROPOSED INLETS
ERM TYPE _____ BERM WIDTH _____ X CATCH BASINS 48

INTERSECTIONS 12 ASPHALT CONCRETE
DRIVEWAYS 6 DRIVEWAYS 4

STRUCTURES

STRUCTURE NO.	WIDTH	LENGTH	APPR.	SLABS
<u>None</u>				

RAILROAD CROSSINGS

NAME R. R.	STATION	(*)	()	No.	TRACE
<u>None</u>		()	()		TRACE
		()	()		TRACE
		()	()		TRACE
*Indicate length of crossing along E Pav't.

Raised Pavement Markers Locations

Edge Pav't. No. _____

Centerline Pav't. No. _____


NOTES

All driveways not listed have raised curbs with a
minimum height of 2 inch.

PERSONNEL	TITLE	PERSONNEL	TITLE	COUNTY	DATE	S. R.	WEATHER	SEC.	TEMP.
Stone				Lucas	9 Feb. 87	#51	Cool	11.27-12.66	20°
Crew									

DESCRIPTION faucets + widths JOB NO. _____

LEFT CENTER LINE RIGHT

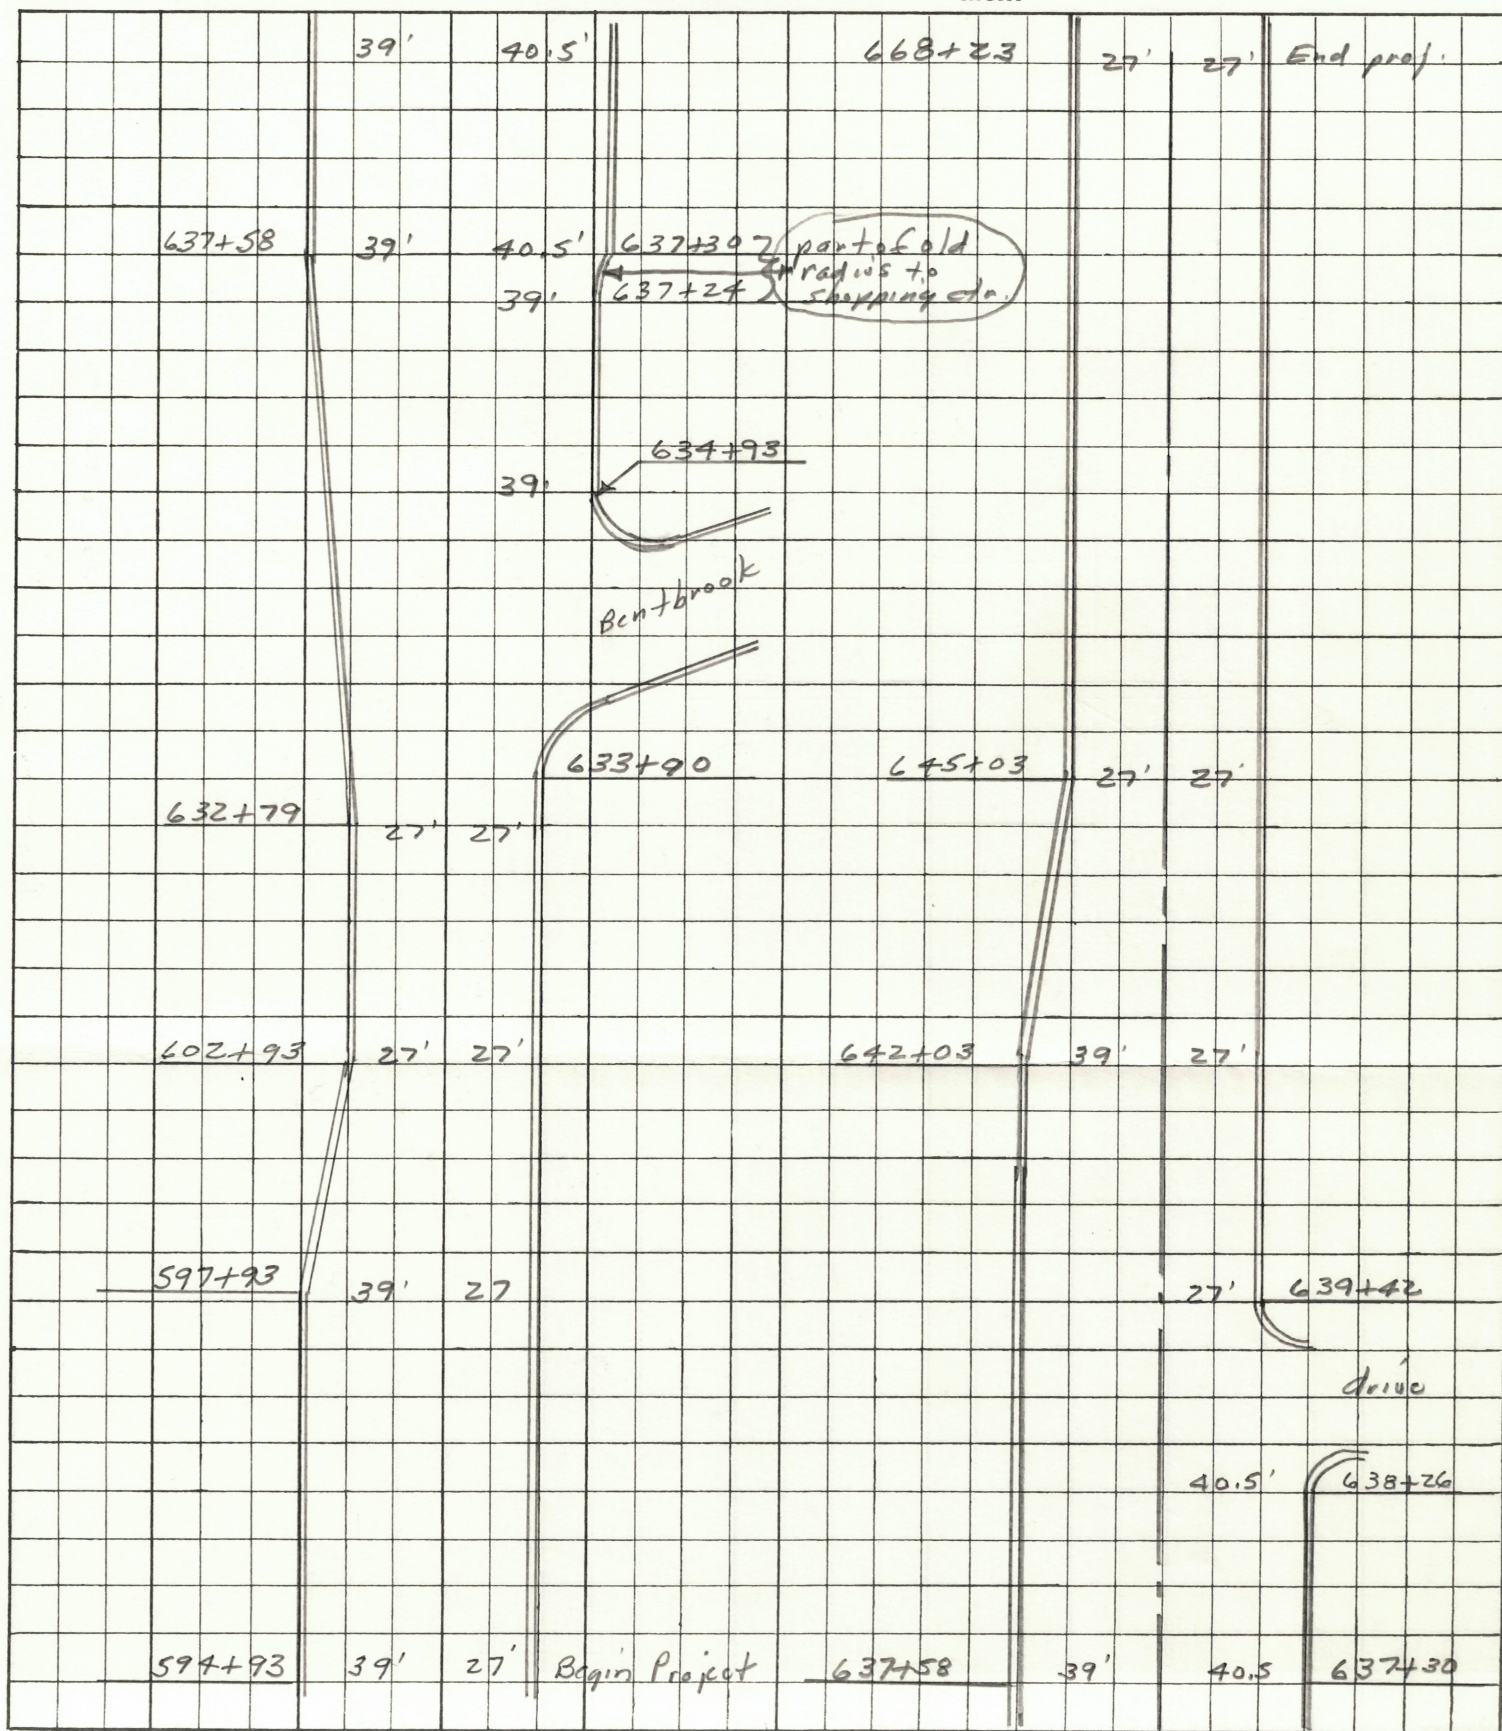

PERSONNEL	TITLE	PERSONNEL	TITLE	COUNTY	DATE
Stoys				Lucas	5 Feb. 87
				S. R.	#51
				WEATHER	Cool
				SEC.	11.27-12.66
				TEMP.	20°
DESCRIPTION				JOB NO.	
LEFT		CENTER LINE		RIGHT	

STATION	OUT Rt.-Lt.	CB	TYPE 1,2,3	MH	TYPE San. Storm	MONU	TYPE Box Other	WV	CASTING		Remarks
									Raise	Feather	
595+20	36' Rt			✓	Storm				✓		
595+22	Rt	✓	1							✓	double
595+85	Rt	✓	1							✓	"
597+04	Lt	✓	1							✓	"
597+19	Rt	✓	1							✓	"
603+69	Rt	✓	1							✓	"
604+04	Lt	✓	1							✓	"
604+85	Rt	✓	1							✓	"
605+85	Lt	✓	1							✓	"
605+97	Rt	✓	1							✓	single
606+00	33' Lt			✓	Storm				✓		
606+41	29' Lt			✓	Storm				✓		
606+48	30' Rt			✓	Storm						
606+60	Rt	✓	1							✓	double
606+80.5	E					✓			✓		Int. Whitford Rd.
606+70	35' Rt			✓	Storm				✓		
606+90	Lt	✓	1							✓	double
606+90	35' Lt			✓	Storm					✓	
607+97	Lt	✓	1							✓	double
608+05	Rt	✓	1							✓	single
608+17	Rt	✓	1							✓	single
616+79	Lt	✓	1							✓	double
617+29	Rt	✓	1							✓	"
617+34	29' Lt			✓							
617+80	Rt	✓	1							✓	double
618+59	Rt	✓	1							✓	"
621+03	Lt	✓	1							✓	
621+26	E					✓			✓		Int. Silhouette = P.I.
621+65	46' Rt			✓	Storm					✓	
621+76	49' Rt							✓	✓		
621+81	43' Rt							✓	✓		
621+97	33' Rt			✓	Storm					✓	
622+55	Lt	✓	1							✓	double
626+04	Lt	✓	1							✓	"
627+97	17' Rt	✓	1	✓	Storm				✓	✓	"
628+04	Rt	✓	1							✓	double
628+04	24' Lt			✓	Storm				✓		
628+52	Lt	✓	1							✓	double
629+99	Rt	✓	1							✓	"
629+99	Lt	✓	1							✓	"
631+38	18' Rt			✓	San.				✓		
632+04	Lt	✓	1							✓	double
632+04	Rt	✓	1							✓	"
632+04	22' Lt			✓	Storm				✓		

PERSONNEL

TITLE

PERSONNEL

TITLE

COUNTY

Lucas

DATE

5 Feb. 87

S. R.

#51

WEATHER

Cool

SEC.

11.27 - 12.66

TEMP.

26.0

DESCRIPTION

LEFT

CENTER LINE


RIGHT

JOB NO.


STATION	OUT Rt.-Lt.	CB	TYPE 1,2,3	MH	TYPE San. Storm	MONU	TYPE Box Other	WV	CASTING		Remarks
									Raise	Feather	
634+51	21' Rt.			✓	San.				✓		
635+04	19' Lt.			✓	Storm				✓		
635+04	Rt.	✓	1							✓	double
635+46	E					✓			✓		P.O.T.
636+04	Lt.	✓	1							✓	double
637+48	25' Rt.			✓	Storm				✓		
640+85	23' Rt.			✓	"				✓		
641+04	Lt.	✓	1							✓	double
641+55	Lt.	✓	1							✓	"
644+02	Rt.	✓	1							✓	"
644+50	Rt.	✓	1							✓	"
644+61	17' Rt.			✓	San.				✓		
647+03	3' Rt.			✓	San.				✓		
647+50	Rt.	✓	2						✓		double
648+51	Rt.	✓	1							✓	"
648+99	Rt.	✓	1							✓	"
649+08	21' Rt.			✓	Storm					✓	
649+66	11' Rt.					✓			✓		P.C. & R/W 110+33.34
650+51	Rt.	✓	1							✓	
656+99	10' Rt.					✓			✓		P.T. & R/W 103+01.82
657+51	Lt.	✓	1							✓	double
657+94	Lt.	✓	1							✓	"
658+49	Lt.	✓	1							✓	"
658+96	3' Lt.					✓			✓		P.C. & R/W 101+03.64
659+27	18' Rt.			✓	San.				✓		
659+75	2' Lt.	✓	1							✓	double
661+04	17' Rt.			✓	San.				✓		
661+75	Rt.	✓	1							✓	double
664+58	22' Rt.							✓	✓		
664+66	19' Rt.			✓	San.				✓		
665+35	Lt.	✓	1							✓	double
665+35	Rt.	✓	1							✓	"
666+49	Lt.	✓	2							✓	"
666+49	Rt.	✓	1							✓	"
668+25	26' Rt.			✓	San.					✓	
668+80	Rt.	✓	1							✓	double
642+03	Lt.	✓	1							✓	"

COUNTY Lucas DATE 9 Feb. 87
S. R. #51 WEATHER Cool
SEC 11.27-12.66 TEMP 200

DESCRIPTION	LEFT	CENTER LINE	RIGHT	JOB NO.
-------------	------	-------------	-------	---------

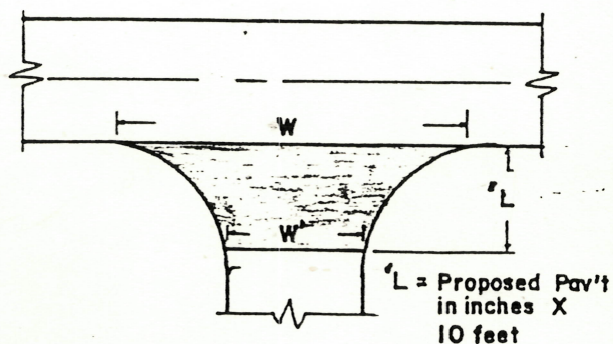

INTERSECTION TYPICAL

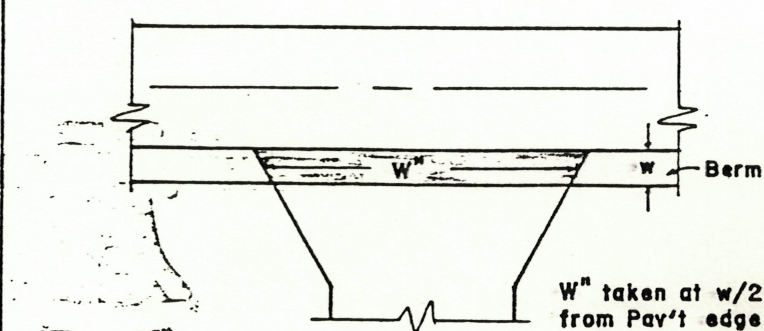

DRIVEWAY - TYPICAL

[illegible]