

O.D.O.T. DISTRICT 2 SURVEY OFFICE (USE ONLY)

PERSONNEL

REFERENCE NO. 3

SHEET 4 OF 7

NOTES BALBAUGH

DATE 4/15/20

ROUTE SR 51

H.C. LEU

WEATHER CLOUDY

COUNTY OTTAWA

R.C. BALBAUGH

TEMP. 64°

TOWNSHIP HARRIS

SECTION 19

DWG BY NIESE

PID 94324

T 6 N R 14 E

TYPE MONUMENT NAIL

ON SURFACE - ~~BELOW~~ ON

OFFSET CL PAVEMENT 0.8' LT : ~~RT~~

- TO - EDGE PAVEMENT


STATION: 52+07.09

HORZ. DATUM: NAD83 2011


GEOID: NAVD88 2012A

GRID: NORTHING: 658759.381

EASTING: 1749329.766

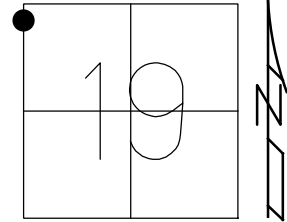


RECORD: P.I.
 STA 51+98.39
 $\Delta=45^{\circ}27'30''$ RT
 FD P.K.
 ATOP P.K.
 9/21/87, JLR
 4/27/15, EBW
 FD NAIL
 4/26/16, DCH
 SET MAG/WASHER
 NEWREF3
 9/30/16, DCH

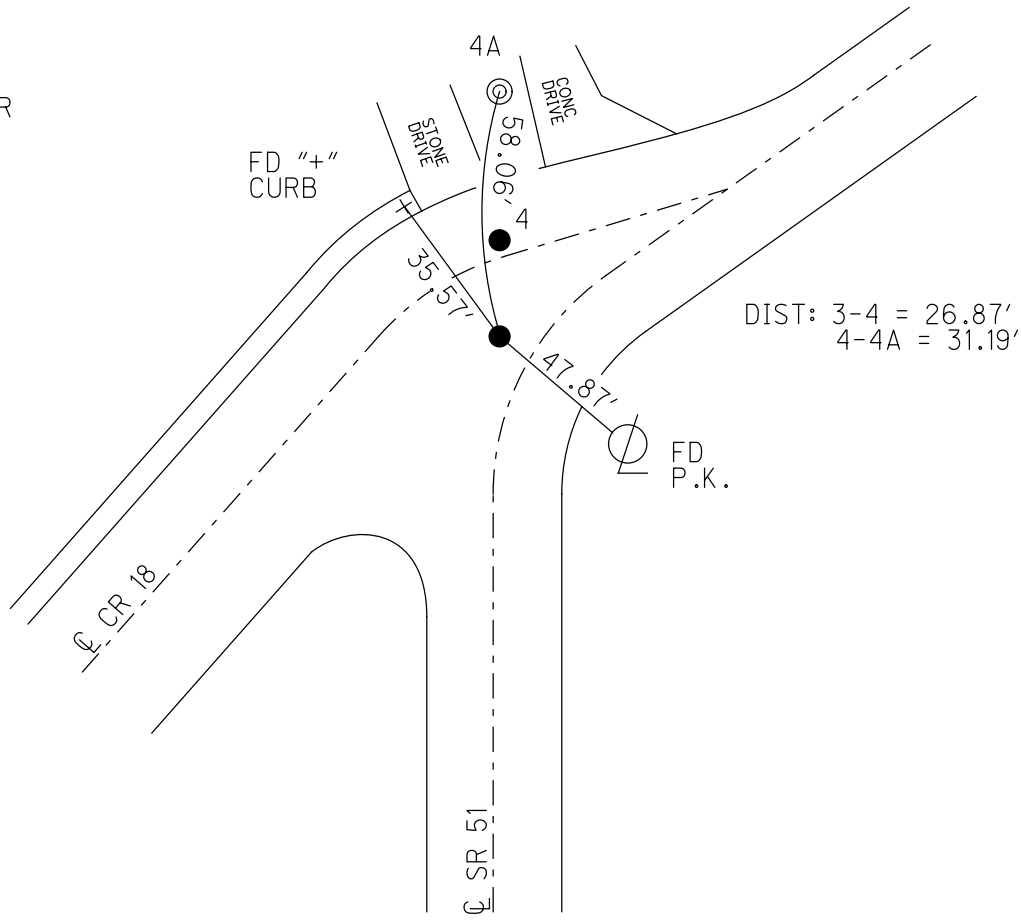

O.D.O.T. DISTRICT 2 SURVEY OFFICE (USE ONLY)

PERSONNEL _____ REFERENCE NO. 3 SHEET 4 OF 7
 NOTES LEU DATE 04-26-16 ROUTE SR 51
 H.C. HOMAN WEATHER PARTLY CLDY COUNTY OTTAWA
 R.C. LEU TEMP. 64°F TOWNSHIP HARRIS
 _____ SECTION 19
 _____ T 6 N R 14 E

TYPE MONUMENT NAIL
 ON SURFACE - ~~BELOW~~ ON _____
 LEFT - ☉ PAV'T - ~~RIGHT~~ 0.8'
 - TO - EDGE PAVEMENT
 S.L.M. 52+07.09

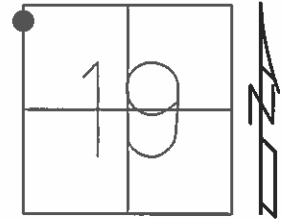

Grid: Northing: 658759.381 Easting: 1749329.766


RECORD:
 PI ??
 $\Delta = 45^\circ 27' 30''$ RT
 STA 51+98.39
 PK ATOP
 PK BELOW SURFACE
 * IF STATION RIGHT
 ON MON THEN PI OFF 10'

DIST: 3-4 = 26.87'
 4-4A = 31.19'

GPS, REF3
 04-27-15, EBW, JLL

FD NAIL
 GPS, REF3
 04-26-16

SET MAG/WASHER
 GPS, NEWREF3
 09-30-16, DCH

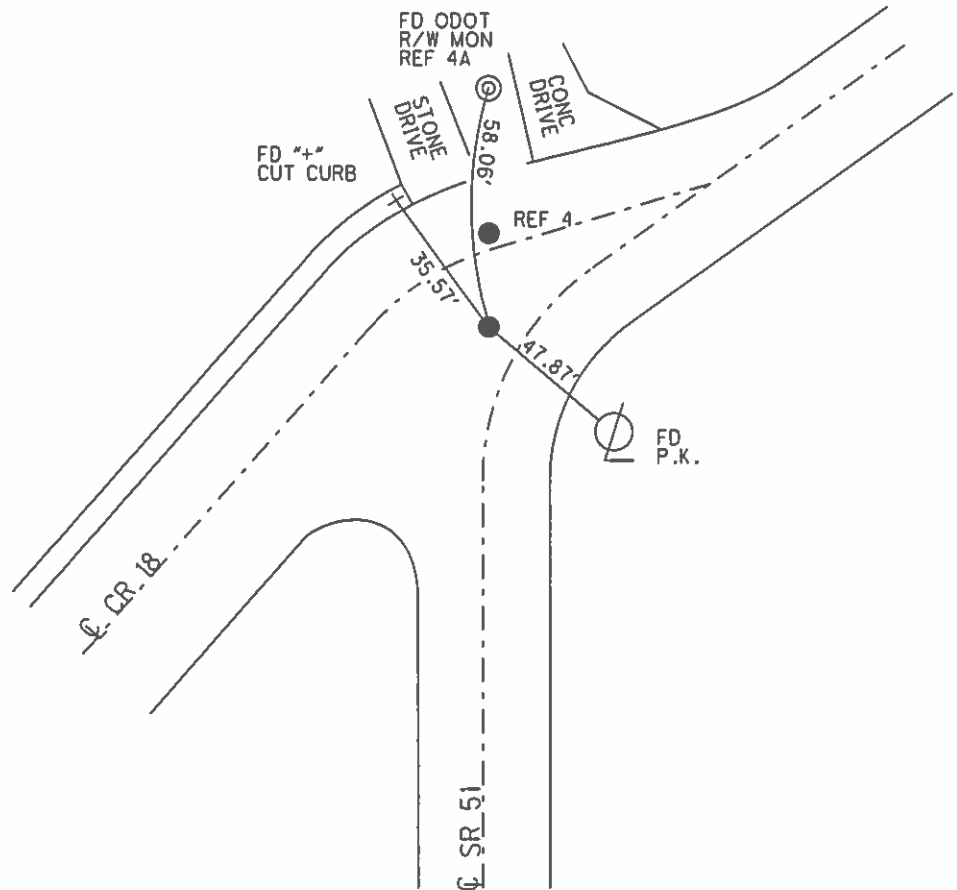

O.D.O.T. DISTRICT 2 SURVEY OFFICE

PERSONNEL

REFERENCE NO. 3

SHEET 3 OF

NOTES Cronin

H.C. Ripple

R.C. Garbour

Geyman

DATE 9/21/87

WEATHER sunny

TEMP. 63°

ROUTE 51

COUNTY Ottawa

TOWNSHIP Harris

SECTION 19

T 6 N R 14 E



TYPE MONUMENT P.K.

ON SURFACE - BELOW on surface

LEFT - & PAV'T. - RIGHT 28' Lt. & Pavt.

TO EDGE PAVEMENT

S.L.M. 51+98.39??

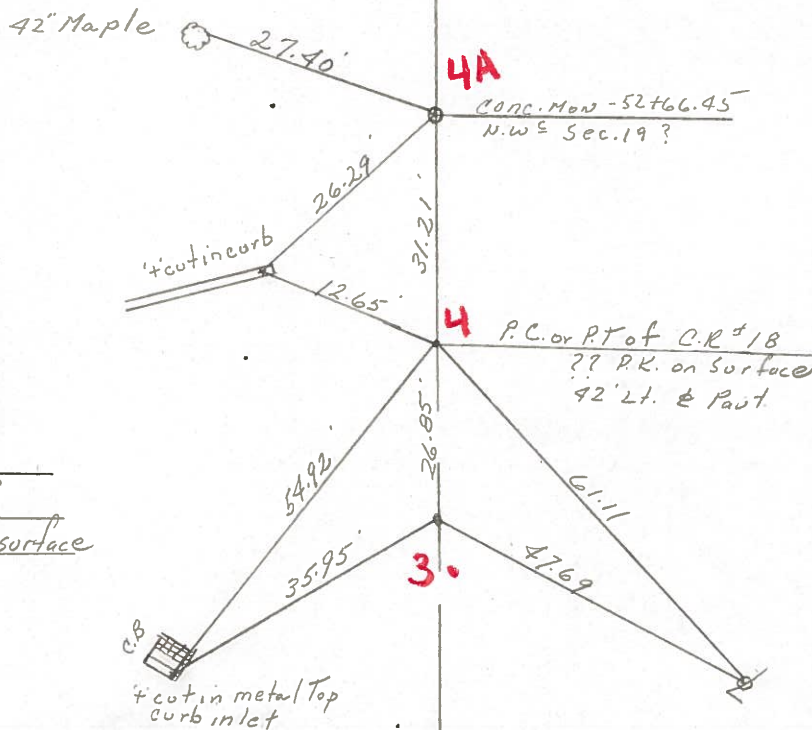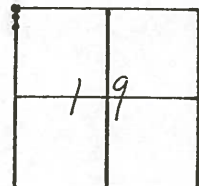

$\Delta = 45^\circ 27' 30''$ Rt.

51+98.39 P.I.??

P.K. at top P.K. below surface

* If right Sta. on road then P.I. is 40' off.

S. R. # 51

PERSONNEL TITLE PERSONNEL TITLE


COUNTY Ottawa DATE 1-10-72

S. R. 51 WEATHER Fair

SEC. 19 & 24 TEMP. 35°

DESCRIPTION Clay & Harris Twp JOB NO. _____

LEFT CENTER LINE RIGHT

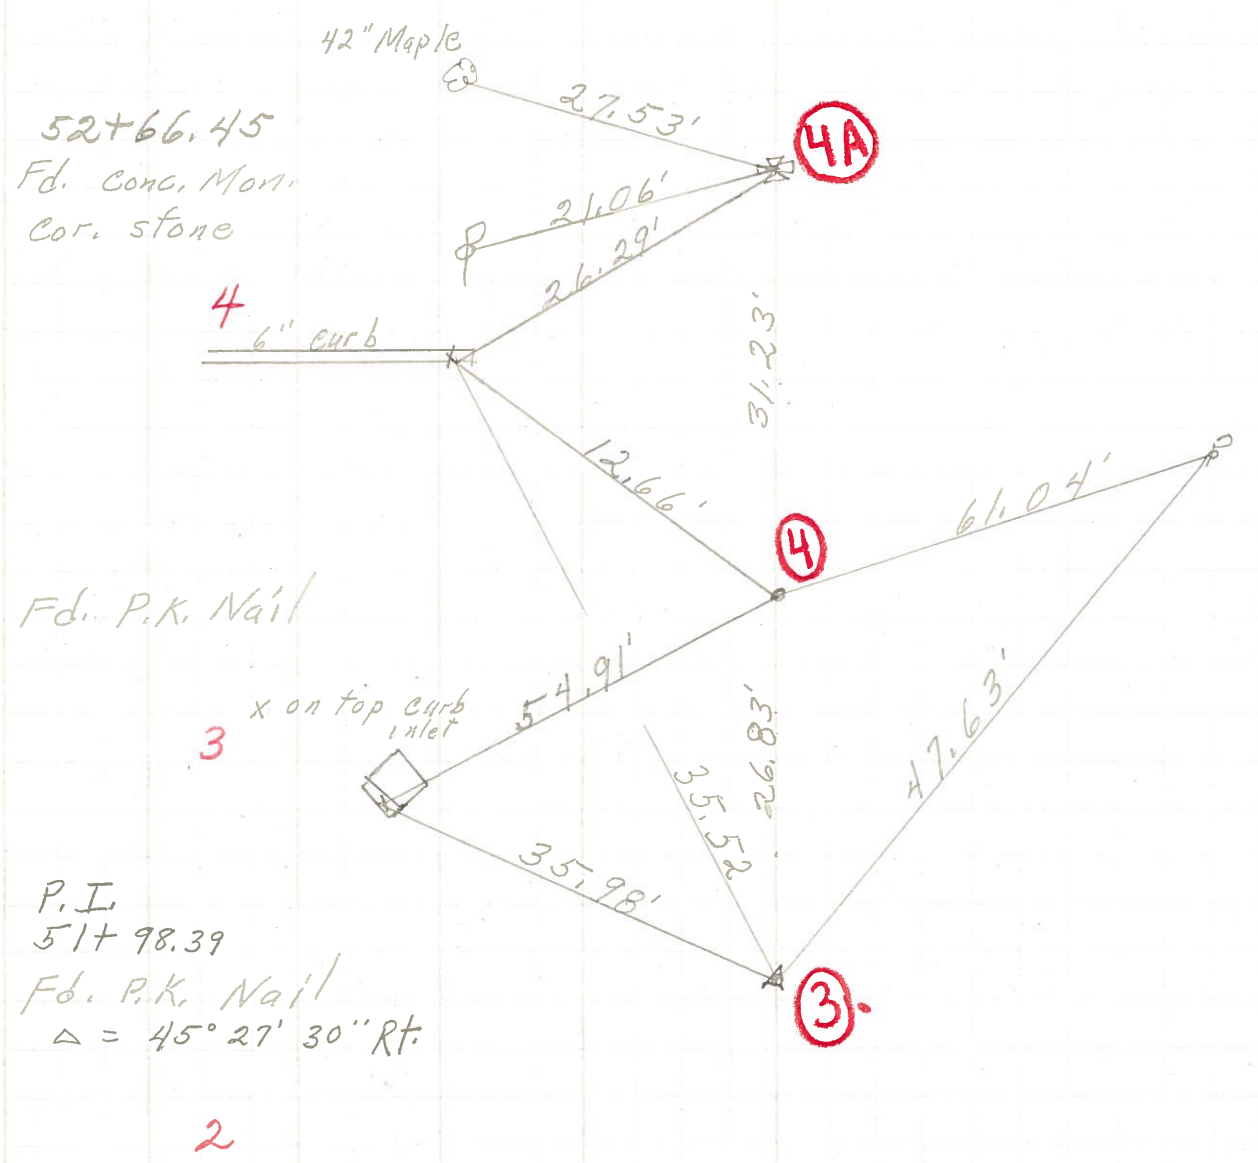

PERSONNEL	TITLE	PERSONNEL	TITLE	COUNTY	DATE
<u>Schneider</u>		<u>Potts</u>		<u>Ottawa</u>	<u>7-10-68</u>
<u>Mosser</u>				S. R. <u>51</u>	WEATHER <u>Fair</u>
<u>Barbour</u>				SEC. <u>Wood Co Line - East</u>	TEMP. <u>75°</u>
<u>Redding</u>					
DESCRIPTION	<u>Ties for Control Points</u>			JOB NO.	

