


O.D.O.T. DISTRICT 2 SURVEY OFFICE (USE ONLY)


PERSONNEL _____ REFERENCE NO. 4 SHEET 5 OF 7
 NOTES LEU DATE 4/26/16 ROUTE SR 51
 H.C. HOMAN WEATHER PARTLY CLOUDY COUNTY OTTAWA
 R.C. LEU TEMP. 64° TOWNSHIP HARRIS
 SECTION 19
 DWG BY NIESE PID 94324 T 6 N R 14 E

TYPE MONUMENT MAG NAIL
 ON SURFACE - ~~BELOW~~ ON
 OFFSET ☉ PAVEMENT 19.2' LT : RT
- TO - EDGE PAVEMENT
 STATION: 52+25.88

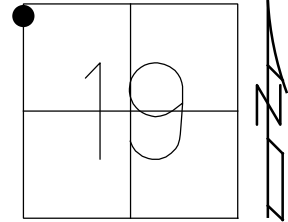

HORIZ.DATUM: NAD83 2011 GEOID: NAVD88 2012A
 GRID: NORTHING: 658786.235 EASTING: 1749329.885


RECORD:
 FD P.K.NAIL
 4/27/15, EBW
 FD MAG NAIL
 4/26/16, DCH
 SET MAG/WASHER
 NEWREF4
 9/30/16, DCH

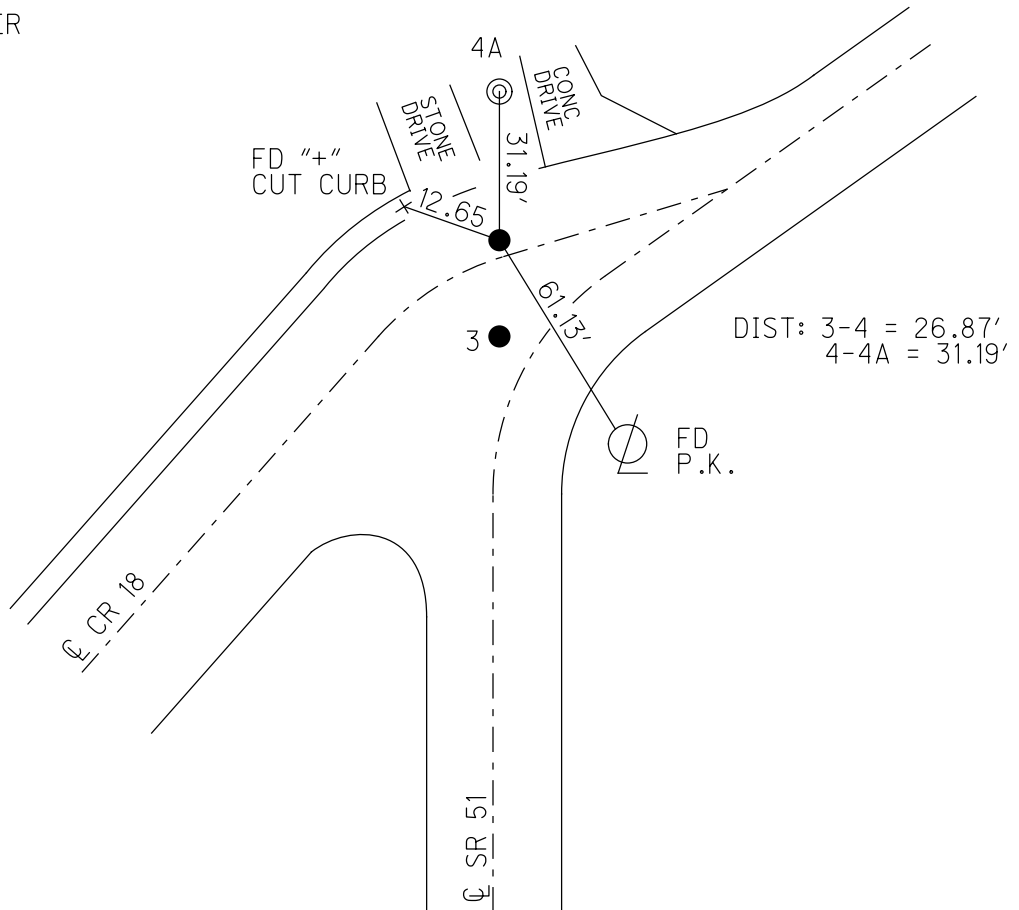

O.D.O.T. DISTRICT 2 SURVEY OFFICE (USE ONLY)

PERSONNEL _____ REFERENCE NO. 4 SHEET 5 OF 7
 NOTES LEU DATE 04-26-16 ROUTE SR 51
 H.C. HOMAN WEATHER PARTLY CLDY COUNTY OTTAWA
 R.C. LEU TEMP. 64°F TOWNSHIP HARRIS
 _____ SECTION 19
 _____ T 6 N R 14 E

TYPE MONUMENT MAG NAIL
 ON SURFACE - ~~BELOW~~ ON _____
 LEFT - ☉ PAV'T - ~~RIGHT~~ 19.2'
 - TO - EDGE PAVEMENT
 S.L.M. 52+25.88

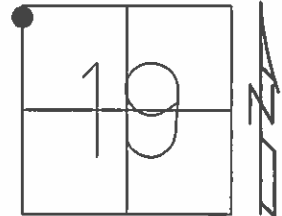

Grid: Northing: 658786.2347 Easting: 1749329.885


RECORD:
 P.C. OR P.T. OF CR#18
 ?? PK AT SURFACE
 42' LT ☉ PAVT

DIST: 3-4 = 26.87'
 4-4A = 31.19'

GPS, REF4
 04-27-15, EBW, JLL

FD MAG NAIL
 GPS, REF4
 04-26-16

SET MAG/WASHER
 GPS, NEWREF4
 09-30-16

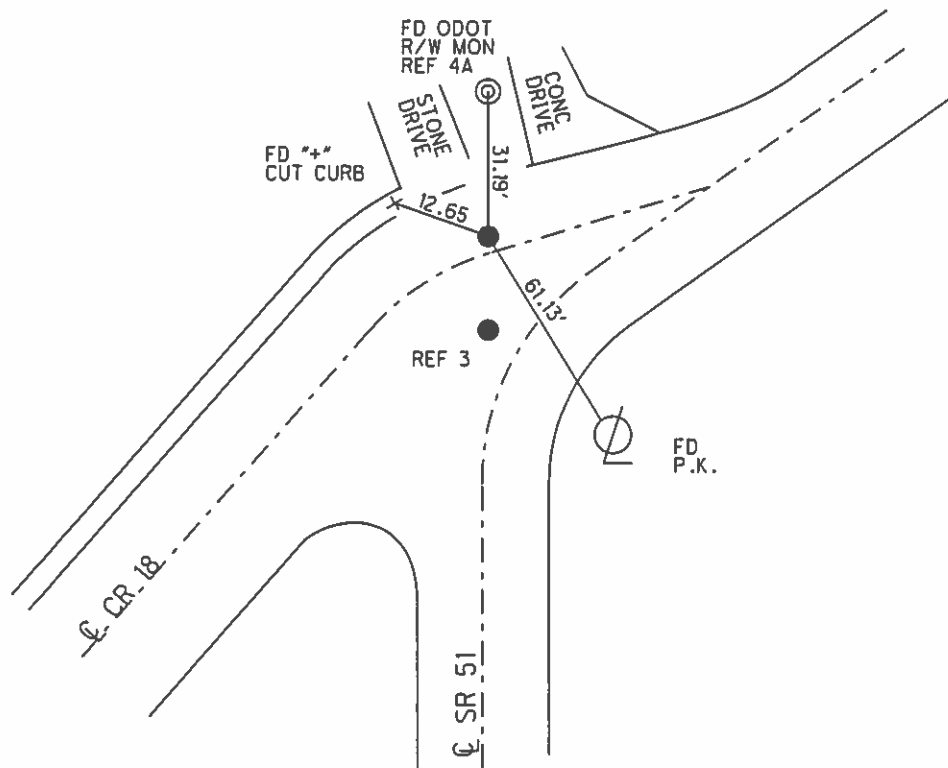

O.D.O.T. DISTRICT 2 SURVEY OFFICE

PERSONNEL

REFERENCE NO. 3

SHEET 3 OF

NOTES Cronin

H.C. Ripple

R.C. Garbour

Geyman

DATE 9/21/87

WEATHER sunny

TEMP. 63°

ROUTE 51

COUNTY Ottawa

TOWNSHIP Harris

SECTION 19

T 6 N R 14 E



TYPE MONUMENT P.K.

ON SURFACE - BELOW on surface

LEFT - & PAV'T. - RIGHT 28' Lt. & Pavt.

TO EDGE PAVEMENT

S.L.M. 51+98.39??

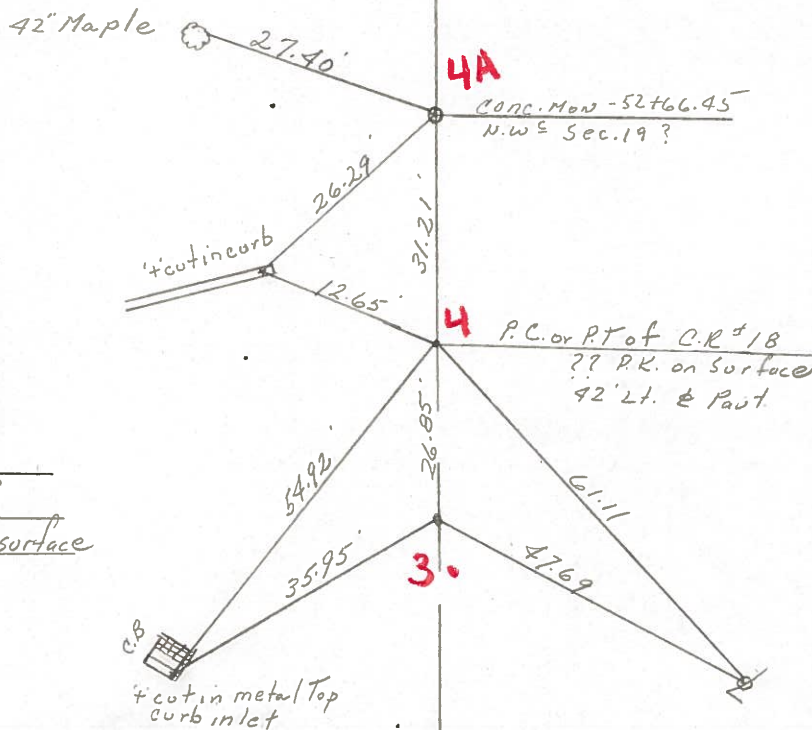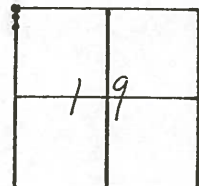

$\Delta = 45^\circ 27' 30''$ Rt.

51+98.39 P.I.??

P.K. at top P.K. below surface

* If right Sta. on road then P.I. is 40' off.

S. R. # 51

PERSONNEL TITLE PERSONNEL TITLE

COUNTY Ottawa DATE 1-10-72

S. R. 51 WEATHER Fair

SEC. 19 & 24 TEMP. 35°

DESCRIPTION Clay & Harris Twp JOB NO. _____

LEFT CENTER LINE RIGHT

