

O.D.O.T. DISTRICT 2 SURVEY OFFICE (USE ONLY)

PERSONNEL

REFERENCE NO. 8

SHEET 4 OF 18

NOTES BALBAUGH

DATE 4/15/20

ROUTE SR 51

H.C. LEU

WEATHER CLOUDY

COUNTY OTTAWA

R.C. BALBAUGH

TEMP. 39°

TOWNSHIP HARRIS

SECTION 13

DWG BY NIESE

PID 94324

T 6 N R 14 E

TYPE MONUMENT D.N.F.

ON SURFACE - BELOW -

OFFSET  $\odot$  PAVEMENT - LT : RT

- TO - EDGE PAVEMENT


STATION: 105+40.08

HORZ.DATUM: NAD83 2011


GEOID: NAVD88 2012A

GRID: NORTHING: \_\_\_\_\_

EASTING: \_\_\_\_\_

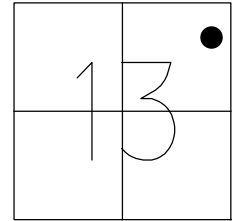

RECORD: P.I.  
 $\Delta = 00^{\circ} 25' 00''$  LT  
D.N.F.  
9/22/87  
4/28/00  
4/29/15, JLL  
4/15/20, JLL

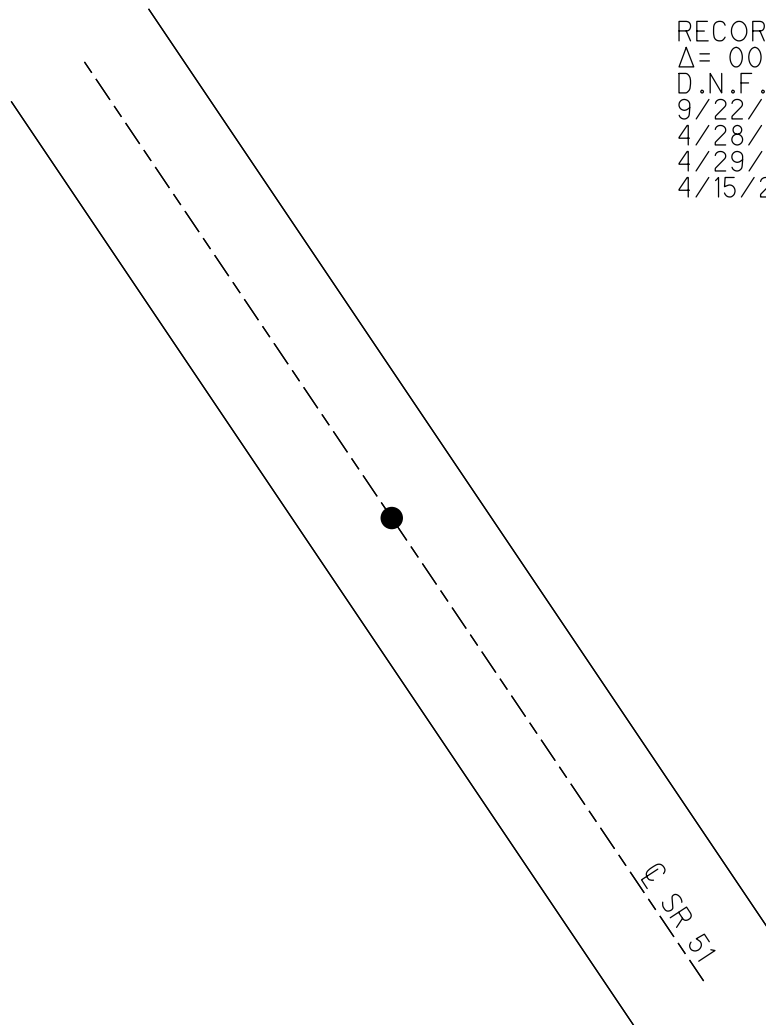

Did not Find

# O.D.O.T. DISTRICT 2 SURVEY OFFICE

PERSONNEL \_\_\_\_\_

REFERENCE NO. 8

SHEET 2 OF 17

NOTES Barnhisel

H.C. Canterbury

R.C. Moser

DATE 4-28-00

WEATHER Sunny

TEMP. 55°

ROUTE 51

COUNTY OTTAWA

TOWNSHIP HARRIS

SECTION 13

DRAWN BY - ADMAN

T 6 N R 14 E


TYPE MONUMENT \_\_\_\_\_

ON SURFACE - BELOW \_\_\_\_\_

LEFT - Q PAW'T. - RIGHT \_\_\_\_\_


\_\_\_\_\_ TO \_\_\_\_\_ EDGE PAVEMENT

S.L.M. 105 + 40.08

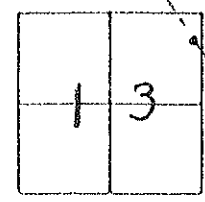

RECORD: P.I.  $\Delta = 00^{\circ}25'00''$  LT.  
 WILL HAVE TO RE-ESTABLISH.  
 9-22-87

DNE 4-28-00

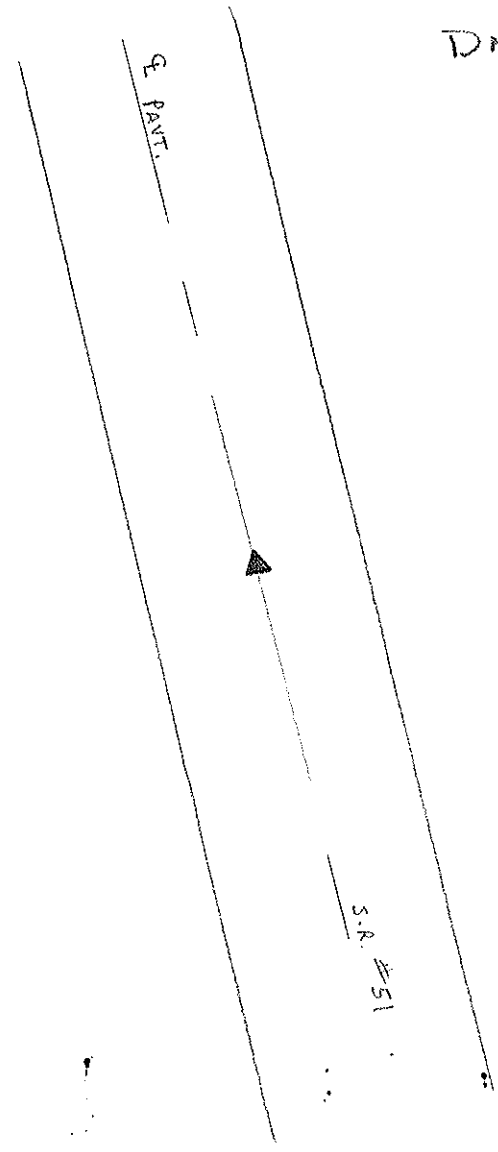

O.D.O.T. DISTRICT 2 SURVEY OFFICE

PERSONNEL \_\_\_\_\_

REFERENCE NO. 8

SHEET 7 OF \_\_\_\_\_

NOTES Cronin

H.C. \_\_\_\_\_

R.C. \_\_\_\_\_

DATE 9/22/87

WEATHER Rain

TEMP. 60°

ROUTE 51

COUNTY Ottawa

TOWNSHIP Harris

SECTION 13

T 6 N R 14 E



TYPE MONUMENT \_\_\_\_\_

ON SURFACE - BELOW \_\_\_\_\_


LEFT -  $\text{C}$  PAV'T. - RIGHT \_\_\_\_\_

\_\_\_\_\_ TO \_\_\_\_\_ EDGE PAVEMENT


S.L.M. 105+40.08

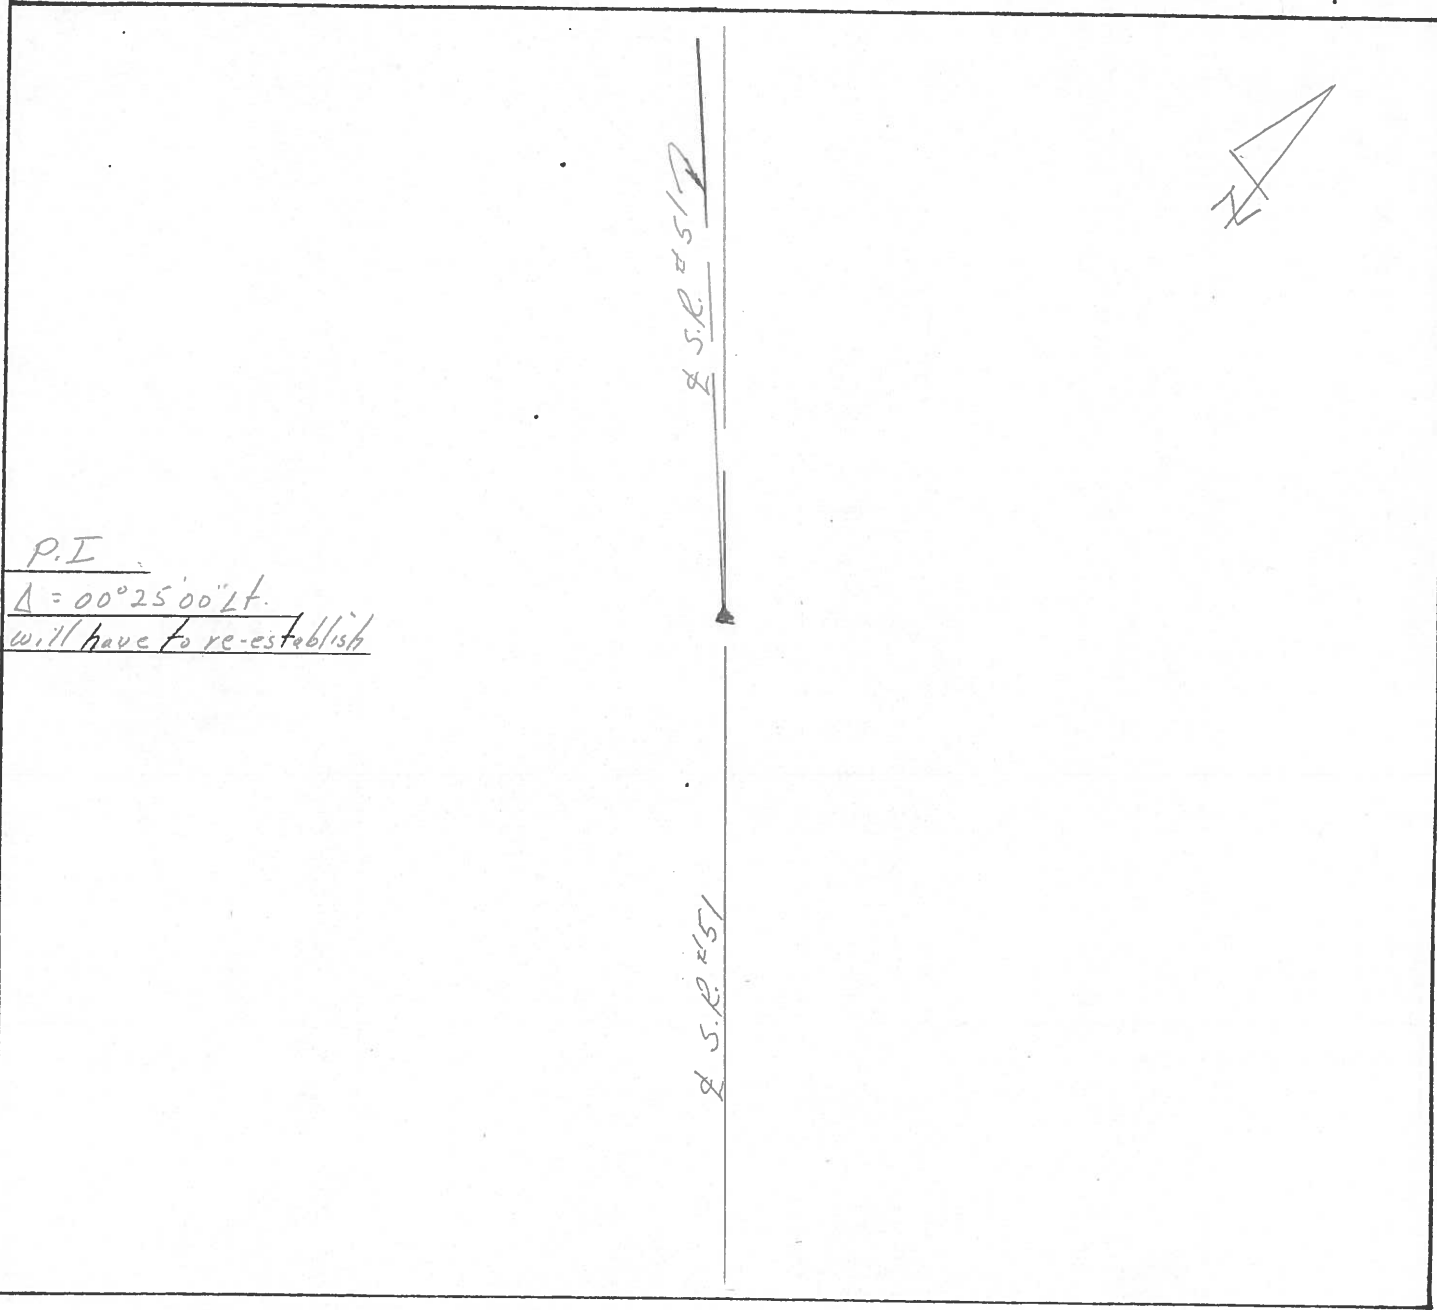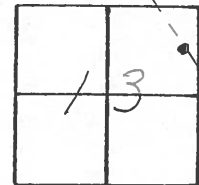


PERSONNEL	TITLE	PERSONNEL	TITLE	COUNTY	DATE
				<u>Ottawa</u>	<u>1-10-72</u>
				S. R. <u>51</u>	WEATHER <u>Fair</u>
				SEC. <u>12</u>	TEMP. <u>35°</u>
DESCRIPTION <u>Clay Twp.</u>				JOB NO. _____	
LEFT		CENTER LINE		RIGHT	

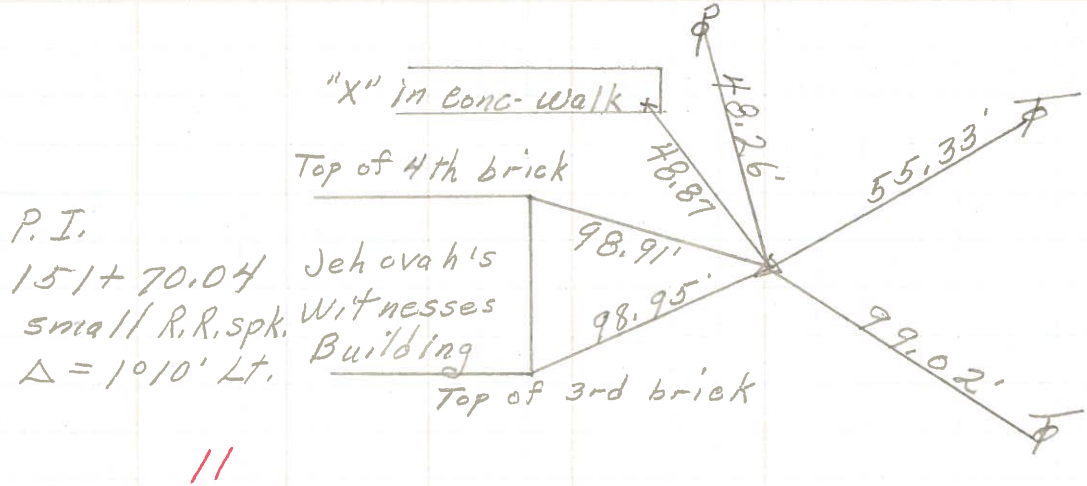

11

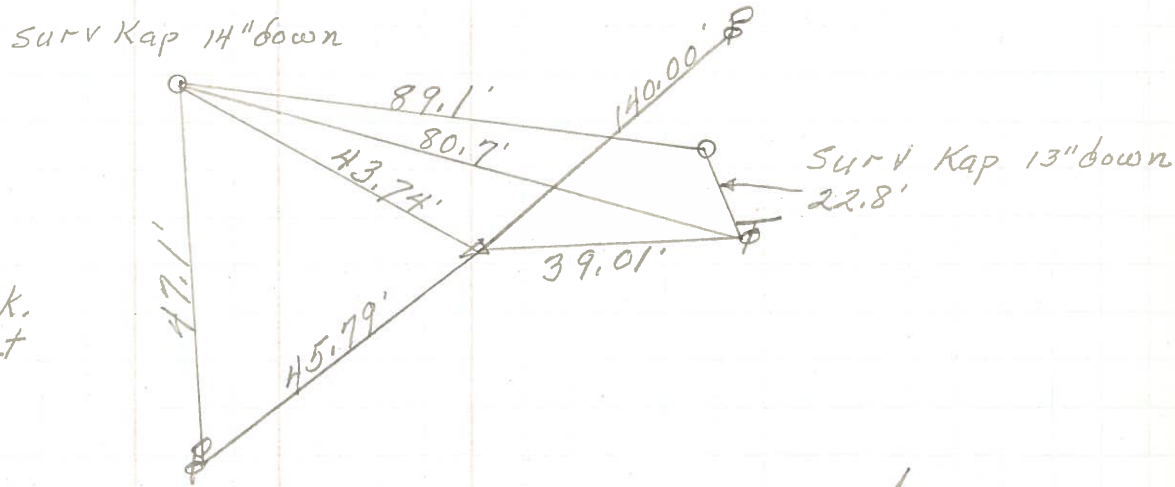

10

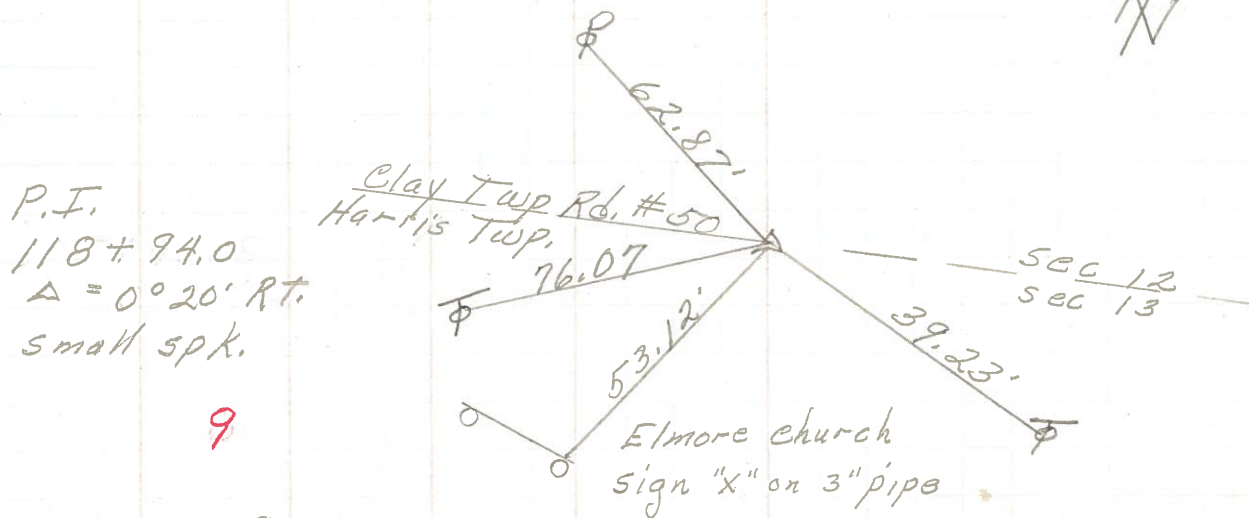

9

105+40.08  
did not find