

O.D.O.T. DISTRICT 2 SURVEY OFFICE (USE ONLY)

PERSONNEL _____ REFERENCE NO. 16 SHEET 12 OF 18
 NOTES BALBAUGH DATE 4/16/20 ROUTE SR 51
 H.C. LEU WEATHER SUNNY COUNTY OTTAWA
 R.C. BALBAUGH TEMP. 35° TOWNSHIP CLAY
 _____ SECTION 2
 DWG BY NIESE PID 94324 T 6 N R 13 E

TYPE MONUMENT 1" IPIN

~~ON SURFACE~~ - BELOW 3.5"


OFFSET CL PAVEMENT 20.6' ~~LT~~ : RT

8.3' TO RT ~~EDGE PAVEMENT~~ OF EB


STATION: 207+23.06

HORZ.DATUM: NAD83 2011 GEOID: NAVD88 2012A

GRID: NORTHING: 671578.956 EASTING: 1743443.155

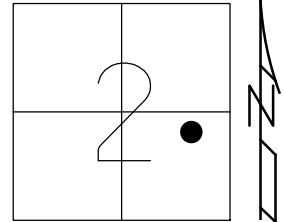

RECORD: P.I.
 $\Delta = 20^\circ 36' 00''$ LT
 FD IPIN
 4/28/00, MB
 6/28/00, SAH
 FD 1" IPIN
 REF16
 4/17/15, JFO

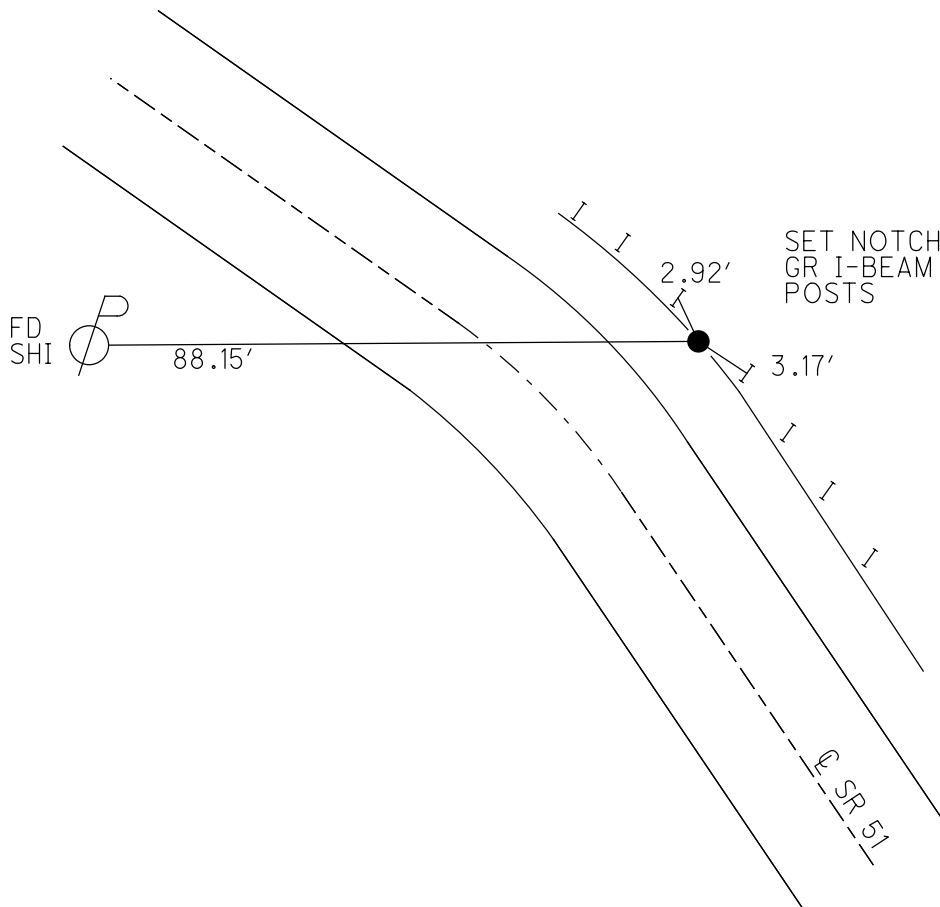


O.D.O.T. DISTRICT 2 SURVEY OFFICE (USE ONLY)


PERSONNEL _____ REFERENCE NO. 16 SHEET 10 OF 16

NOTES BARNHESEL DATE 4/28/00 ROUTE SR 51
 H.C. CANTERBURY WEATHER SUNNY COUNTY OTTAWA
 R.C. MOSER TEMP. 55° TOWNSHIP CLAY
 _____ SECTION 2
 _____ T 6 N R 13 E

TYPE MONUMENT 1" IPIN
 ON SURFACE - ~~BELOW~~ ON _____
~~LEFT~~ - Q PAV'T - RIGHT 21'
8.3' RT TO RT EDGE OF BERM
 S.L.M. 207+32.06
 Grid: Northing: 671578.969 Easting: 1743433.123

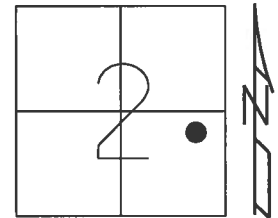

RECORD: P.I.
 $\Delta = 20^\circ 36' LT$
 FD IPIN
 4/28/00, MB
 NOT COVERED
 6/28/00, SAH
 FD 1" IPIN
 REF 16
 4/17/15, JFO

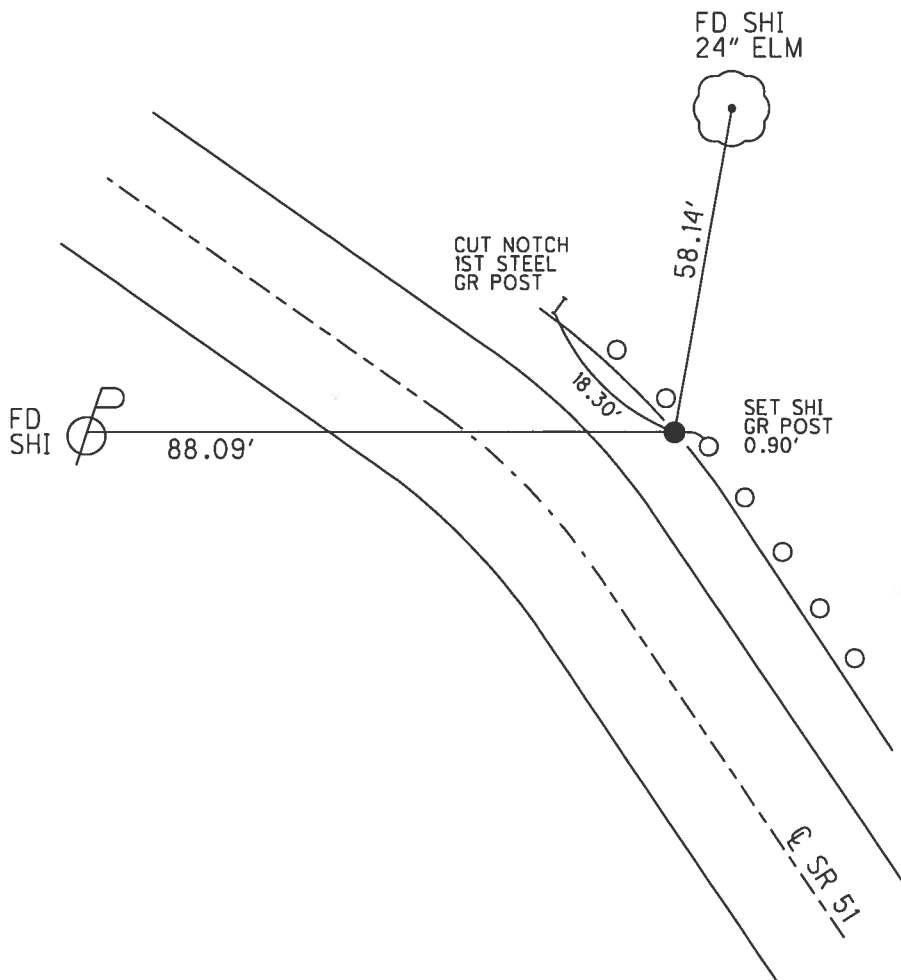

O.D.O.T. DISTRICT 2 SURVEY OFFICE

PERSONNEL _____

REFERENCE NO. 16

SHEET 10 OF 17

NOTES Barnhisel

H.C. Canterbury

R.C. Moser

DATE 4-28-00

WEATHER Sunny

TEMP. 55°

ROUTE 51

COUNTY Ottawa

TOWNSHIP Clay

SECTION 2

T6 N R 13 E

DRAWN BY - HOMAN!


TYPE MONUMENT Iron Rod

ON SURFACE - BELOW Yes

LEFT - C. PAV'T. - RIGHT 21'


8.3 TO EDGE PAVEMENT

S.L.M. 208+06

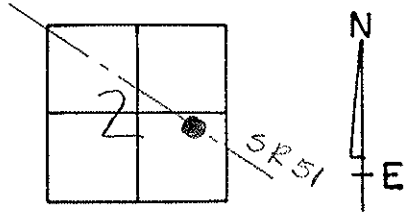

PI "RECORD"
 $\Delta = 20^{\circ} 36' 00''$ Lt

NOT COVERED w/ ASPHALT
 6-28-00
 SAH

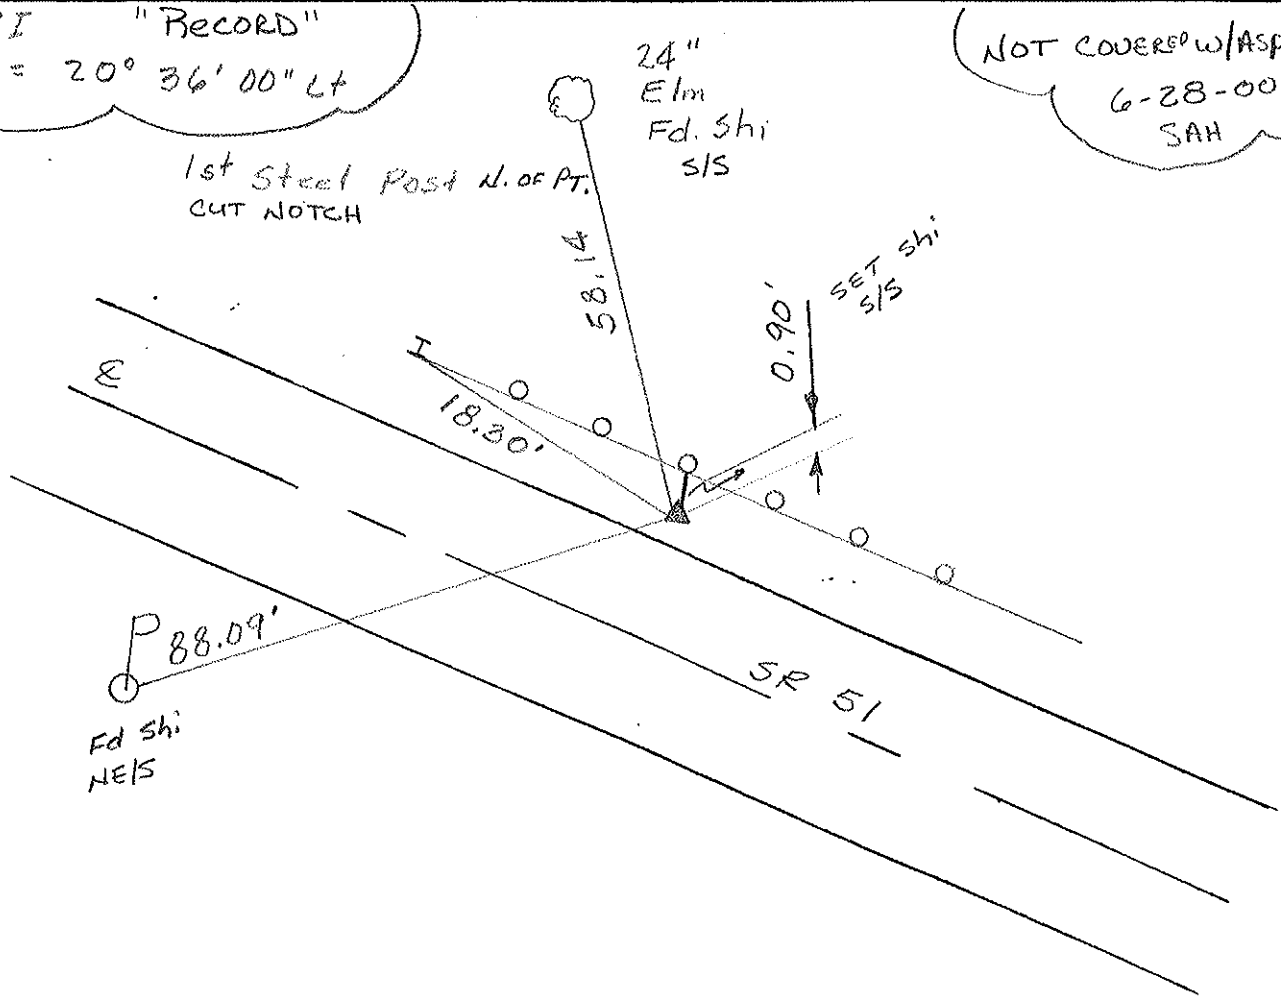

O.D.O.T. DISTRICT 2 SURVEY OFFICE

PERSONNEL

REFERENCE NO. 16

SHEET 15 OF

NOTES Cronin

H.C. Ripple

R.C. Barbour

Geyman

DATE 9/24/87

WEATHER overcast

TEMP. 66°

ROUTE 51

COUNTY Ottawa

TOWNSHIP Clay

SECTION 2

T 6 N R 13 E



TYPE MONUMENT Iron Rod

ON SURFACE - BELOW on surface

LEFT - ☉ PAV'T. - RIGHT 21 ft. & Post.

 TO EDGE PAVEMENT


S.L.M. 207+43.83

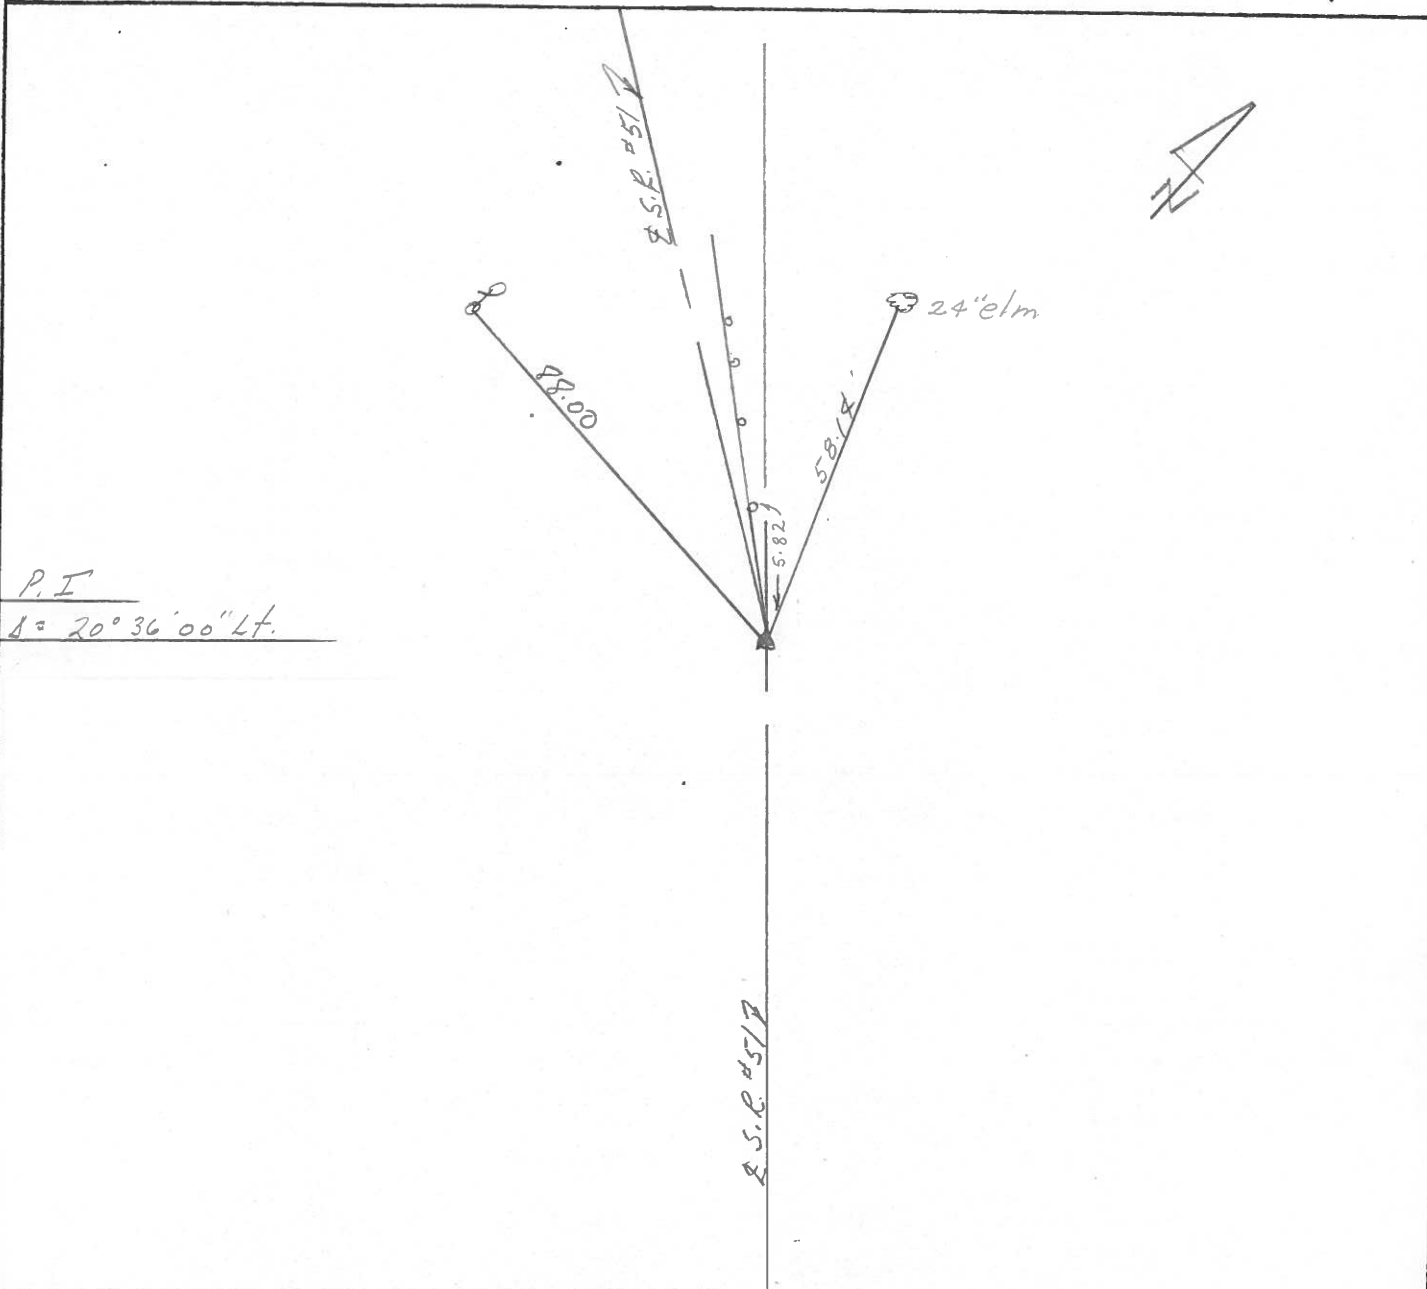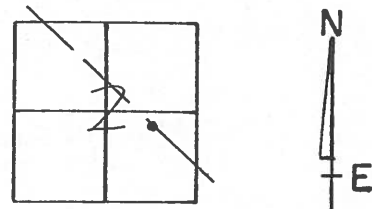

PERSONNEL	TITLE	PERSONNEL	TITLE

COUNTY Ottawa DATE 1-11-72
 S. R. 51 WEATHER Fair
 SEC. 2 TEMP. 40°


DESCRIPTION Clay Twp. JOB NO. _____

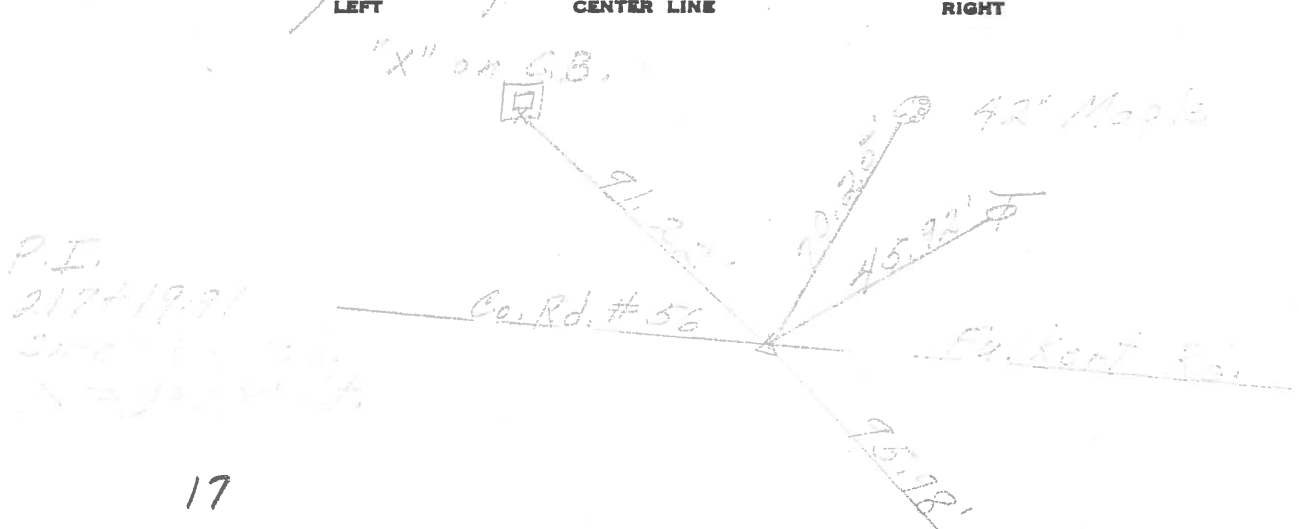

P.I.
 217+19.91
 Δ = 20° 36' Lt.
 X = 1/2" on C.B.

17

P.I.
 207+45.83
 Δ = 20° 36' Lt.
 Set 1" x 30" Iron pin
 16.
 Measured & turned
 angle

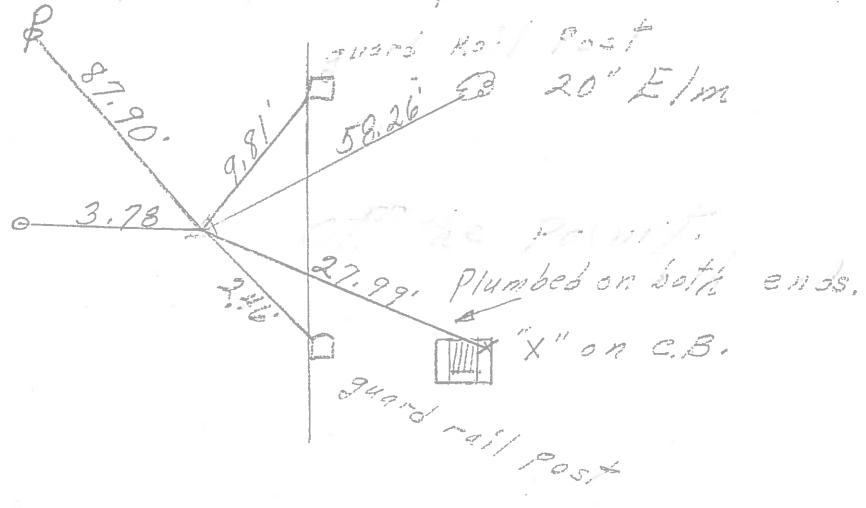

P.I.
 199+42.75
 Δ = 0° 07' Rt
 Measured & turned
 angle; set P.K. Nail
 15

