


O.D.O.T. DISTRICT 2 SURVEY OFFICE (USE ONLY)


PERSONNEL _____ REFERENCE NO. 21 SHEET 17 OF 18
 NOTES BALBAUGH DATE 4/16/00 ROUTE SR 51
 H.C. LEU WEATHER WINDY COUNTY OTTAWA
 R.C. BALBAUGH TEMP. 40° TOWNSHIP CLAY
 DWG BY NIESE PID 94324 SECTION 2
 T 6 N R 13 E

TYPE MONUMENT P.K./WASHER
 ON SURFACE - ~~BELOW~~ ON
 OFFSET 1.1' LT : ~~RT~~
12.1' TO LT EDGE PAVEMENT
 STATION: 247+54.63

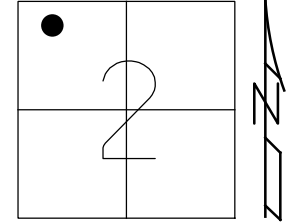

HORZ.DATUM: NAD83 2011 GEOID: NAVD88 2012A
 GRID: NORTHING: 673975.292 EASTING: 1740212.947

RECORD: P.I.
 $\Delta = 02^{\circ} 30' 00''$ RT
 FD P.K./WASHER
 ATOP SM.R.R.SPIKE
 FD P.K./WASHER
 5/1/00, MB
 SET P.K./WASHER
 6/9/00, SAH
 FD P.K./WASHER
 REF21
 4/17/15, JFO
 SET MAG/WASHER
 10/14/20, DSA

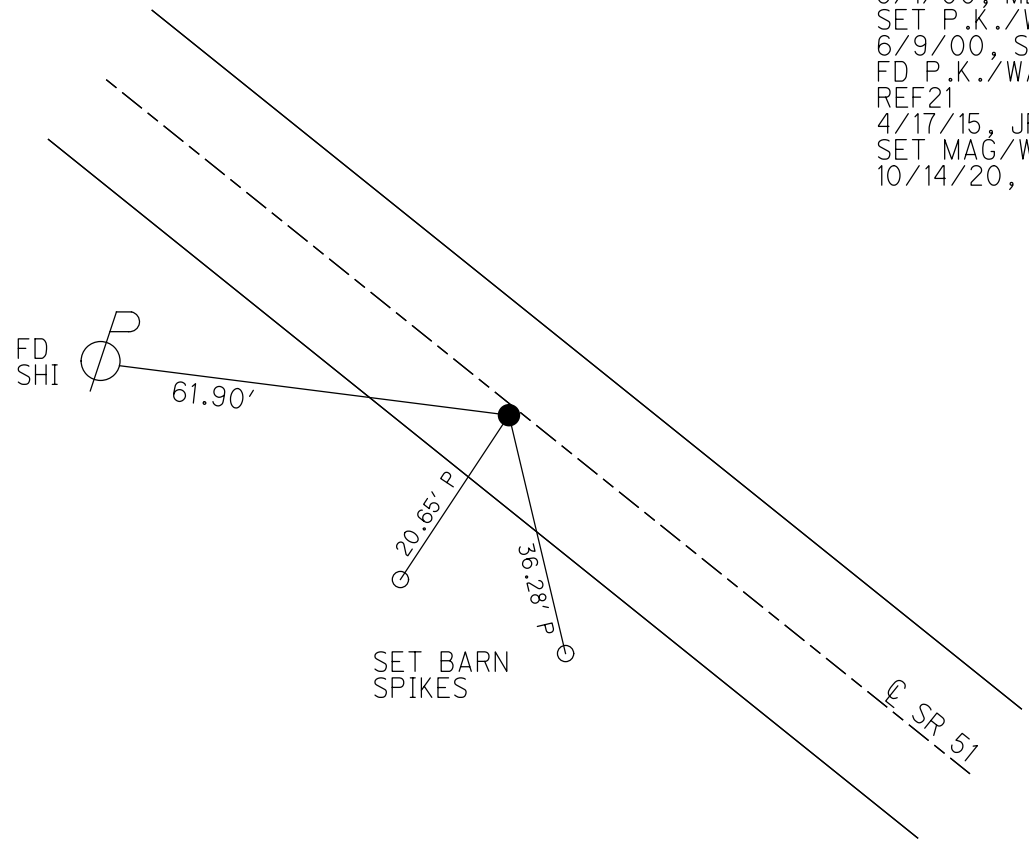

O.D.O.T. DISTRICT 2 SURVEY OFFICE (USE ONLY)

PERSONNEL _____ REFERENCE NO. 21 SHEET 15 OF 16

NOTES BARNHISEL DATE 5/1/00 ROUTE SR 51
H.C. CANTERBURY WEATHER CLOUDY COUNTY OTTAWA
R.C. MOSER TEMP. 55° TOWNSHIP CLAY
HOMAN SECTION 2
T 6 N R 13 E

TYPE MONUMENT P.K./WASHER


ON SURFACE - ~~BELOW~~ ON _____

LEFT - ☉ PAV'T - ~~RIGHT~~ 1.0'


12.1' TO LT EDGE PAVEMENT

S.L.M. 247+54.63

Grid: Northing: 673975.281 Easting: 1740212.945

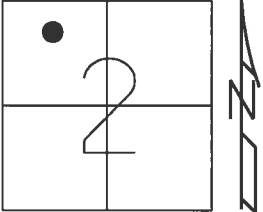

RECORD: P.I.
 $\Delta = 02^\circ 30' \text{ RT}$
P.K./WASHER ATOP
SM.R.R.SPIKE
FD P.K./WASHER
5/1/00, MB
SET P.K./WASHER
6/9/00, SAH
FD P.K./WASHER
REF21
4/17/15, JFO

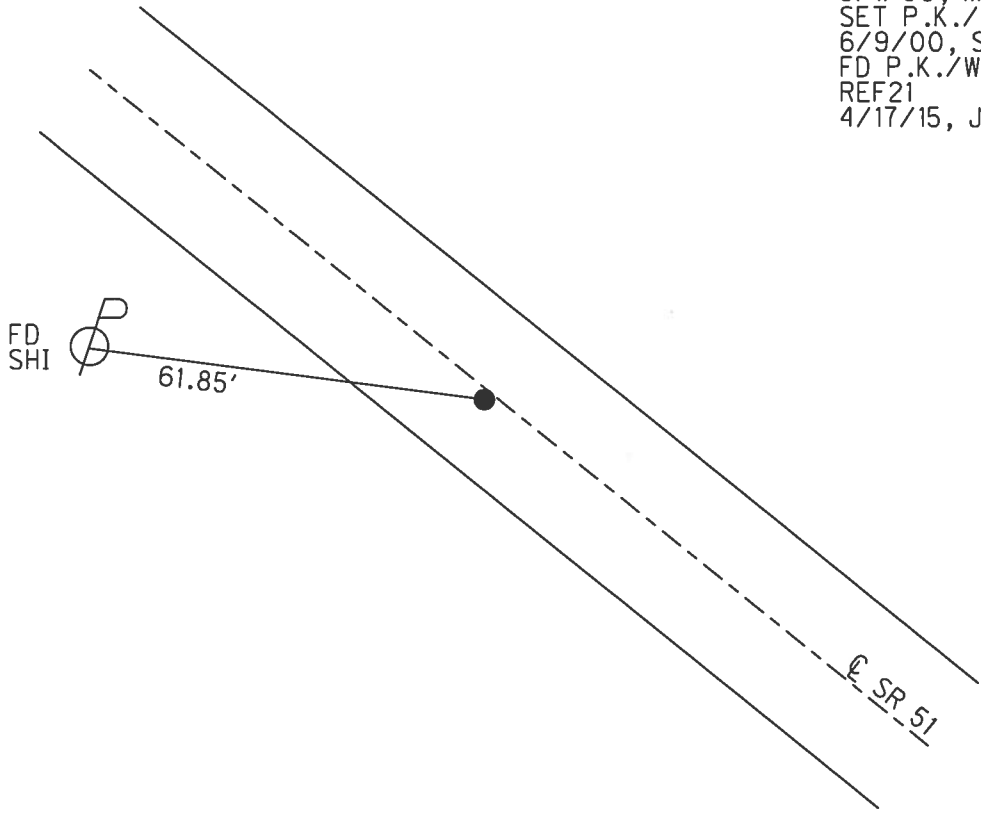

O.D.O.T. DISTRICT 2 SURVEY OFFICE

PERSONNEL

REFERENCE NO. 21

SHEET 15 OF 17

NOTES Barnhisel

H.C. Canterbury

DATE 5-1-00

ROUTE 51

R.C. Moser

WEATHER Cloudy

COUNTY Ottawa

TEMP. 55°

TOWNSHIP Clay

DRAWN BY - Homan

SECTION 2

T 6 N R 13 E


TYPE MONUMENT PK & Washer

ON SURFACE - BELOW Yes

LEFT- & PAV'T. - RIGHT 1.0


12.1 TO Lt EDGE PAVEMENT

S.L.M. 248+45

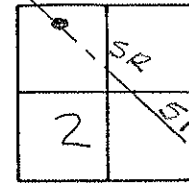

PI "Record"
 $A = 02^{\circ}30'00''$ RT
 PK & Washer over small
 RR Spike below surface

Set PK/washer
 6-9-00
 SAH

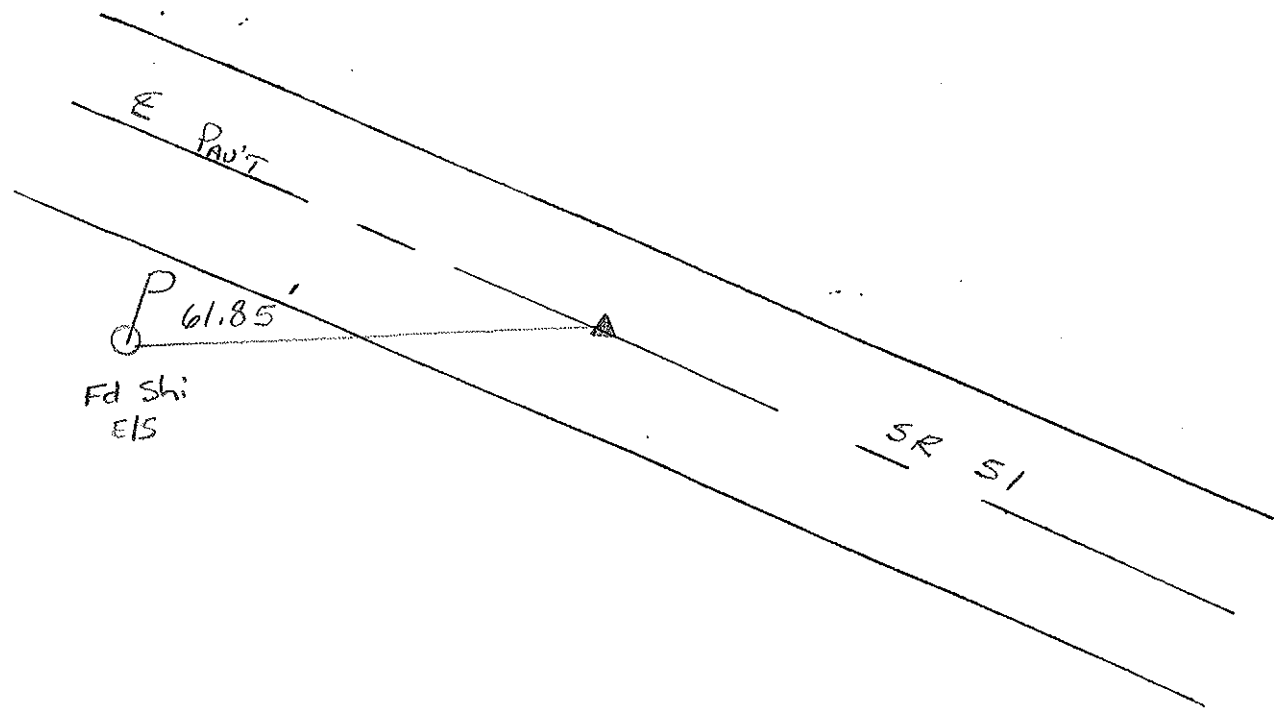

O.D.O.T. DISTRICT 2 SURVEY OFFICE

PERSONNEL _____

REFERENCE NO. 21

SHEET 20 OF _____

NOTES Cronin

H.C. Ripple

R.C. Barbour

Coyman

DATE 9/24/87

WEATHER overcast

TEMP. 66°

ROUTE 51

COUNTY Ottawa

TOWNSHIP Clay

SECTION 2

T 6 N R 13 E



TYPE MONUMENT P.K. & washer

ON SURFACE - BELOW on surface

LEFT - CL PAV'T. - RIGHT & Pavt.

TO _____ EDGE PAVEMENT

S.L.M. 247+69.98

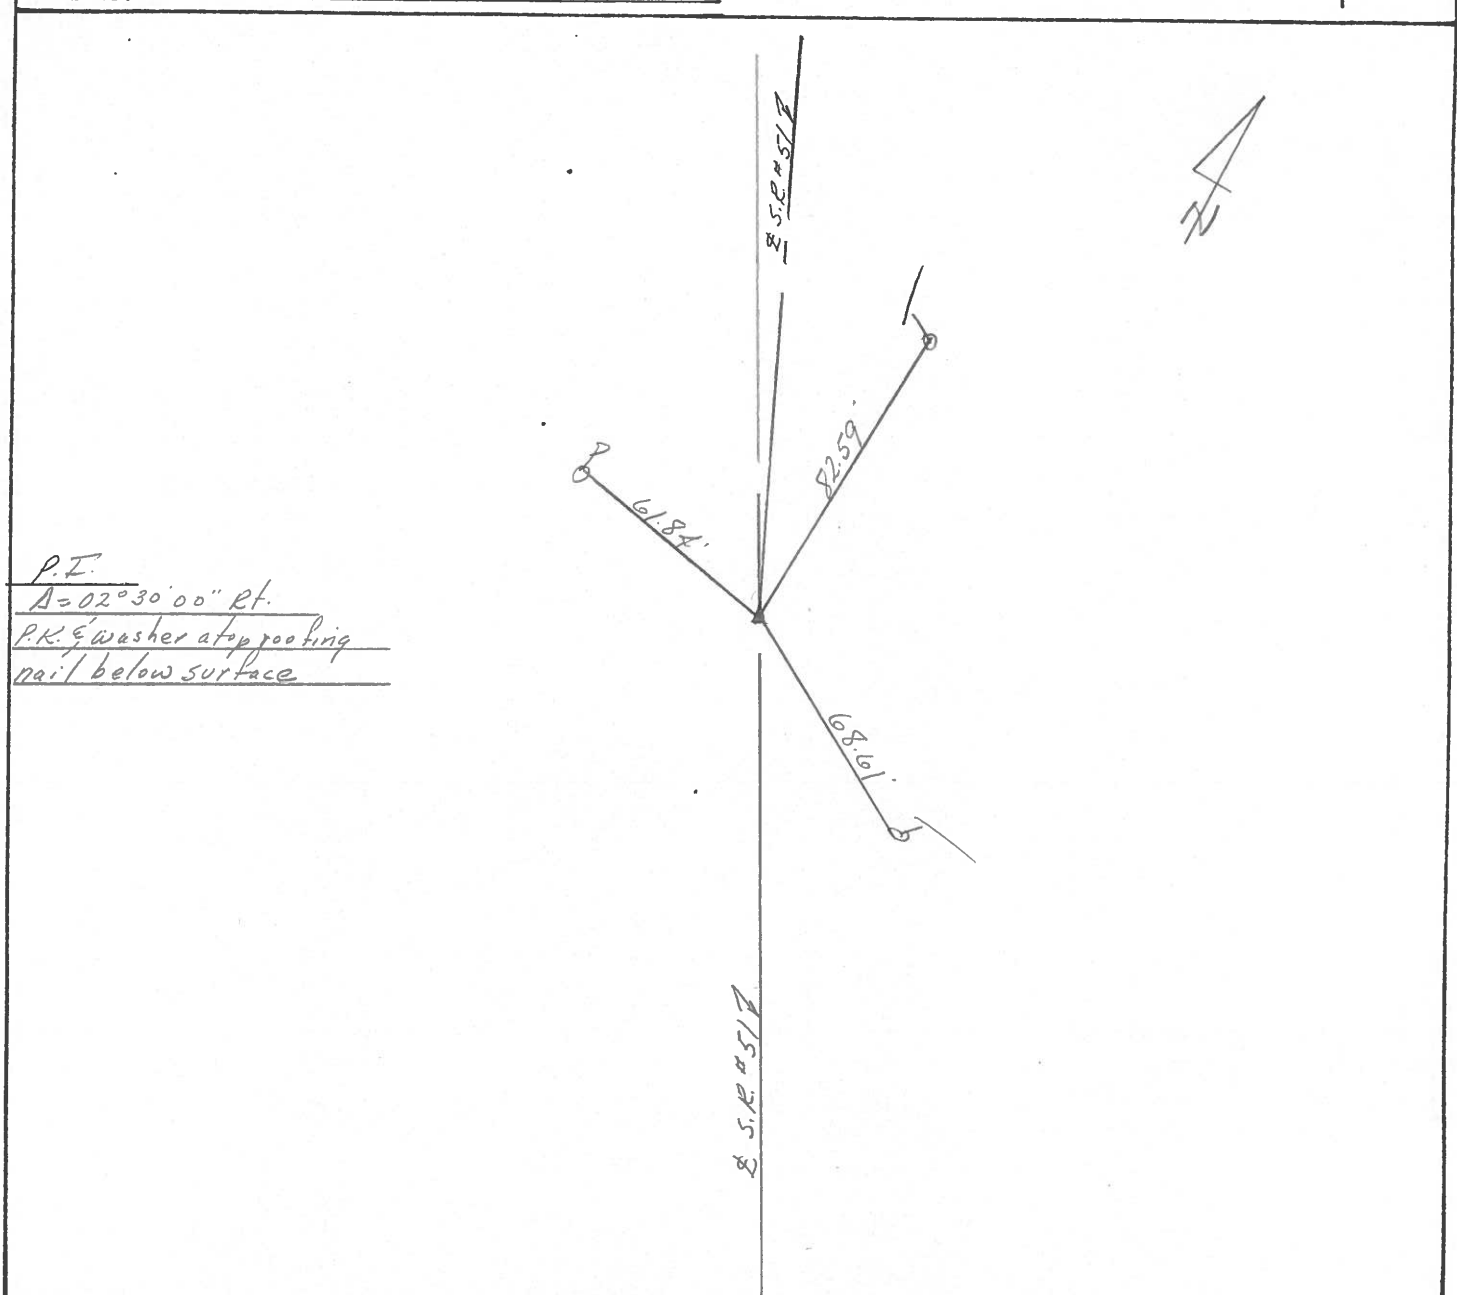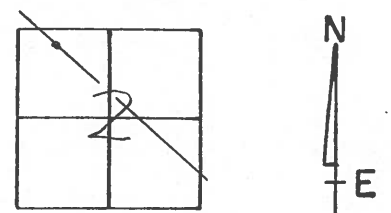

P.I.
 $\Delta = 02^{\circ}30'00''$ Rt.
P.K. & washer atop potholing
nail below surface


PERSONNEL TITLE PERSONNEL TITLE

COUNTY Ottawa DATE 1-11-72

S. R. 51 WEATHER Cloudy

SEC. 2 TEMP. 40°

DESCRIPTION Clay Twp. JOB NO. _____

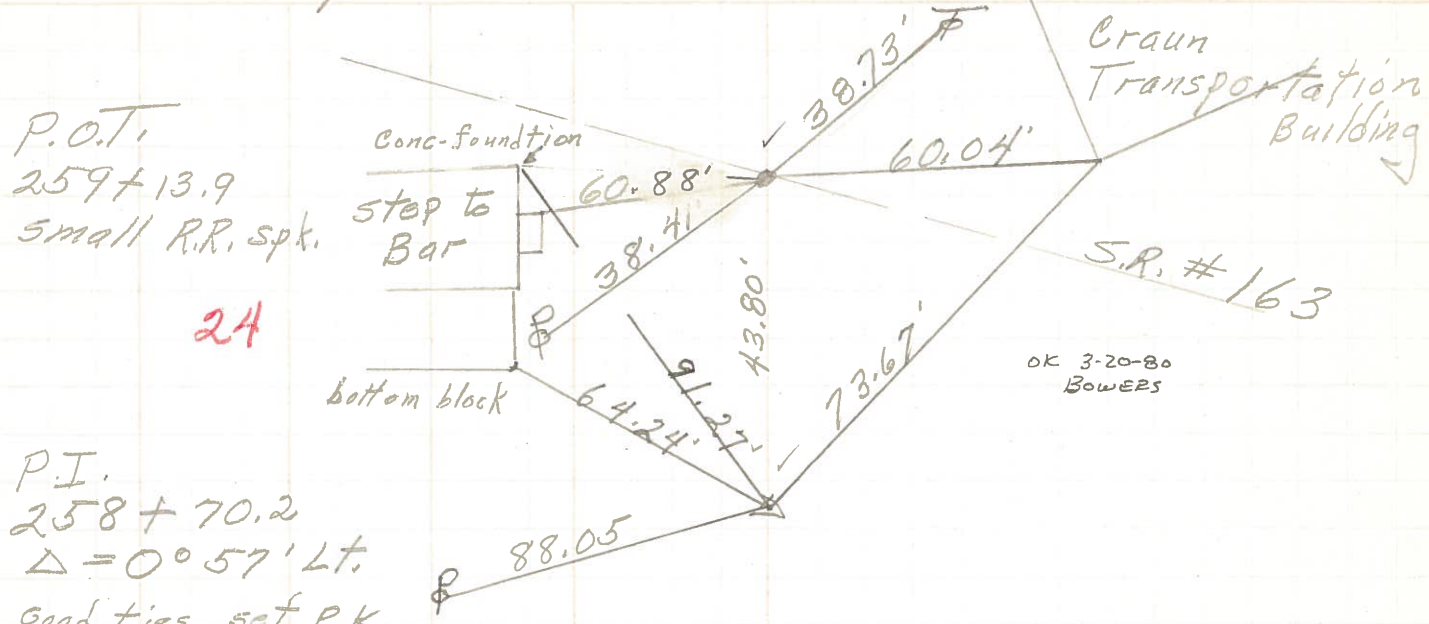


OK 3-20-80 BOWERS

P.I.
 258 + 70.2
 $\Delta = 0^\circ 57' \text{ Lt.}$
 Good ties set P.K.
 set P.K. Nail

23

P.I.
 250 + 70.1
 $\Delta = 1^\circ 52' \text{ Rt.}$
 set P.K. Nail
 Measured & turned angle

22

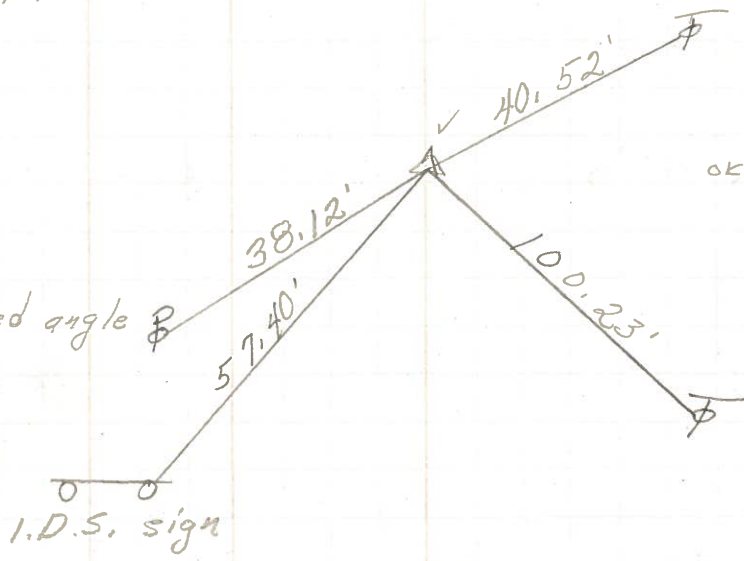

OK 3-20-80 BOWERS

P.I.
 247 + 69.90
 $\Delta = 2^\circ 30' \text{ Rt.}$
 Fd. Roofing Nail
 1/4" down

21.

