



O.D.O.T. DISTRICT 2 SURVEY OFFICE (USE ONLY)

PERSONNEL _____ REFERENCE NO. 27 SHEET 5 OF 21
 NOTES RHOADES DATE 4/5/16 ROUTE SR 51
 H.C. FARKAS WEATHER CLEAR COUNTY OTTAWA
 R.C. HOMAN TEMP. 25° TOWNSHIP CLAY
 _____ SECTION 34
 _____ T 7 N R 13 E

TYPE MONUMENT P.K./WASHER
 ON SURFACE - ~~BELOW~~ ON _____
 LEFT - ☉ PAV'T - ~~RIGHT~~ 0.8'
 _____ TO _____ EDGE PAVEMENT
 S.L.M. 297+89
 Grid: Northing: 677395.520 Easting: 1736642.637

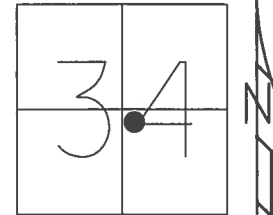


RECORD: P.I.
 $\Delta = 0^\circ 04'$
 297+16.7
 FD SM.R.R.SPIKE
 FD P.K./WASHER
 4" DOWN
 5/14/02, MB
 SET P.K./WASHER
 7/29/02, MB
 FD P.K./WASHER
 REF27
 2/16/16, JFO
 SET MAG/WASHER
 NEWREF27
 5/31/17, JFO

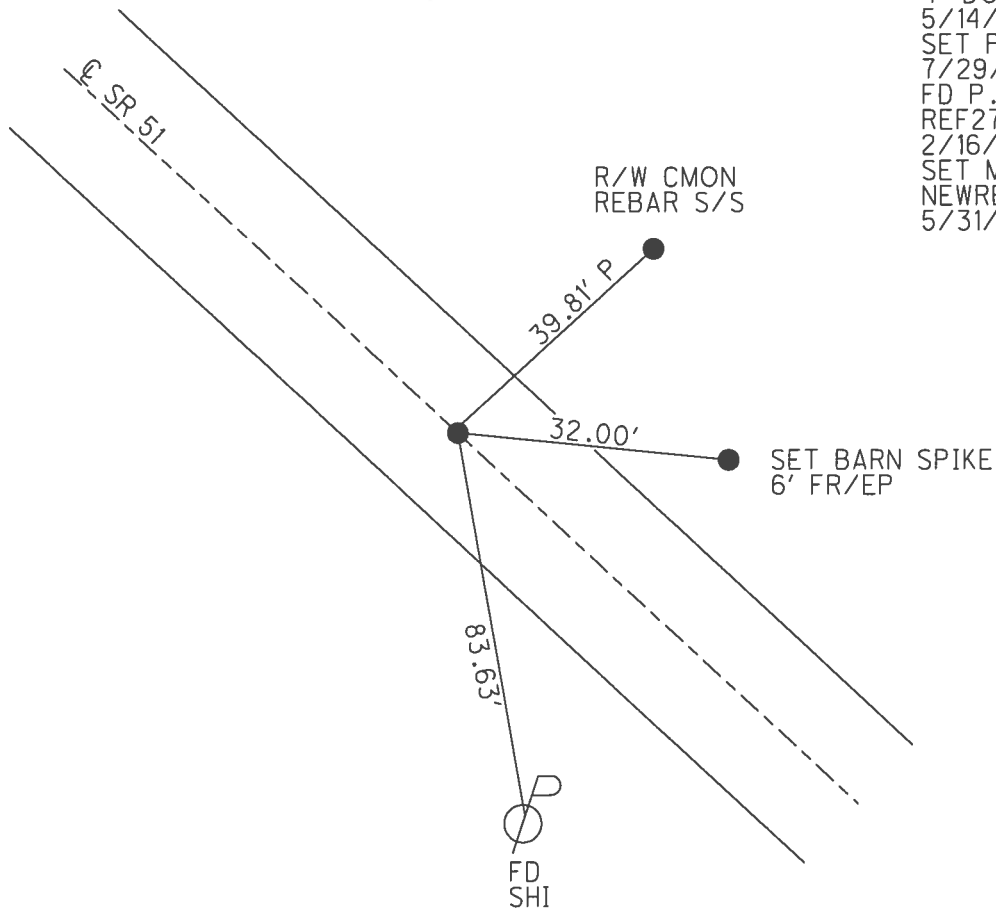

O.D.O.T. DISTRICT 2 SURVEY OFFICE (USE ONLY)


PERSONNEL _____ REFERENCE NO. 27 SHEET 5 OF 21
 NOTES MOSE DATE 5/14/02 ROUTE SR 51
 H.C. BARNHISEL WEATHER PTLY CLOUDY COUNTY OTTAWA
 R.C. LOEHRKE TEMP. 55° TOWNSHIP CLAY
HOFFMAN SECTION 34
 T 7 N R 13 E

TYPE MONUMENT P.K./WASHER
 ON SURFACE - BELOW 4"
 LEFT - ☉ PAV'T - RIGHT ON
- TO - EDGE PAVEMENT
 S.L.M. 297+89

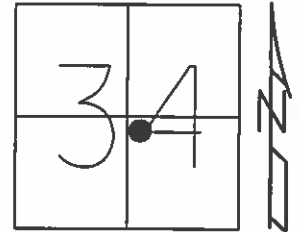

Grid: Northing: - Easting: -

RECORD: P.I.
 $\Delta = 00^\circ 04'$
 297+16.7
 SM.R.R.SPIKE
 SET P.K./WASHER
 7/29/02, MB

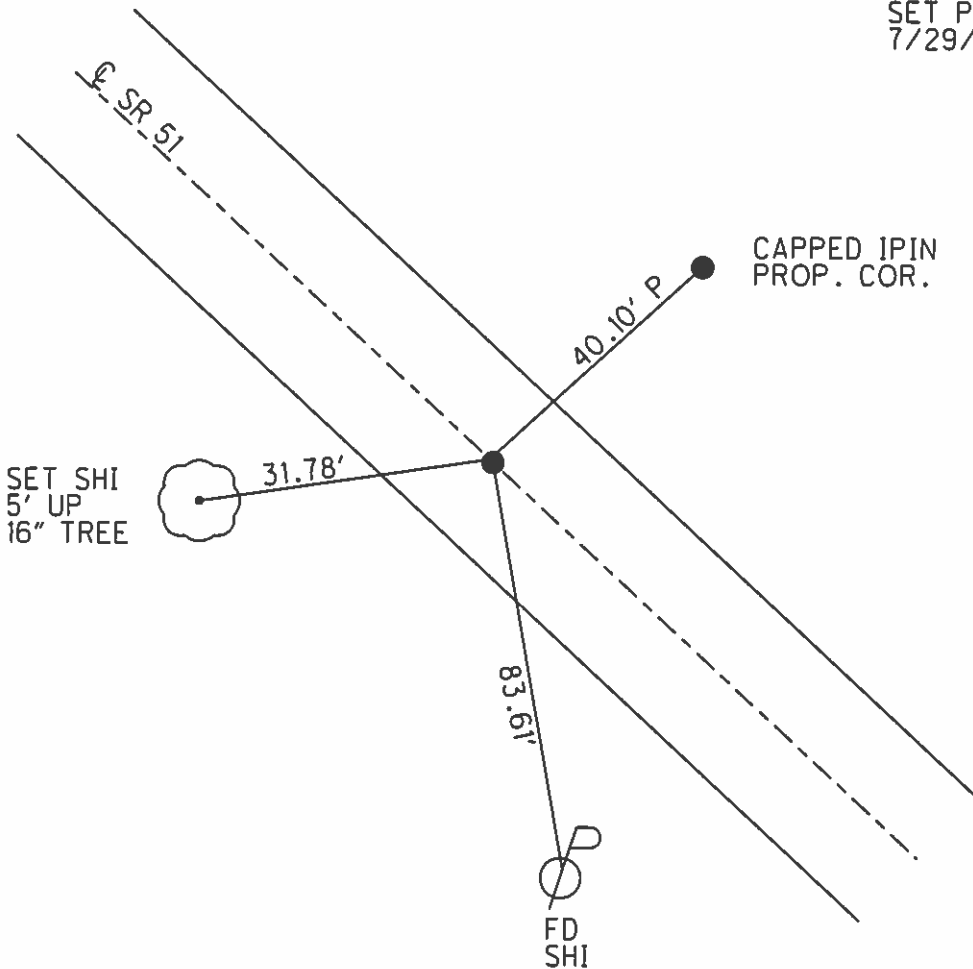

PERSONNEL	TITLE	PERSONNEL	TITLE


COUNTY Ottawa DATE 1-11-72
 S. R. 51 WEATHER Fair
 SEC. 34 & 35 TEMP. 40°

DESCRIPTION Clay Twp. JOB NO. _____

LEFT CENTER LINE RIGHT

P.I.
 297+16.7
 small spk.
 $\Delta = 0^\circ 04' \text{ Rt}$

27

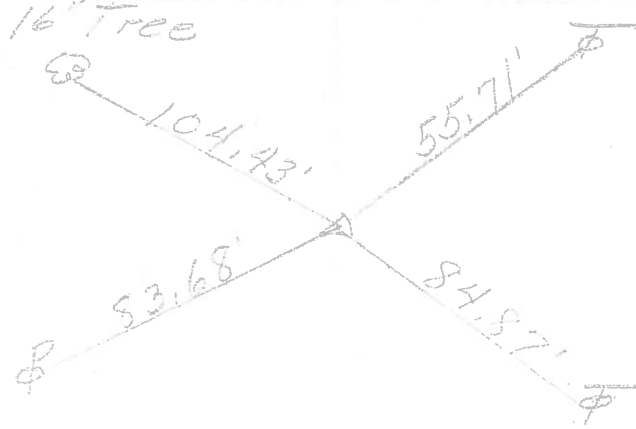


2-spry Kaps
 15" down

Well base

P.I.
 287+55.03
 $\Delta = 0^\circ 11' \text{ Lt}$
 287+34.43

26

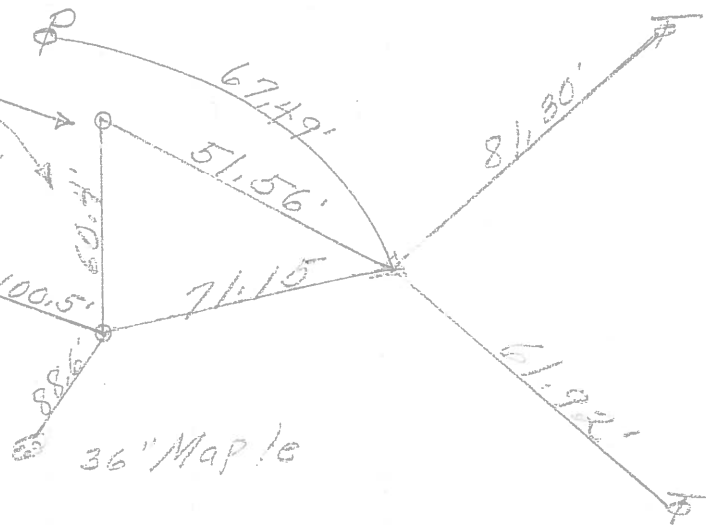

P.I.
 269+37.15
 $\Delta = 0^\circ 38' \text{ Lt}$
 P.K. Nail

P.O.T. 269+18.0
 N. & S.

25

