



O.D.O.T. DISTRICT 2 SURVEY OFFICE (USE ONLY)

PERSONNEL _____ REFERENCE NO. 28 SHEET 6 OF 21
 NOTES RHOADES DATE 4/5/16 ROUTE SR 51
 H.C. FARKAS WEATHER CLEAR COUNTY OTTAWA
 R.C. HOMAN TEMP. 26° TOWNSHIP CLAY
 _____ SECTION 34
 _____ T 7 N R 13 E

TYPE MONUMENT P.K.NAIL
 ON SURFACE - ~~BELOW~~ ON
 LEFT - ☉ PAV'T - RIGHT ON
- TO - EDGE PAVEMENT
 S.L.M. 308+80
 Grid: Northing: 678141.995 Easting: 1735847.236

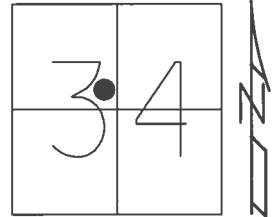


RECORD: P.I.
 $\Delta = 0^\circ 35' \text{ LT}$
 308+07.20
 SET P.K.NAIL
 1/12/72
 FD P.K./WASHER
 5/14/02, MB
 SET P.K./WASHER
 7/29/02, MB
 FD P.K./WASHER
 REF28
 2/16/16, JFO
 SET MAG/WASHER
 NEWREF28
 6/2/17, JFO

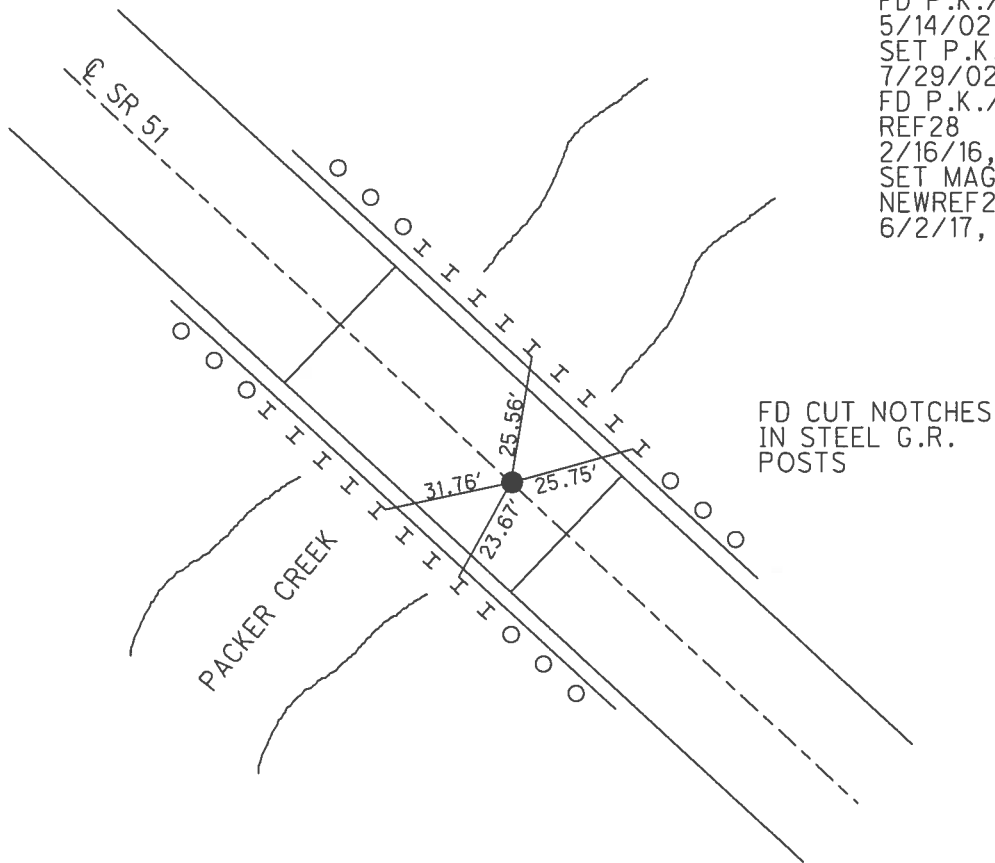


O.D.O.T. DISTRICT 2 SURVEY OFFICE (USE ONLY)

PERSONNEL _____ REFERENCE NO. 28 SHEET 6 OF 21
 NOTES MOSER DATE 5/14/02 ROUTE SR 51
 H.C. BARNHISEL WEATHER PTLY CLOUDY COUNTY OTTAWA
 R.C. LOEHRKE TEMP. 55° TOWNSHIP CLAY
HOFFMAN SECTION 34
 T 7 N R 13 E

TYPE MONUMENT P.K.NAIL
 ON SURFACE - ~~BELOW~~ ON _____
 LEFT - ☉ PAV'T - RIGHT ON _____
 - TO - EDGE PAVEMENT
 S.L.M. 308+80
 Grid: Northing: _____ Easting: _____

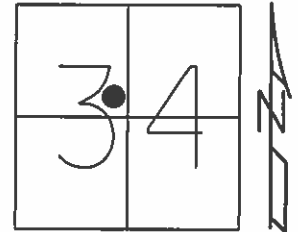


RECORD: P.I.
 $\Delta = 00^{\circ} 35' \text{ LT}$
 308+07.20
 SET P.K.NAIL
 1/12/72

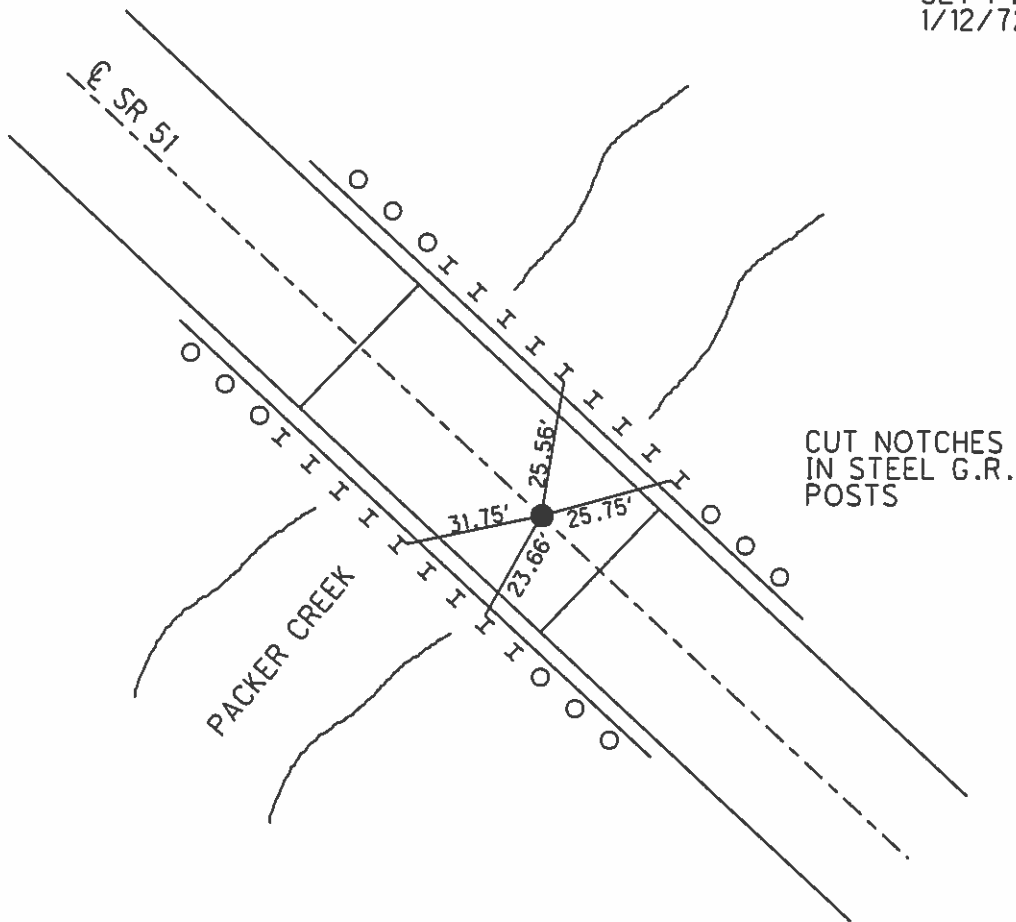

PERSONNEL	TITLE	PERSONNEL	TITLE	COUNTY	DATE	WEATHER	TEMP.
RIPPLE				OTTAWA	12/15/86	SUNNY	34°
BARBOUR				S. R. #51			
GEYMAN				SEC. 34			


DESCRIPTION LEFT CENTER LINE RIGHT JOB NO.

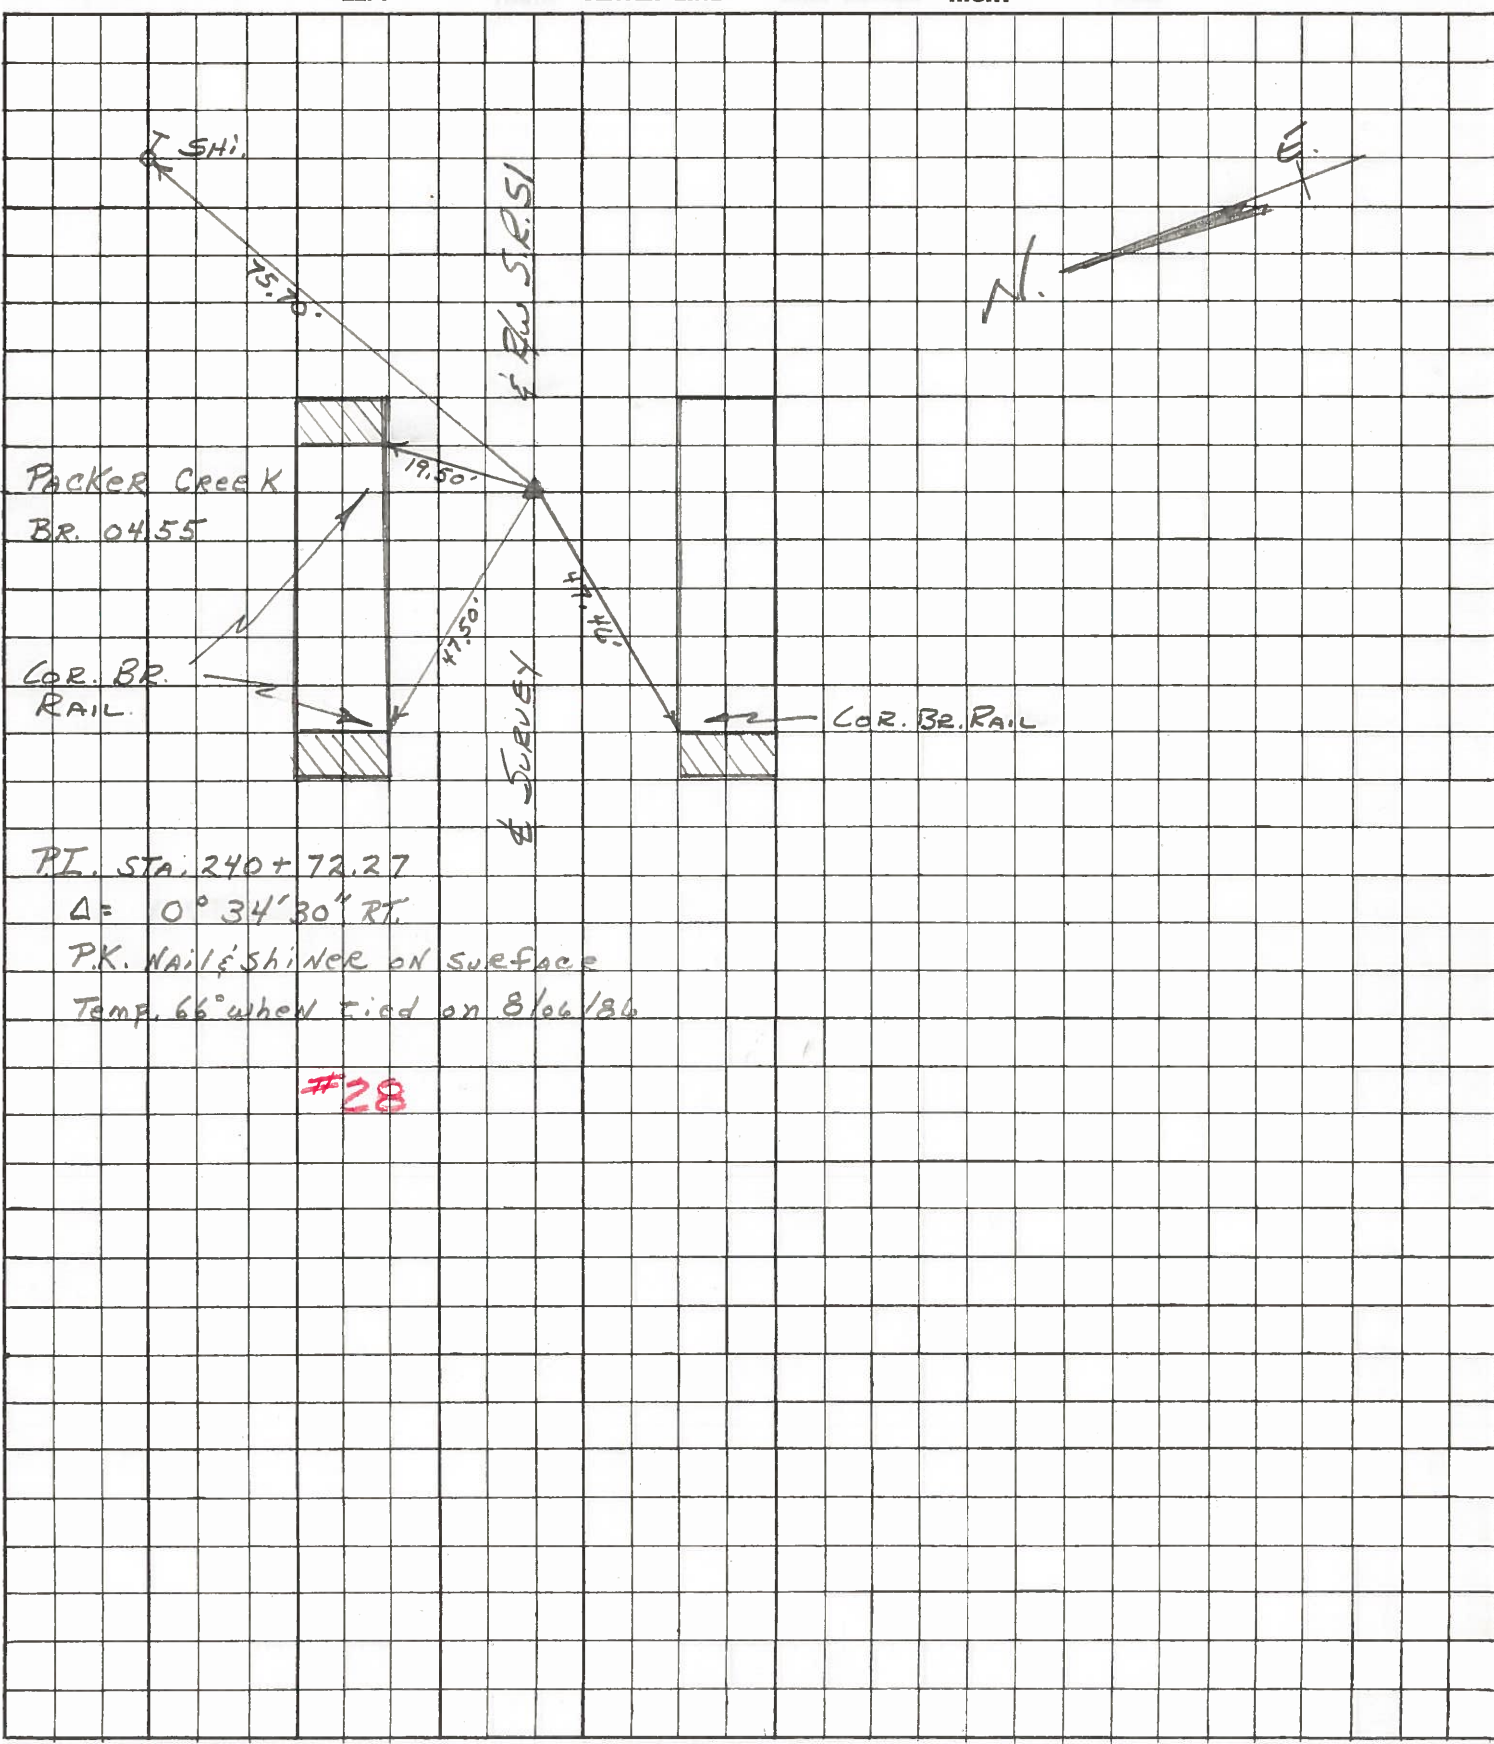

PERSONNEL	TITLE	PERSONNEL	TITLE
_____	_____	_____	_____
COUNTY <u>Ottawa</u>		DATE <u>1-12-72</u>	
S. R. <u>51</u>		WEATHER <u>Fair</u>	
SEC. <u>27 & 34</u>		TEMP. <u>40°</u>	
DESCRIPTION <u>Clay Twp.</u>			JOB NO. _____
LEFT	CENTER LINE		RIGHT

P.I.
 333+82.5
 $\Delta = 0^{\circ}02' \text{ Rt.}$
 P.K. Nail


30

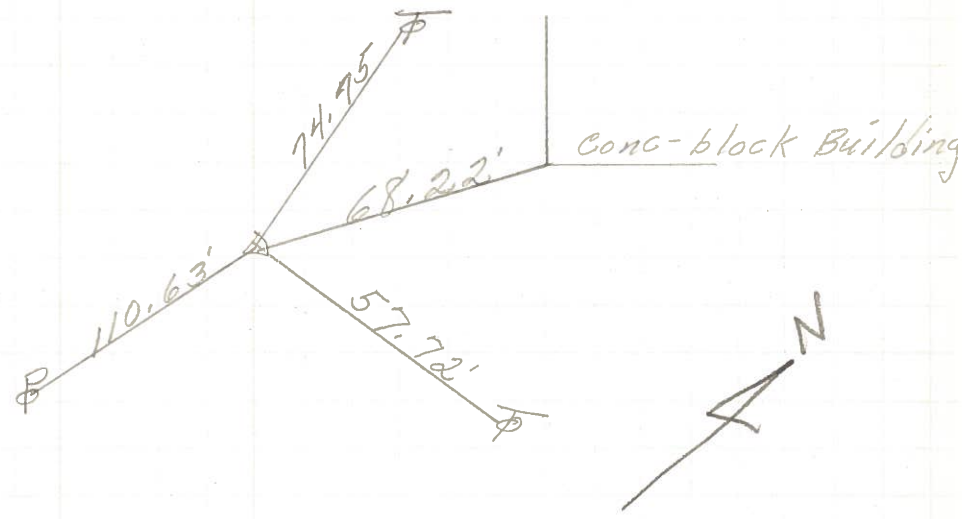

P.I.
 321+80.7
 Small R.R. spk.
 $\Delta = 0^{\circ}27' \text{ Rt.}$


29

1 story Res.

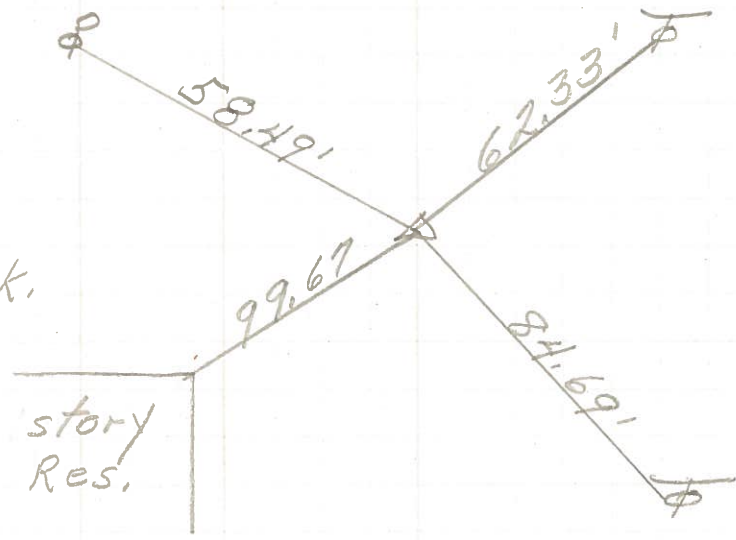

P.I.
 308+07.20
 $\Delta = 0^{\circ}35' \text{ Lt.}$
 Good ties set P.K.

28.

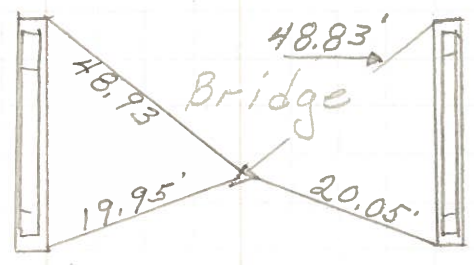

Packer Creek