



O.D.O.T. DISTRICT 2 SURVEY OFFICE (USE ONLY)

PERSONNEL	REFERENCE NO.	33	SHEET	10	OF	21
NOTES	RHOADES	DATE	4/5/16	ROUTE	SR 51	
H.C.	FARKAS	WEATHER	CLOUDY	COUNTY	OTTAWA	
R.C.	HOMAN	TEMP.	30°	TOWNSHIP	CLAY	
				SECTION	28	
				T	7	N
				R	13	E

TYPE MONUMENT P.K.NAIL, BENT  
~~ON SURFACE~~ - BELOW 3"  
~~LEFT~~ - C PAV'T - RIGHT 7.4'  
9.6' TO RT EDGE PAVEMENT  
 S.L.M. 348+56  
 Grid: Northing: 680843.721 Easting: 1732934.011

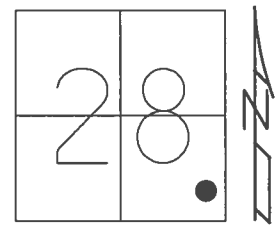

RECORD: P.I.  
 $\Delta = 0^\circ 45' 50''$  RT  
 200+99.23  
 FD P.K.NAIL  
 12/15/86, RIPPLE  
 FD P.K.SHANK  
 5/15/02, MB  
 SET P.K./WASHER  
 7/29/02, MB  
 FD P.K.NAIL, BENT  
 3" DOWN  
 REF33  
 4/5/16, JFO  
 SET MAG/WASHER  
 NEWREF33  
 6/1/17, JFO

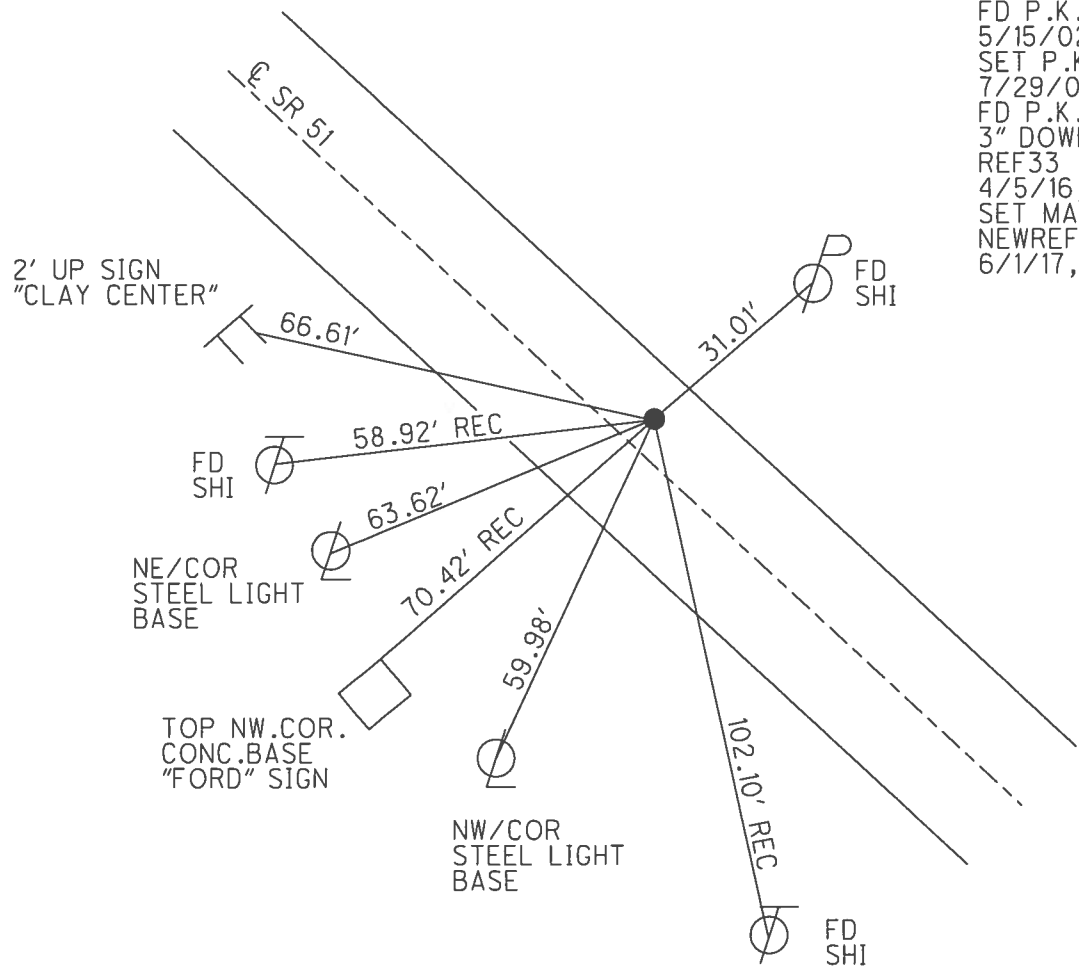

O.D.O.T. DISTRICT 2 SURVEY OFFICE (USE ONLY)

PERSONNEL	REFERENCE NO.	<u>33</u>	SHEET	<u>10</u>	OF	<u>21</u>	
NOTES	<u>MOSER</u>	DATE	<u>5/15/02</u>	ROUTE	<u>SR 51</u>		
H.C.	<u>BARNHISEL</u>	WEATHER	<u>SUNNY</u>	COUNTY	<u>OTTAWA</u>		
R.C.	<u>LOEHRKE</u>	TEMP.	<u>70°</u>	TOWNSHIP	<u>CLAY</u>		
	<u>HOFFMAN</u>			SECTION	<u>28</u>		
				T	<u>7</u>	R	<u>13</u>
				E			

TYPE MONUMENT P.K.SHANK


~~ON SURFACE~~ - BELOW 1"

~~LEFT~~ - CL PAV'T - RIGHT 7.4'

9.6' TO RT EDGE PAVEMENT

S.L.M. 348+56


Grid: Northing: - Easting: -

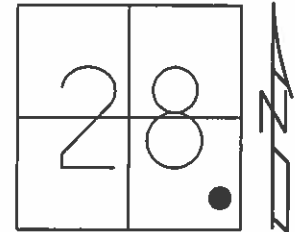

RECORD: P.I.  
 $\Delta = 00^\circ 45' 50''$  RT  
 200+99.23

FD P.K./SHI  
 ON SURFACE  
 12/15/86, RIPPLE


SET P.K./WASHER  
 7/29/02, MB

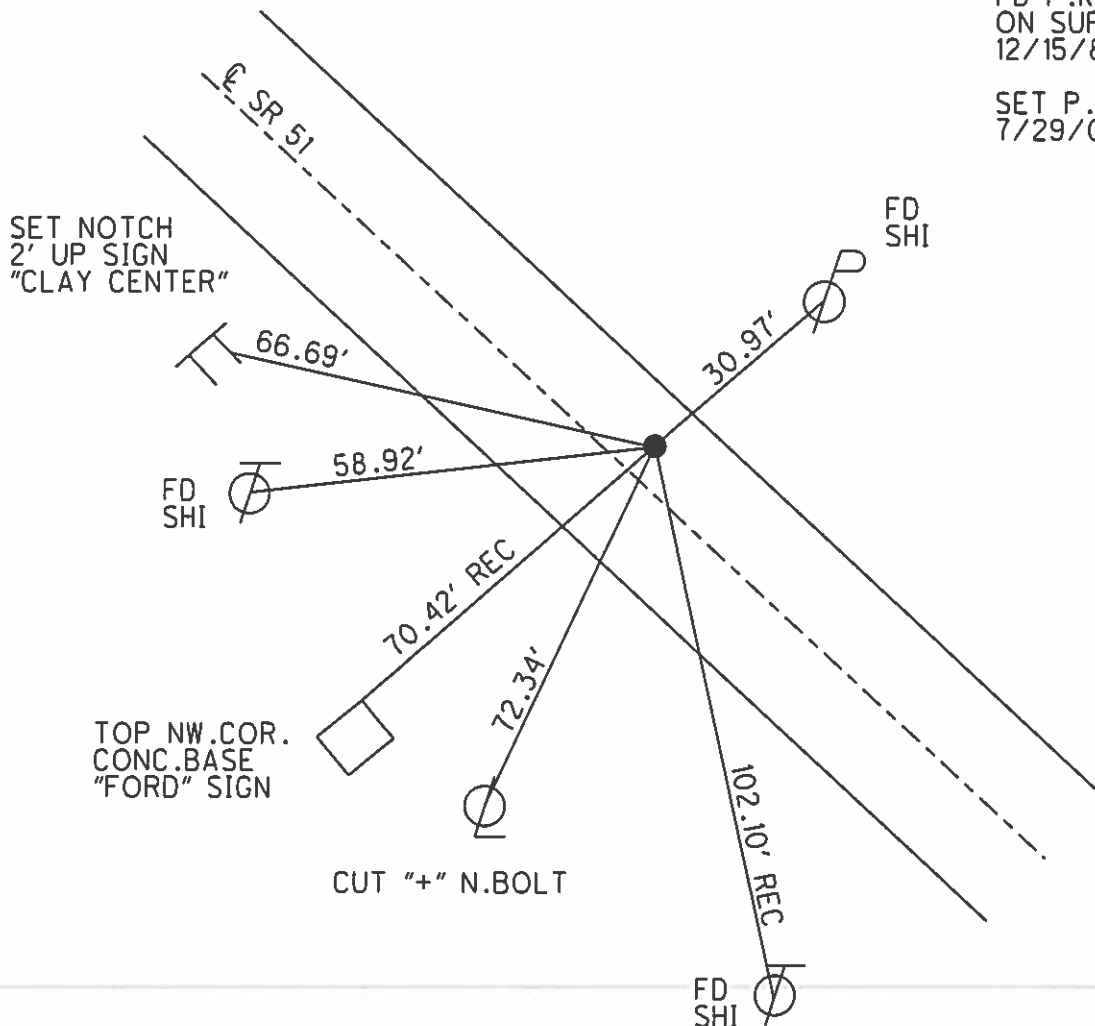

PERSONNEL	TITLE	PERSONNEL	TITLE
RIPPLE			
BARBOUR			
GEYMAN			

COUNTY OTTAWA DATE 12/15/86  
 S. R. #51 WEATHER SUNNY  
 SEC. ~~27~~ 28 TEMP. 34°


DESCRIPTION \_\_\_\_\_ LEFT \_\_\_\_\_ CENTER LINE \_\_\_\_\_ RIGHT \_\_\_\_\_ JOB NO. \_\_\_\_\_

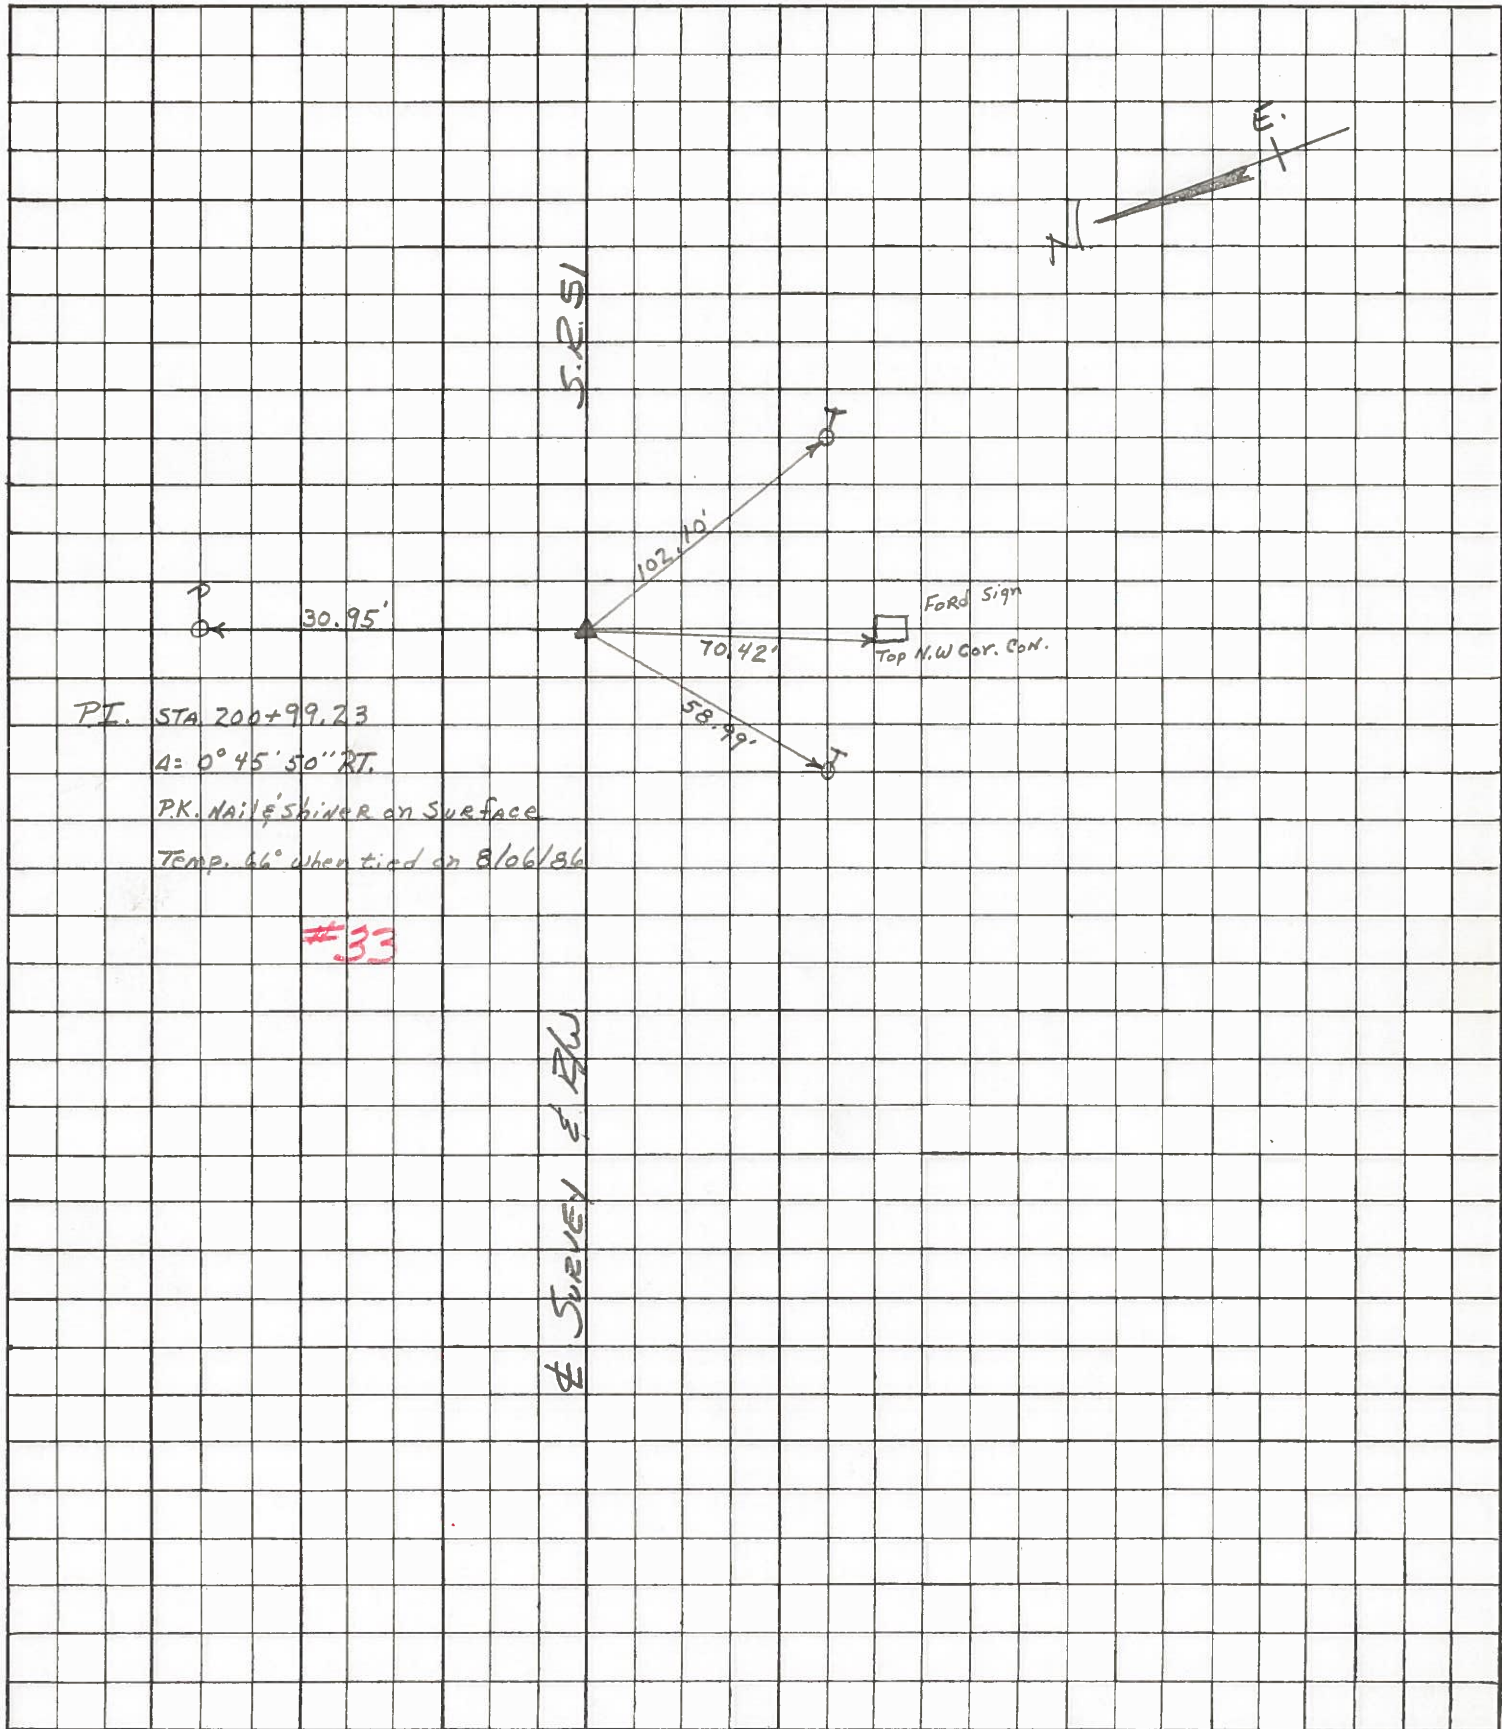

PERSONNEL	TITLE	PERSONNEL	TITLE	COUNTY	DATE
				Ottawa	1-12-72
				S. R. 51	WEATHER Fair
				SEC. 27 & 28	TEMP. 40°
DESCRIPTION <u>Clay Temp.</u>					JOB NO.
	LEFT	CENTER LINE	RIGHT		

SEE New TIES


P.I.  
347+81.22  
R.R. spk.  
Rt. of  $\mathcal{L}$   
 $\Delta = 0^\circ 52' Lt.$

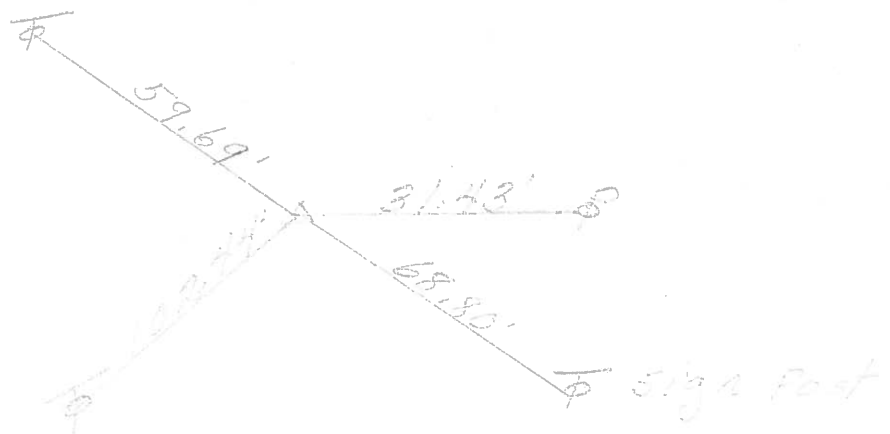

33.


SEE New TIES

P.I.  
341+18.0  
R.R. spk.  
Rt. of  $\mathcal{L}$   
 $\Delta = 0^\circ 26' Lt.$   
207+29.54

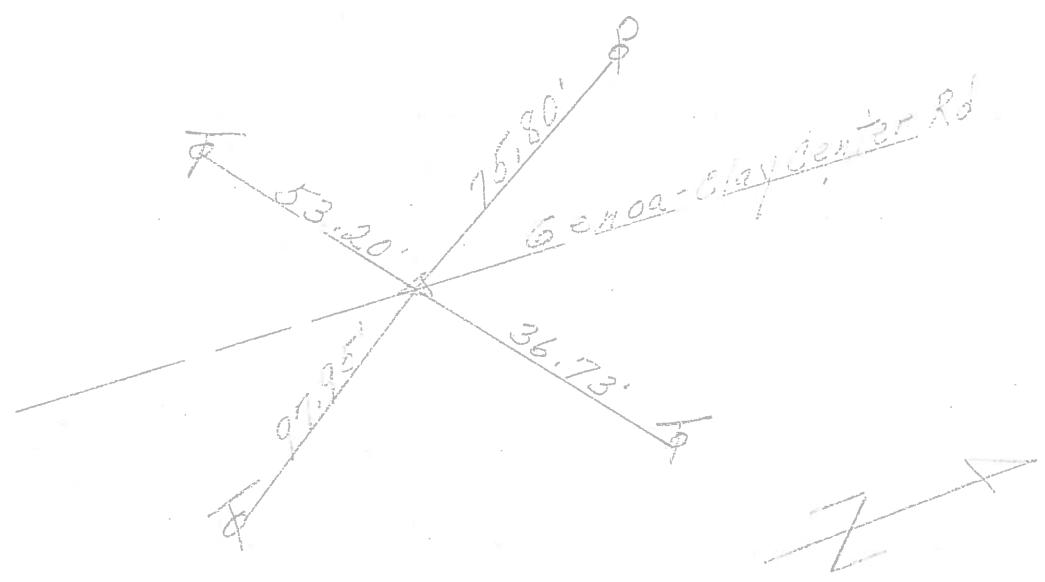

32

P.O.T.  
336+96.3  
Small R.R. spk.  
2' Rt. of  $\mathcal{L}$   
211+48.70

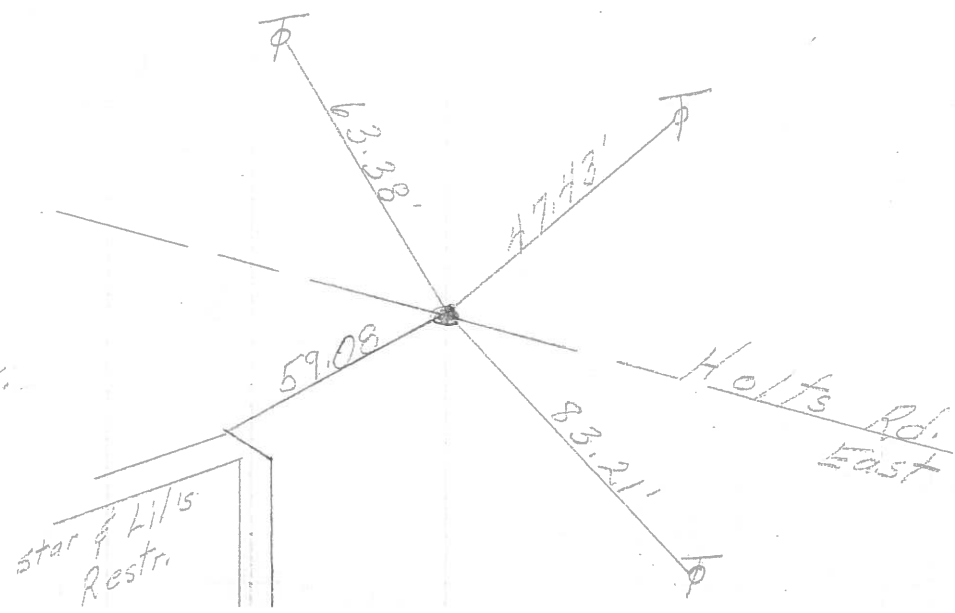

31

PERSONNEL TITLE PERSONNEL TITLE

COUNTY Ottawa DATE 6-20-68

Schneider \_\_\_\_\_

S. R. 51 WEATHER Fair

Mosser \_\_\_\_\_

SEC. Wood Co. Line-East TEMP. 75°

Barbour \_\_\_\_\_


Redding \_\_\_\_\_

DESCRIPTION Ties for Control Points JOB NO. \_\_\_\_\_

LEFT

CENTER LINE

RIGHT

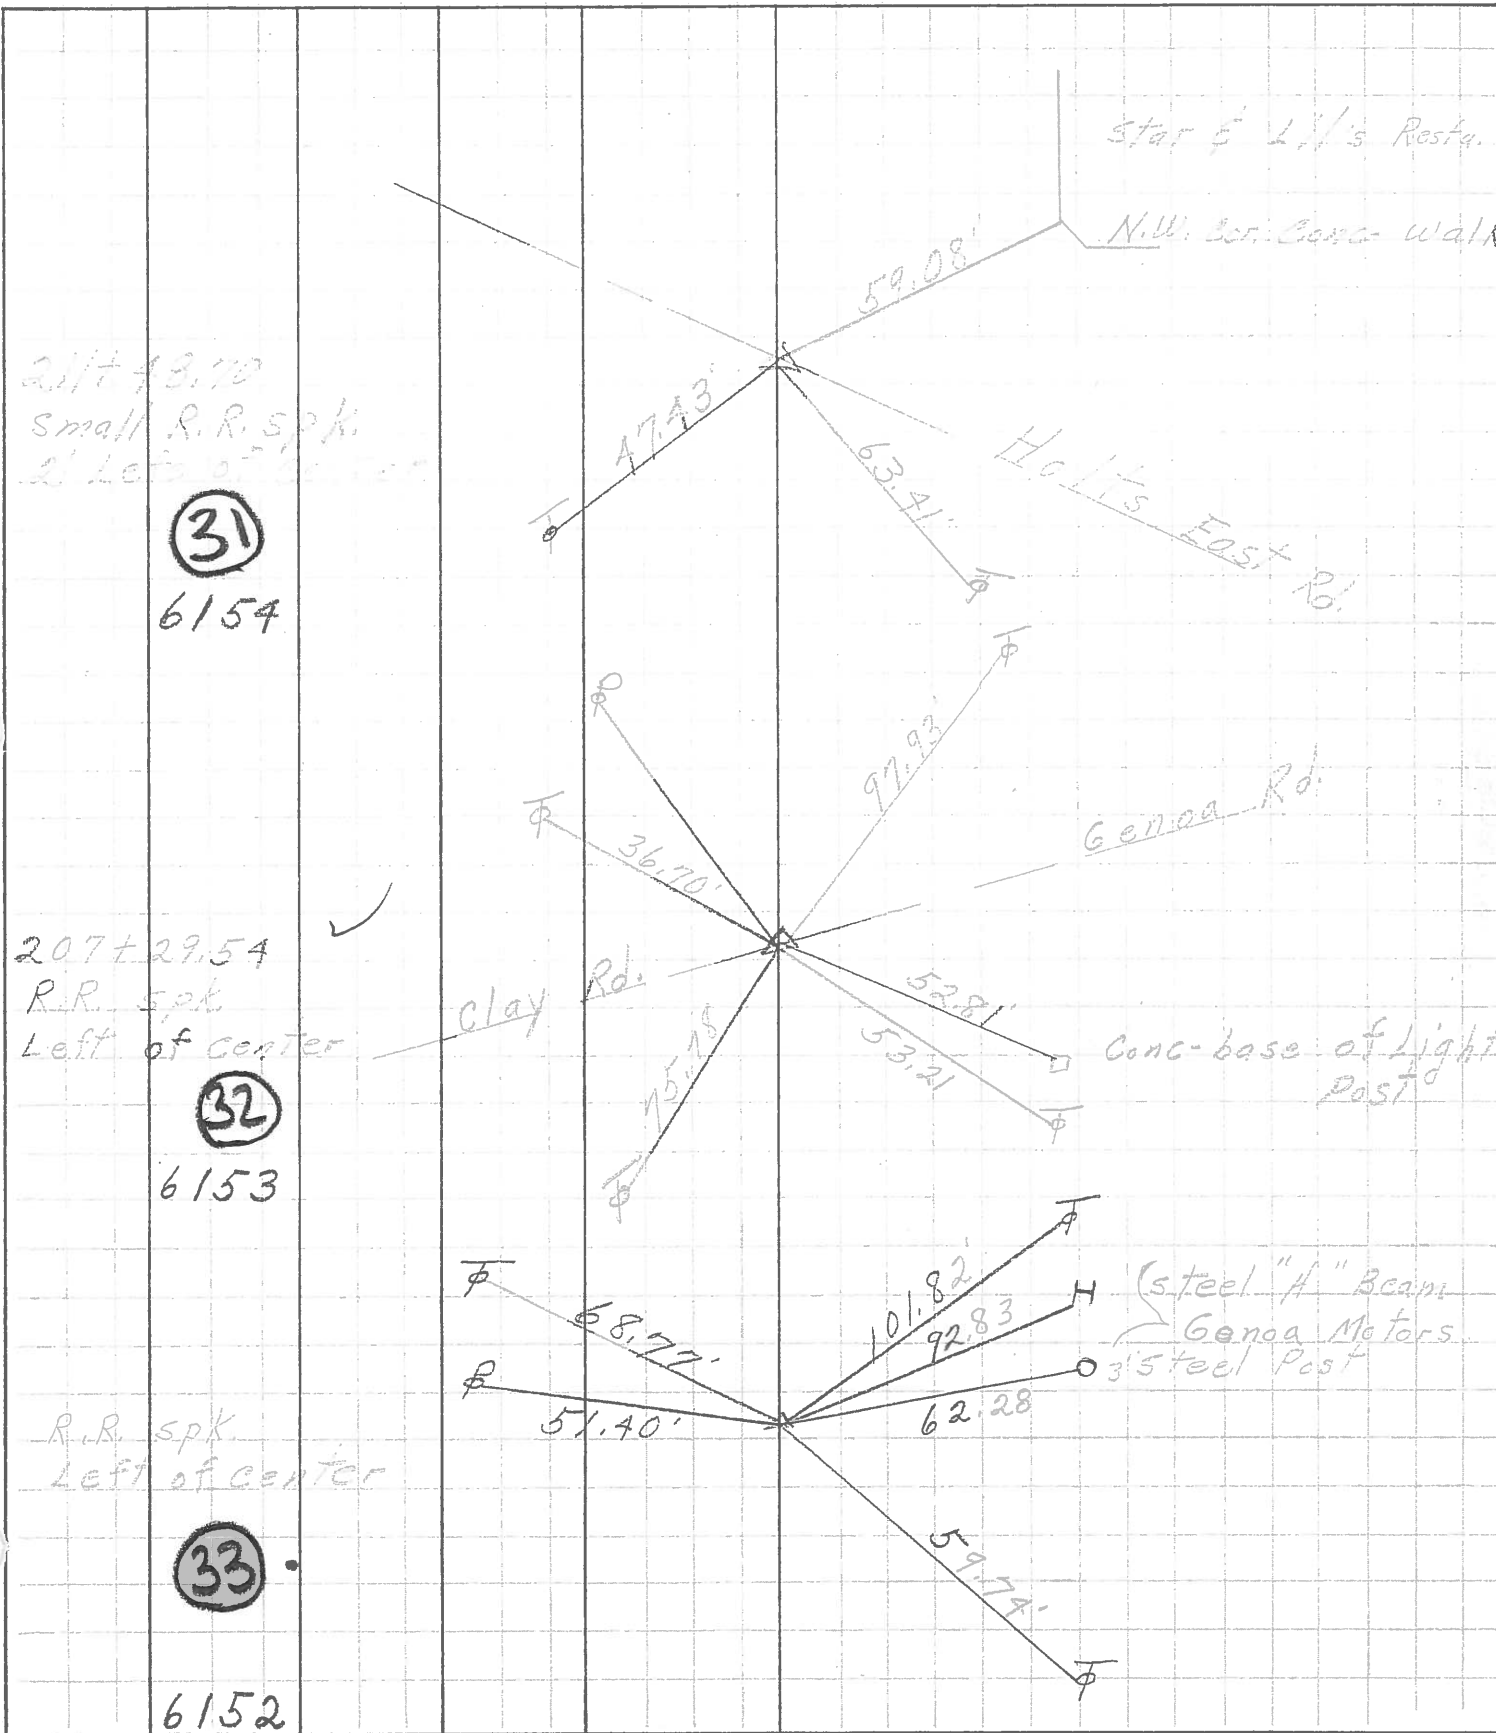

211 + 43.70  
Small R.R. Spk.  
Left of center

31

6154

207 + 29.54  
R.R. Spk  
Left of center

32

6153

R.R. Spk  
Left of center

33

6152