


O.D.O.T. DISTRICT 2 SURVEY OFFICE (USE ONLY)


PERSONNEL \_\_\_\_\_ REFERENCE NO. 34 SHEET 11 OF 21  
 NOTES RHOADES DATE 4/5/16 ROUTE SR 51  
 H.C. FARKAS WEATHER CLOUDY COUNTY OTTAWA  
 R.C. HOMAN TEMP. 30° TOWNSHIP CLAY  
 \_\_\_\_\_ SECTION 28  
 \_\_\_\_\_ T 7 N R 13 E

TYPE MONUMENT P.K./WASHER  
 ON SURFACE - ~~BELOW~~ ON \_\_\_\_\_  
~~LEFT~~ - C PAV'T - RIGHT 8.1'  
10.2' TO RT EDGE PAVEMENT  
 S.L.M. 371+90

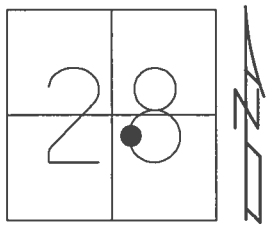

Grid: Northing: 682399.931 Easting: 1731199.265

RECORD: P.I.  
 $\Delta = 0^{\circ}0'30''$  LT  
 371+12.47  
 FD R.R.SPIKE  
 SET P.K.NAIL  
 1/19/72  
 FD P.K.NAIL  
 2" DOWN  
 5/15/02, MB  
 SET P.K./WASHER  
 7/29/02, MB  
 FD P.K./WASHER  
 REF34  
 2/16/16, JFO  
 SET MAG/WASHER  
 NEWREF34  
 6/1/17, JFO

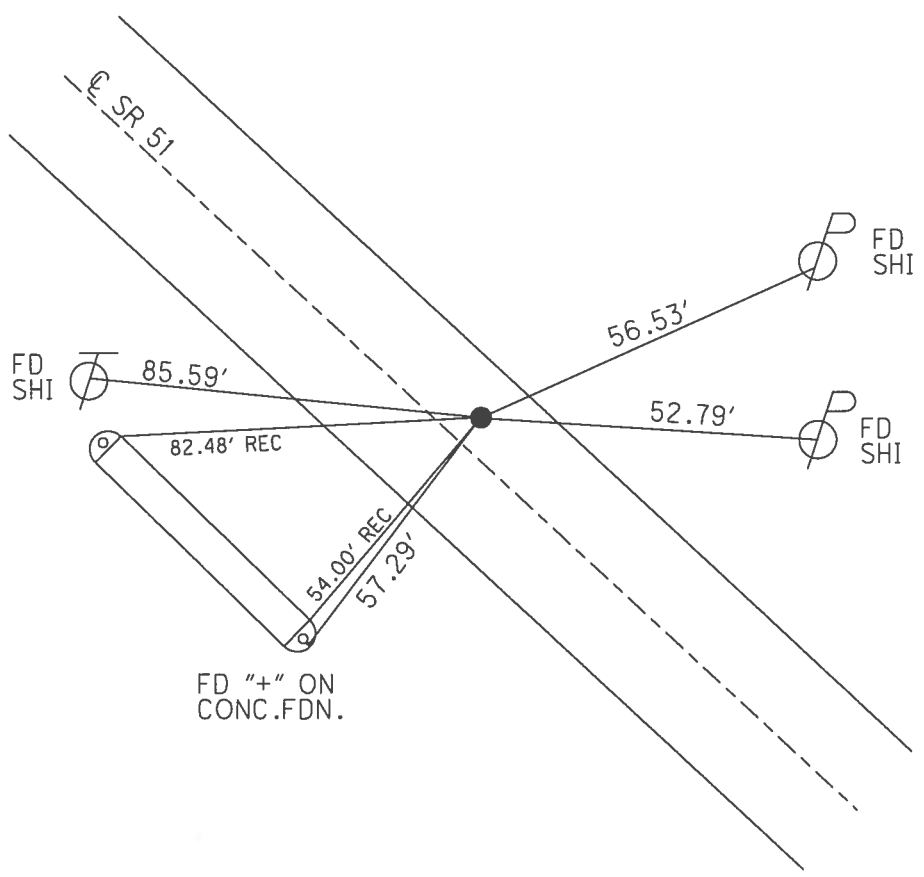


FD "+" ON  
 CONC.FDN.

O.D.O.T. DISTRICT 2 SURVEY OFFICE (USE ONLY)

|           |                  |           |                |           |               |           |
|-----------|------------------|-----------|----------------|-----------|---------------|-----------|
| PERSONNEL | REFERENCE NO.    | <u>34</u> | SHEET          | <u>11</u> | OF            | <u>21</u> |
| NOTES     | <u>MOSER</u>     | DATE      | <u>5/15/02</u> | ROUTE     | <u>SR 51</u>  |           |
| H.C.      | <u>BARNHISEL</u> | WEATHER   | <u>SUNNY</u>   | COUNTY    | <u>OTTAWA</u> |           |
| R.C.      | <u>HOFFMAN</u>   | TEMP.     | <u>70°</u>     | TOWNSHIP  | <u>CLAY</u>   |           |
|           | <u>LOEHRKE</u>   |           |                | SECTION   | <u>28</u>     |           |
|           |                  |           |                | T         | <u>7</u>      | R         |
|           |                  |           |                | N         | <u>13</u>     | E         |

TYPE MONUMENT P.K.NAIL  
~~ON SURFACE~~ - BELOW 2"  
~~LEFT~~ - Q PAV'T - RIGHT 8.1'  
10.2' TO RT EDGE PAVEMENT  
 S.L.M. 371+90

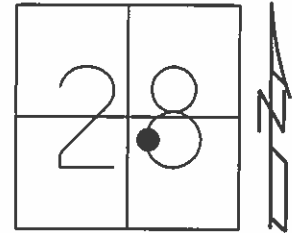


Grid: Northing: - Easting: -

RECORD: P.I.  
 $\Delta = 00^\circ 00' 30''$  LT  
 371+12.47

FD R.R. SPIKE  
 RT OF Q  
 SET P.K.NAIL  
 1/19/72


SET P.K./WASHER  
 7/29/02, MB

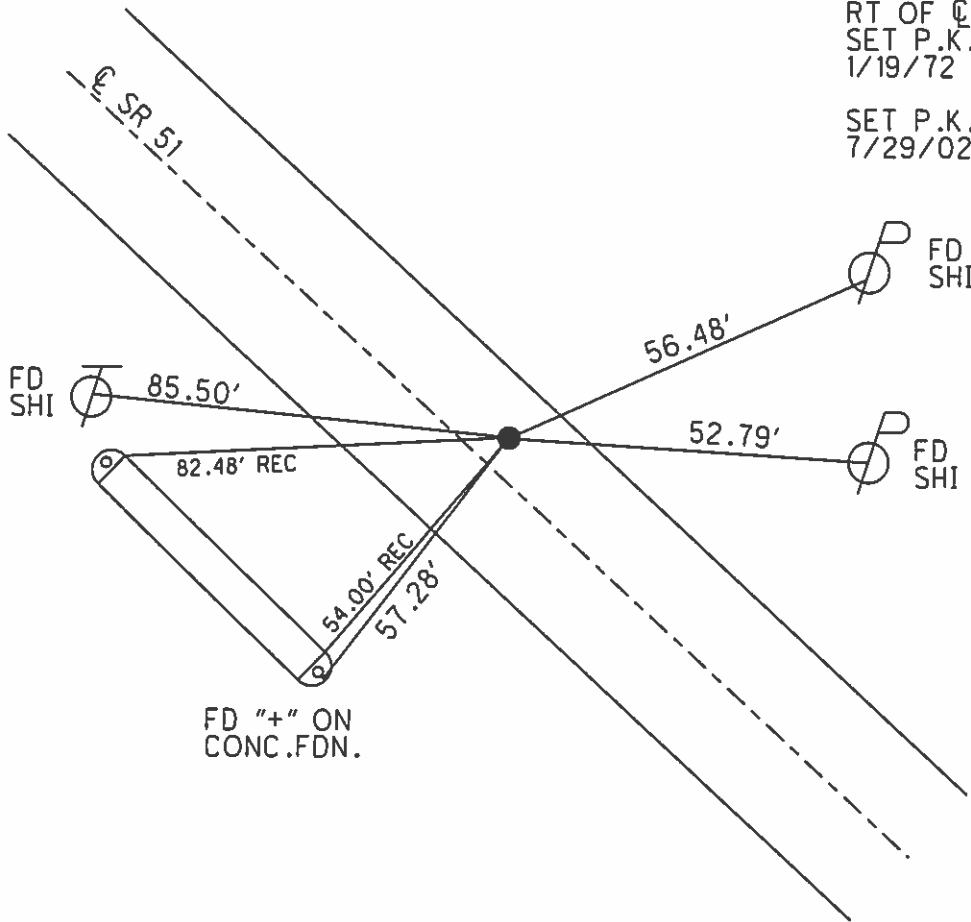

FD "+" ON  
 CONC.FDN.

| PERSONNEL | TITLE | PERSONNEL | TITLE | COUNTY   | DATE     | WEATHER | TEMP. |
|-----------|-------|-----------|-------|----------|----------|---------|-------|
| RIPPLE    |       |           |       | OTTAWA   | 12/15/86 | SUNNY   | 34°   |
| BARBOUR   |       |           |       | S. R. 51 |          |         |       |
| BOYMAN    |       |           |       | SEC. 28  |          |         |       |

DESCRIPTION CLAY Twp. LEFT CENTER LINE RIGHT JOB NO.

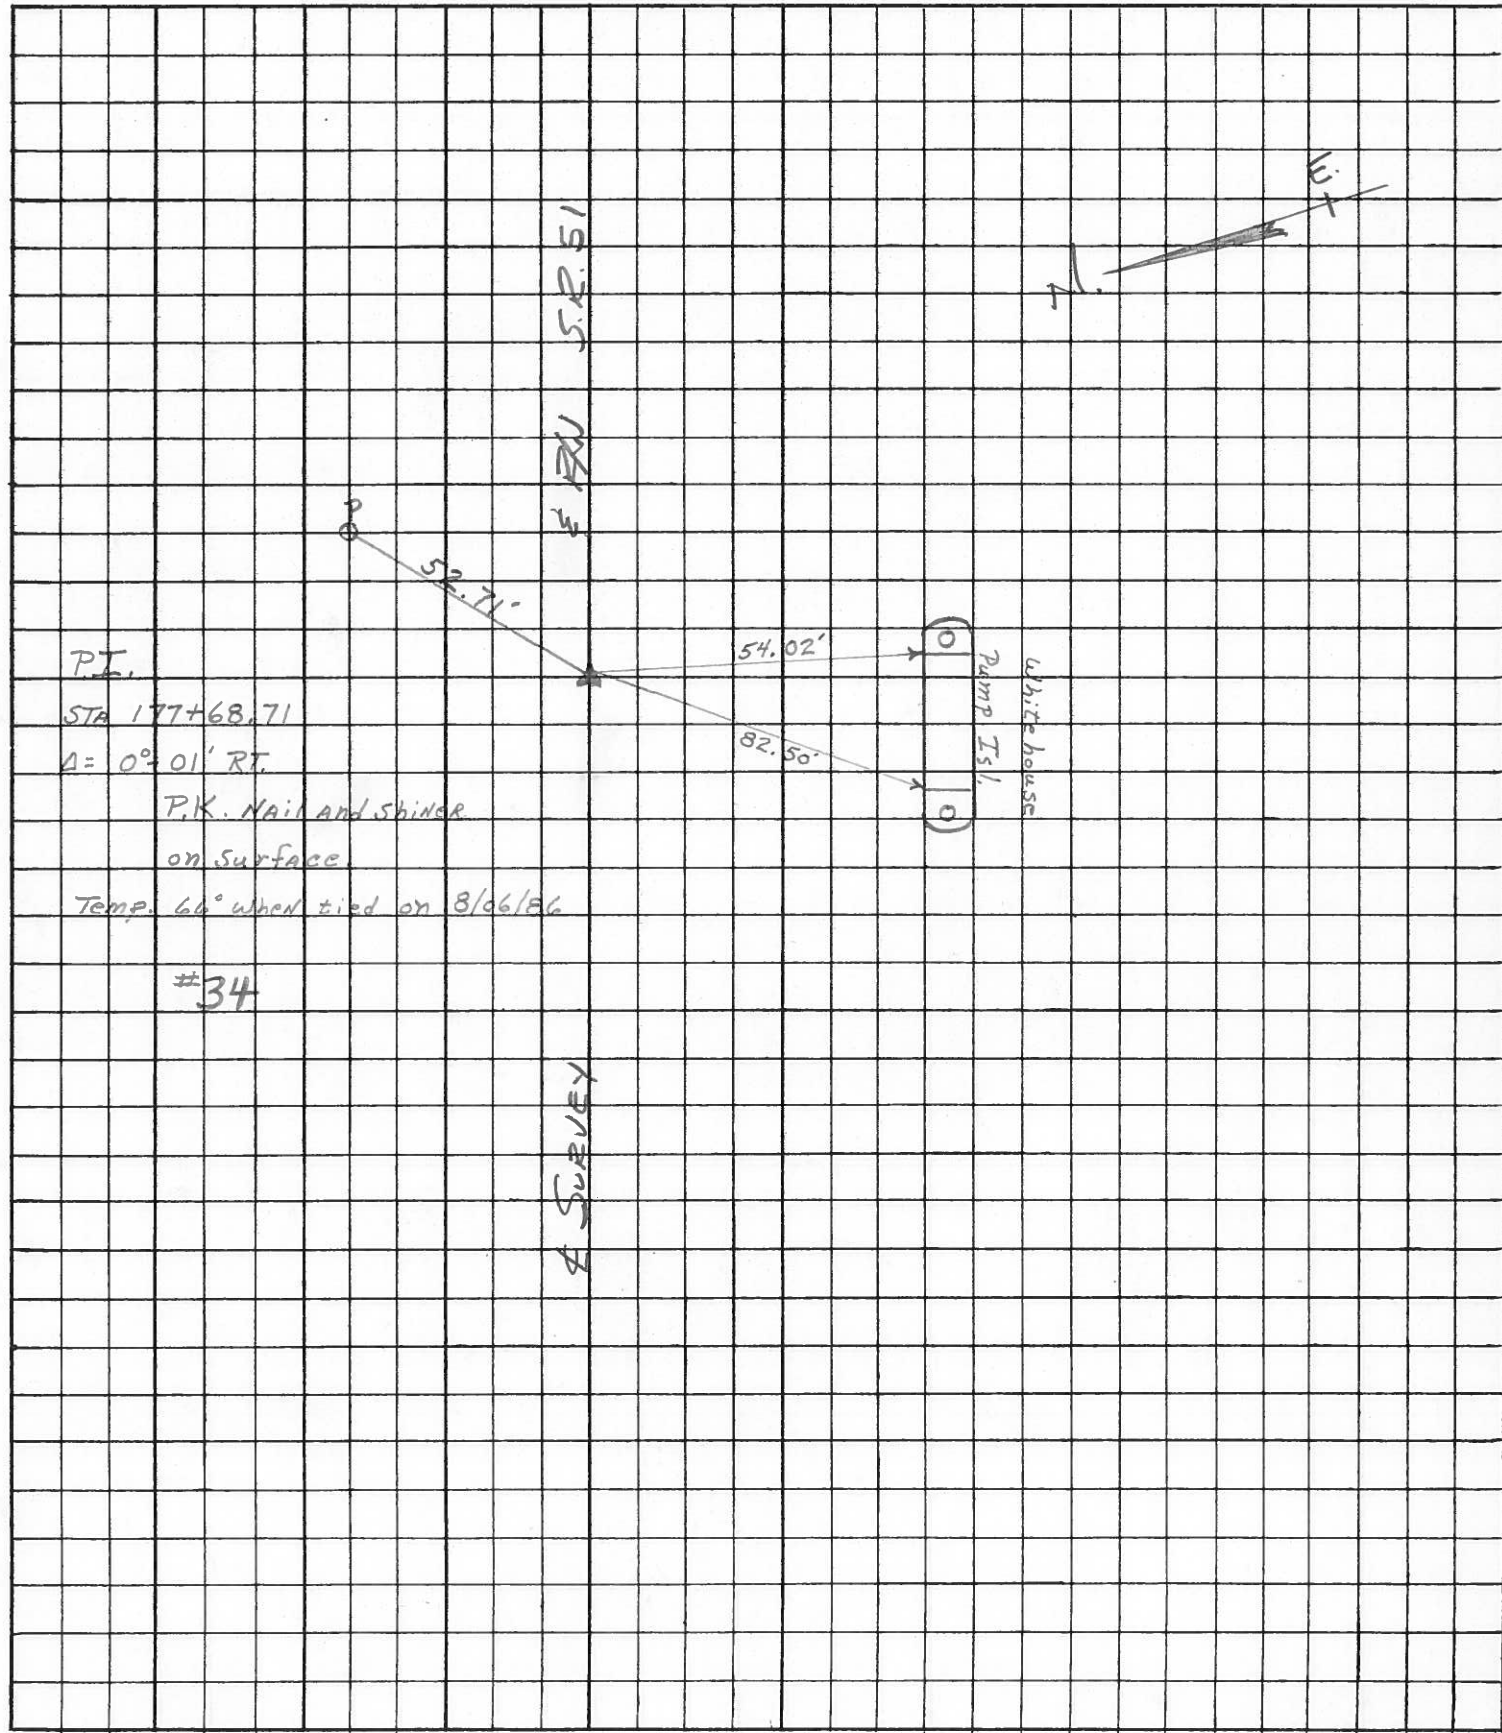

#34

PERSONNEL TITLE PERSONNEL TITLE


COUNTY Ottawa DATE 1-19-72

S. R. 51 WEATHER Fair


SEC. 28 TEMP. 40°

DESCRIPTION Clay Twp. LEFT CENTER LINE RIGHT JOB NO.

P.I.  
406+37.55  
R.R. Spk.  
 $\Delta = 0^{\circ} 03' Lt.$   
**36**

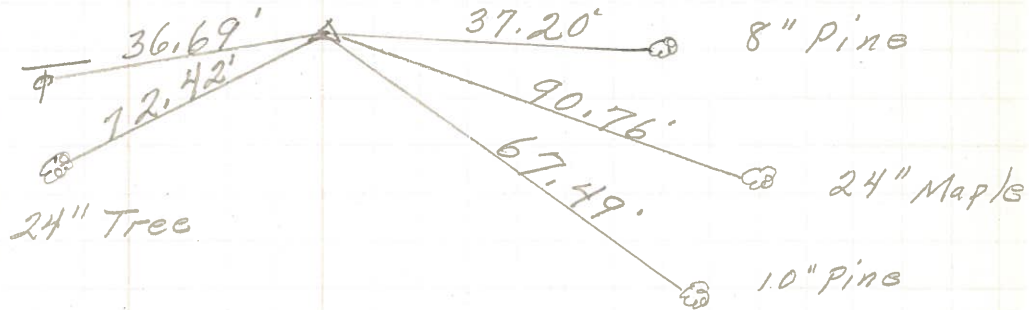

P.I.  
384+40.09  
R.R. Spk.  
Rt. of  $\phi$   
 $\Delta = 0^{\circ} 0' 30" Lt.$   
**35**

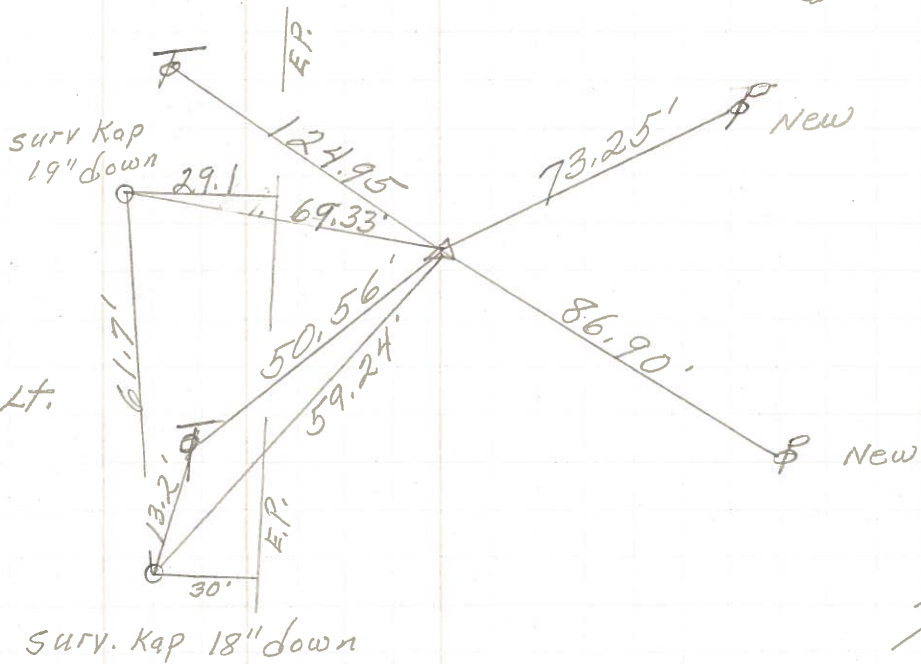

SEE NEW TIES

P.I.  
371+12.47  
R.R. Spk.  
Rt. of  $\phi$   
 $\Delta = 0^{\circ} 0' 30" Lt.$   
Good Ties set P.K. Nail  
**34.**

