

O.D.O.T. DISTRICT 2 SURVEY OFFICE (USE ONLY)

PERSONNEL	REFERENCE NO.	<u>36</u>	SHEET	<u>13</u>	OF	<u>21</u>
NOTES	<u>RHOADES</u>	DATE	<u>4/5/16</u>	ROUTE	<u>SR 51</u>	
H.C.	<u>FARKAS</u>	WEATHER	<u>CLOUDY</u>	COUNTY	<u>OTTAWA</u>	
R.C.	<u>HOMAN</u>	TEMP.	<u>26°</u>	TOWNSHIP	<u>CLAY</u>	
				SECTION	<u>28</u>	
				T	<u>7</u>	R
					<u>N</u>	<u>13</u>
					<u>E</u>	

TYPE MONUMENT P.K.SHANK


~~ON SURFACE~~ - BELOW 1"

~~LEFT~~ - CL PAV'T - RIGHT 7.0'


4.7' TO RT EDGE PAVEMENT

S.L.M. 407+19

Grid: Northing: 684753.329 Easting: 1728574.312

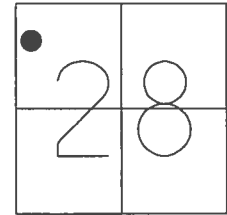


RECORD: P.I.  
 $\Delta = 0^{\circ} 03' LT$   
 406+37.55  
 FD R.R.SPIKE  
 1/19/72  
 FD P.K.NAIL  
 5/15/02, MB  
 SET P.K./WASHER  
 7/29/02, MB  
 FD P.K.SHANK  
 REF36  
 2/16/16, JFO  
 SET MAG/WASHER  
 NEWREF36  
 6/1/17, JFO

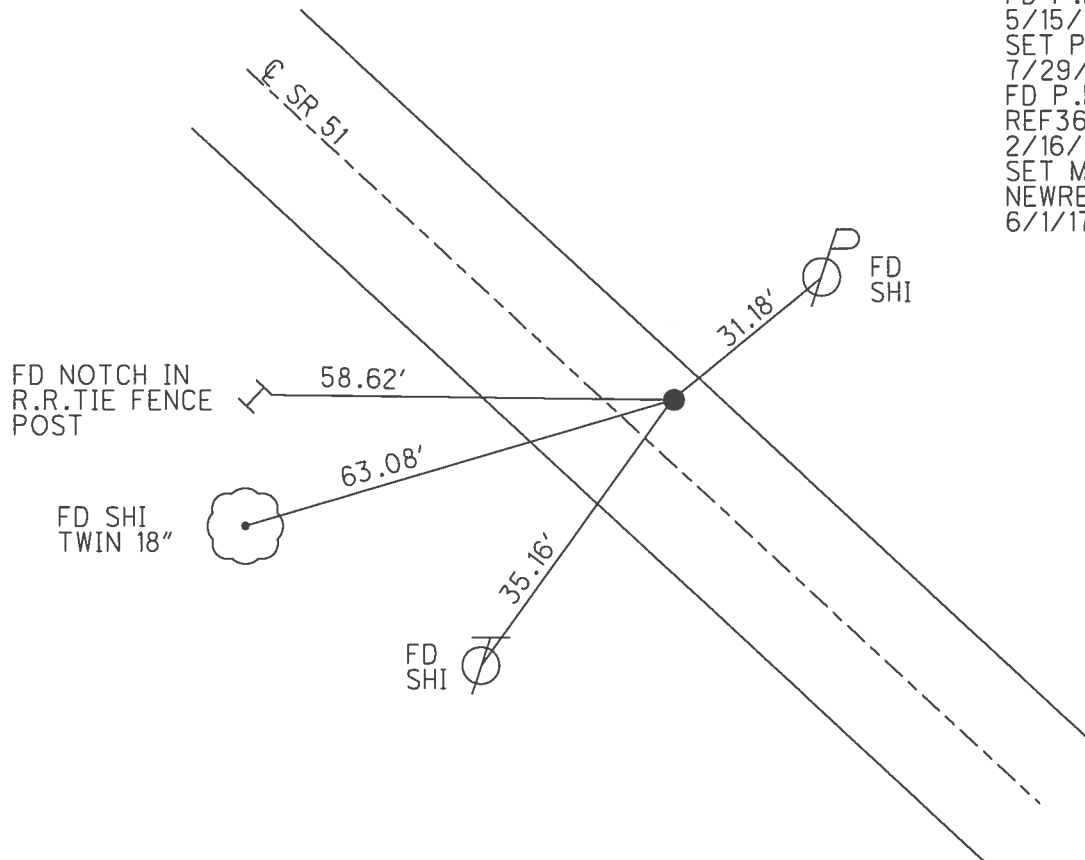

O.D.O.T. DISTRICT 2 SURVEY OFFICE (USE ONLY)

PERSONNEL \_\_\_\_\_ REFERENCE NO. 36 SHEET 13 OF 21  
 NOTES MOSER DATE 5/15/02 ROUTE SR 51  
 H.C. BARNHISEL WEATHER SUNNY COUNTY OTTAWA  
 R.C. HOFFMAN TEMP. 70° TOWNSHIP CLAY  
 \_\_\_\_\_ LOEHRKE \_\_\_\_\_ SECTION 28  
 \_\_\_\_\_ T 7 N R 13 E


TYPE MONUMENT P.K.NAIL  
 ON SURFACE - ~~BELOW~~ ON \_\_\_\_\_  
~~LEFT~~ - CL PAV'T - RIGHT 7.0'  
4.7' TO RT EDGE PAVEMENT  
 S.L.M. 407+19  
 Grid: Northing: \_\_\_\_\_ Easting: \_\_\_\_\_

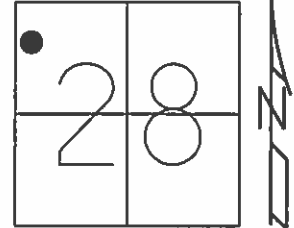

RECORD: P.I.  
 $\Delta = 00^\circ 03' LT$   
 406+37.55

FD R.R.SPIKE  
 1/19/72

SET P.K./WASHER  
 7/29/02, MB

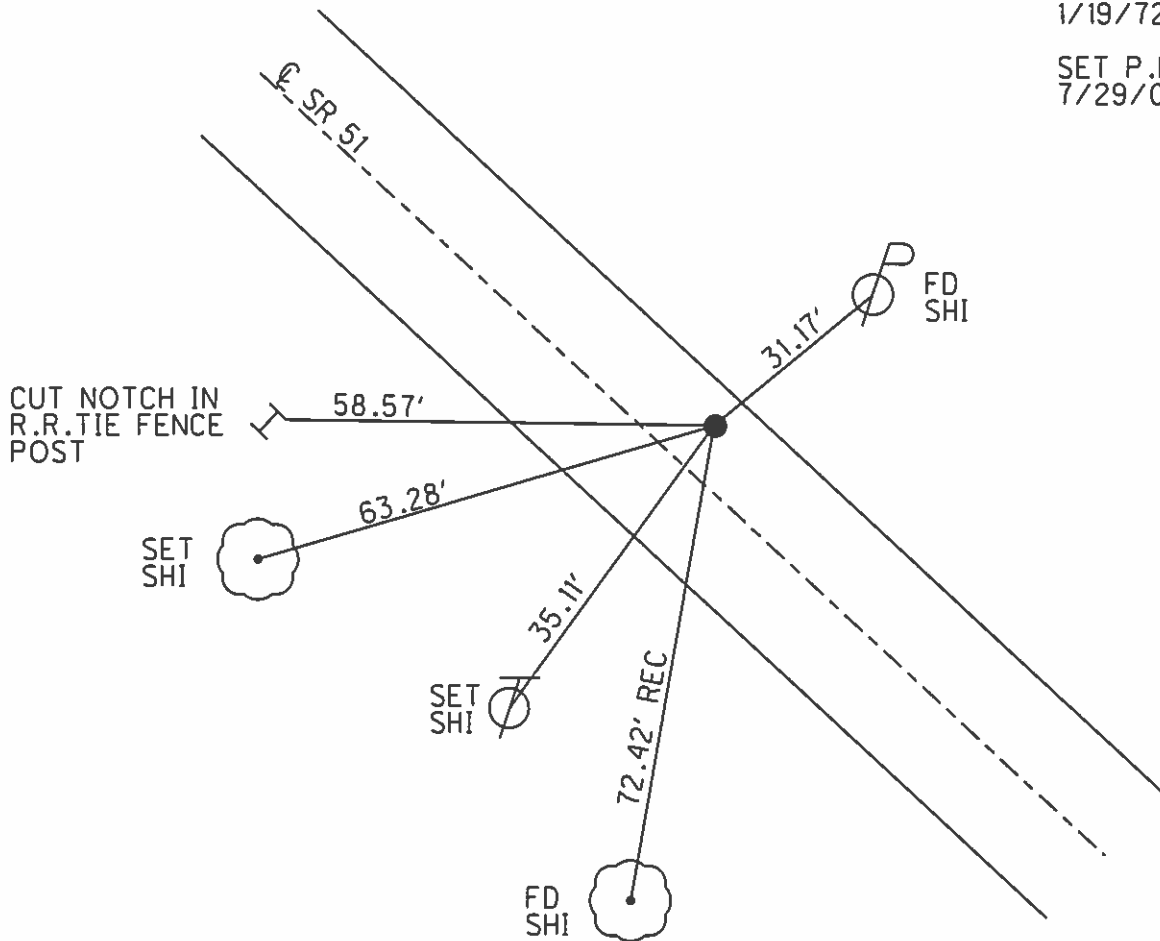

PERSONNEL TITLE PERSONNEL TITLE


COUNTY Ottawa DATE 1-19-72

S. R. 51 WEATHER Fair


SEC. 28 TEMP. 40°

DESCRIPTION Clay Twp. LEFT CENTER LINE RIGHT JOB NO.

P.I.  
406+37.55  
R.R. Spk.  
 $\Delta = 0^{\circ} 03' Lt.$   
**36**

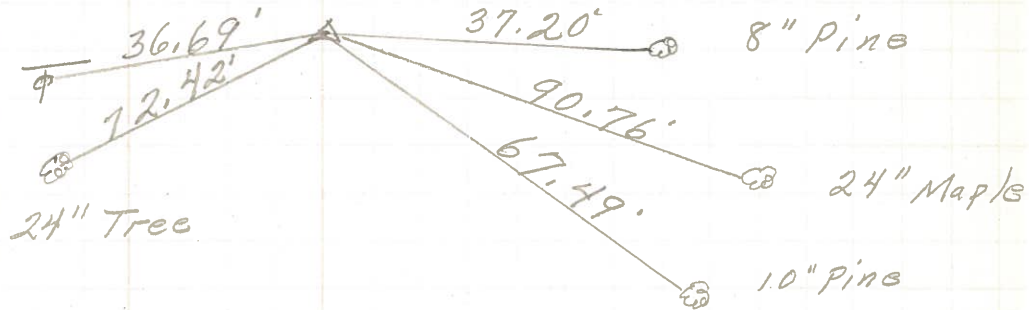


P.I.  
384+40.09  
R.R. Spk.  
Rt. of  $\phi$   
 $\Delta = 0^{\circ} 0' 30'' Lt.$   
**35**

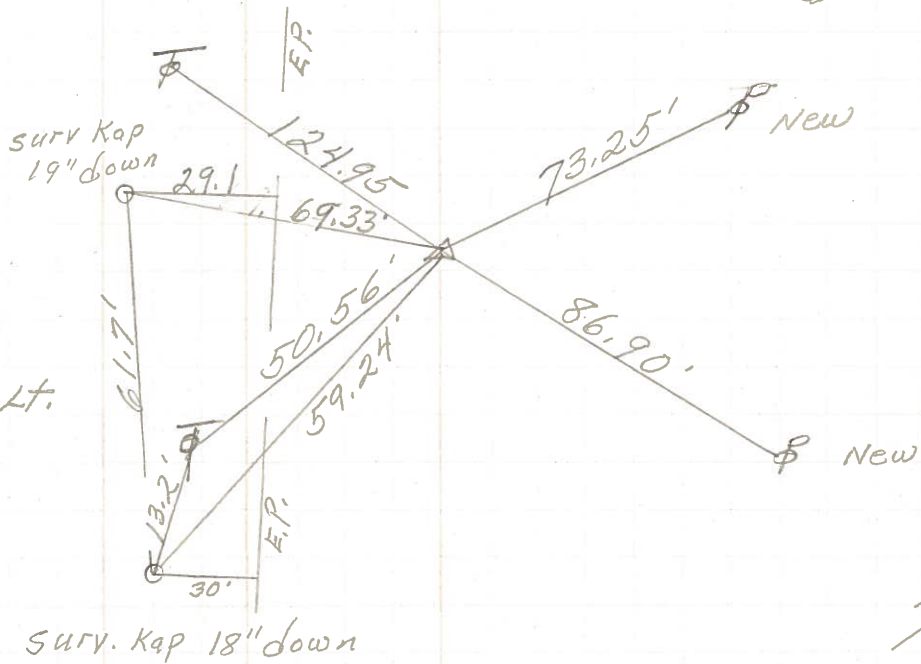

SEE NEW TIES

P.I.  
371+12.47  
R.R. Spk.  
Rt. of  $\phi$   
 $\Delta = 0^{\circ} 0' 30'' Lt.$   
Good Ties set P.K. Nail  
**34.**

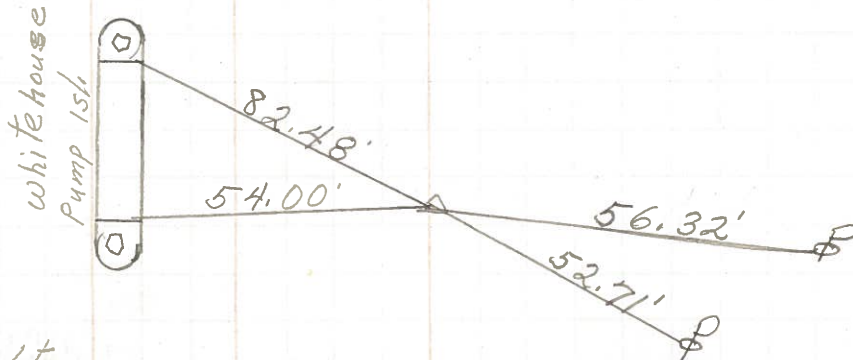

PERSONNEL TITLE PERSONNEL TITLE

COUNTY Ottawa DATE 6-20-68

Schneider

S. R. 51 WEATHER Fair

Mosser

Barbour

SEC. Wood Co. Line-East TEMP. 60°

Redding

DESCRIPTION Ties for Control Points JOB NO.

