

O.D.O.T. DISTRICT 2 SURVEY OFFICE (USE ONLY)

PERSONNEL	REFERENCE NO.	40	SHEET	17	OF	21
NOTES	RHOADES	DATE	4/18/16	ROUTE	SR 51	
H.C.	O'DONNELL	WEATHER	SUNNY	COUNTY	OTTAWA	
R.C.	RHOADES	TEMP.	50°	TOWNSHIP	CLAY	
				SECTION	20	
				T	7	N
				R	13	E

TYPE MONUMENT P.K./WASHER



~~ON SURFACE~~ - BELOW 3"

~~LEFT~~ - ℄ PAV'T - RIGHT 6.3'

- TO - EDGE PAVEMENT

S.L.M. 468+66

Grid: Northing: 688872.603 Easting: 1724012.162

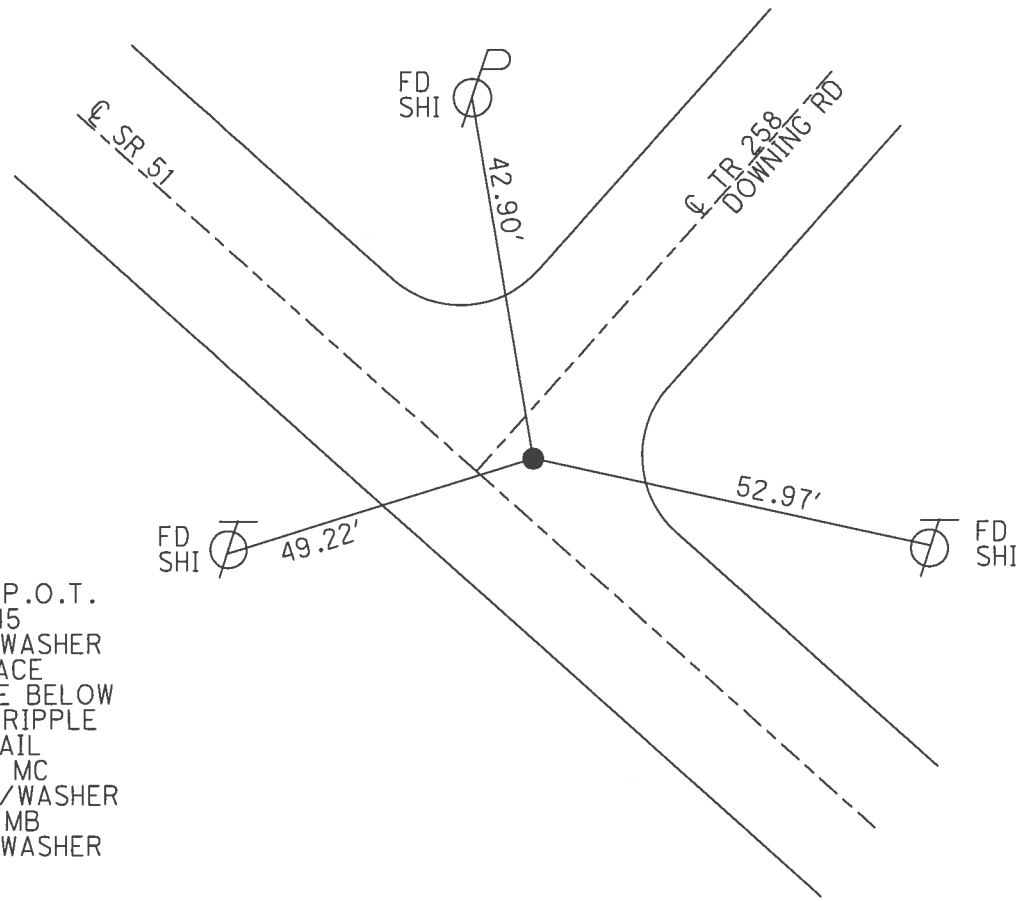
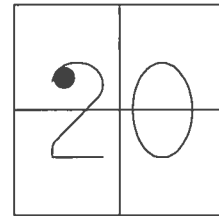


RECORD: P.O.T.  
 473+07.45  
 FD P.K./WASHER  
 ON SURFACE  
 R.R.SPIKE BELOW  
 8/4/82, RIPPLE  
 FD P.K.NAIL  
 5/17/02, MC  
 SET P.K./WASHER  
 8/5/02, MB  
 FD P.K./WASHER  
 3" DOWN  
 REF40  
 4/18/16, JFO  
 SET MAG/WASHER  
 NEWREF40  
 6/1/17, JFO

O.D.O.T. DISTRICT 2 SURVEY OFFICE (USE ONLY)

PERSONNEL \_\_\_\_\_ REFERENCE NO. 40 SHEET 17 OF 21  
 NOTES MOSE DATE 5/17/02 ROUTE SR 51  
 H.C. CANTERBURY WEATHER DRIZZLE COUNTY OTTAWA  
 R.C. C.R. TEMP. 75° TOWNSHIP CLAY  
 \_\_\_\_\_ B.M. \_\_\_\_\_ SECTION 20  
 \_\_\_\_\_ T 7 N R 13 E

TYPE MONUMENT P.K.NAIL  
 ON SURFACE - ~~BELOW~~ ON \_\_\_\_\_  
~~LEFT~~ -  $\phi$  PAV'T - RIGHT 6.3'  
 - TO - EDGE PAVEMENT  
 S.L.M. 473+70  
 Grid: Northing: \_\_\_\_\_ Easting: \_\_\_\_\_


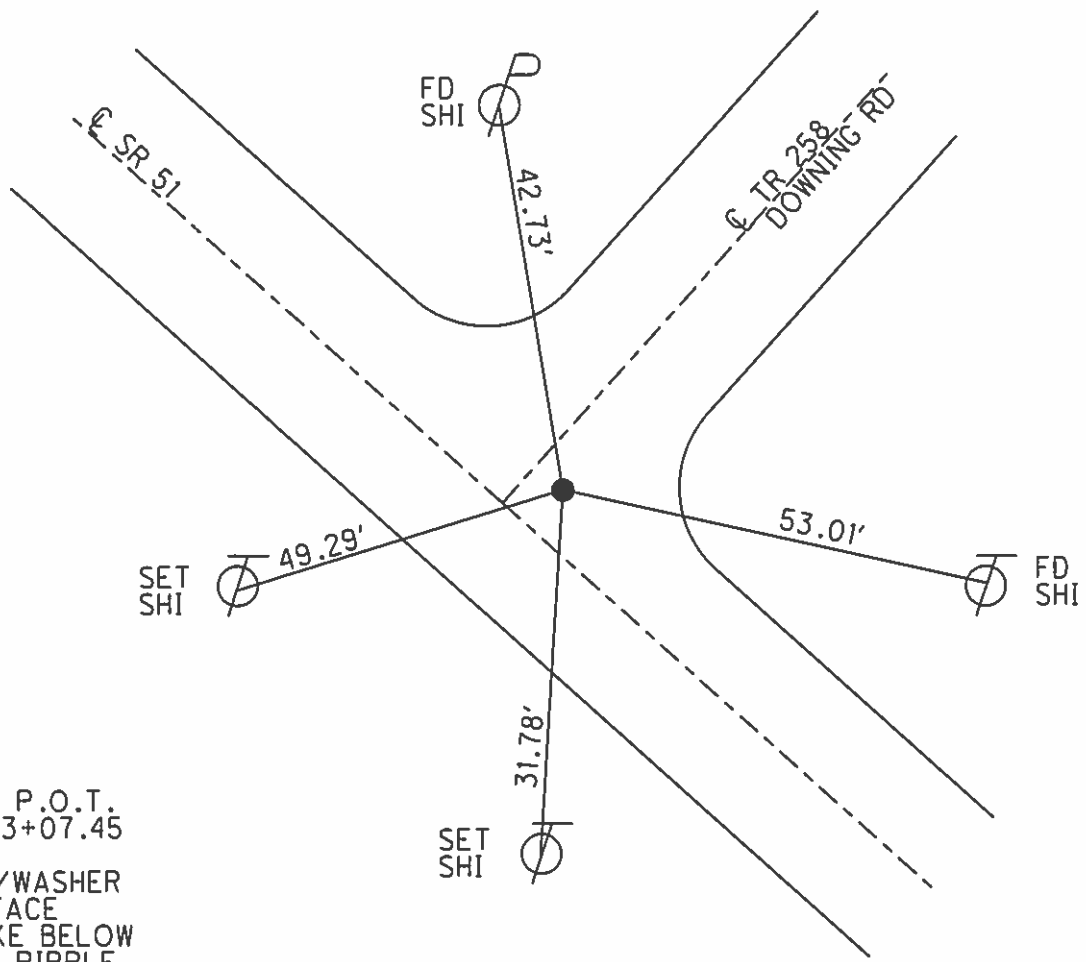
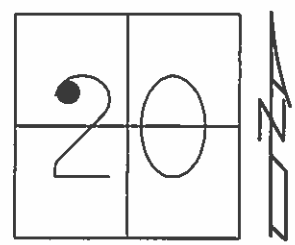


RECORD: P.O.T.  
 PLAN 473+07.45  
 FD P.K./WASHER  
 ON SURFACE  
 R.R.SPIKE BELOW  
 8/4/82, RIPPLE  
 SET P.K./WASHER  
 8/5/02, MB

PERSONNEL	TITLE	PERSONNEL	TITLE
<u>Cronin</u>			
<u>Ripple</u>			
<u>Geyman</u>			
<u>Barbour</u>			

COUNTY Ottawa DATE 8/4/82  
 S. R. #51 WEATHER OVERCAST  
 SEC. Bridge - Ott. 51 - 01.87 TEMP. 82°

DESCRIPTION Ties for Control Points LEFT CENTER LINE R/W RIGHT JOB NO. \_\_\_\_\_

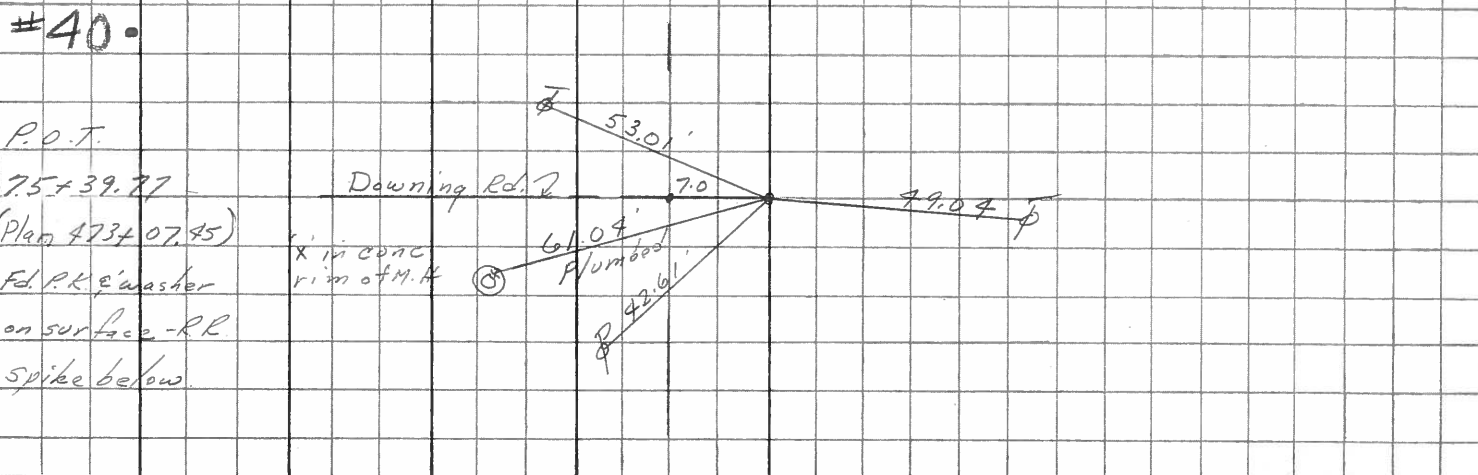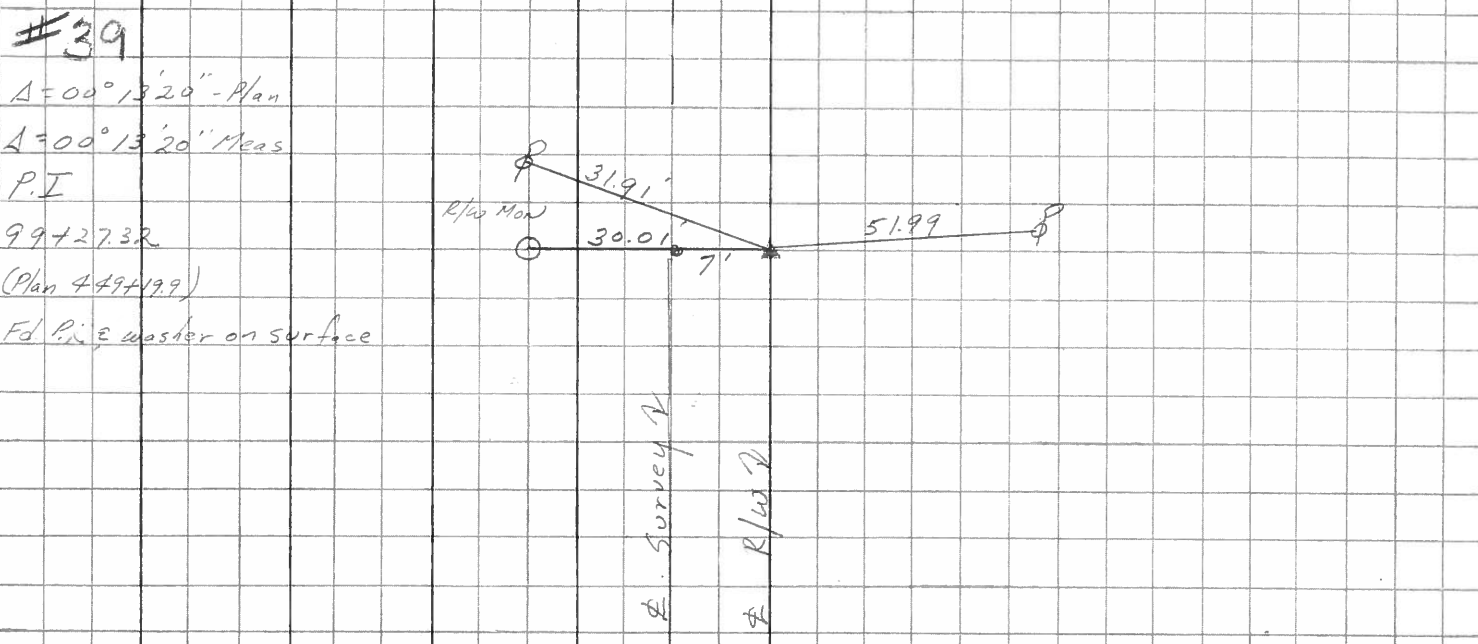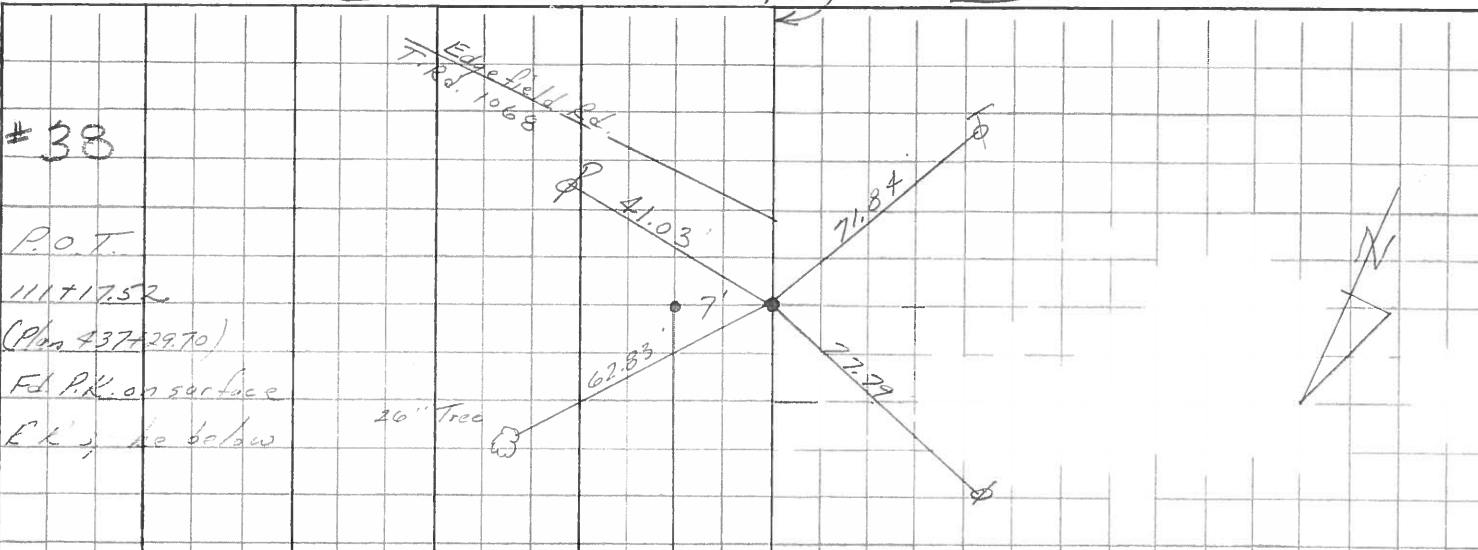


PERSONNEL TITLE PERSONNEL TITLE

COUNTY Ottawa DATE 1-19-72

S. R. 51 WEATHER Fair

SEC. 18 & 19 TEMP. 40°

DESCRIPTION Clay Twp. JOB NO. \_\_\_\_\_

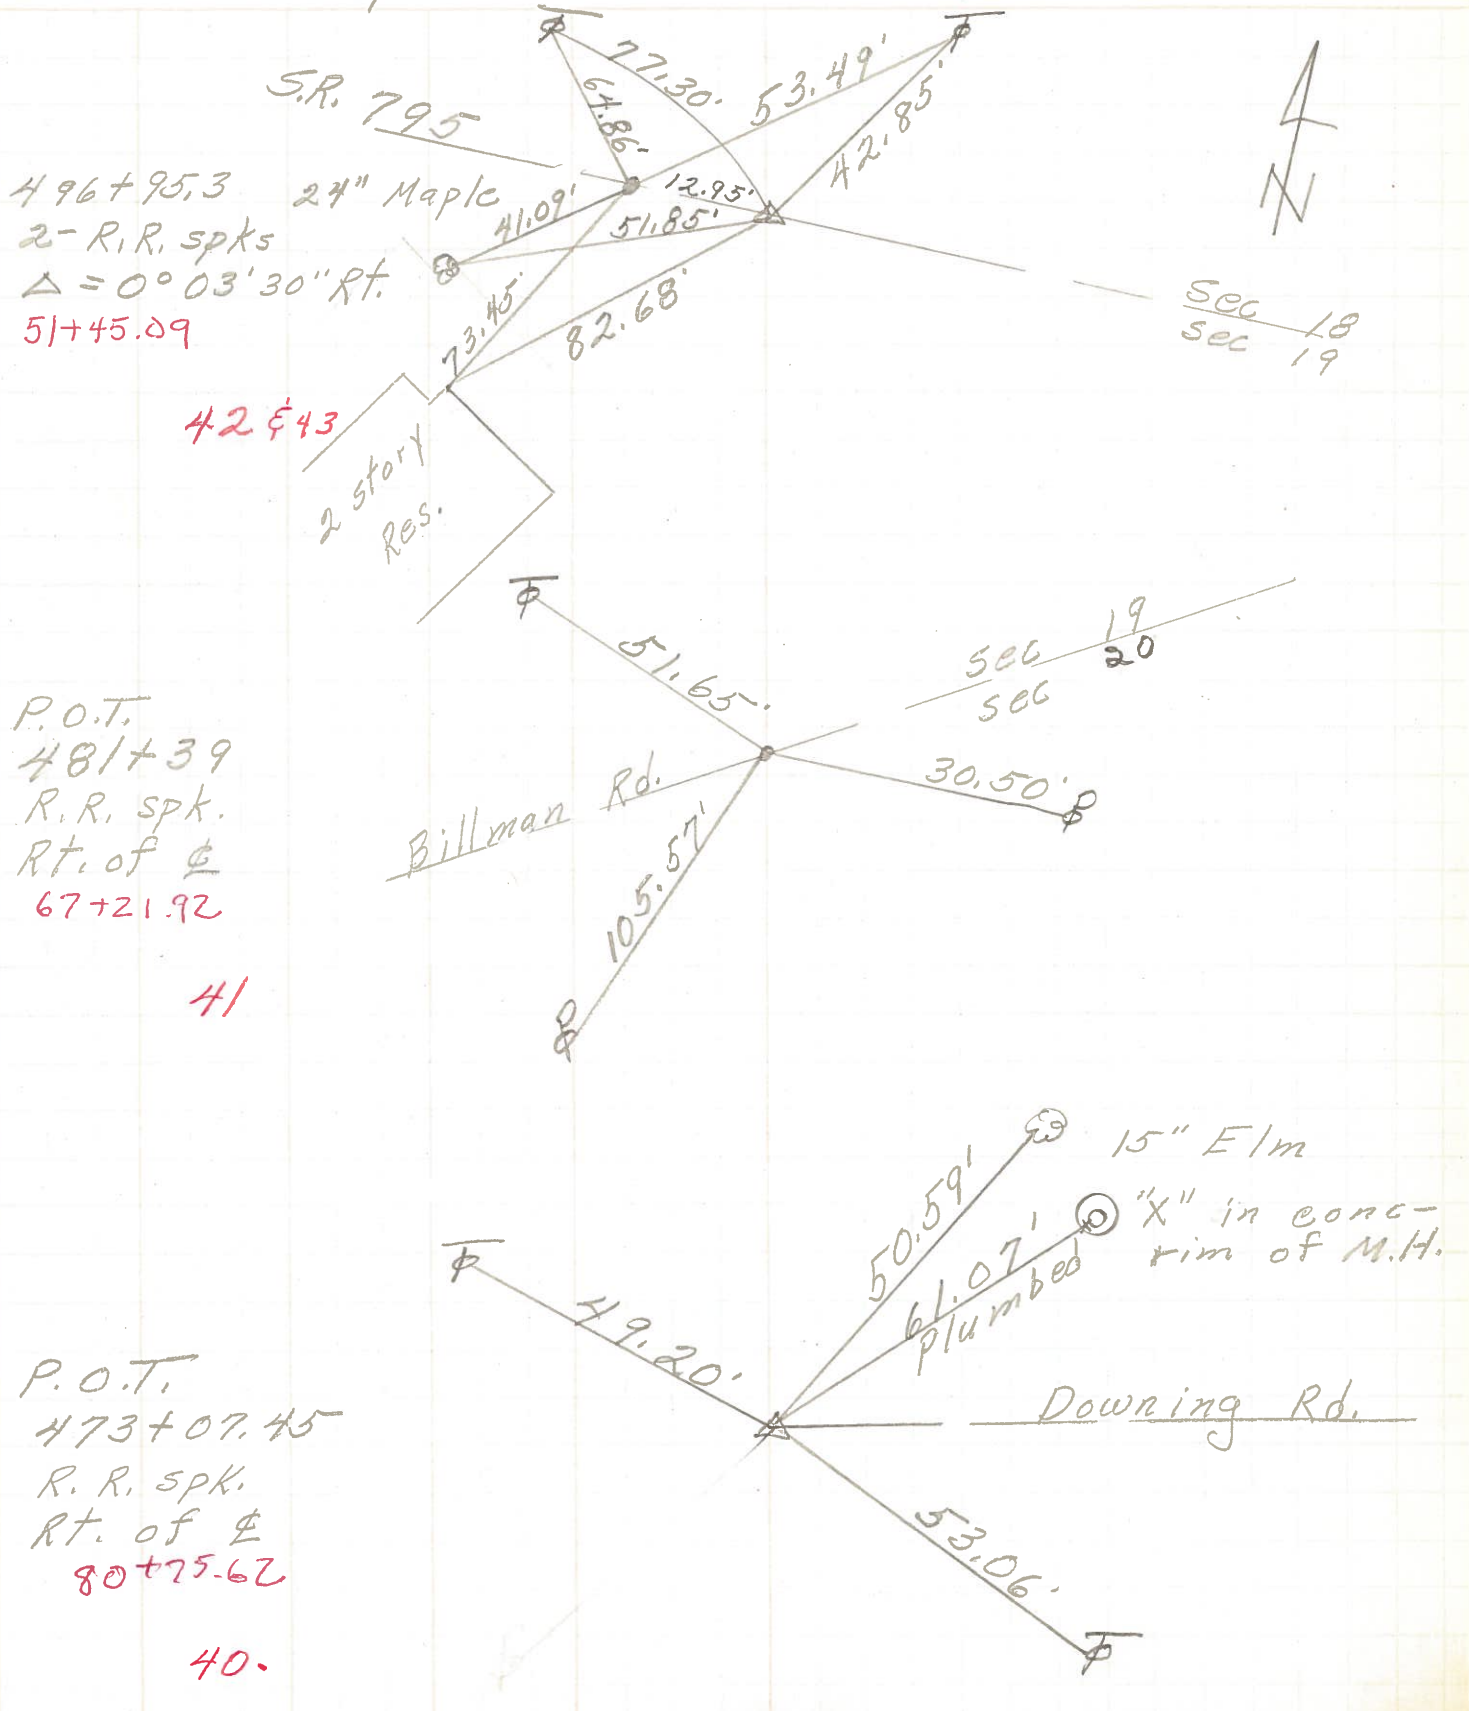

496+95.3 24" Maple  
 2-R.R. spks  
 $\Delta = 0^{\circ} 03' 30''$  Rt.  
 51+45.09

42 & 43  
 2 story Res.

P.O.T.  
 481+39  
 R.R. spk.  
 Rt. of  $\$$   
 67+21.92

41

P.O.T.  
 473+07.45  
 R. R. spk.  
 Rt. of  $\$$   
 80+75.62

40.

PERSONNEL	TITLE	PERSONNEL	TITLE	COUNTY	<u>Ottawa</u>	DATE	<u>6-14-68</u>
<u>Schneider</u>		<u>Potts</u>		S. R.	<u>51</u>	WEATHER	<u>Fair - windy</u>
<u>Mosser</u>				SEC.	<u>Wood Co. Line East</u>	TEMP.	<u>75°</u>
<u>Barbour</u>				DESCRIPTION	<u>Tie for Control Points</u>		
<u>Redding</u>						JOB NO.	

