


PERSONNEL	TITLE	PERSONNEL	TITLE

COUNTY Ottawa DATE 1-19-72
 S. R. 51 WEATHER Fair
 SEC. 18 E 19 TEMP. 40°

DESCRIPTION Clay Twp. JOB NO. _____

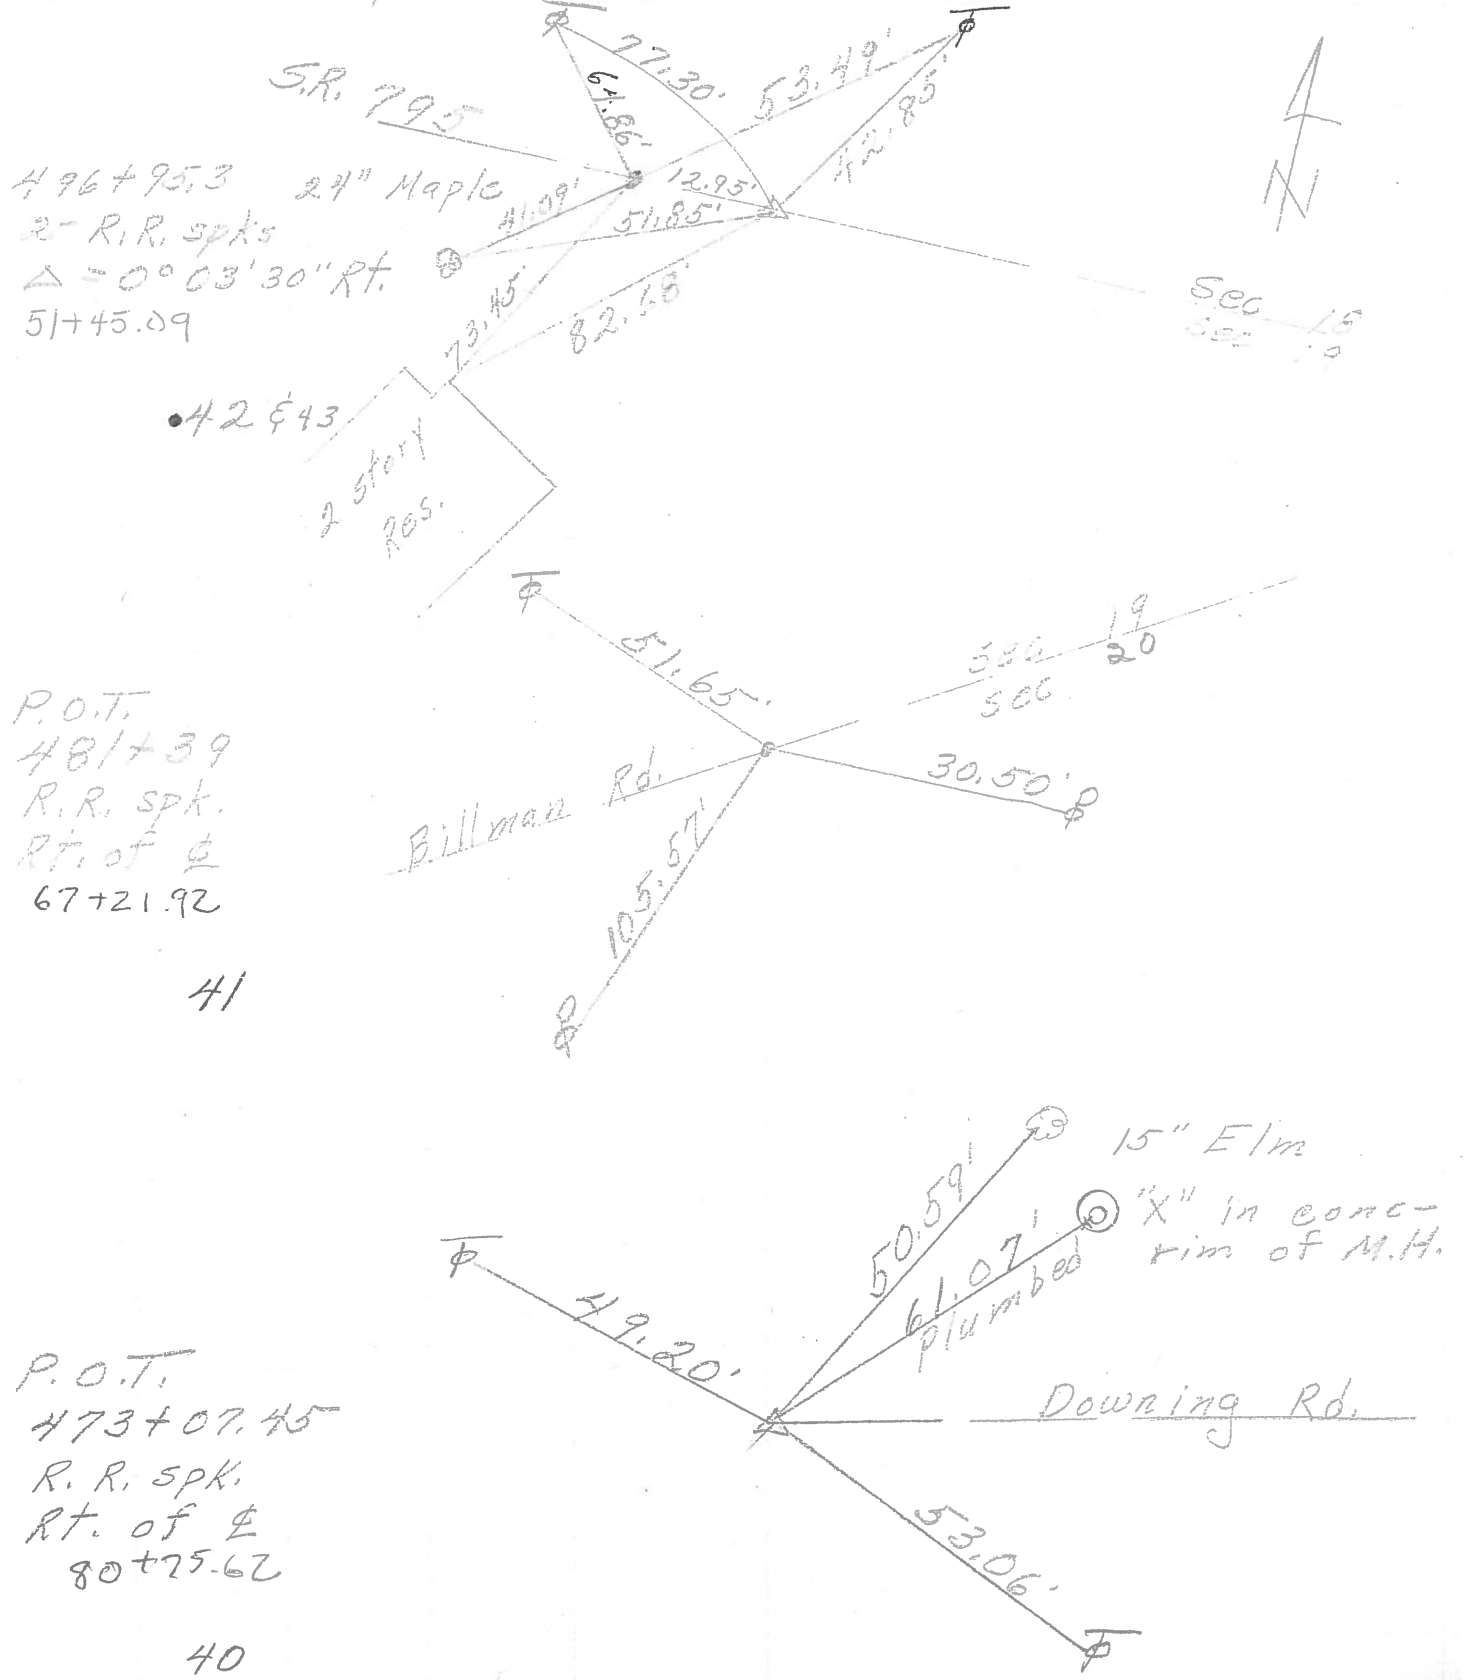

H 96+95.3 24" Maple
 2- R.R. spks
 $\Delta = 0^\circ 03' 30''$ Rt.
 51+45.09

P.O.T.
 481+39
 R.R. spk.
 Rt. of Φ
 67+21.92

41


P.O.T.
 473+07.45
 R.R. spk.
 Rt. of Φ
 80+25.62

40

PERSONNEL TITLE PERSONNEL TITLE
 Schneider _____ Potts _____
 Mosser _____
 Barbour _____
 Redding _____

COUNTY Ottawa DATE 6-14-68
 S. R. 51 WEATHER Fair-windy
 SEC. Wood Co. Line - East TEMP. 70°

DESCRIPTION Ties for Control Points JOB NO. _____

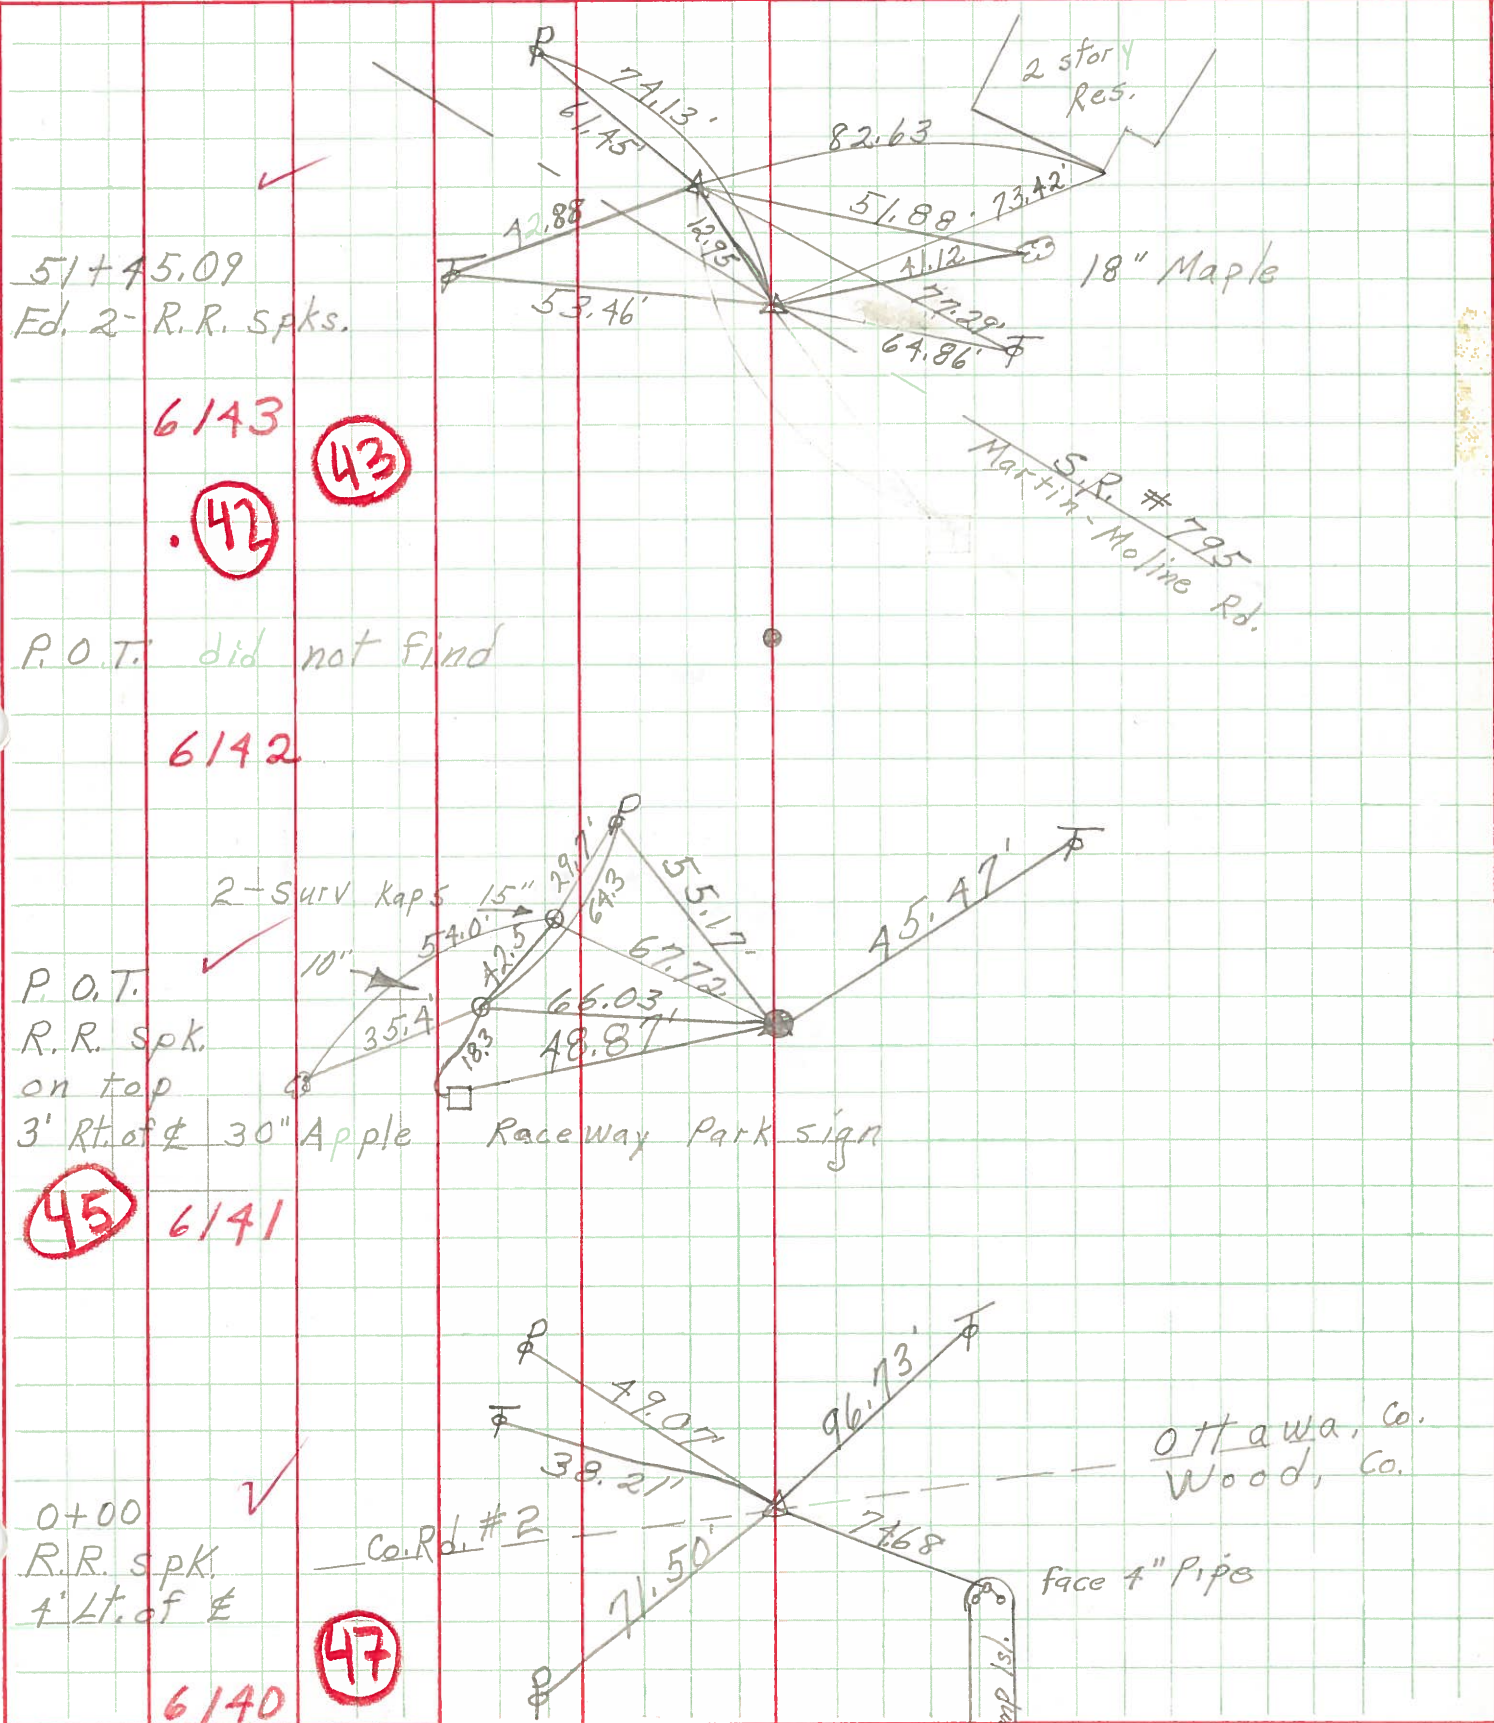

51+45.09
 Ed. 2- R.R. Spks.

6143
 (42) (43)

P.O.T. did not find

6142

P.O.T. ✓
 R.R. Spk.
 on top
 3' Rt. of ϵ 30" Apple

(45) 6141

0+00
 R.R. Spk.
 4' Lt. of ϵ

6140 (47)

Pump Isl.

Ottawa, Co.
 Wood, Co.