

PERSONNEL TITLE PERSONNEL TITLE

COUNTY Ottawa

DATE 1-20-72

S. R. 51

WEATHER Cloudy

SEC. 18

TEMP. 35°

DESCRIPTION Allen Twp.

JOB NO.


LEFT

CENTER LINE

RIGHT

P.O.T.  
516+54.04  
R.R. spk.  
3' Lt. of  $\perp$

45

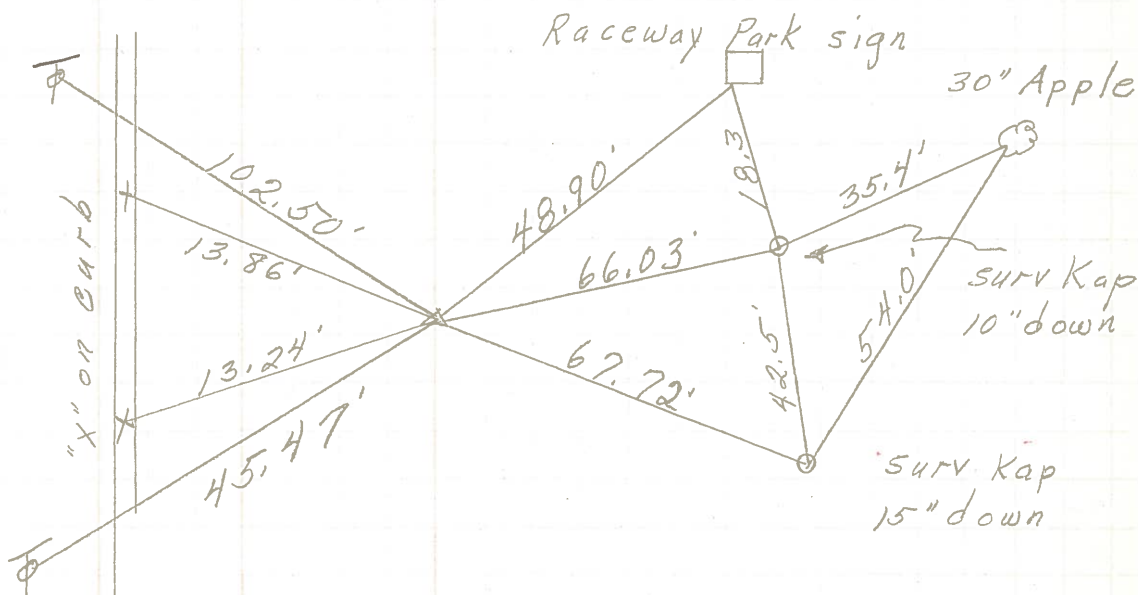

P.I.  
509+99.8  
 $\Delta = 0^{\circ}02' Lt.$   
(38+00)

44

