

PERSONNEL TITLE PERSONNEL TITLE

COUNTY Ottawa

DATE 1-20-72

S. R. 51

WEATHER Cloudy

SEC. 18

TEMP. 35°

DESCRIPTION Allen Twp.

JOB NO.


LEFT

CENTER LINE

RIGHT


P.O.T.  
516+54.04  
R.R. spk.  
3' Lt. of  $\perp$

45

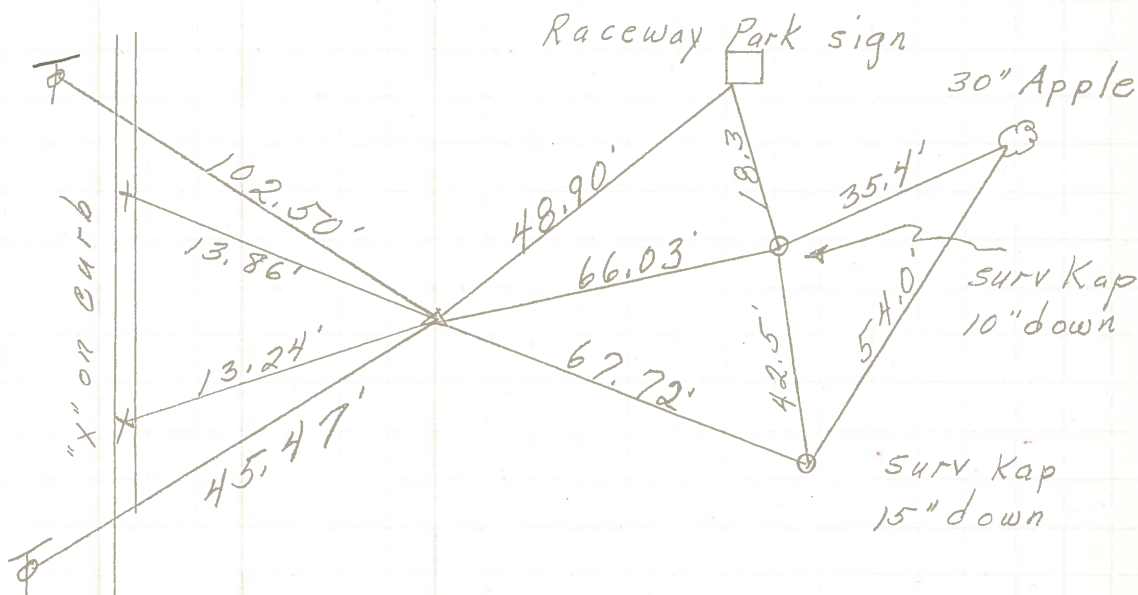


P.I.  
509+99.8  
 $\Delta = 0^{\circ}02' Lt.$   
(38+00)

44

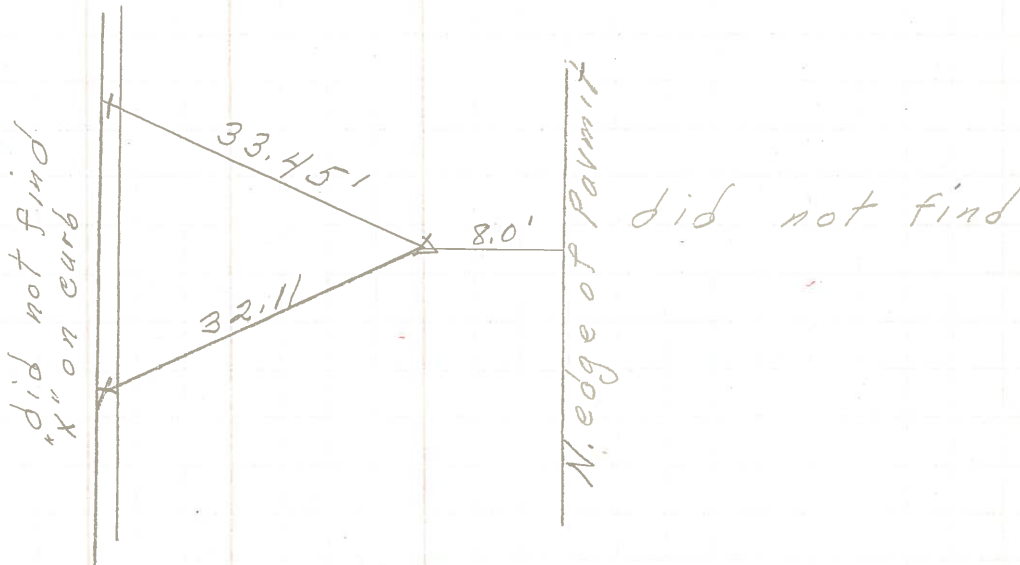

PERSONNEL TITLE PERSONNEL TITLE COUNTY Ottawa DATE 6-14-68  
Schneider \_\_\_\_\_ Potts \_\_\_\_\_  
Mosser \_\_\_\_\_ S. R. 51 WEATHER Fair-windy  
Barbour \_\_\_\_\_  
Redding \_\_\_\_\_ SEC. Wood Co. Line - East TEMP. 70°  
 DESCRIPTION Ties for Control Points JOB NO. \_\_\_\_\_

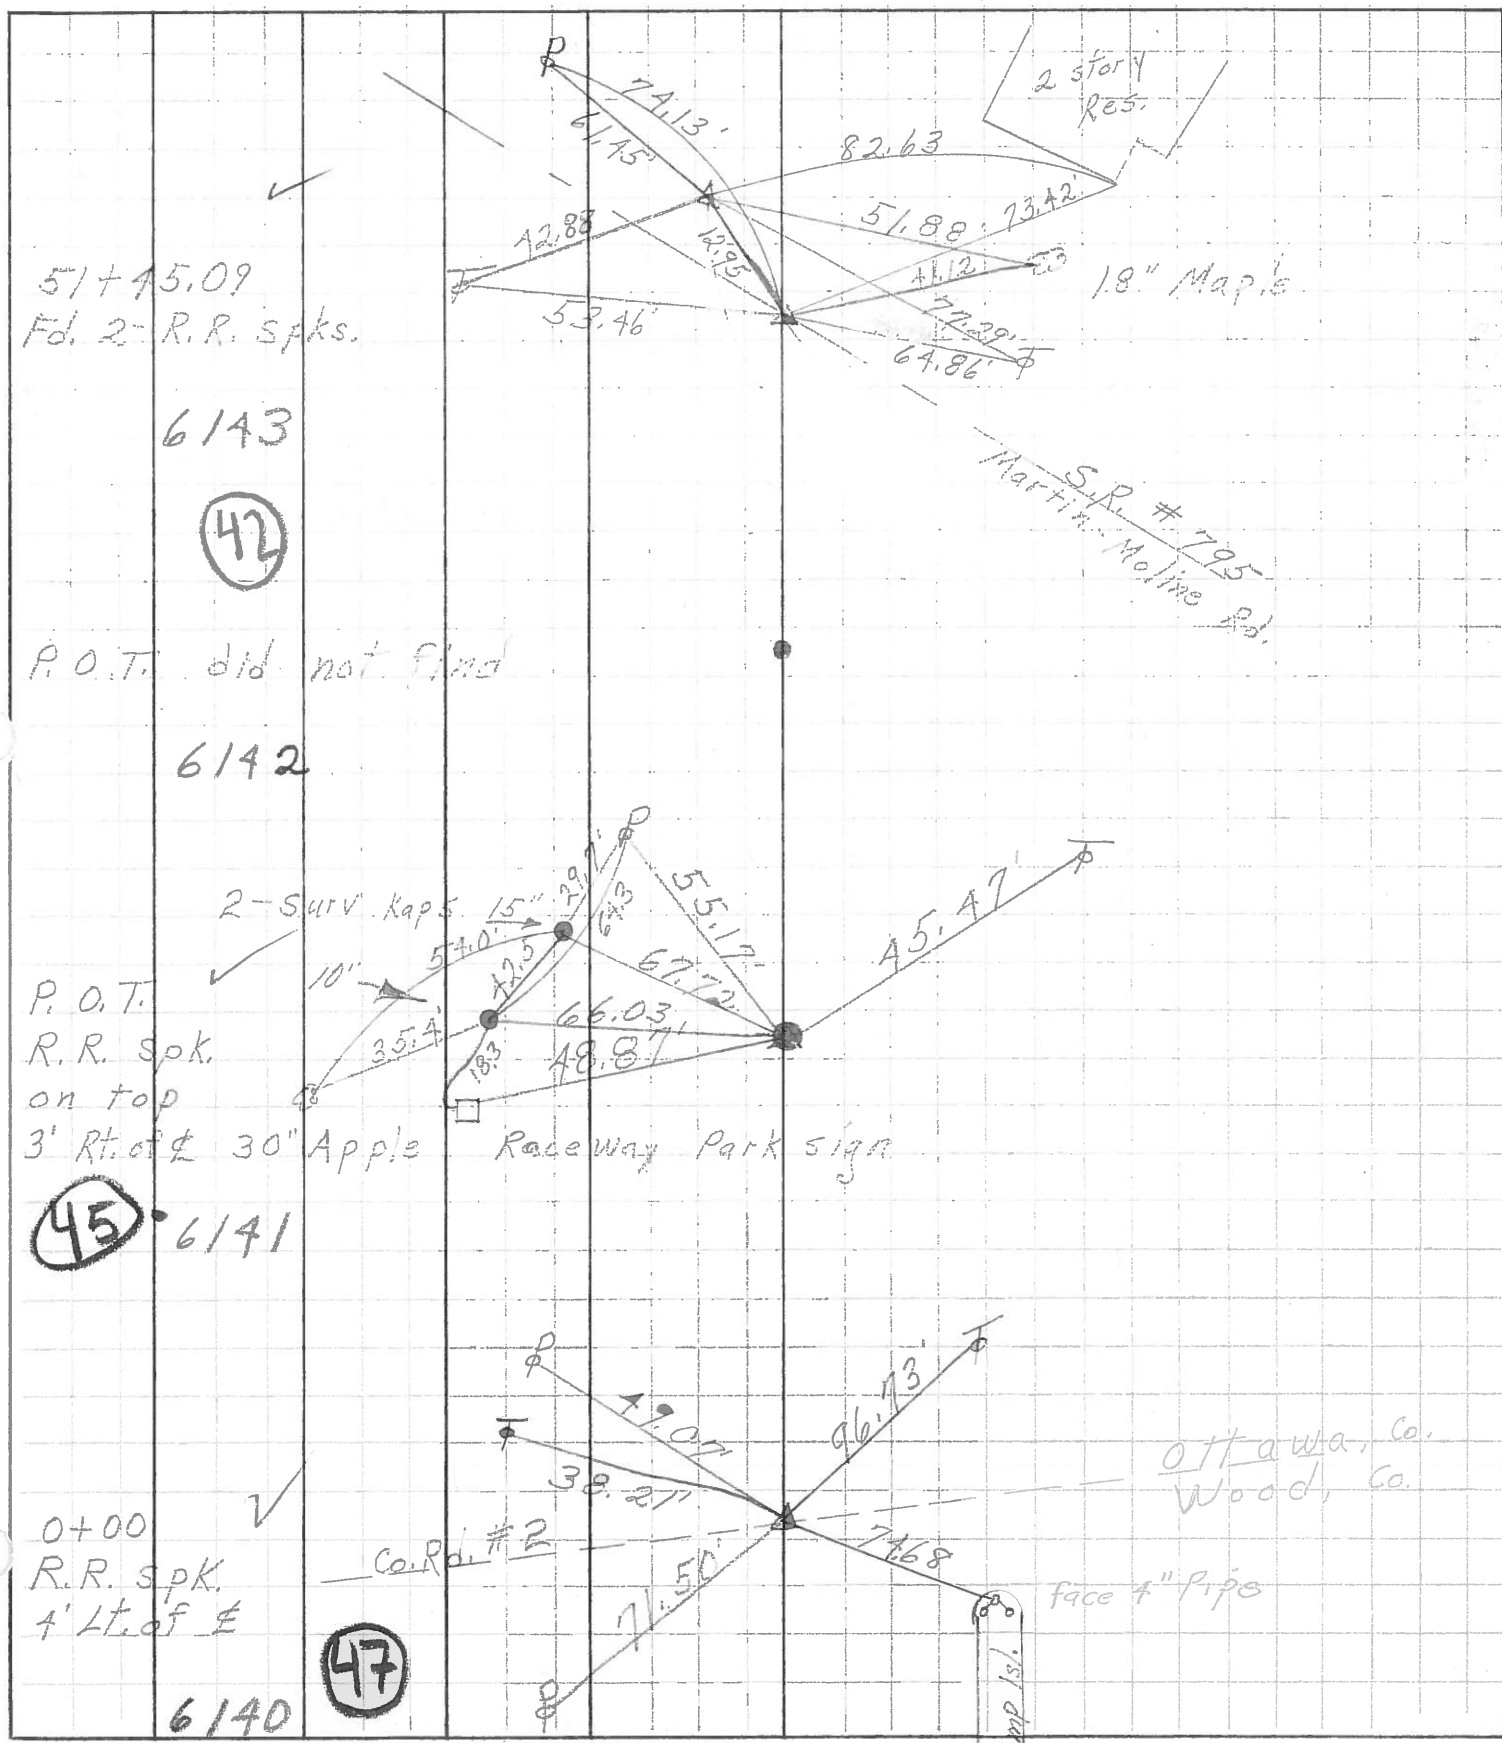

51+45.09  
Fd. 2- R.R. spks.

6143

42

P.O.T. did not find

6142

P.O.T.  
R.R. spk.  
on top  
3' Rt. of £ 30" Apple

Raceway Park sign

45 6141

0+00  
R.R. spk.  
1' Lt. of £

47

6140

Ottawa, Co.  
Wood, Co.

face 4" Pipe

2" pipe