

CDOT (D-2) Notes to: B. Rosebrook 2-23-94  
1994 TWO-LANE RESURFACING PROGRAM  
1995 1996-5

DATE 10-14-1995  
PERSONNEL CHENEY  
RIPPLE  
BARBOUR  
GEYMAN

PRIORITY NO. 32 PART 2 OF 3 SHEET 1 OF 9  
COUNTY OTTAWA ROUTE SR 163 SECTION 20.85  
BEGIN LOG (SLM) 20.85 TERMINII SR 358  
END LOG (SLM) 25.11 TERMINII Bridge No. 2511  
TOTAL LENGTH 3.97 MILES  
MUNICIPALITY Port Clinton BEGIN LOG (SLM) 24.03 END LOG (SLM) 27.04  
MUNICIPALITY BEGIN LOG (SLM) END LOG (SLM)

PROPOSED WORK: Resurface  
PAVEMENT 1 1/2" 404 SHOULDER 1 1/2" 404, 617  
OTHER

STATION ESTABLISHED FROM: ① USED S.L.M. 20.85 = (STA. 1100+88) @ E. OF  
PAV'T. INTERSECTION S.R. # 358 & S.R. # 163.

STRUCTURES:

| NUMBER | STATION | WIDTH | LENGTH | PROPOSED WORK |
|--------|---------|-------|--------|---------------|
|        |         |       |        |               |
|        |         |       |        |               |
|        |         |       |        |               |
|        |         |       |        |               |

RAILROAD CROSSING:

NAME CONRAIL STATION 1178+24 NO. TRACKS 2 LENGTH ALONG C L 25 FT  
NAME STATION NO. TRACKS LENGTH ALONG C L FT

MISCELLANEOUS:

NO RAISED PAVEMENT MARKERS; EDGE OF PAVEMENT 35 CENTERLINE 228

NO. MAILBOX APPROACHES N/A MAILBOX SUPPORTS N/A

REMARKS: ① CONSTRUCTION JOINT @ STA. 1101+67. ② END STATION IN  
@ CONCRETE APPROACH SLAB OF STR. # 2511 - STA. 1326+50.

[illegible]

DATE 10-14-1993

SHEET 3 OF 9

UTILITIES (CATCH BASIN, MANHOLE, INLET, WATER VALVE, BOX AND MONUMENT BOX)

COUNTY OTTAWA. ROUTE S.R. #163 SECTION 20.85

R = RAISE      F = FEATHER

[illegible]

SHEET 4 OF 9

SHEET 4 OF 9

SHEET 5 OF 9

NOTE: LOCATE ALL  
CHANGES IN PVMT WIDTH

ROUTE S.R.# 163 SECTION 20.85

[illegible]

DATE 2-15-1994

1994 TWO-LANE RESURFACING PROGRAM  
CENTERLINE PAVEMENT MARKINGS  
INSIDE CITY LIMITS ONLY

SHEET 6 OF 9

COUNTY OTTAWA ROUTE S.R. #163 SECTION 20.85

[illegible]

DATE 10-14-1995

1994 TWO-LANE RESURFACING PROGRAM  
CROSSWALKS AND STOP BARS

SHEET 7 OF 9

COUNTY OTTAWA ROUTE SR#163 SECTION 20.85

[illegible]

LD-5  
5-92

State of Ohio Department of Transportation  
Field Notes

SHEET NO. 8-9

| PERSONNEL | TITLE | PERSONNEL | TITLE |
|-----------|-------|-----------|-------|
| CHENEY    |       |           |       |
| ZIPPLE    | TAPE  |           |       |
| DARBOUR   | PAINT |           |       |
| GEYMAN    | WHEEL |           |       |


COUNTY OTAWA DATE 10-14-1993  
S. R. #163 WEATHER FAIR  
SEC. 20.85 TEMP. 60°

DESCRIPTION ENTRANCE RAMP TO S.R. #2 DETAIL JOB NO. 624029


LEFT

CENTER LINE

RIGHT

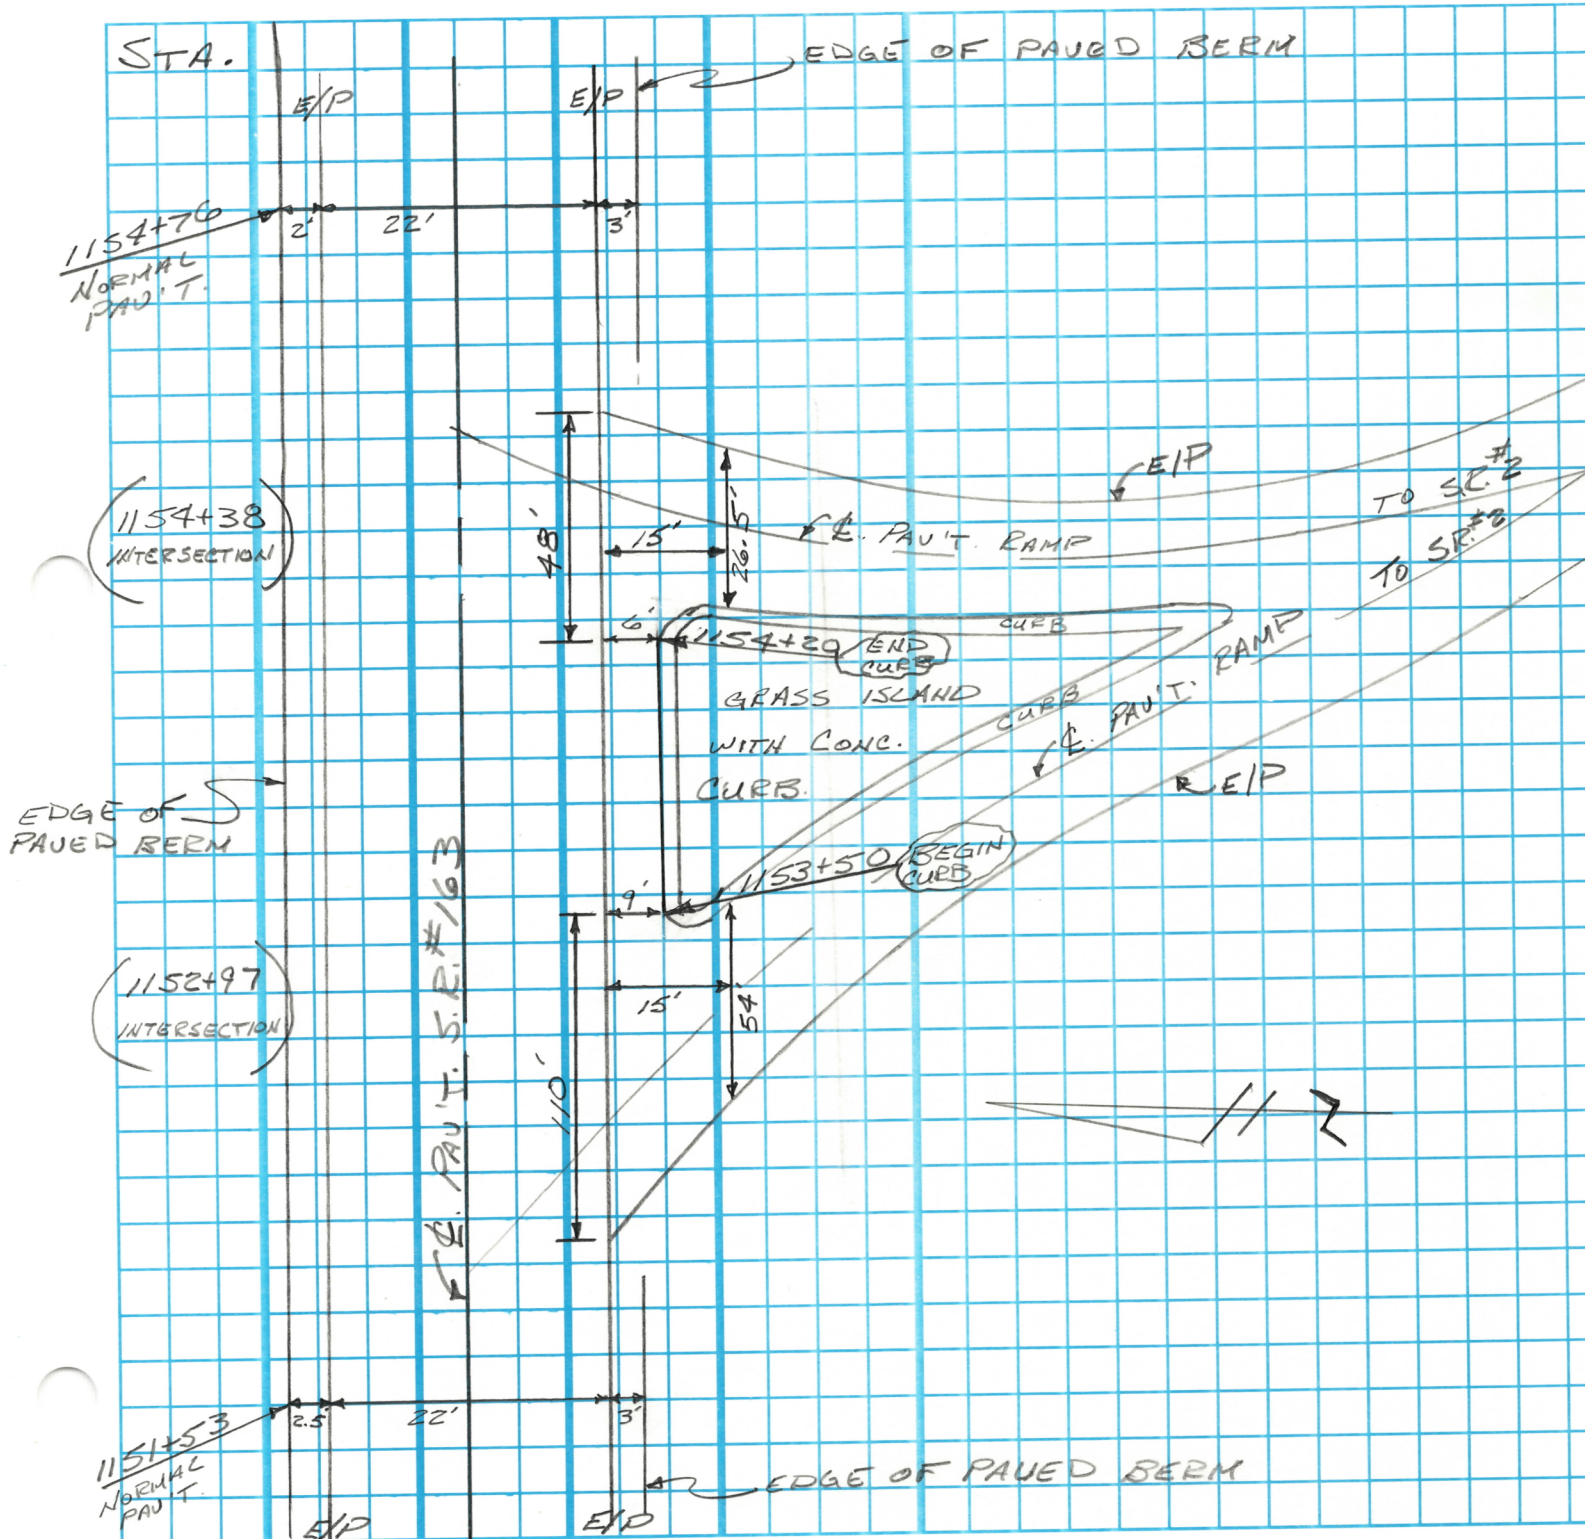

| PERSONNEL   | TITLE   | PERSONNEL   | TITLE | COUNTY         | DATE           |
|-------------|---------|-------------|-------|----------------|----------------|
| RIppLE      | M       |             |       | OTTAWA         | 12-22-93       |
| GEYMAN      | H. TAPE |             |       | S. R. #163     | WEATHER Cloudy |
|             |         |             |       | SEC. 20.85     | TEMP.          |
| DESCRIPTION |         |             |       | JOB NO. 624029 |                |
| LEFT        |         | CENTER LINE |       | RIGHT          |                |

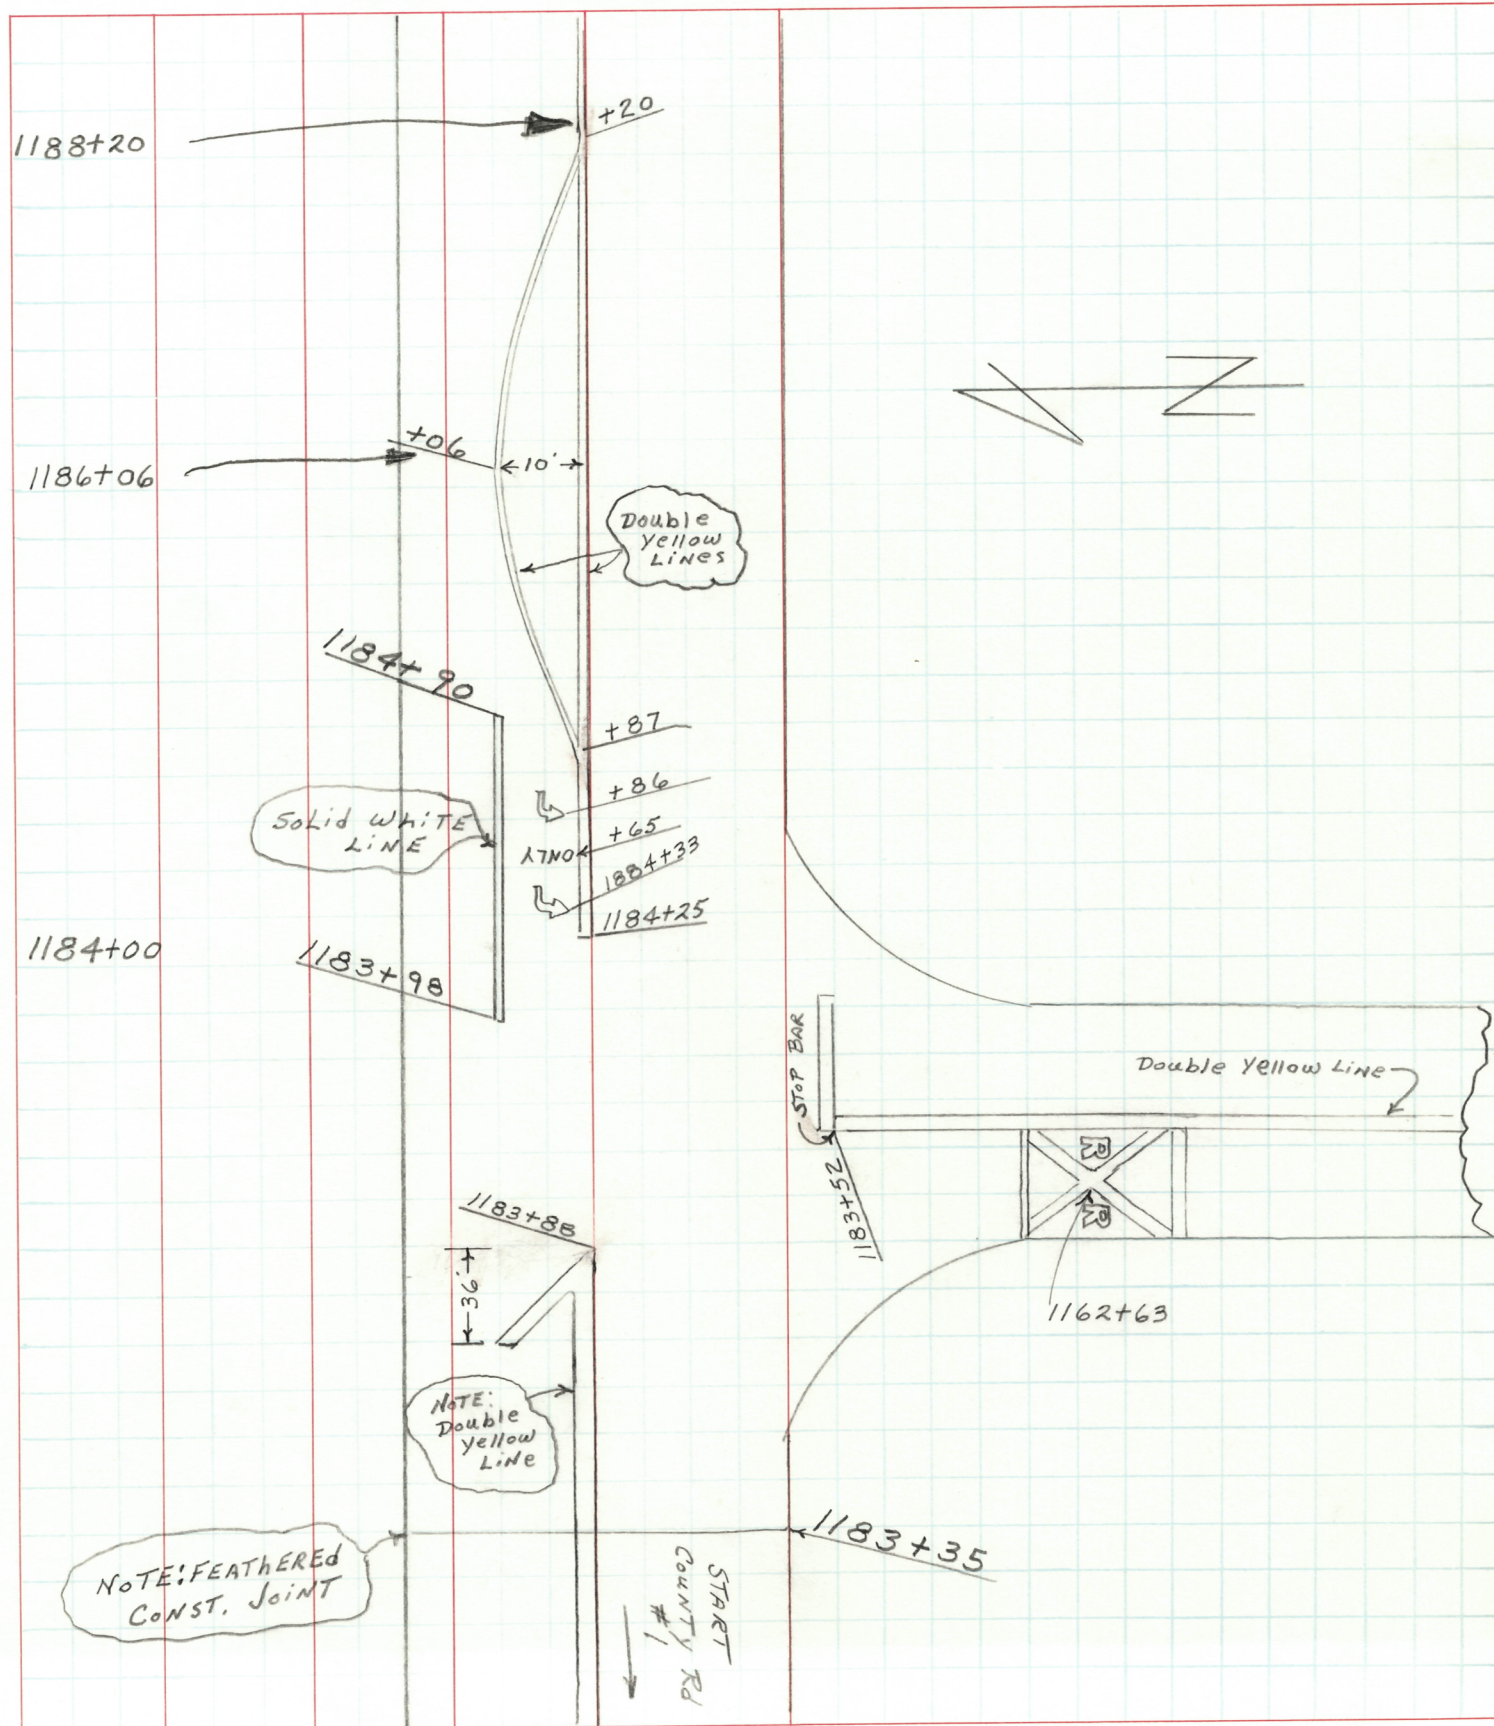

| DESCRIPTION     | LEFT | RIGHT | JOB NO. |
|-----------------|------|-------|---------|
| PARM'T MARKINGS |      |       | 624029  |

