

O.D.O.T. DISTRICT 2 SURVEY OFFICE (USE ONLY)

PERSONNEL

REFERENCE NO. 17 A

SHEET 1 OF 6

NOTES MILLER

DATE 12-27-18

ROUTE SR 53

H.C. LEU

WEATHER CLOUDY

COUNTY OTTAWA

R.C. MILLER

TEMP. 36°

TOWNSHIP BAY

DWG BY JAMES

PID 92368

SECTION 11

T 6 N R 16 E

TYPE MONUMENT MONBOX W/ 1" IPIN

ON SURFACE - BELOW ON

OFFSET \odot PAVEMENT ON LT : RT

TO EDGE PAVEMENT


STATION: 265+04.64

HORIZ.DATUM: NAD83 2011

GEOID: NAVD88 2012A


GRID: NORTHING: 667687.705

EASTING: 1838759.754

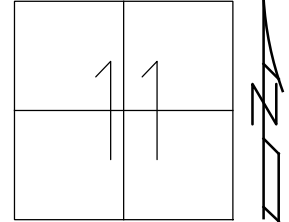

RECORD:
STA. 265+00
FD MONBOX
6/9/92, CHENEY
FD MONBOX
SHOT "+" ON LID
CP101
4/5/13, TMR


SET SHI
5"x3" WOOD POST
REAL ESTATE SIGN

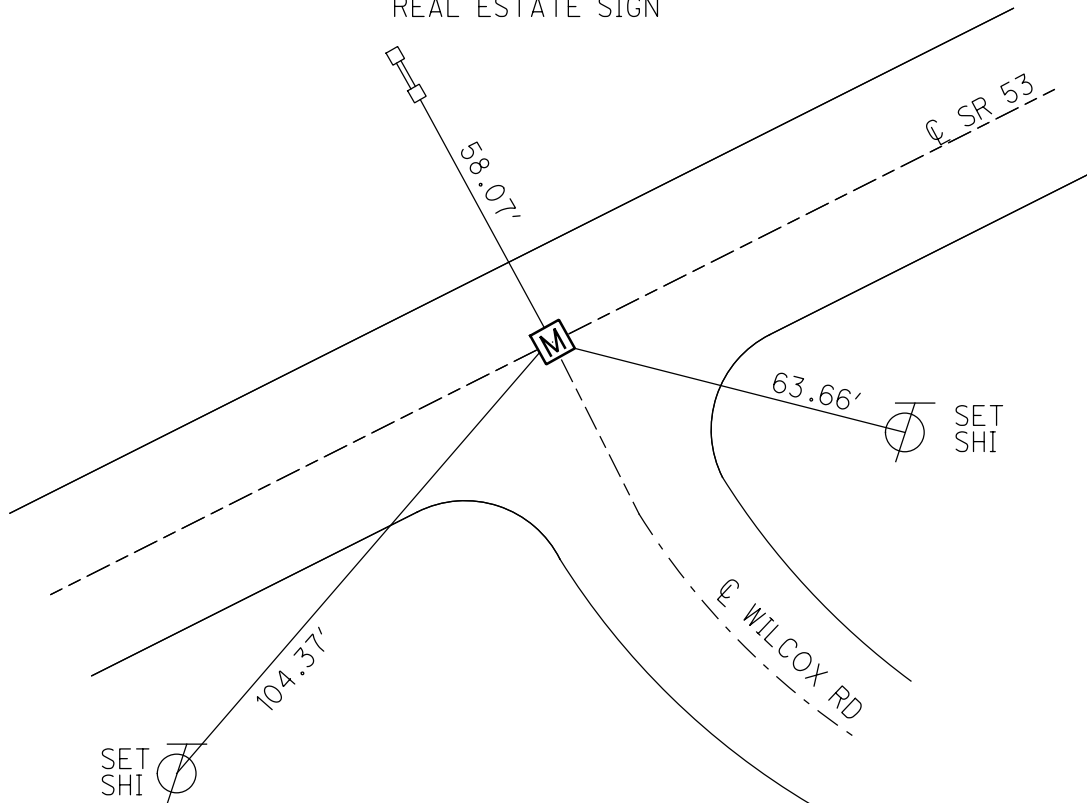

O.D.O.T. DISTRICT 2 SURVEY OFFICE (USE ONLY)


PERSONNEL _____ REFERENCE NO. 17 A SHEET 2 OF 7
 NOTES ROUSOS DATE 4/5/13 ROUTE SR 53
 H.C. ROUSOS WEATHER CLEAR COUNTY OTTAWA
 R.C. LAU TEMP. 40° TOWNSHIP BAY
 _____ SECTION 11
 _____ T 6 N R 16 E

TYPE MONUMENT MONBOX
 ON SURFACE - ~~BELOW~~ ON
 LEFT - ☉ PAV'T - RIGHT ON
- TO - EDGE PAVEMENT
 S.L.M. 264+99.40

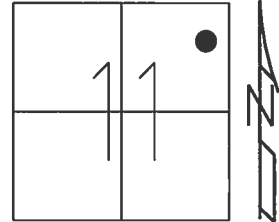

Grid: Northing: 667687.789 Easting: 1838759.762

RECORD:
 STA. 265+00
 FD MONBOX
 6/9/92, CHENEY
 FD MONBOX
 SHOT "+" ON LID
 CP101
 4/5/13, TMR

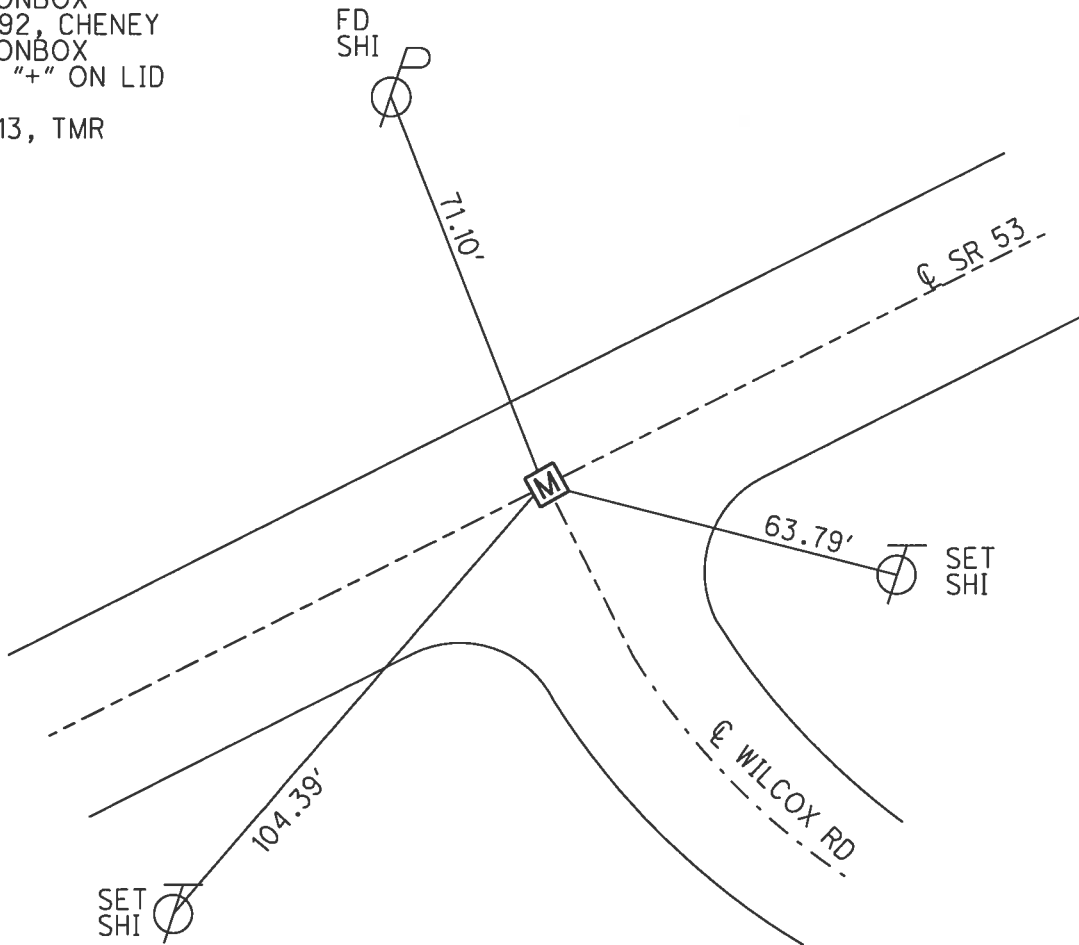


PERSONNEL	TITLE	PERSONNEL	TITLE
CHENEY	<i>[Signature]</i>		
PIPPLE	<i>[Signature]</i>		
BARBOUR	<i>[Signature]</i>		
GEYMAN	<i>[Signature]</i>		

COUNTY OTTAWA DATE 6-9-1992
 S. R. #2-53 OVERPASS WEATHER SUNNY
 SEC. 16.63 TEMP. 70°

DESCRIPTION TITLE SHEET JOB NO. 022960

LEFT CENTER LINE RIGHT

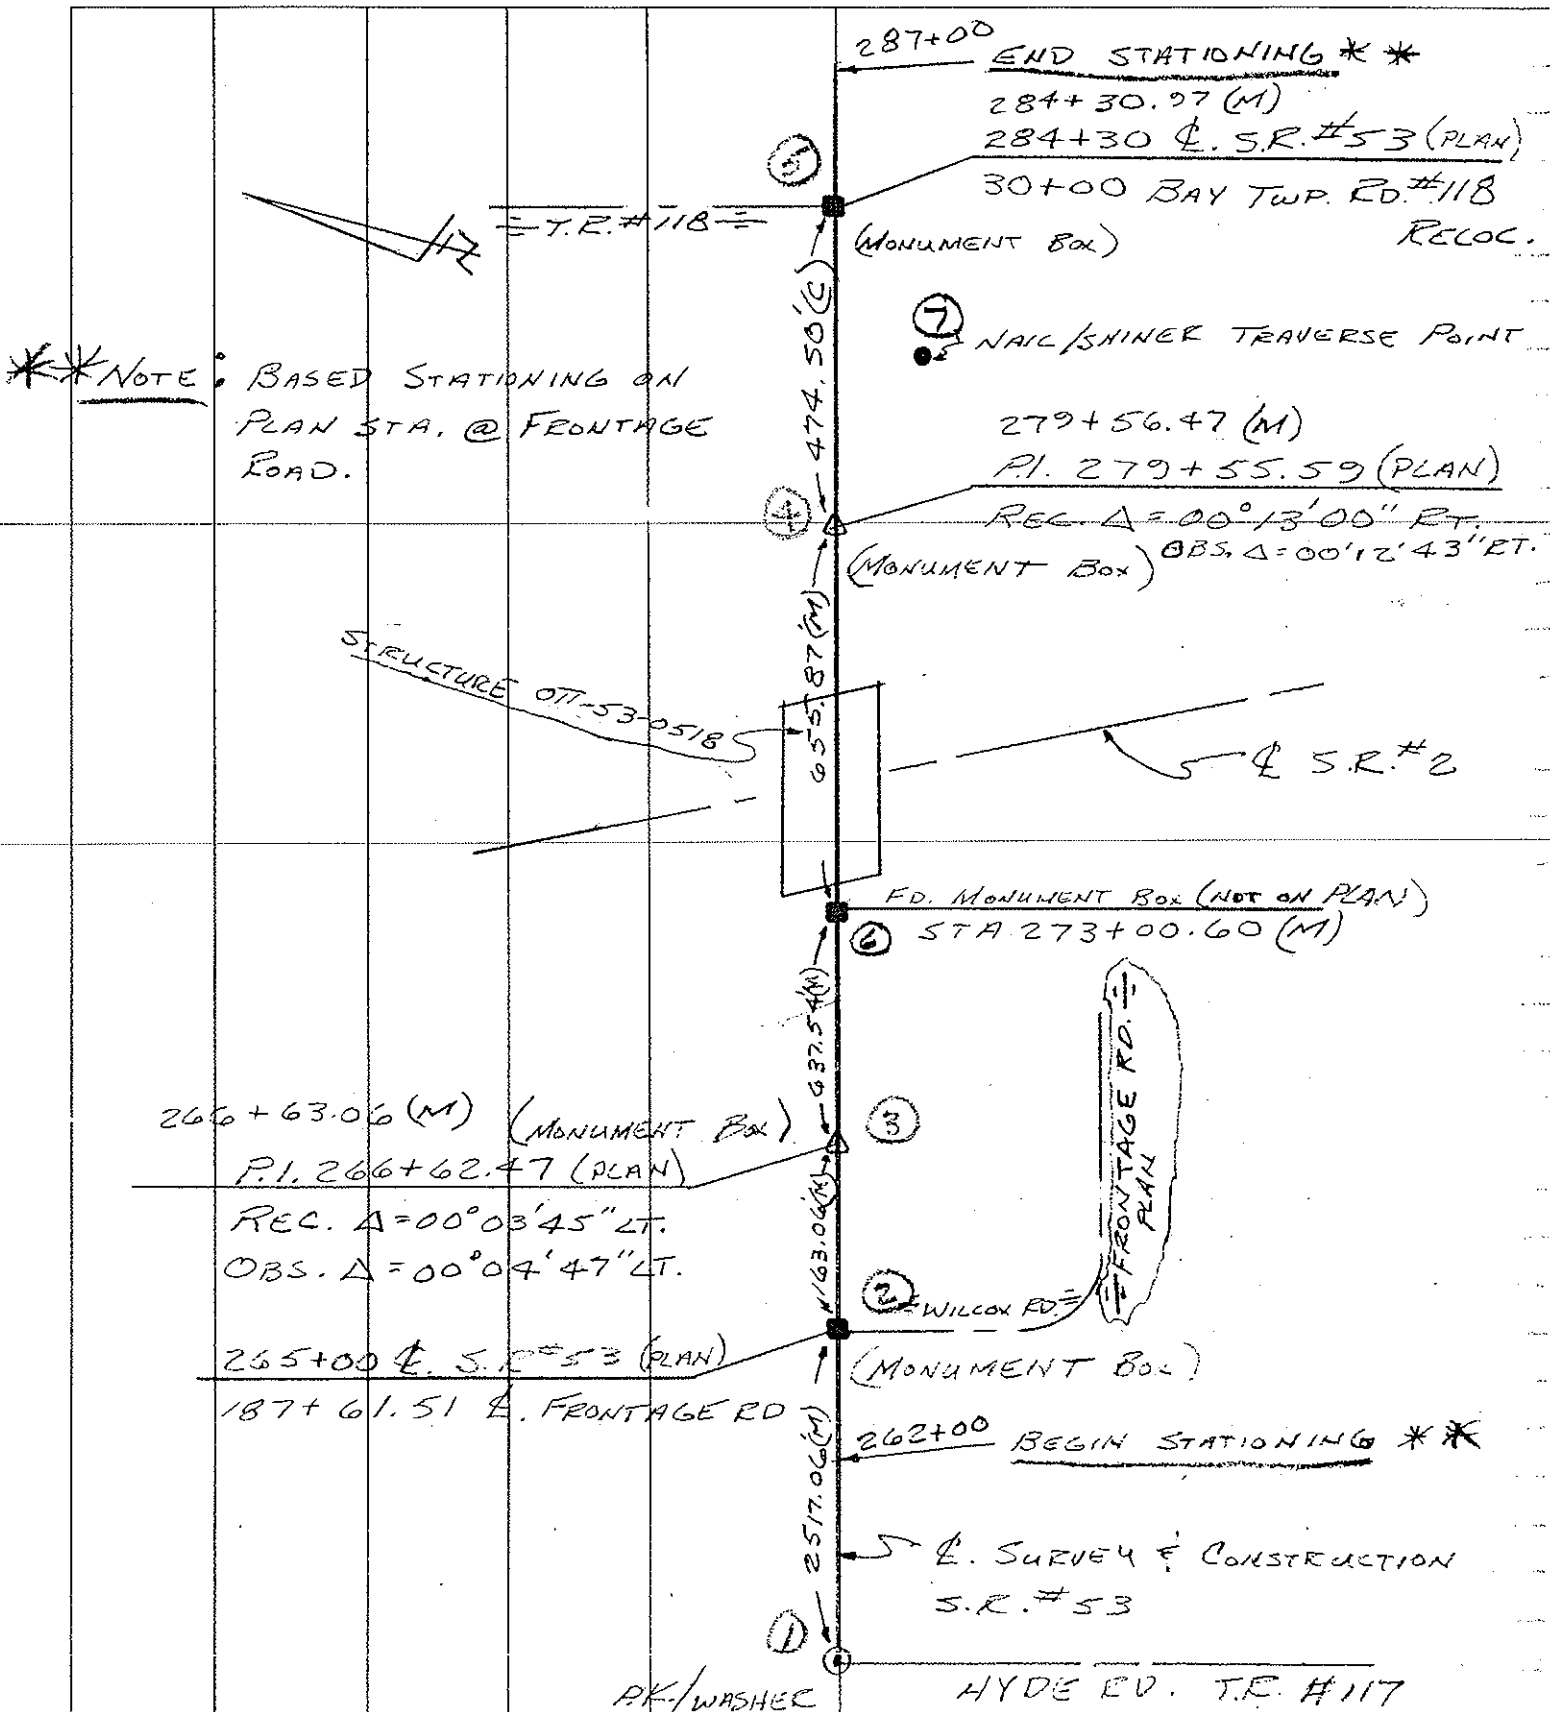

****NOTE:** BASED STATIONING ON PLAN STA. @ FRONTAGE ROAD.


PERSONNEL	TITLE	PERSONNEL	TITLE
<u>Cronin</u>			
<u>Rippte</u>			
<u>Geyman</u>			
<u>Barbour</u>			

COUNTY Ottawa DATE 12/05/89
 S. R. # 53 WEATHER overcast
 SEC. _____ TEMP. 30°

DESCRIPTION Movement Boxes JOB NO. _____
 LEFT CENTER LINE RIGHT

DESCRIPTION	LEFT	CENTER LINE	RIGHT
Man. Box P.I. 27945559 From Off. 2 - 1960 Plans			* Was not raised when pavement was resurfaced.
P.O.T Man Box 265400 From Off. 2 - 1960 Plans Access Rd.			* Was not raised when pavement was resurfaced.

PERSONNEL	TITLE	PERSONNEL	TITLE	COUNTY	DATE
Schneider		Winson		Ottawa	4-19-72
Masser				S. R. 53	WEATHER cloudy
Barbour				SEC. Sandusky Co Line North	TEMP. 75°
Geyman					

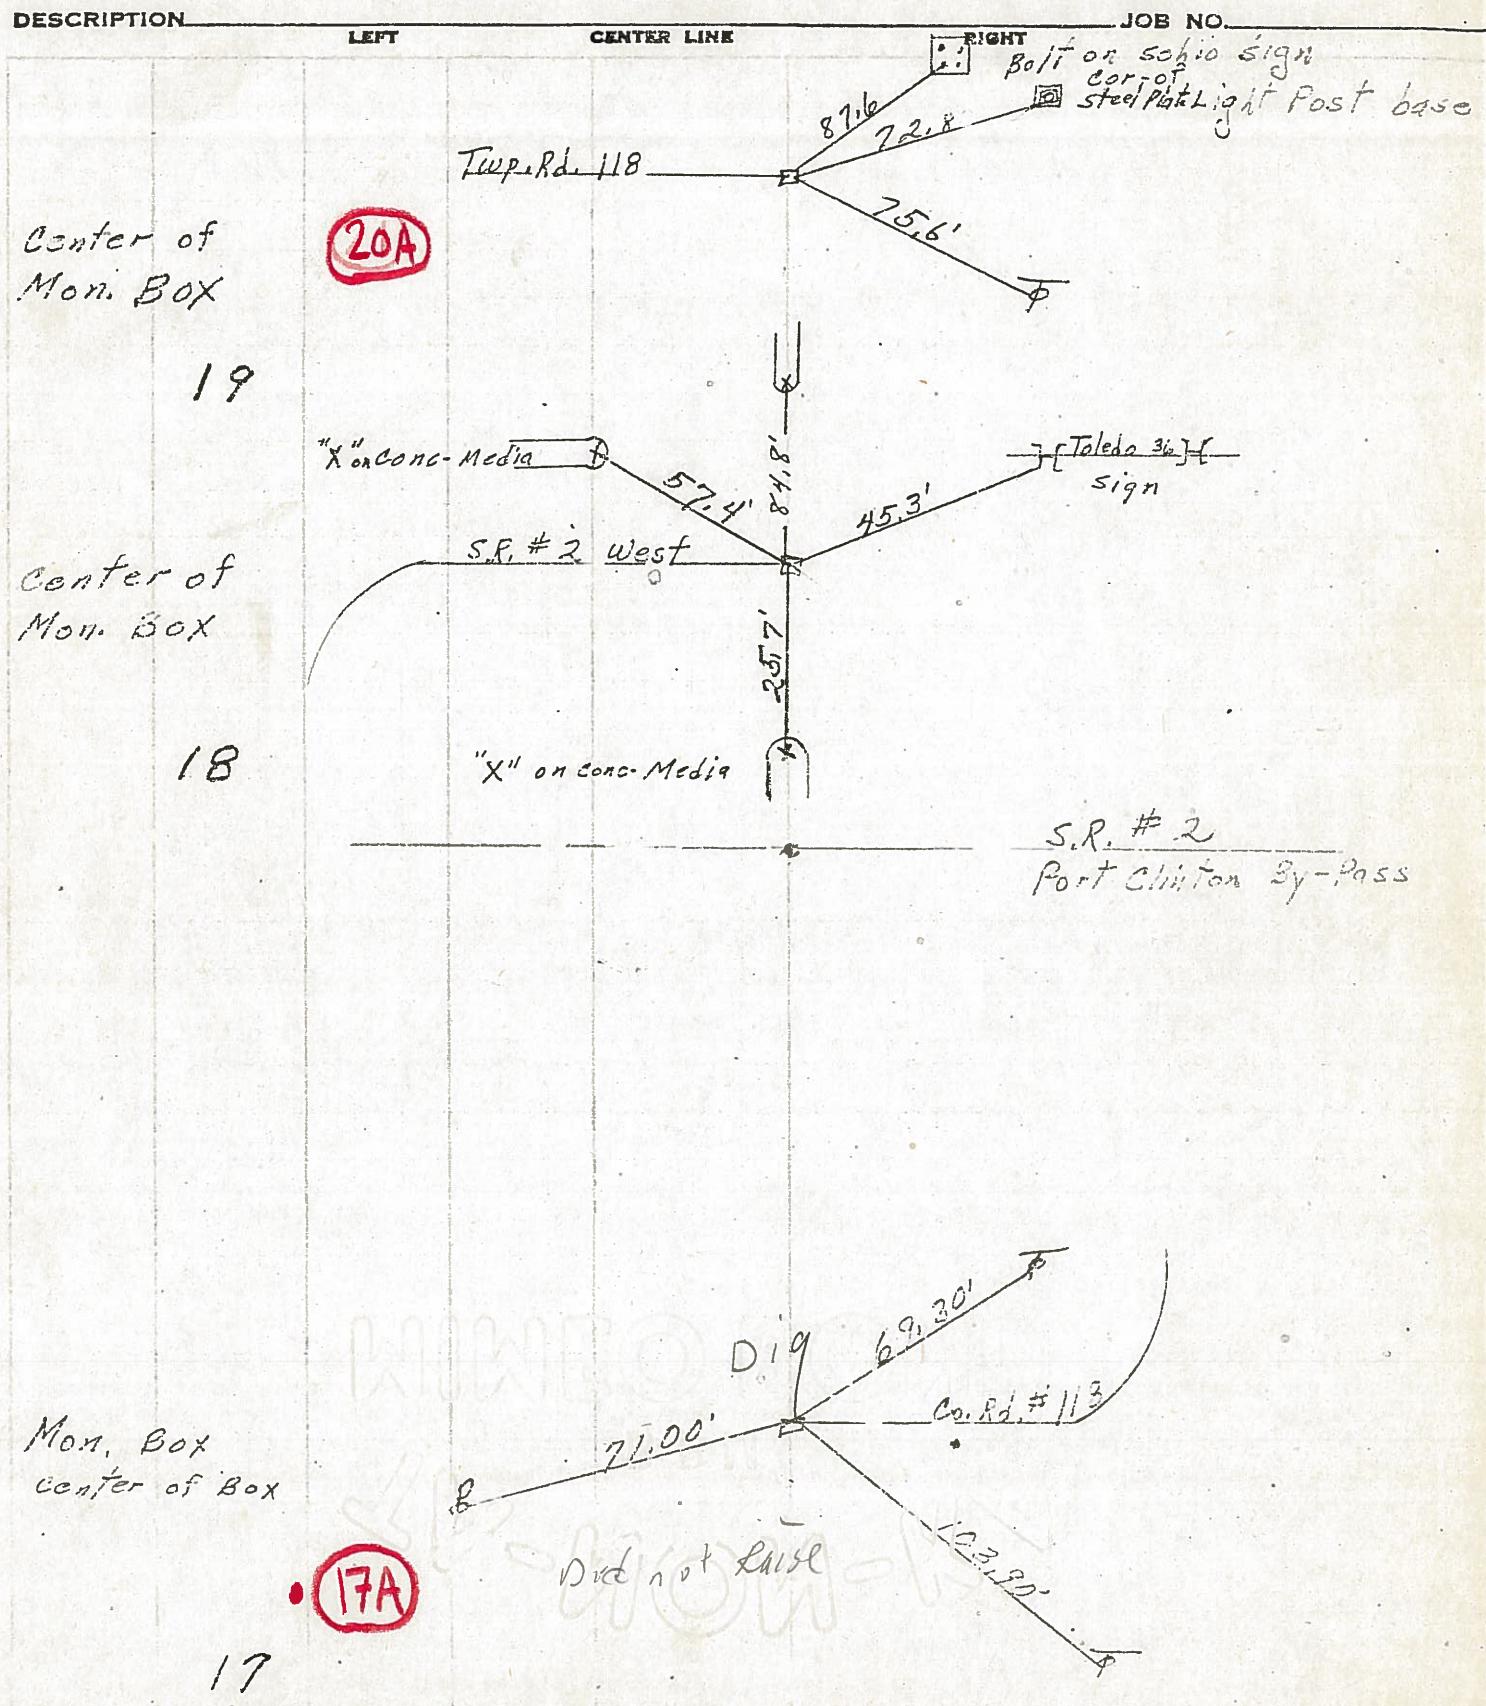

PERSONNEL	TITLE	PERSONNEL	TITLE
Schneider		Vinson	
Mosser			
Barbour			
Geyman			

COUNTY Ottawa DATE 4-19-72
 S. R. 53 WEATHER Cloudy
 SEC. Sandusky Co. Line North TEMP. 75°

