


O.D.O.T. DISTRICT 2 SURVEY OFFICE (USE ONLY)


PERSONNEL _____ REFERENCE NO. 20 A SHEET 6 OF 7
 NOTES ROUSOS DATE 4/5/13 ROUTE SR 53
 H.C. ROUSOS WEATHER CLEAR COUNTY OTTAWA
 R.C. LAU TEMP. 40° TOWNSHIP BAY
 _____ SECTION 12
 _____ T 6 N R 16 E

TYPE MONUMENT MONBOX W/ 1" IPIN
 ON SURFACE - ~~BELOW~~ ON
 LEFT - ☉ PAV'T - RIGHT ON
- TO - EDGE PAVEMENT
 S.L.M. 284+30.09

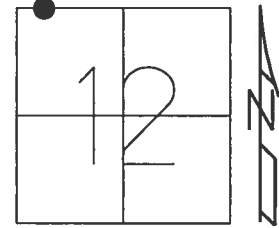

Grid: Northing: 668627.005 Easting: 1840446.600

RECORD:
 STA. 284+30
 FD MONBOX
 6/9/92, CHENEY
 FD MONBOX
 W/ 1" IPIN
 CP105
 4/5/13, TMR

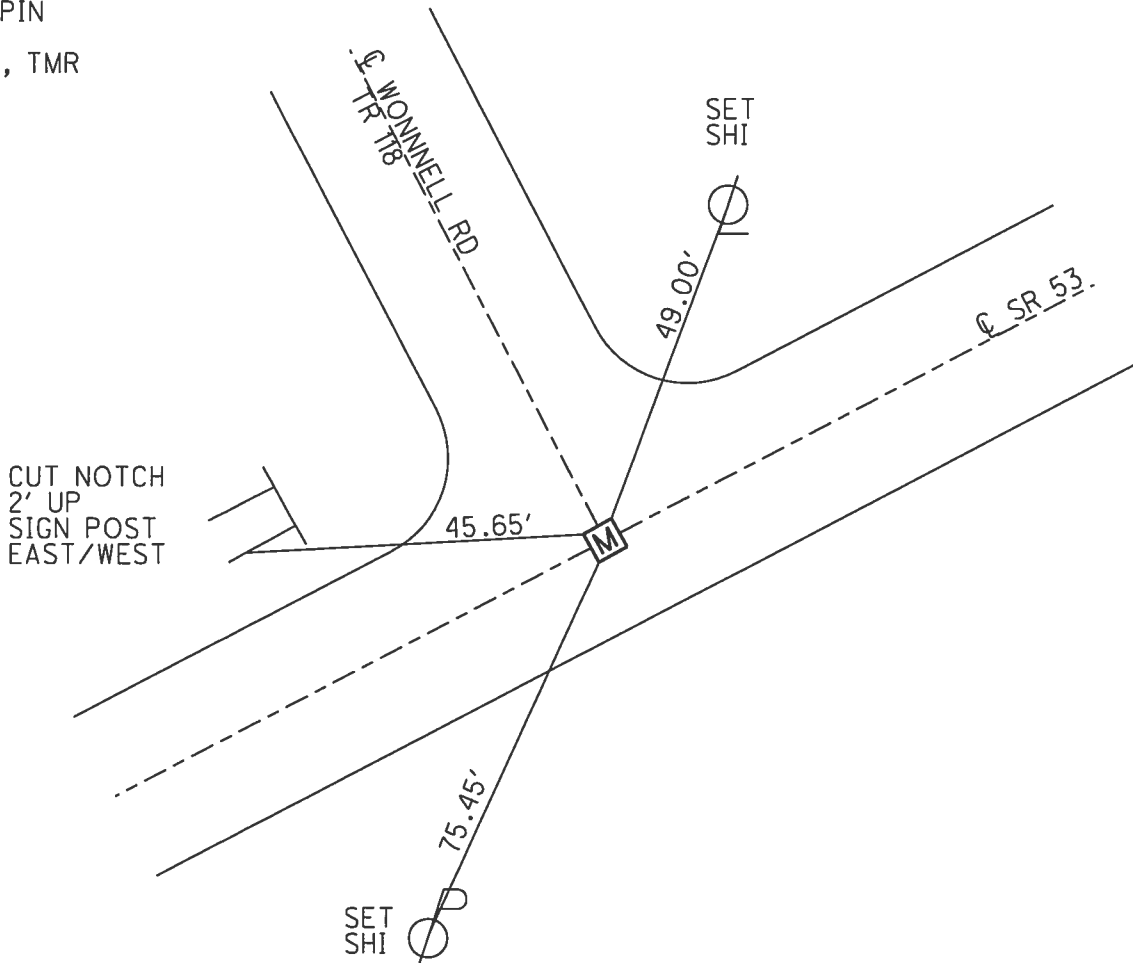


PERSONNEL	TITLE	PERSONNEL	TITLE
CHENEY	M		
PIPPLE	Ø		
BARBOUR	T		
GEYMAN	Ø		

COUNTY OTTAWA DATE 6-9-1992
 S. R. #2-53 OVERPASS WEATHER SUNNY
 SEC. 16.63 TEMP. 70°

DESCRIPTION TITLE SHEET JOB NO. 022960

LEFT CENTER LINE RIGHT

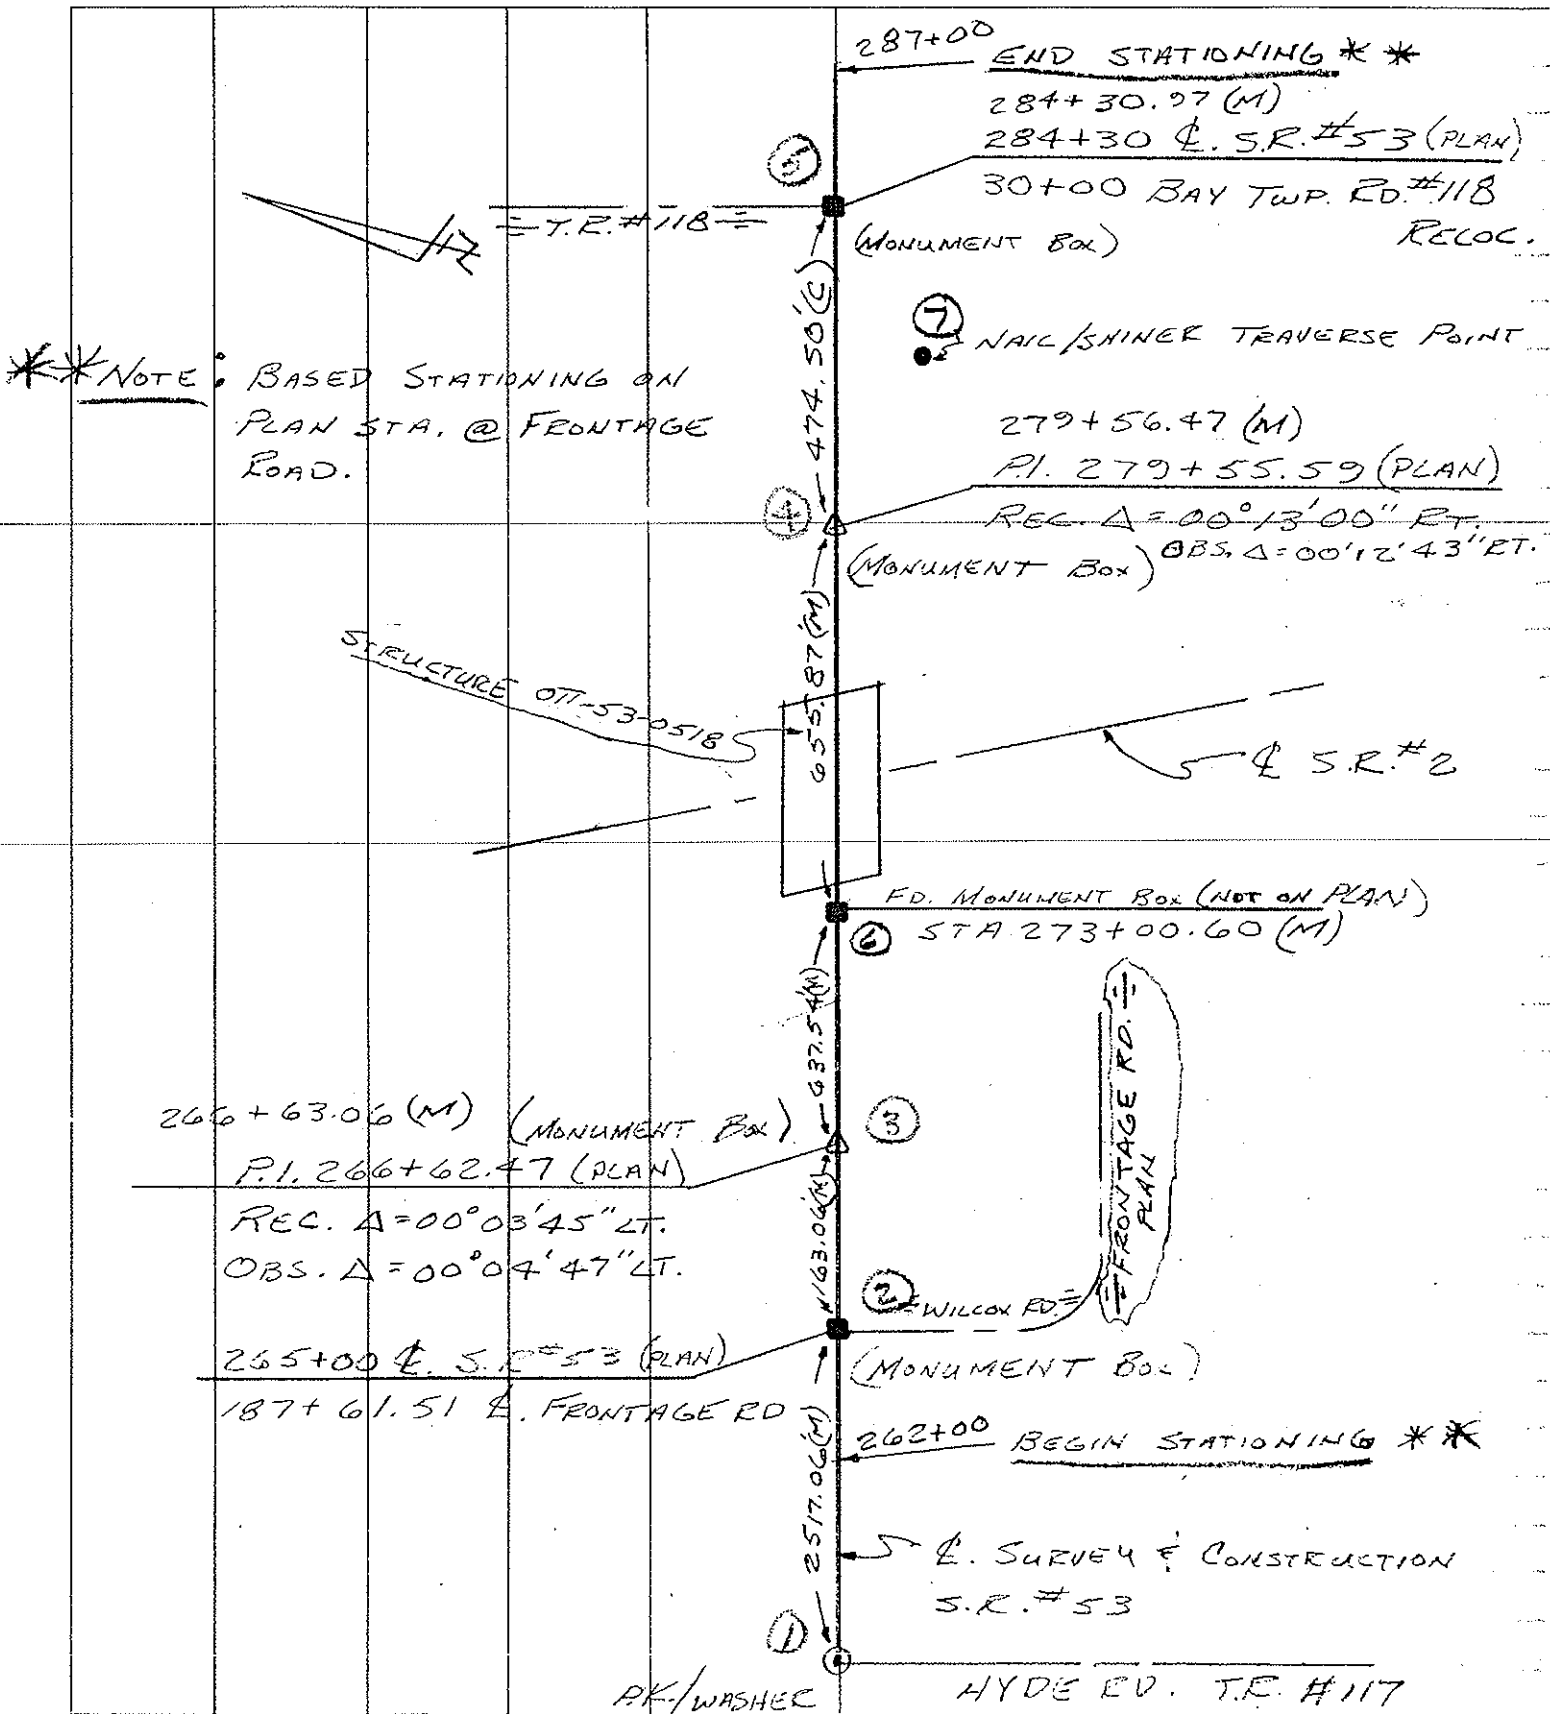

PERSONNEL	TITLE	PERSONNEL	TITLE	COUNTY	DATE
Schneider		Vinson		Ottawa	4-19-72
Mosser				S. R. 53	WEATHER Cloudy
Barbour				SEC. Sandusky Co. Line North	TEMP. 75°
Geyman					

DESCRIPTION	LEFT	CENTER LINE	RIGHT	JOB NO.
-------------	------	-------------	-------	---------

