


O.D.O.T. DISTRICT 2 SURVEY OFFICE (USE ONLY)


PERSONNEL _____ REFERENCE NO. 20 SHEET 1 OF 12
 NOTES RHOADES DATE 3/9/21 ROUTE SR 53
 H.C. AUBLE WEATHER _____ COUNTY OTTAWA
 R.C. _____ TEMP. _____ TOWNSHIP PORTAGE
 _____ SECTION 2
 DWG BY RHOADES PID 102905 T 6 N R 17 E

TYPE MONUMENT MONBOX W/1" IPIN
 ON SURFACE - ~~BELOW~~ ON
 OFFSET ☉ PAVEMENT ON _____ LT : RT
 _____ TO _____ EDGE PAVEMENT
 STATION: 618+22.82

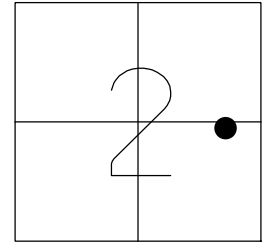

HORZ.DATUM: NAD83 2011 GEOID: NAVD88 2018
 GRID: NORTHING: 670474.636 EASTING: 1870029.918

RECORD:
 FD MONBOX
 6/12/72, BARBOUR
 FD MONBOX
 W/IPIN
 10/30/89, SH
 REF20
 3/9/21, DSA

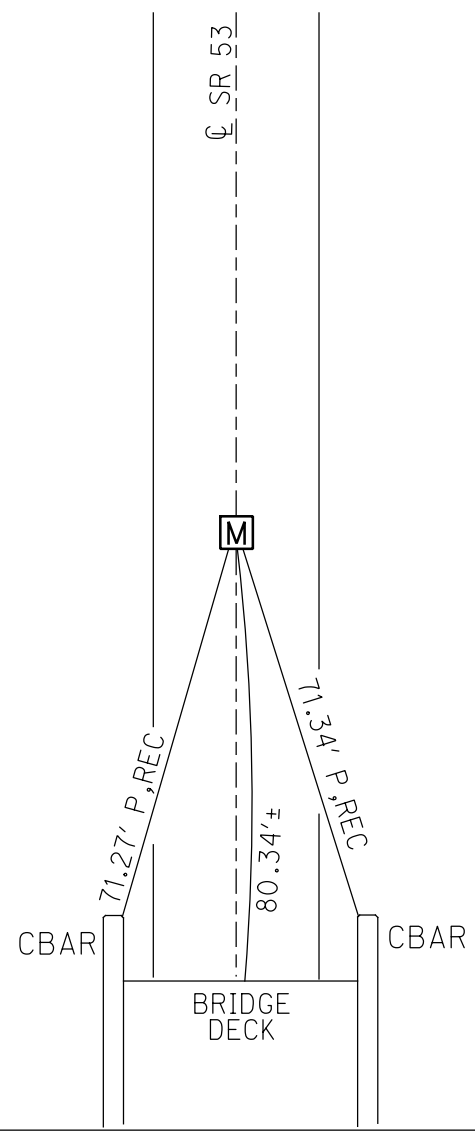

O.D.O.T. DISTRICT 2 SURVEY OFFICE

PERSONNEL _____

REFERENCE NO. 20

SHEET 1 OF 5

NOTES HOFFMAN

H.C. BARNHISEC

DATE 10-30-89

ROUTE SR 53

R.C. _____

WEATHER clear

COUNTY OTTAWA

TEMP. 79°

TOWNSHIP Poemag5

SECTION 2

T6 NR 17 E

TYPE MONUMENT IRON PIN IN MONUMENT BOX

ON SURFACE - BELOW YES

LEFT - & PAV'T. - RIGHT YES

TO EDGE PAVEMENT

S.L.M. OLD PLAKI STA = 52400.00

